

FEE \$	1589
TCP \$	460
SIF \$	1

PLANNING CLEARANCE

(Single Family Residential and Accessory Structures)

Community Development Department

BLDG PERMIT NO. _____

Building Address 2466 Theresa Ln.
 Parcel No. 2945-041-27-089
 Subdivision Brookwillow
 Filing 1 Block _____ Lot 89

No. of Existing Bldgs 0 No. Proposed 1
 Sq. Ft. of Existing Bldgs N/A Sq. Ft. Proposed 1375
 Sq. Ft. of Lot / Parcel 427
 Sq. Ft. Coverage of Lot by Structures & Impervious Surface (Total Existing & Proposed) _____
 Height of Proposed Structure _____

OWNER INFORMATION:

Name Darter LLC
 Address 786 Valley Ct.
 City / State / Zip CO 81505

DESCRIPTION OF WORK & INTENDED USE:
 New Single Family Home (*check type below)
 Interior Remodel Addition
 Other (please specify): Townhome Unit

APPLICANT INFORMATION:

Name Grace Homes
 Address 786 Valley Ct.
 City / State / Zip CO 81505
 Telephone 248-8522

*TYPE OF HOME PROPOSED:
 Site Built Manufactured Home (UBC)
 Manufactured Home (HUD)
 Other (please specify): _____

NOTES: _____

REQUIRED: One plot plan, on 8 1/2" x 11" paper, showing all existing & proposed structure location(s), parking, setbacks to all property lines, ingress/egress to the property, driveway location & width & all easements & rights-of-way which abut the parcel.

THIS SECTION TO BE COMPLETED BY COMMUNITY DEVELOPMENT DEPARTMENT STAFF	
ZONE <u>PP</u>	Maximum coverage of lot by structures <u>per plan</u>
SETBACKS: Front <u>20'</u> from property line (PL)	Permanent Foundation Required: YES <u>X</u> NO _____
Side <u>per plan</u> from PL Rear <u>per plan</u> from PL	Parking Requirement <u>2</u>
Maximum Height of Structure(s) <u>per plan</u>	Special Conditions <u>refer to 12/19/06 site plan</u>
Voting District <u>B</u>	Driveway Location Approval <u>JR/PAO</u> (Engineer's Initials)
	<u>FP-2005-144</u>

Modifications to this Planning Clearance must be approved, in writing, by the Community Development Department. The structure authorized by this application cannot be occupied until a final inspection has been completed and a Certificate of Occupancy has been issued, if applicable, by the Building Department (Section 305, Uniform Building Code).

I hereby acknowledge that I have read this application and the information is correct; I agree to comply with any and all codes, ordinances, laws, regulations or restrictions which apply to the project. I understand that failure to comply shall result in legal action, which may include but not necessarily be limited to non-use of the building(s).

Applicant Signature [Signature] - Agent Date 11/10/06

Department Approval [Signature] Charge Date _____


Additional water and/or sewer tap fee(s) are required: YES <u>X</u> NO _____	W/O No. <u>19961</u>
Utility Accounting <u>[Signature]</u>	Date <u>2-5-07</u>

VALID FOR SIX MONTHS FROM DATE OF ISSUANCE (Section 2.2.C.1 Grand Junction Zoning & Development Code)
 (White: Planning) (Yellow: Customer) (Pink: Building Department) (Goldenrod: Utility Accounting)

2-5-07

JAR/Isle Magee

PLANNING
IDENTIFY EASEMENTS
BOUNDARIES

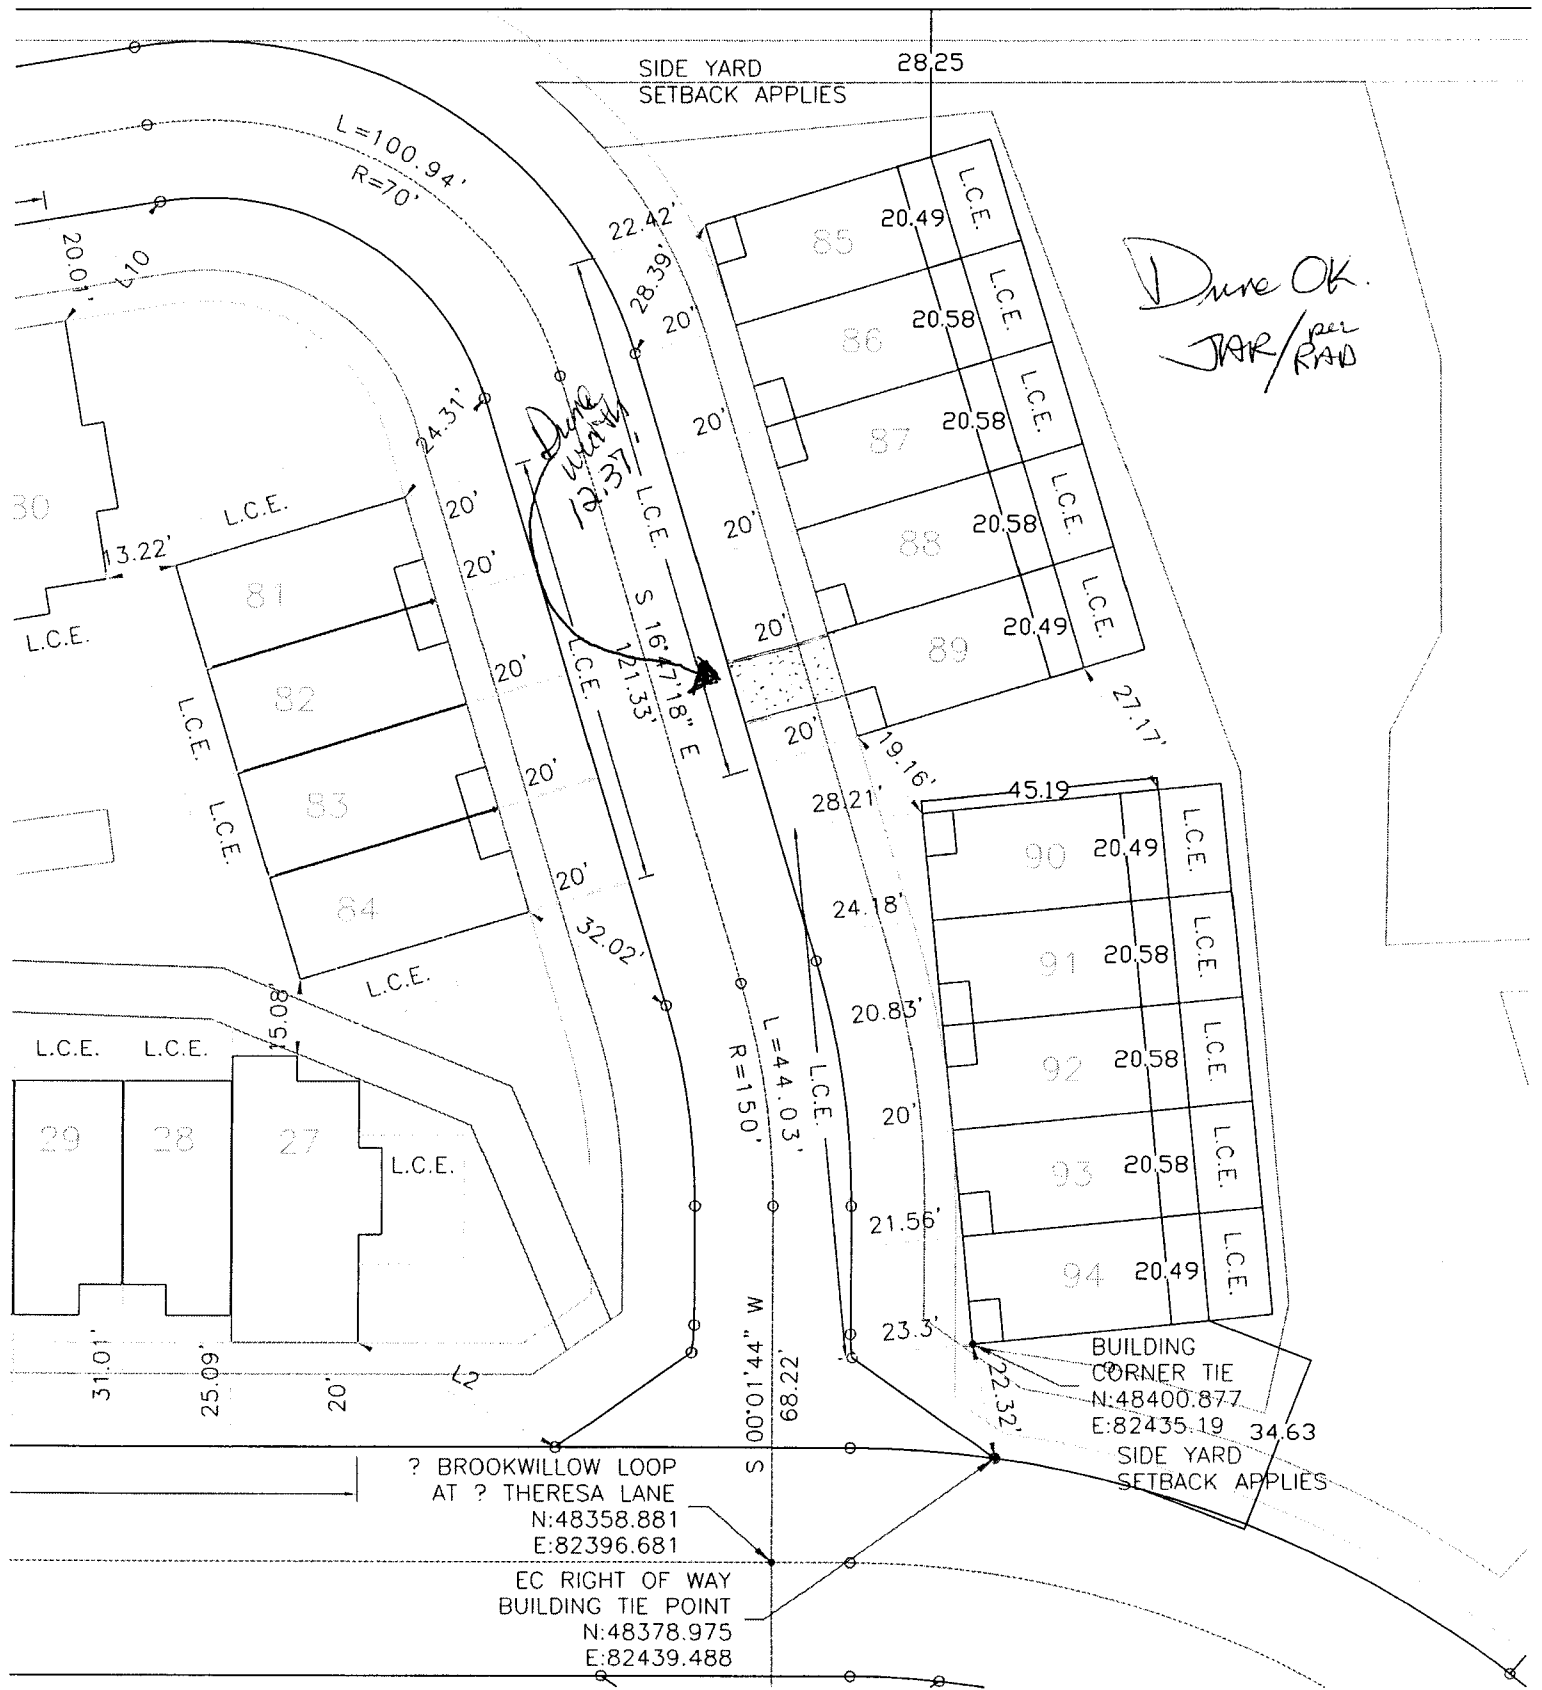

Done OK.
JAR/per RAD

? BROOKWILLOW LOOP
AT ? THERESA LANE
N:48358.881
E:82396.681

EC RIGHT OF WAY
BUILDING TIE POINT
N:48378.975
E:82439.488

BUILDING
CORNER TIE
N:48400.877
E:82435.19 34.63