

FEE \$	10 ⁰⁰
TCP \$	1589 ⁰⁰
SIF \$	460 ⁰⁰

PLANNING CLEARANCE
 (Single Family Residential and Accessory Structures)
Community Development Department

BLDG PERMIT NO. _____

Building Address 2450 1/2 Theresa Ln.
 Parcel No. 2945-041-27-050
 Subdivision Brockwillow
 Filing 1 Block _____ Lot 50

No. of Existing Bldgs 0 No. Proposed 1
 Sq. Ft. of Existing Bldgs NA Sq. Ft. Proposed 1365
 Sq. Ft. of Lot / Parcel _____
 Sq. Ft. Coverage of Lot by Structures & Impervious Surface (Total Existing & Proposed) _____
 Height of Proposed Structure _____

OWNER INFORMATION:

Name Darter LLC
 Address 786 Valley Ct.
 City / State / Zip GJ CO 81505

DESCRIPTION OF WORK & INTENDED USE:

- New Single Family Home (*check type below)
 Interior Remodel Addition
 Other (please specify): _____

APPLICANT INFORMATION:

Name Grace Homes
 Address 786 Valley Ct.
 City / State / Zip GJ CO 81505
 Telephone 248-8522

***TYPE OF HOME PROPOSED:**

- Site Built Manufactured Home (UBC)
 Manufactured Home (HUD)
 Other (please specify): _____

NOTES: _____

REQUIRED: One plot plan, on 8 1/2" x 11" paper, showing all existing & proposed structure location(s), parking, setbacks to all property lines, ingress/egress to the property, driveway location & width & all easements & rights-of-way which abut the parcel.

THIS SECTION TO BE COMPLETED BY COMMUNITY DEVELOPMENT DEPARTMENT STAFF	
ZONE <u>PD</u>	Maximum coverage of lot by structures <u>per plan</u>
SETBACKS: Front <u>20</u> from property line (PL)	Permanent Foundation Required: YES <u>X</u> NO _____
Side <u>per plan</u> from PL Rear <u>per plan</u> from PL	Parking Requirement <u>2</u>
Maximum Height of Structure(s) <u>per plan</u>	Special Conditions <u>refer to 12/19/06 site plan</u>
Voting District <u>B</u> Driveway _____	<u>FP-2005-144</u>
Location Approval <u>JMR</u> (Engineer's Initials)	

Modifications to this Planning Clearance must be approved, in writing, by the Community Development Department. The structure authorized by this application cannot be occupied until a final inspection has been completed and a Certificate of Occupancy has been issued, if applicable, by the Building Department (Section 305, Uniform Building Code).

I hereby acknowledge that I have read this application and the information is correct; I agree to comply with any and all codes, ordinances, laws, regulations or restrictions which apply to the project. I understand that failure to comply shall result in legal action, which may include but not necessarily be limited to non-use of the building(s).

Applicant Signature Lee Hollington - Agent Date 1/30/07
 Department Approval JMR Date 4/30/07


Additional water and/or sewer tap fee(s) are required:	YES <input checked="" type="checkbox"/>	NO <input type="checkbox"/>	W/O No. <u>20001</u>
Utility Accounting <u>Kate Ceberry</u>	Date <u>4/30/07</u>		

VALID FOR SIX MONTHS FROM DATE OF ISSUANCE (Section 2.2.C.1 Grand Junction Zoning & Development Code)
 (White: Planning) (Yellow: Customer) (Pink: Building Department) (Goldenrod: Utility Accounting)

DATE: 1/15/14

BK. 849
PG. 494

CONVEYANCE TO PROPERTY
AND ENCUMBRANCES

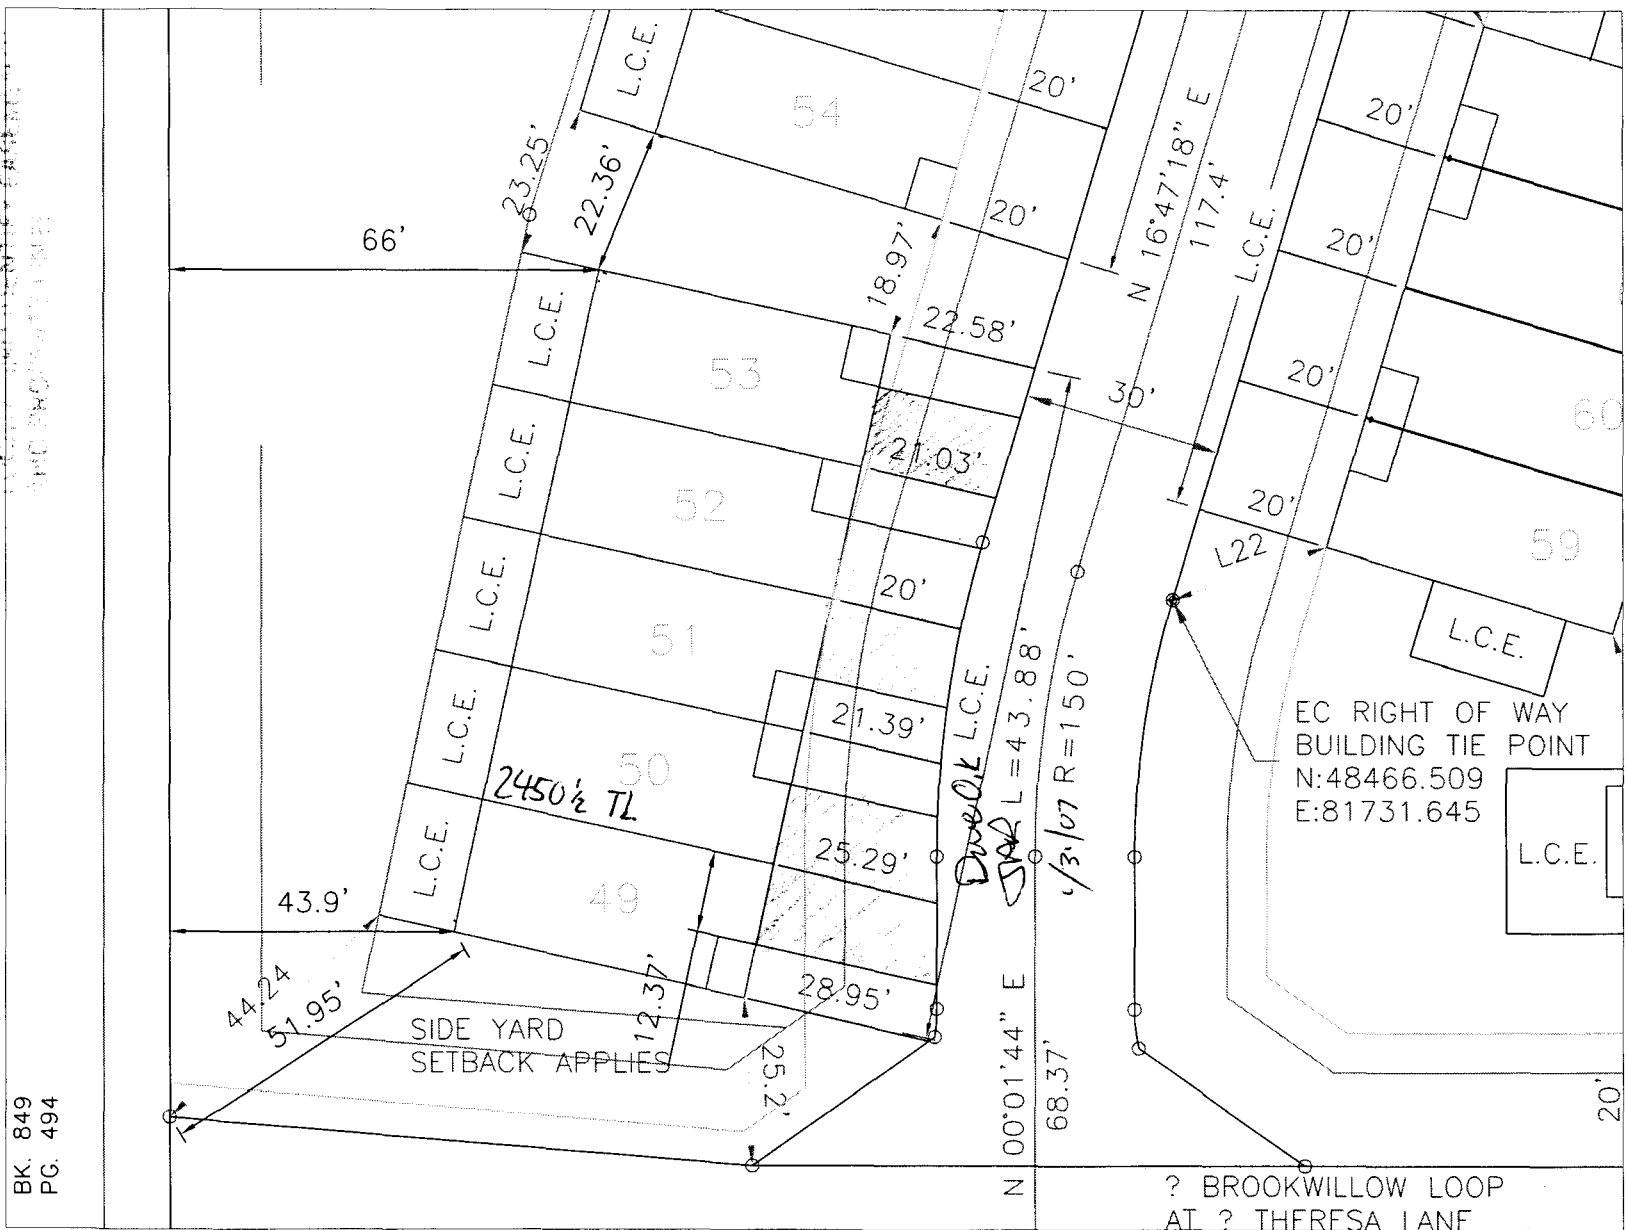

2450 1/2 Theresa Ln. Lot 50