

FEE \$	10
TCP \$	1589
SIF \$	460

**PLANNING CLEARANCE**  
 (Single Family Residential and Accessory Structures)  
**Community Development Department**

BLDG PERMIT NO. \_\_\_\_\_

*AL*

Building Address 411 Allison Way  
 Parcel No. 2943-164-21-006  
 Subdivision River Run  
 Filing 1 Block 1 Lot 6

No. of Existing Bldgs 0 No. Proposed 1  
 Sq. Ft. of Existing Bldgs 0 Sq. Ft. Proposed 1098  
 Sq. Ft. of Lot / Parcel 6029  
 Sq. Ft. Coverage of Lot by Structures & Impervious Surface  
 (Total Existing & Proposed) ~~1589~~ 2266 *48'*  
 Height of Proposed Structure \_\_\_\_\_

**OWNER INFORMATION:**

Name Darter LLC  
 Address 786 Valley Ct  
 City / State / Zip Grand Jct Co 81505

**DESCRIPTION OF WORK & INTENDED USE:**

New Single Family Home (\*check type below)  
 Interior Remodel  Addition  
 Other (please specify): \_\_\_\_\_

**APPLICANT INFORMATION:**

Name Grace Homes  
 Address 786 Valley Ct  
 City / State / Zip Grand Jct Co 81505  
 Telephone (970) 248-8511

**\*TYPE OF HOME PROPOSED:**

Site Built  Manufactured Home (UBC)  
 Manufactured Home (HUD)  
 Other (please specify): \_\_\_\_\_

NOTES: \_\_\_\_\_

**REQUIRED: One plot plan, on 8 1/2" x 11" paper, showing all existing & proposed structure location(s), parking, setbacks to all property lines, ingress/egress to the property, driveway location & width & all easements & rights-of-way which abut the parcel.**

THIS SECTION TO BE COMPLETED BY COMMUNITY DEVELOPMENT DEPARTMENT STAFF			
ZONE <u>R-8</u>	Maximum coverage of lot by structures <u>70%</u>		
SETBACKS: Front <u>30</u> from property line (PL)	Permanent Foundation Required: YES <input checked="" type="checkbox"/> NO <input type="checkbox"/>		
Side <u>5</u> from PL Rear <u>10</u> from PL	Parking Requirement <u>2</u>		
Maximum Height of Structure(s) <u>35</u>	Special Conditions _____		
Voting District <u>C</u>	Driveway Location Approval <u>PH</u> (Engineer's Initials)		

Modifications to this Planning Clearance must be approved, in writing, by the Community Development Department. The structure authorized by this application cannot be occupied until a final inspection has been completed and a Certificate of Occupancy has been issued, if applicable, by the Building Department (Section 305, Uniform Building Code).

I hereby acknowledge that I have read this application and the information is correct; I agree to comply with any and all codes, ordinances, laws, regulations or restrictions which apply to the project. I understand that failure to comply shall result in legal action, which may include but not necessarily be limited to non-use of the building(s).

Applicant Signature [Signature] for Grace Homes Date 6-19-08

Department Approval PH [Signature] Date 6/25/08

Additional water and/or sewer tap fee(s) are required: YES  NO  W/O No. 21112

Utility Accounting [Signature] Date 6/30/08

VALID FOR SIX MONTHS FROM DATE OF ISSUANCE (Section 2.2.C.1 Grand Junction Zoning & Development Code)  
 (White: Planning) (Yellow: Customer) (Pink: Building Department) (Goldenrod: Utility Accounting)

# Site & Plan Information

## 411 Allison Way

Subdivision	River Run	
Plan Name	1098	
Filing Number	1	
Block Number	1	
Lot Number	6	
County	Mesa	
Setbacks Used	Front	25
	Side	5
	Rear	20

## Sqft Information


Living Sqft	1098
Garage Sqft	411
Lot Size	6,029 Sqft

**Note:**  
DIMENSION LINES ARE PULLED FROM EDGE OF BRICK LEDGE. IF NO BRICK LEDGE EXISTS, DIMENSIONS WILL BE PULLED FROM EDGE OF FOUNDATION.


- NOTICE:**
- IT IS THE RESPONSIBILITY OF THE BUILDER OR OWNER TO VERIFY ALL DETAILS AND DIMENSIONS PRIOR TO CONSTRUCTION.
  - USE OF THIS PLAN CONSTITUTES BUILDER AND OR HOME OWNERS ACCEPTANCE OF THESE TERMS
  - BUILDER AND OR OWNER TO VERIFY ALL SETBACKS AND EASEMENTS
  - THIS PLAN HAS NOT BEEN ENGINEERED. SEE SEPARATE DRAWINGS BY OTHERS FOR ENGINEERING DATA.

**NOTE:**  
GRADE MUST SLOPE AWAY FROM HOUSE 6" OF FALL IN THE FIRST 10' OF DISTANCE PER LOCAL BUILDING CODE

**NOTE:**  
BUILDER TO VERIFY ALL SETBACK AND EASEMENT ENCROACHMENTS PRIOR TO CONSTRUCTION.

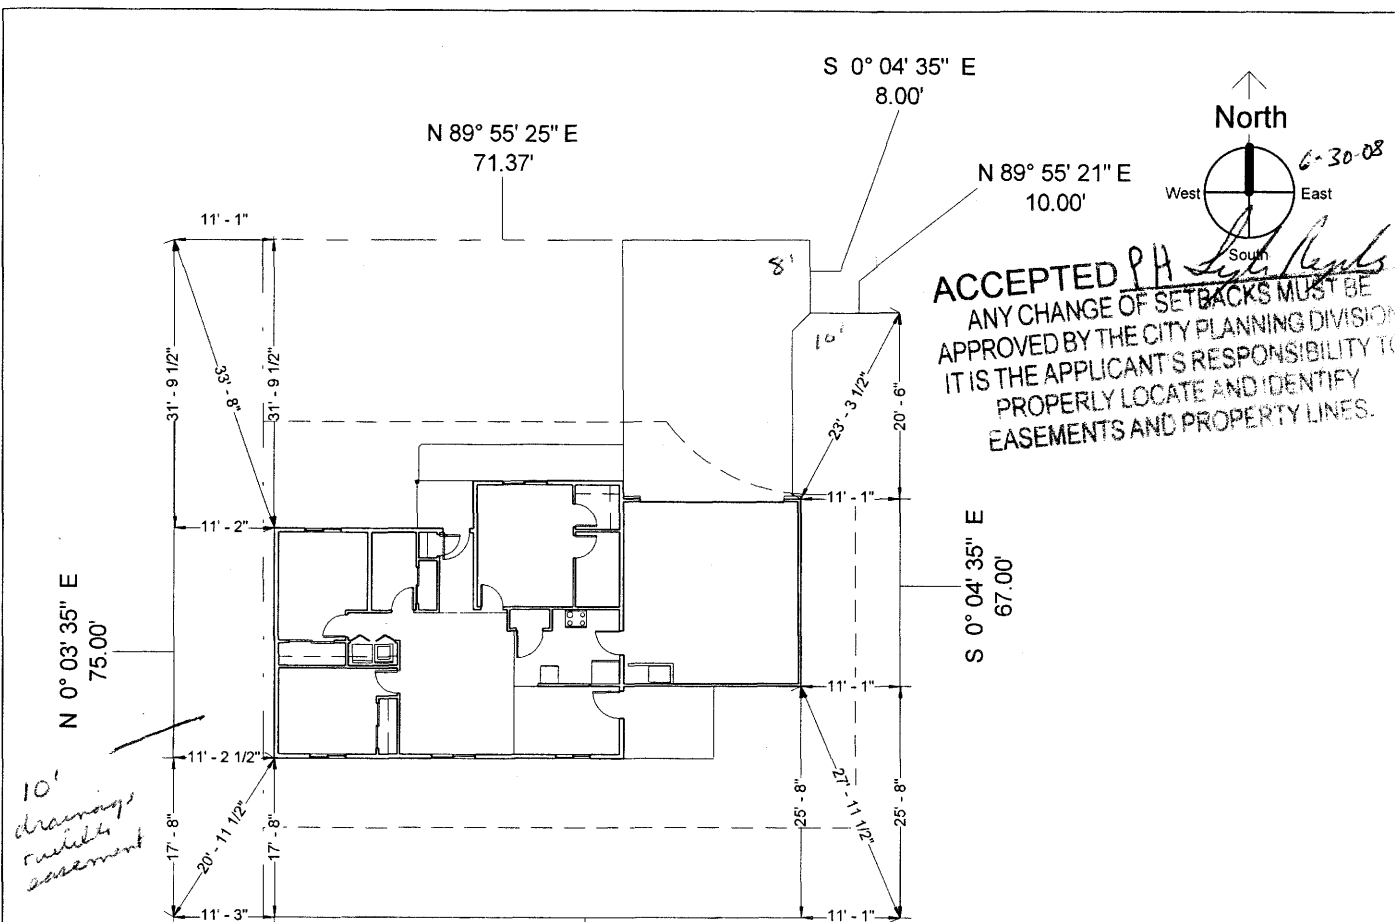

**ACCEPTED PA**  
 ANY CHANGE OF SETBACKS MUST BE APPROVED BY THE CITY PLANNING DIVISION. IT IS THE APPLICANT'S RESPONSIBILITY TO PROPERLY LOCATE AND IDENTIFY EASEMENTS AND PROPERTY LINES.

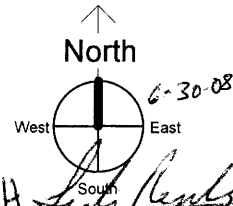

Flatwork Schedule	
Room Name	Area

Covered Entry	36 SF
Driveway	557 SF
Patio	83 SF
Sidewalk	97 SF
	<b>773 SF</b>

----- Setback Lines  
 ----- 10' Drainage and Utility Easement

1 Site Plan  
 1" = 20'-0"