

FEE \$	10 ⁰⁰
TCP \$	/
SIF \$	/

PLANNING CLEARANCE
 (Single Family Residential and Accessory Structures)
Community Development Department

BLDG PERMIT NO. _____

Building Address 2547 Brenna Way
 Parcel No. 2945-032466-002
 Subdivision Westwood Ranch
 Filing _____ Block _____ Lot _____

No. of Existing Bldgs 1 No. Proposed 0
 Sq. Ft. of Existing Bldgs ~1000ft Sq. Ft. Proposed 0
 Sq. Ft. of Lot / Parcel 10,890 ft
 Sq. Ft. Coverage of Lot by Structures & Impervious Surface
 (Total Existing & Proposed) _____
 Height of Proposed Structure ~10ft-12ft

OWNER INFORMATION:

Name Amy Rager
 Address same
 City / State / Zip CO 81505

DESCRIPTION OF WORK & INTENDED USE:

- New Single Family Home (*check type below)
- Interior Remodel Addition
- Other (please specify): deck x 2 (front + back)

APPLICANT INFORMATION:

Name same
 Address _____
 City / State / Zip _____
 Telephone 424-0263

***TYPE OF HOME PROPOSED:**

- Site Built Manufactured Home (UBC)
- Manufactured Home (HUD)
- Other (please specify): _____

NOTES: _____

REQUIRED: One plot plan, on 8 1/2" x 11" paper, showing all existing & proposed structure location(s), parking, setbacks to all property lines, ingress/egress to the property, driveway location & width & all easements & rights-of-way which abut the parcel.

THIS SECTION TO BE COMPLETED BY COMMUNITY DEVELOPMENT DEPARTMENT STAFF	
ZONE <u>PD</u>	Maximum coverage of lot by structures _____
SETBACKS: Front _____ from property line (PL)	Permanent Foundation Required: YES _____ NO _____
Side _____ from PL Rear _____ from PL	Parking Requirement _____
Maximum Height of Structure(s) <u>35'</u>	Special Conditions _____
Voting District _____ Driveway _____	PAID MAY 16 2008 IB
Location Approval _____ (Engineer's Initials)	

Modifications to this Planning Clearance must be approved, in writing, by the Community Development Department. The structure authorized by this application cannot be occupied until a final inspection has been completed and a Certificate of Occupancy has been issued, if applicable, by the Building Department (Section 305, Uniform Building Code).


I hereby acknowledge that I have read this application and the information is correct; I agree to comply with any and all codes, ordinances, laws, regulations or restrictions which apply to the project. I understand that failure to comply shall result in legal action, which may include but not necessarily be limited to non-use of the building(s).

Applicant Signature [Signature] Date 5/16/08
 Department Approval [Signature] Date 5/16/08

Additional water and/or sewer tap fee(s) are required:	YES	NO <input checked="" type="checkbox"/>	W/O No.
--	-----	--	---------

Utility Accounting <u>[Signature]</u>	Date <u>5/16/08</u>
---------------------------------------	---------------------

VALID FOR SIX MONTHS FROM DATE OF ISSUANCE (Section 2.2.C.1 Grand Junction Zoning & Development Code)
 (White: Planning) (Yellow: Customer) (Pink: Building Department) (Goldenrod: Utility Accounting)

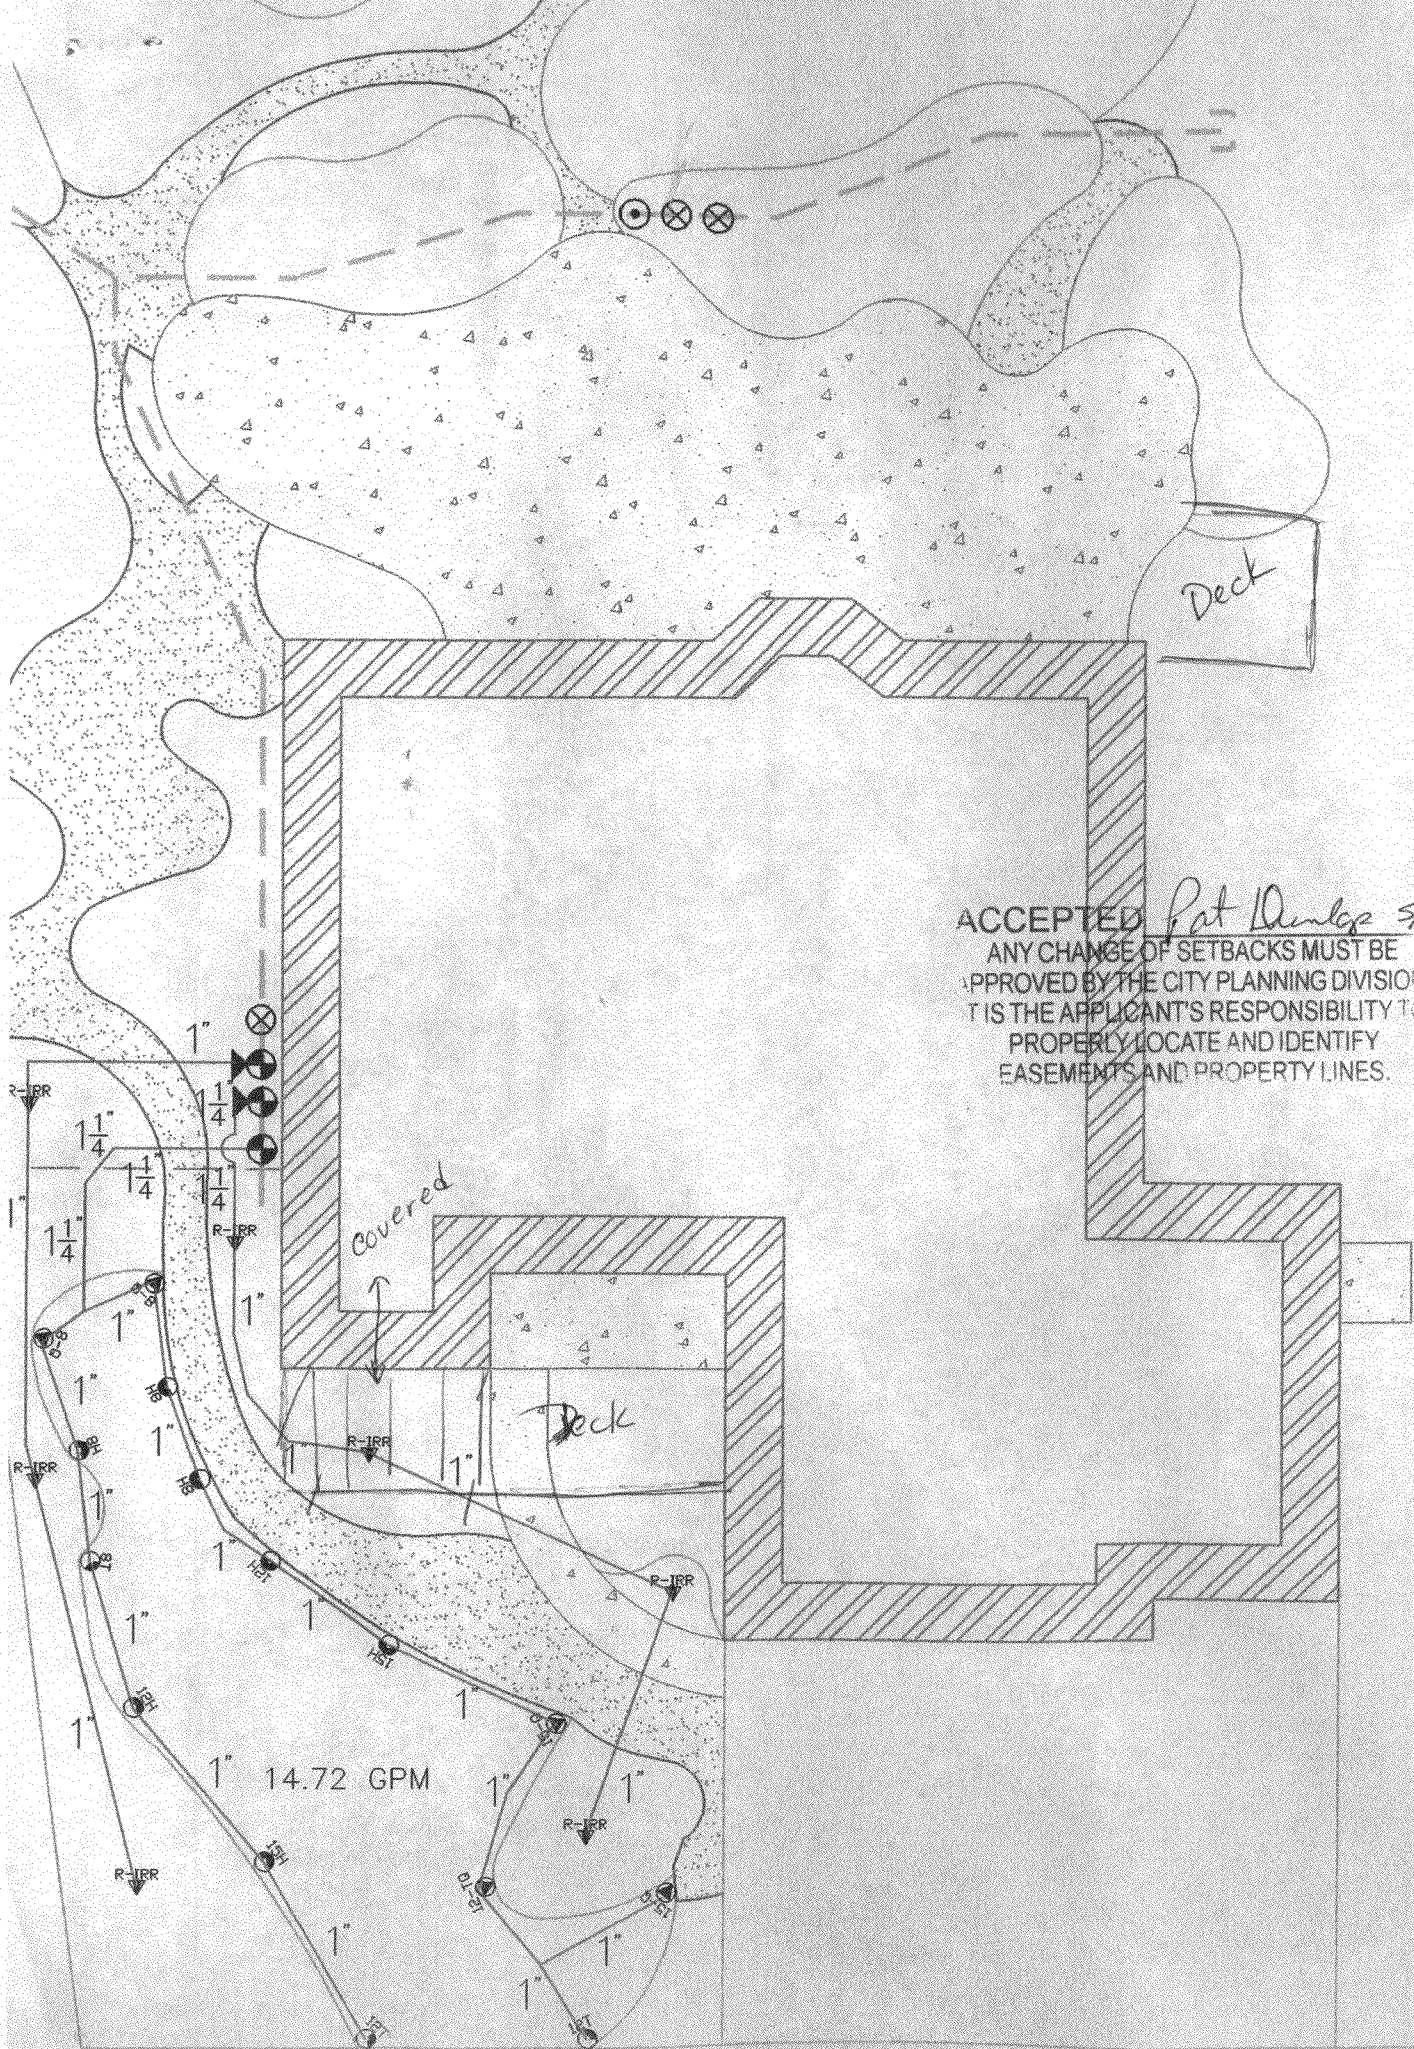

ACCEPTED *Pat Dunlop 5/16/08*
 ANY CHANGE OF SETBACKS MUST BE APPROVED BY THE CITY PLANNING DIVISION. IT IS THE APPLICANT'S RESPONSIBILITY TO PROPERLY LOCATE AND IDENTIFY EASEMENTS AND PROPERTY LINES.

14.72 GPM