

FEE \$	10 <sup>-</sup>
TCP \$	1589 <sup>-</sup>
SIF \$	460 <sup>-</sup>

**PLANNING CLEARANCE**  
 (Single Family Residential and Accessory Structures)  
**Community Development Department**

BLDG PERMIT NO. \_\_\_\_\_

*29*

Building Address <sup>2914</sup> 2924 Brookview Ln.  
 Parcel No. 2943-292-37-008  
 Subdivision Riverview Estates  
 Filing 1 Block 2 Lot 8

No. of Existing Bldgs 0 No. Proposed 1  
 Sq. Ft. of Existing Bldgs 0 Sq. Ft. Proposed 2615  
 Sq. Ft. of Lot / Parcel 8009  
 Sq. Ft. Coverage of Lot by Structures & Impervious Surface  
 (Total Existing & Proposed) 2615 + 638 = 3253 = 40%  
 Height of Proposed Structure 20

**OWNER INFORMATION:**

Name R&D Quality Builders, LLC.  
 Address 1760 Lucki Dr.  
 City / State / Zip Fruita, CO 81521

**DESCRIPTION OF WORK & INTENDED USE:**

New Single Family Home (\*check type below)  
 Interior Remodel  Addition  
 Other (please specify): \_\_\_\_\_

**APPLICANT INFORMATION:**

Name R&D Quality Builders, LLC  
 Address 1760 Lucki Dr.  
 City / State / Zip Fruita, CO 81521  
 Telephone 234-0717

**\*TYPE OF HOME PROPOSED:**

Site Built  Manufactured Home (UBC)  
 Manufactured Home (HUD)  
 Other (please specify): \_\_\_\_\_

NOTES: easement ~~release~~ release 10/17/07 per Dave Thinter

**REQUIRED: One plot plan, on 8 1/2" x 11" paper, showing all existing & proposed structure location(s), parking, setbacks to all property lines, ingress/egress to the property, driveway location & width & all easements & rights-of-way which abut the parcel.**

THIS SECTION TO BE COMPLETED BY COMMUNITY DEVELOPMENT DEPARTMENT STAFF	
ZONE <u>R-4</u>	Maximum coverage of lot by structures <u>50%</u>
SETBACKS: Front <u>20</u> from property line (PL)	Permanent Foundation Required: YES <input checked="" type="checkbox"/> NO <input type="checkbox"/>
Side <u>7</u> from PL Rear <u>25</u> from PL	Parking Requirement <u>2</u>
Maximum Height of Structure(s) <u>35</u>	Special Conditions _____
Voting District <u>E</u> Driveway Location Approval <u>PD</u> (Engineer's Initials)	_____

Modifications to this Planning Clearance must be approved, in writing, by the Community Development Department. The structure authorized by this application cannot be occupied until a final inspection has been completed and a Certificate of Occupancy has been issued, if applicable, by the Building Department (Section 305, Uniform Building Code).

I hereby acknowledge that I have read this application and the information is correct; I agree to comply with any and all codes, ordinances, laws, regulations or restrictions which apply to the project. I understand that failure to comply shall result in legal action, which may include but not necessarily be limited to non-use of the building(s).


Applicant Signature [Signature] Date 2-8-08

Department Approval PO Paul Hennleach Date 3/19/08

Additional water and/or sewer tap fee(s) are required:	YES <input checked="" type="checkbox"/>	NO <input type="checkbox"/>	W/O No. <u>PD@OmsD</u>
Utility Accounting <u>[Signature]</u>	Date <u>3/11/08</u>		

VALID FOR SIX MONTHS FROM DATE OF ISSUANCE (Section 2.2.C.1 Grand Junction Zoning & Development Code)  
 (White: Planning) (Yellow: Customer) (Pink: Building Department) (Goldenrod: Utility Accounting)

ACCEPTED *PO Paul Henshel*  
 ANY CHANGE OF SETBACKS MUST BE APPROVED BY THE CITY PLANNING DIVISION.  
 IT IS THE APPLICANT'S RESPONSIBILITY TO PROPERLY LOCATE AND IDENTIFY EASEMENTS AND PROPERTY LINES.

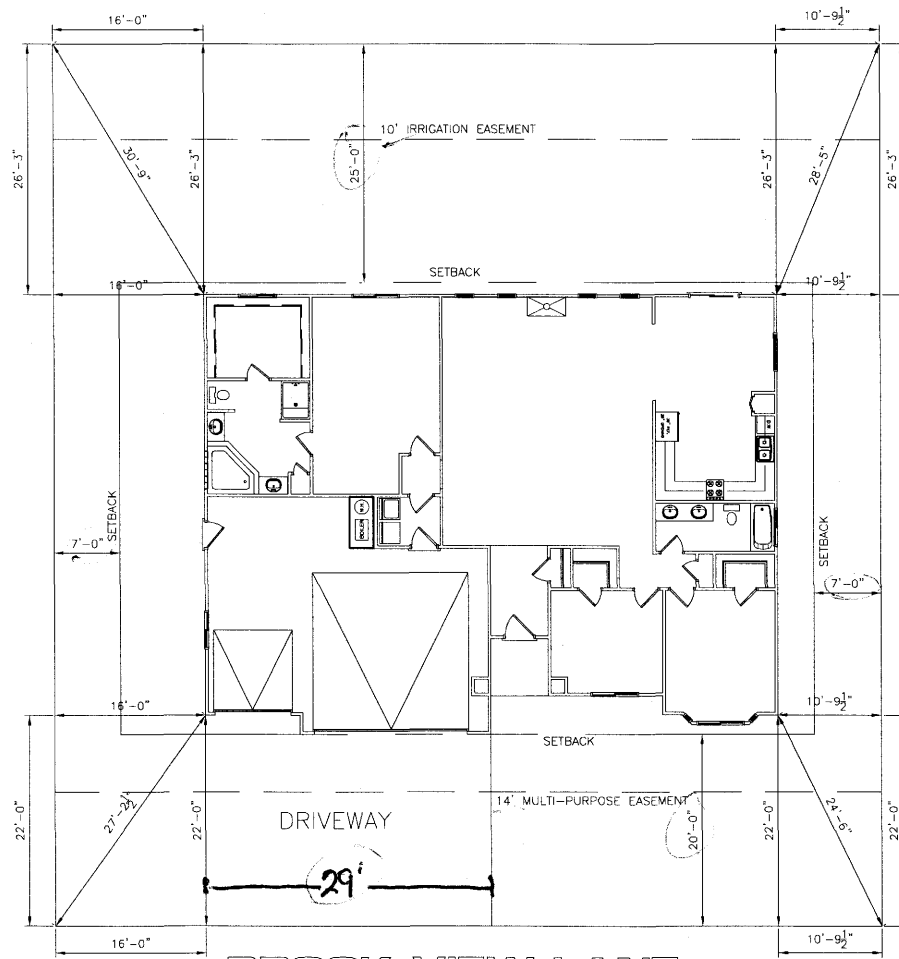


Drive OK  
 Pat 2/19/08

NOTICE:  
 1. IT IS THE RESPONSIBILITY OF THE BUILDER OR OWNER TO VERIFY ALL DETAILS AND DIMENSIONS PRIOR TO CONSTRUCTION.  
 2. USE OF THIS PLAN CONSTITUTES BUILDER AND OR HOME OWNERS ACCEPTANCE OF THESE TERMS.  
 3. ALL DIMENSIONS ARE TO EDGE OF FOUNDATION UNLESS OTHER WISE NOTED.  
 4. BUILDER AND OR OWNER TO VERIFY ALL SETBACKS AND EASEMENTS.  
 5. THIS PLAN HAS NOT BEEN ENGINEERED BY AUTODRAFT. SEE SEPARATE DRAWINGS BY OTHERS FOR ENGINEERING DATA.

NOTE:  
 GRADE MUST SLOPE AWAY FROM HOUSE 6" OF FALL IN THE FIRST 10' OF DISTANCE PER LOCAL BUILDING CODE.

NOTE:  
 DIMENSION LINES ARE PULLED FROM EDGE OF BRICK LEDGE. IF NO BRICK LEDGE EXISTS, DIMENSIONS WILL BE FROM EDGE OF FOUNDATION.

NOTE:  
 BUILDER TO VERIFY ALL SETBACK AND EASEMENT ENCROACHMENTS PRIOR TO CONSTRUCTION

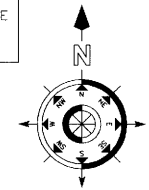

SITE PLAN INFORMATION	
SUBDIVISION NAME	RIVERVIEW ESTATES
FILING NUMBER	N/A
MODEL TYPE	N/A
LOT NUMBER	8
BLOCK NUMBER	2
STREET ADDRESS	2914 BROOK VIEW LANE
COUNTY	MESA
GARAGE SQ. FT.	656 SF
LIVING SQ. FT.	1959 SF
LOT SIZE	8009 SF
SETBACKS USED	FRONT 20' SIDES 7' REAR 25'

SCALE: 1"=20'-0"