

FEE \$	10-
TCP \$	1589-
SIF \$	460-

**PLANNING CLEARANCE**  
 (Single Family Residential and Accessory Structures)  
**Community Development Department**

BLDG PERMIT NO. \_\_\_\_\_

*Handwritten initials*

Building Address 307 Carriage Hills Ct.  
 Parcel No. 2945-244-46-002  
 Subdivision Carriage Hills  
 Filing \_\_\_\_\_ Block 2 Lot 2

No. of Existing Bldgs 0 No. Proposed 1  
 Sq. Ft. of Existing Bldgs \_\_\_\_\_ Sq. Ft. Proposed 1993  
 Sq. Ft. of Lot / Parcel \_\_\_\_\_  
 Sq. Ft. Coverage of Lot by Structures & Impervious Surface (Total Existing & Proposed) \_\_\_\_\_  
 Height of Proposed Structure \_\_\_\_\_

**OWNER INFORMATION:**

Name Escalante Builders, LLC  
 Address 818 Montclair Drive  
 City / State / Zip Palisade, CO 81526

DESCRIPTION OF WORK & INTENDED USE:  
 New Single Family Home (\*check type below)  
 Interior Remodel  Addition  
 Other (please specify): \_\_\_\_\_

**APPLICANT INFORMATION:**

Name Escalante Builders, LLC  
 Address 818 Montclair Drive  
 City / State / Zip Palisade, CO 81526  
 Telephone 970-464-1284

\*TYPE OF HOME PROPOSED:  
 Site Built  Manufactured Home (UBC)  
 Manufactured Home (HUD)  
 Other (please specify): \_\_\_\_\_

NOTES: \_\_\_\_\_

**REQUIRED: One plot plan, on 8 1/2" x 11" paper, showing all existing & proposed structure location(s), parking, setbacks to all property lines, ingress/egress to the property, driveway location & width & all easements & rights-of-way which abut the parcel.**

THIS SECTION TO BE COMPLETED BY COMMUNITY DEVELOPMENT DEPARTMENT STAFF	
ZONE <u>R-8</u>	Maximum coverage of lot by structures <u>70%</u>
SETBACKS: Front <u>20'</u> from property line (PL)	Permanent Foundation Required: YES <input checked="" type="checkbox"/> NO _____
Side <u>5'</u> from PL Rear <u>10'</u> from PL	Parking Requirement <u>2</u>
Maximum Height of Structure(s) <u>35'</u>	Special Conditions _____
Voting District <u>E</u> Driveway Location Approval <u>PD</u> (Engineer's Initials)	_____

Modifications to this Planning Clearance must be approved, in writing, by the Community Development Department. The structure authorized by this application cannot be occupied until a final inspection has been completed and a Certificate of Occupancy has been issued, if applicable, by the Building Department (Section 305, Uniform Building Code).


I hereby acknowledge that I have read this application and the information is correct; I agree to comply with any and all codes, ordinances, laws, regulations or restrictions which apply to the project. I understand that failure to comply shall result in legal action, which may include but not necessarily be limited to non-use of the building(s).

Applicant Signature Margaret C. Cox Date 2-25-08  
 Department Approval PD Paul Hornbeck Date 2-27-08


Additional water and/or sewer tap fee(s) are required: YES <input checked="" type="checkbox"/> NO _____	W/O No. <u>20907</u>
Utility Accounting <u>CW Cole</u>	Date <u>2/27/08</u>

VALID FOR SIX MONTHS FROM DATE OF ISSUANCE (Section 2.2.C.1 Grand Junction Zoning & Development Code)  
 (White: Planning) (Yellow: Customer) (Pink: Building Department) (Goldenrod: Utility Accounting)

ACCEPTED *PO Paul Hornbeck*  
 ANY CHANGE OF SETBACKS MUST BE  
 APPROVED BY THE CITY PLANNING DIVISION.  
 IT IS THE APPLICANT'S RESPONSIBILITY TO  
 PROPERLY LOCATE AND IDENTIFY  
 EASEMENTS AND PROPERTY LINES.

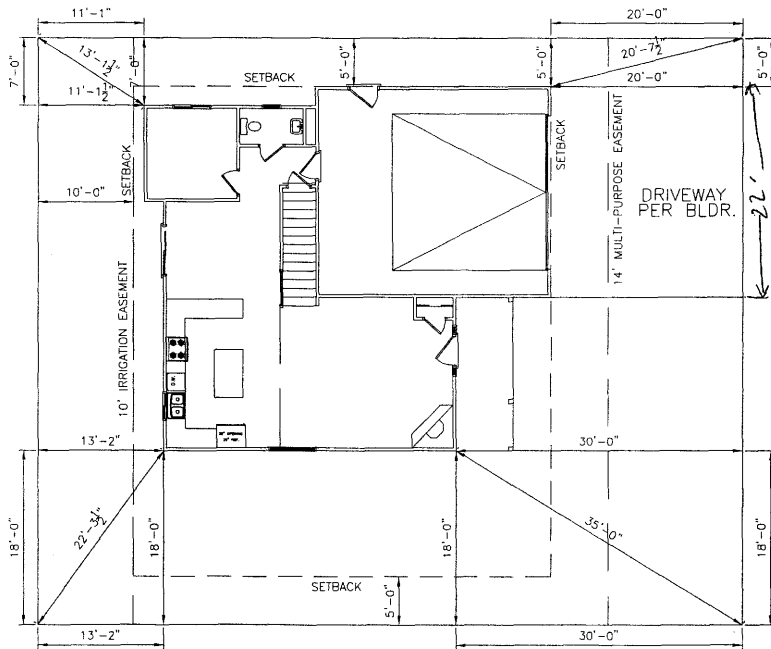

*Drive OK  
 Ret 7/21/08*

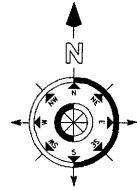

NOTE:  
 BUILDER TO VERIFY  
 ALL SETBACK AND EASEMENT  
 ENCROACHMENTS PRIOR  
 TO CONSTRUCTION

NOTE:  
 DIMENSION LINES ARE PULLED FROM  
 EDGE OF BRICK LEDGE. IF NO BRICK LEDGE  
 EXISTS, DIMENSIONS WILL BE FROM EDGE  
 OF FOUNDATION.

NOTE  
 GRADE MUST SLOPE AWAY FROM HOUSE 6" OF FALL IN  
 THE FIRST 10' OF DISTANCE PER LOCAL BUILDING CODE.

- NOTICE:
1. IT IS THE RESPONSIBILITY OF THE BUILDER OR OWNER TO VERIFY ALL DETAILS AND DIMENSIONS PRIOR TO CONSTRUCTION.
  2. USE OF THIS PLAN CONSTITUTES BUILDER AND OR HOME OWNERS ACCEPTANCE OF THESE TERMS.
  3. ALL DIMENSIONS ARE TO EDGE OF FOUNDATION UNLESS OTHER WISE NOTED.
  4. BUILDER AND OR OWNER TO VERIFY ALL SETBACKS AND EASEMENTS.
  5. THIS PLAN HAS NOT BEEN ENGINEERED BY AUTODRAFT. SEE SEPARATE DRAWINGS BY OTHERS FOR ENGINEERING DATA.

SITE PLAN INFORMATION	
SUBDIVISION NAME	CARRIAGE HILLS
FILING NUMBER	N/A
LOT NUMBER	2
BLOCK NUMBER	2
STREET ADDRESS	307 CARRIAGE HILLS COURT
COUNTY	MESA
GARAGE SQ. FT.	540 SF
COVERED ENTRY SQ. FT.	86 SF
COVERED PATIO SQ. FT.	N/A
LIVING SQ. FT.	1993 SF
LOT SIZE	4522 SF
SETBACKS USED	FRONT 20'
	SIDES 5'
	REAR 10'

**SCALE: 1"=20'-0"**