

72

FEE \$	10.00
TCP \$	1,039.00
SIF \$	400.00

PLANNING CLEARANCE
(Single Family Residential and Accessory Structures)
Community Development Department

BLDG PERMIT NO. _____

Building Address 332 CLIFF VIEW No. of Existing Bldgs _____ No. Proposed 1
 Parcel No. 294520110012945-201-63-031 Sq. Ft. of Existing Bldgs _____ Sq. Ft. Proposed 24382007
 Subdivision SHADOW RUN Sq. Ft. of Lot / Parcel 2039 1426
 Filing NA Block H.A Lot 30 Sq. Ft. Coverage of Lot by Structures & Impervious Surface (Total Existing & Proposed) _____
 Height of Proposed Structure 26' 1746

OWNER INFORMATION:
 Name HARVEST HOMES
 Address 4833 FRONT ST.
 City / State / Zip CR. CO 81504

DESCRIPTION OF WORK & INTENDED USE:
 New Single Family Home (*check type below)
 Interior Remodel Addition
 Other (please specify): _____

APPLICANT INFORMATION:
 Name CHARLES BEAN
JAMES SANTIACROCE
 Address 632 KAREN COURT 2481 BROADWAY
 City / State / Zip GS CO 81508
 Telephone 970-245-5958

***TYPE OF HOME PROPOSED:**
 Site Built Manufactured Home (UBC)
 Manufactured Home (HUD)
 Other (please specify): _____

PAID

NOTES: 4-Plex

REQUIRED: One plot plan, on 8 1/2" x 11" paper, showing all existing & proposed structure location(s), parking, setbacks to all property lines, ingress/egress to the property, driveway location & width & all easements & rights-of-way which abut the parcel.

THIS SECTION TO BE COMPLETED BY COMMUNITY DEVELOPMENT DEPARTMENT STAFF	
ZONE <u>PD</u>	Maximum coverage of lot by structures _____
SETBACKS: Front <u>20'</u> from property line (PL)	Permanent Foundation Required: YES <u>X</u> NO _____
Side <u>-</u> from PL Rear <u>-</u> from PL	Parking Requirement <u>2</u>
Maximum Height of Structure(s) <u>30/Ranch - 26/2-Story</u>	Special Conditions <u>per building envelope</u>
Voting District <u>A</u>	Driveway Location Approval <u>SH</u> (Engineer's Initials)

Modifications to this Planning Clearance must be approved, in writing, by the Community Development Department. The structure authorized by this application cannot be occupied until a final inspection has been completed and a Certificate of Occupancy has been issued, if applicable, by the Building Department (Section 305, Uniform Building Code).

I hereby acknowledge that I have read this application and the information is correct; I agree to comply with any and all codes, ordinances, laws, regulations or restrictions which apply to the project. I understand that failure to comply shall result in legal action, which may include but not necessarily be limited to non-use of the building(s).

Applicant Signature Ch Co Date 10 Mar 08

Department Approval NA Y/ku Magan Date 4/17/08


Additional water and/or sewer tap fee(s) are required:	YES <u>X</u> NO _____	W/O No. <u>20926</u>
Utility Accounting <u>W Bousley</u>	Date _____	

VALID FOR SIX MONTHS FROM DATE OF ISSUANCE (Section 2.2.C.1 Grand Junction Zoning & Development Code)
 (White: Planning) (Yellow: Customer) (Pink: Building Department) (Goldenrod: Utility Accounting)

RIDGES
MAJOR CC
(ROW WIDTH)

John W. Wagner

$\Delta = 36^{\circ}07'40''$
RAD = 480.00'
ARC = 302.66'
CH = 297.67'
CH BRG = N47°18'31"E

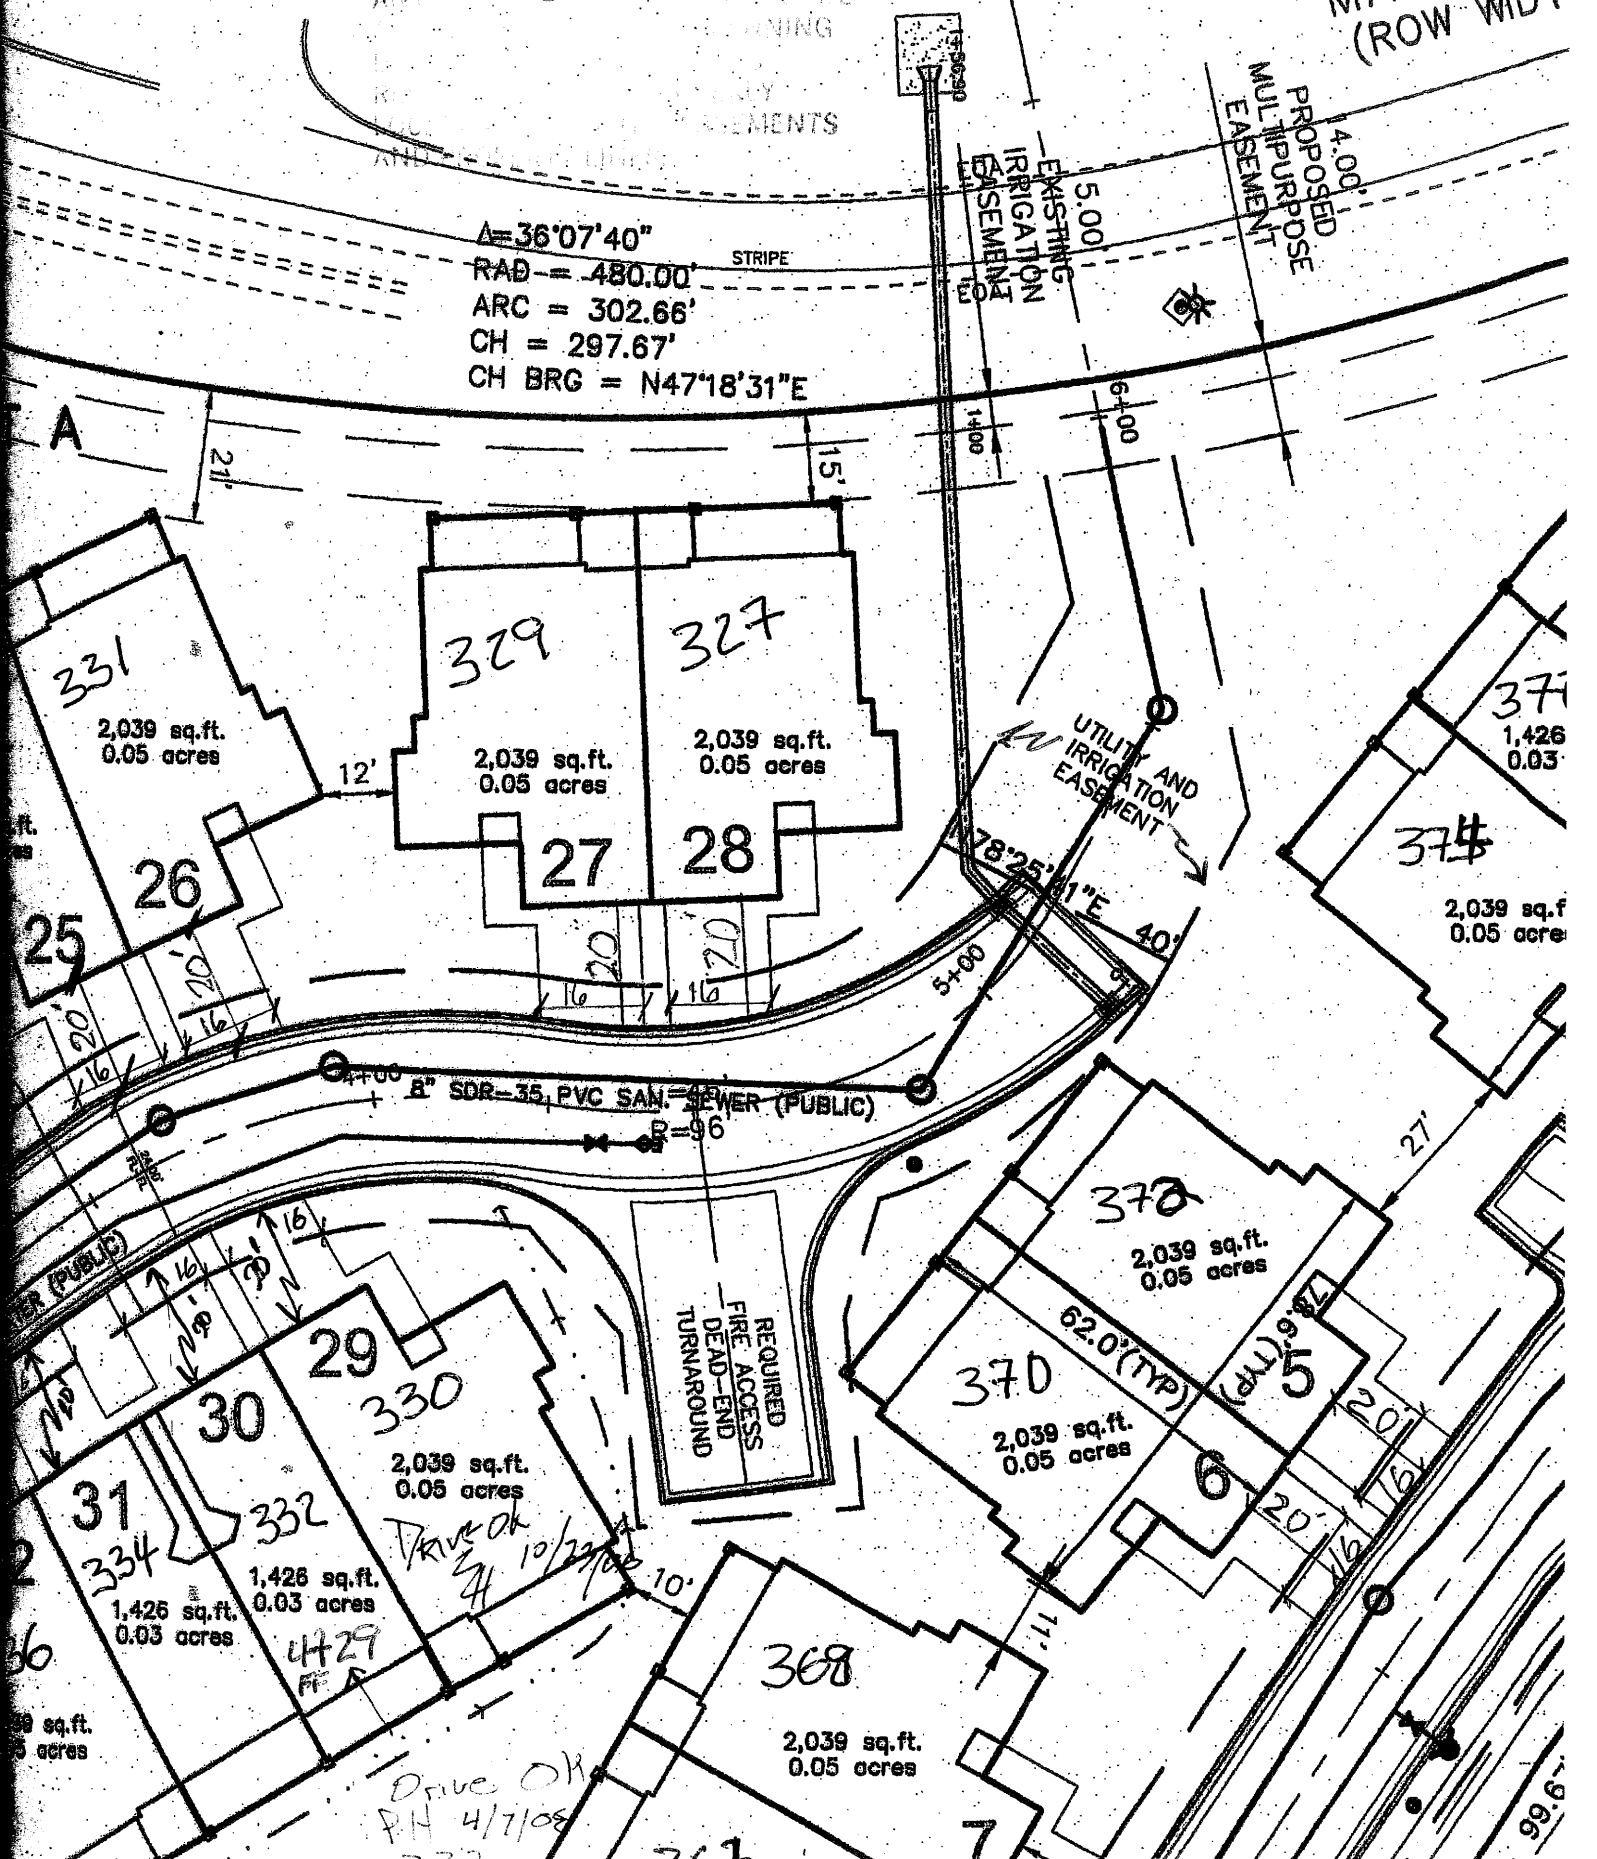

(392)

Drive OK
PH 4/7/08
237

REQUIRED
FIRE ACCESS
DEAD-END
TURNAROUND

UTILITY AND
IRRIGATION
EASEMENT

PROPOSED
MULTIPURPOSE
EASEMENT
4.00'

EXISTING
IRRIGATION
EASEMENT
5.00'

STRIPE

sq. ft.
acres

99.6'