

FEE \$	10. ⁰⁰
TCP \$	2,554
SIF \$	460

PLANNING CLEARANCE
 (Single Family Residential and Accessory Structures)
Community Development Department

BLDG PERMIT NO. _____

Building Address 3,024 2945 Four Leaf Clover No. of Existing Bldgs 0 No. Proposed 1
 Parcel No. 2943-052-84-007 Sq. Ft. of Existing Bldgs 0 Sq. Ft. Proposed 2144
 Subdivision CLAREFLOW SUB Sq. Ft. of Lot / Parcel 6751 SQFT
 Filing 1 Block 1 Lot 7 Sq. Ft. Coverage of Lot by Structures & Impervious Surface (Total Existing & Proposed) 2750 SQFT 40%
 Height of Proposed Structure 27'

OWNER INFORMATION:

Name SKELTON CONSTRUCTION INC.
 Address P.O. Box 4247
 City / State / Zip G.J. Co 81502

DESCRIPTION OF WORK & INTENDED USE:

New Single Family Home (*check type below)
 Interior Remodel Addition
 Other (please specify): _____

APPLICANT INFORMATION:

Name SKELTON CONSTRUCTION INC.
 Address P.O. Box 4247
 City / State / Zip G.J. Co 81502
 Telephone 245-9008

***TYPE OF HOME PROPOSED:**

Site Built Manufactured Home (UBC)
 Manufactured Home (HUD)
 Other (please specify): _____

NOTES: _____

PAID

FB

REQUIRED: One plot plan, on 8 1/2" x 11" paper, showing all existing & proposed structure location(s), parking, setbacks to all property lines, ingress/egress to the property, driveway location & width & all easements & rights-of-way which abut the parcel.

THIS SECTION TO BE COMPLETED BY COMMUNITY DEVELOPMENT DEPARTMENT STAFF	
ZONE <u>R-5</u>	Maximum coverage of lot by structures <u>60%</u>
SETBACKS: Front <u>20</u> from property line (PL)	Permanent Foundation Required: YES <input checked="" type="checkbox"/> NO <input type="checkbox"/>
Side <u>5</u> from PL Rear <u>25'</u> from PL	Parking Requirement <u>2</u>
Maximum Height of Structure(s) <u>35'</u>	Special Conditions _____
Voting District <u>"D"</u> Driveway Location Approval <u>RL</u> (Engineer's Initials)	_____


Modifications to this Planning Clearance must be approved, in writing, by the Community Development Department. The structure authorized by this application cannot be occupied until a final inspection has been completed and a Certificate of Occupancy has been issued, if applicable, by the Building Department (Section 305, Uniform Building Code).

I hereby acknowledge that I have read this application and the information is correct; I agree to comply with any and all codes, ordinances, laws, regulations or restrictions which apply to the project. I understand that failure to comply shall result in legal action, which may include but not necessarily be limited to non-use of the building(s).

Applicant Signature Jackie Skelton Date 7/7/08
 Department Approval AR Hayden Henderson Date 7/7/08

Additional water and/or sewer tap fee(s) are required:	YES <input checked="" type="checkbox"/> NO <input type="checkbox"/>	W/O No. <u>PD (6-USD)</u>
Utility Accounting <u>C. Benseley</u>	Date <u>7/7/08</u>	

VALID FOR SIX MONTHS FROM DATE OF ISSUANCE (Section 2.2.C.1 Grand Junction Zoning & Development Code)
 (White: Planning) (Yellow: Customer) (Pink: Building Department) (Goldenrod: Utility Accounting)

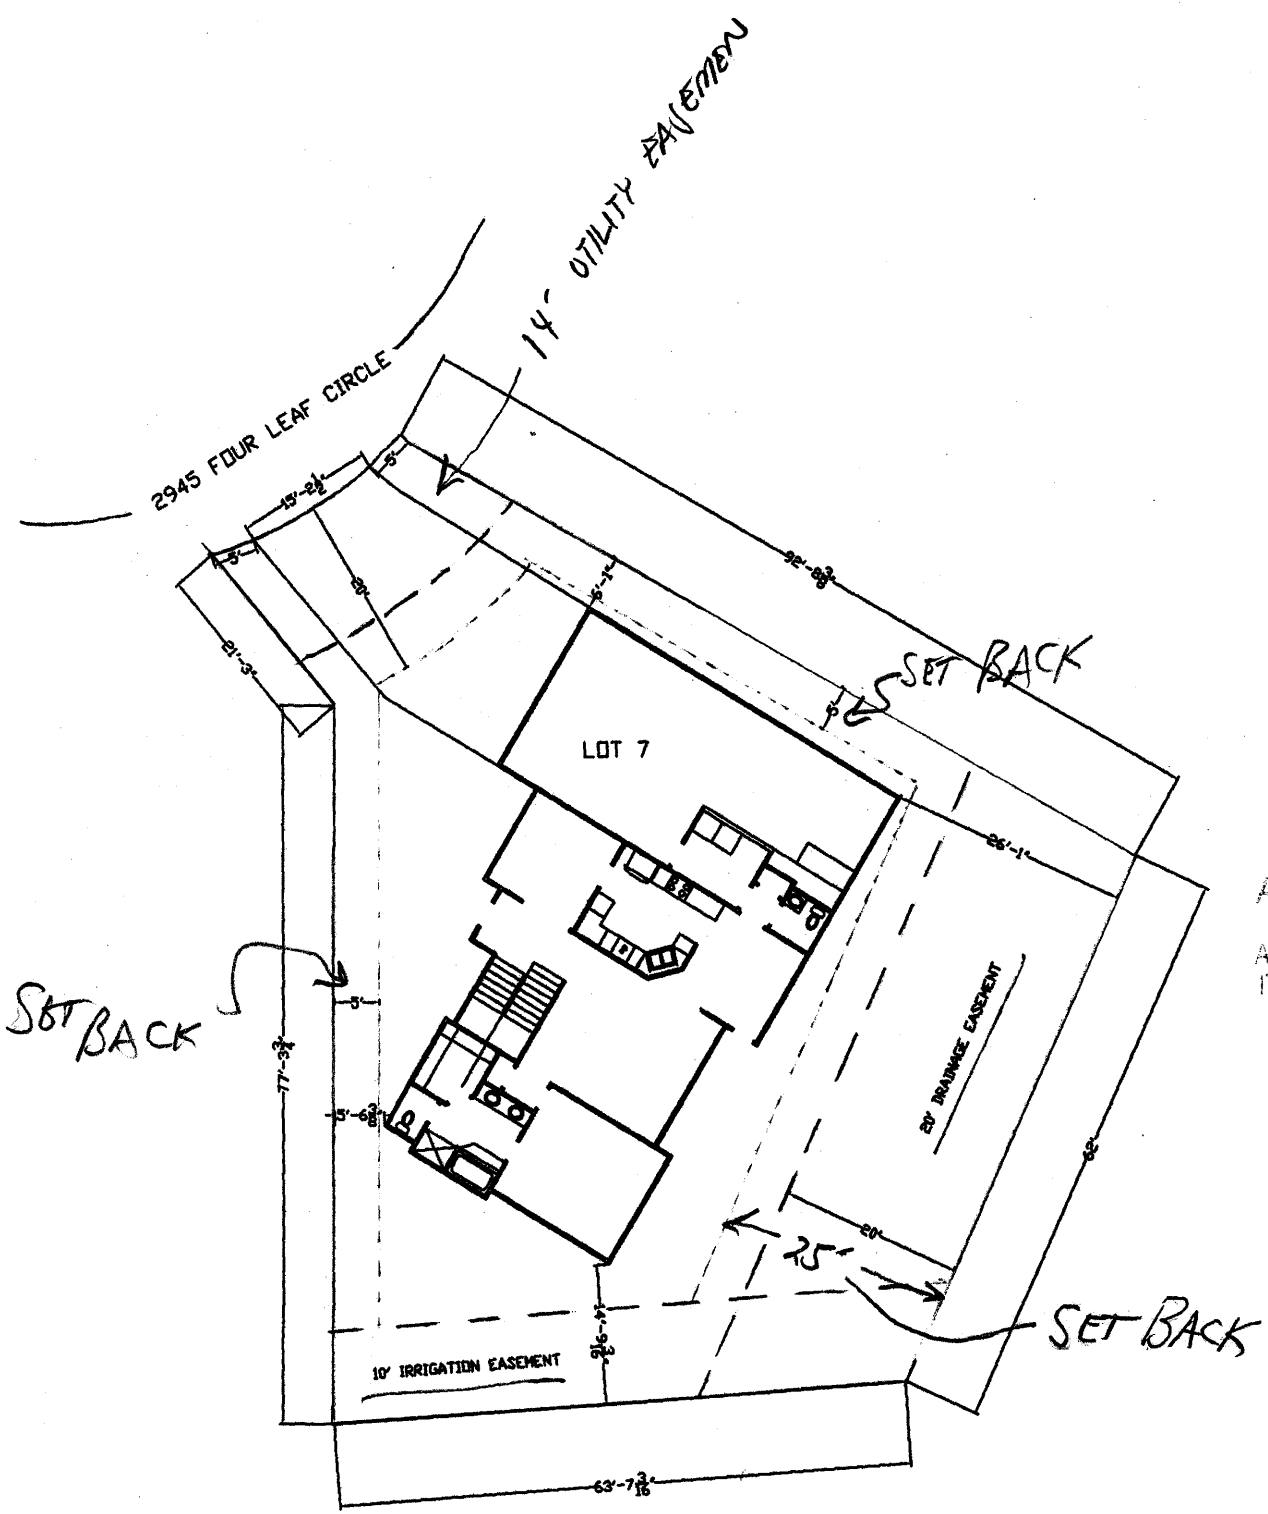

ACCEPTED *JR Henderson*
 ANY CHANGE OF SETBACKS MUST BE APPROVED BY THE CITY PLANNING DIVISION. IT IS THE APPLICANT'S RESPONSIBILITY TO PROPERLY LOCATE AND IDENTIFY EASEMENTS AND PROPERTY LINES.