
//							
FEE \$ 10,00 PLANNING CLE	BLDG PERMIT NO.						
TCP \$ 1589.06 (Single Family Residential and	Accessory Structures)						
SIF \$ 460.00 <u>Community Developm</u>	nent Department						
Building Address 656 Levi Ct.	No. of Existing Bldgs N/H No. Proposed						
Parcel No. 2945-024-30-005	Sq. Ft. of Existing Bldgs N/H Sq. Ft. Proposed 2368						
Subdivision Logan Creek Sub	Sq. Ft. of Lot / Parcel <u>e 24 acre</u>						
Filing Block Lot _5 OWNER INFORMATION:	Sq. Ft. Coverage of Lot by Structures & Impervious Surface (Total Existing & Proposed) <u>みになっています。 Height of Proposed Structure ススイナーンろ</u>						
Name Jason + Kiley Thrompson	DESCRIPTION OF WORK & INTENDED USE:						
Address Illes Dyer Rd.	New Single Family Home (*check type below) Interior Remodel Other (please specify):						
City/State/Zip Whitewater, COSIS27							
APPLICANT INFORMATION:	*TYPE OF HOME PROPOSED:						
Name Jason & Kiley Thompson	Manufactured Home (HUD)						
Address 1163 Dyer Rd.	Other (please specify):						
City/State/Zip Whitewater, 10 8507 N	NOTES: 1951' down living w/ 690' caray						
Telephone <u>970 2013660</u>	NOTES: 1951' down living w/ 690' carcy						
REQUIRED: One plot plan, on 8 1/2" x 11" paper, showing all existing & proposed structure location(s), parking, setbacks to all property lines, ingress/egress to the property, driveway location & width & all easements & rights-of-way which abut the parcel.							
THIS SECTION TO BE COMPLETED BY COM	MMUNITY DEVELOPMENT DEPARTMENT STAFF						
ZONE <u>R-4</u>	Maximum coverage of lot by structures5070						
SETBACKS: Front 20 from property line (PL)	Permanent Foundation Required: YESNO						
Side 7from PL Rearfrom PL	Parking Requirement 2						
Maximum Height of Structure(s)35 '	Special Conditions						
Voting DistrictB Driveway Location Approval(Engineer's Initial	,						
	d, in writing, by the Community Development Department. The I until a final inspection has been completed and a Certificate of Department (Section 305, Uniform Building Code).						

1

I hereby acknowledge that I have read this application and the information is correct; I agree to comply with any and all codes, ordinances, laws, regulations or restrictions which apply to the project. I understand that failure to comply shall result in legal action, which may include but not necessarily be limited to non-use of the building(s).

Applicant Signature	Ja Thy		Da	ate2	5/2	9/08	
Department Approval TR Jychin Reyrolds Date 5/23/08							
Additional water and/or se	ewer tap fee(s) are required:	YE\$ NO	2	W/O No.	推	- 2106/	
Utility Accounting	Ci		Date	to	Íý	158	
VALID FOR SIX MONTHS FROM DATE OF ISSUANCE (Section 2.2.C.1 Grand Junction Zoning & Development Code) (White: Planning) (Yellow: Customer) (Pink: Building Department) (Goldenrod: Utility Accounting)							

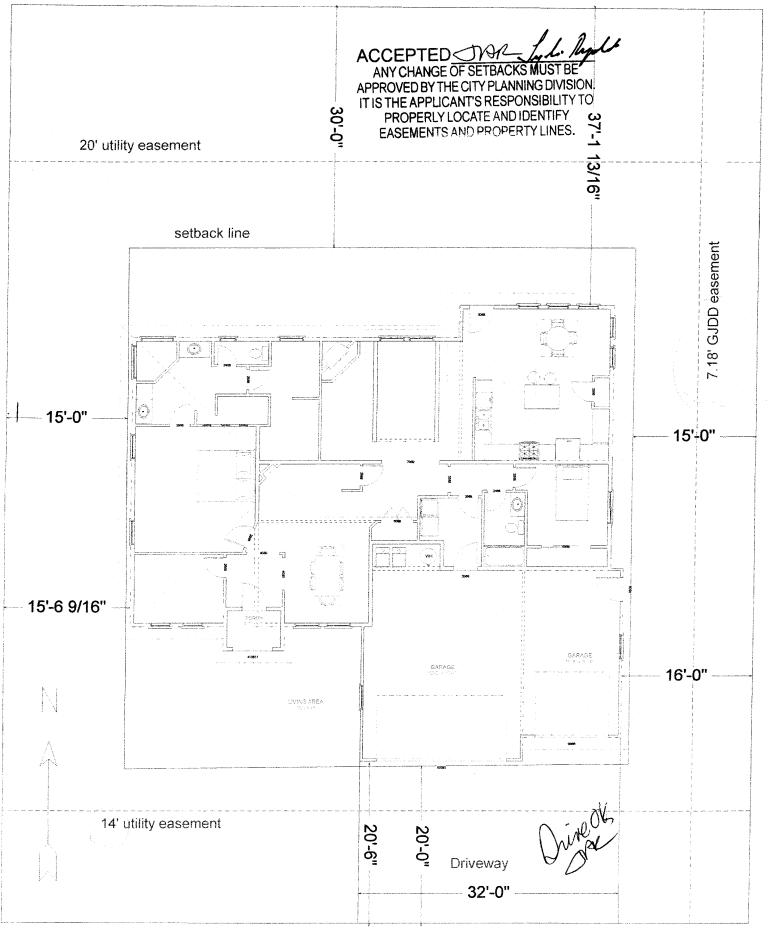

۰.

656 Levi Court

N