

FEE \$	10 ⁰⁰
TCP \$	1589 ⁰⁰
SIF \$	460 ⁰⁰

PLANNING CLEARANCE
 (Single Family Residential and Accessory Structures)
Community Development Department

BLDG PERMIT NO. _____

Building Address 2948 Margaret Dr. No. of Existing Bldgs 0 No. Proposed 1
 Parcel No. 2943-293-34-008 Sq. Ft. of Existing Bldgs 28 Sq. Ft. Proposed 2655
 Subdivision Chipeta West Sq. Ft. of Lot / Parcel 9978
 Filing 1 Block 2 Lot 8 Sq. Ft. Coverage of Lot by Structures & Impervious Surface (Total Existing & Proposed) 3450 ³⁴⁹⁰
 Height of Proposed Structure 19'

OWNER INFORMATION:

Name Armond C Hughes
 Address 205 Knob Hill dr.
 City / State / Zip Grand Jct. Co 81503

DESCRIPTION OF WORK & INTENDED USE:

New Single Family Home (*check type below)
 Interior Remodel Addition
 Other (please specify): _____

APPLICANT INFORMATION:

Name Armond Hughes / Monob Bldgs.
 Address 205 Knob Hill
 City / State / Zip GJ Co. 81503
 Telephone (970) 433-2056

***TYPE OF HOME PROPOSED:**

Site Built Manufactured Home (UBC)
 Manufactured Home (HUD)
 Other (please specify): _____

PAID

NOTES: _____

REQUIRED: One plot plan, on 8 1/2" x 11" paper, showing all existing & proposed structure location(s), parking, setbacks to all property lines, ingress/egress to the property, driveway location & width & all easements & rights-of-way which abut the parcel.

THIS SECTION TO BE COMPLETED BY COMMUNITY DEVELOPMENT DEPARTMENT STAFF

ZONE R-4 Maximum coverage of lot by structures 50%
 SETBACKS: Front 20/25 from property line (PL) Permanent Foundation Required: YES X NO _____
 Side 7/3 from PL Rear 25/5 from PL Parking Requirement 2
 Maximum Height of Structure(s) 35' Special Conditions _____
 Voting District E Driveway Location Approval PD
 (Engineer's Initials)

Modifications to this Planning Clearance must be approved, in writing, by the Community Development Department. The structure authorized by this application cannot be occupied until a final inspection has been completed and a Certificate of Occupancy has been issued, if applicable, by the Building Department (Section 305, Uniform Building Code).

I hereby acknowledge that I have read this application and the information is correct; I agree to comply with any and all codes, ordinances, laws, regulations or restrictions which apply to the project. I understand that failure to comply shall result in legal action, which may include but not necessarily be limited to non-use of the building(s).

Applicant Signature Armond C Hughes Date 6-9-08
 Department Approval PD Tyden Reynolds Date 6/11/08

Additional water and/or sewer tap fee(s) are required:	YES <u>X</u>	NO	W/O No. <u>PD omSP</u>
Utility Accounting <u>T. Bensley</u>	Date <u>6/11/08</u>		


VALID FOR SIX MONTHS FROM DATE OF ISSUANCE (Section 2.2.C.1 Grand Junction Zoning & Development Code)
 (White: Planning) (Yellow: Customer) (Pink: Building Department) (Goldenrod: Utility Accounting)

2948 Margaret Dr.

LOT 9
9,138 SF

ACCEPTED *PD Lyli Rynd*
ANY CHANGE OF SETBACKS MUST BE APPROVED BY THE CITY PLANNING DIVISION. IT IS THE APPLICANT'S RESPONSIBILITY TO PROPERLY LOCATE AND IDENTIFY EASEMENTS AND PROPERTY LINES.

LOT 7
9,248 SF

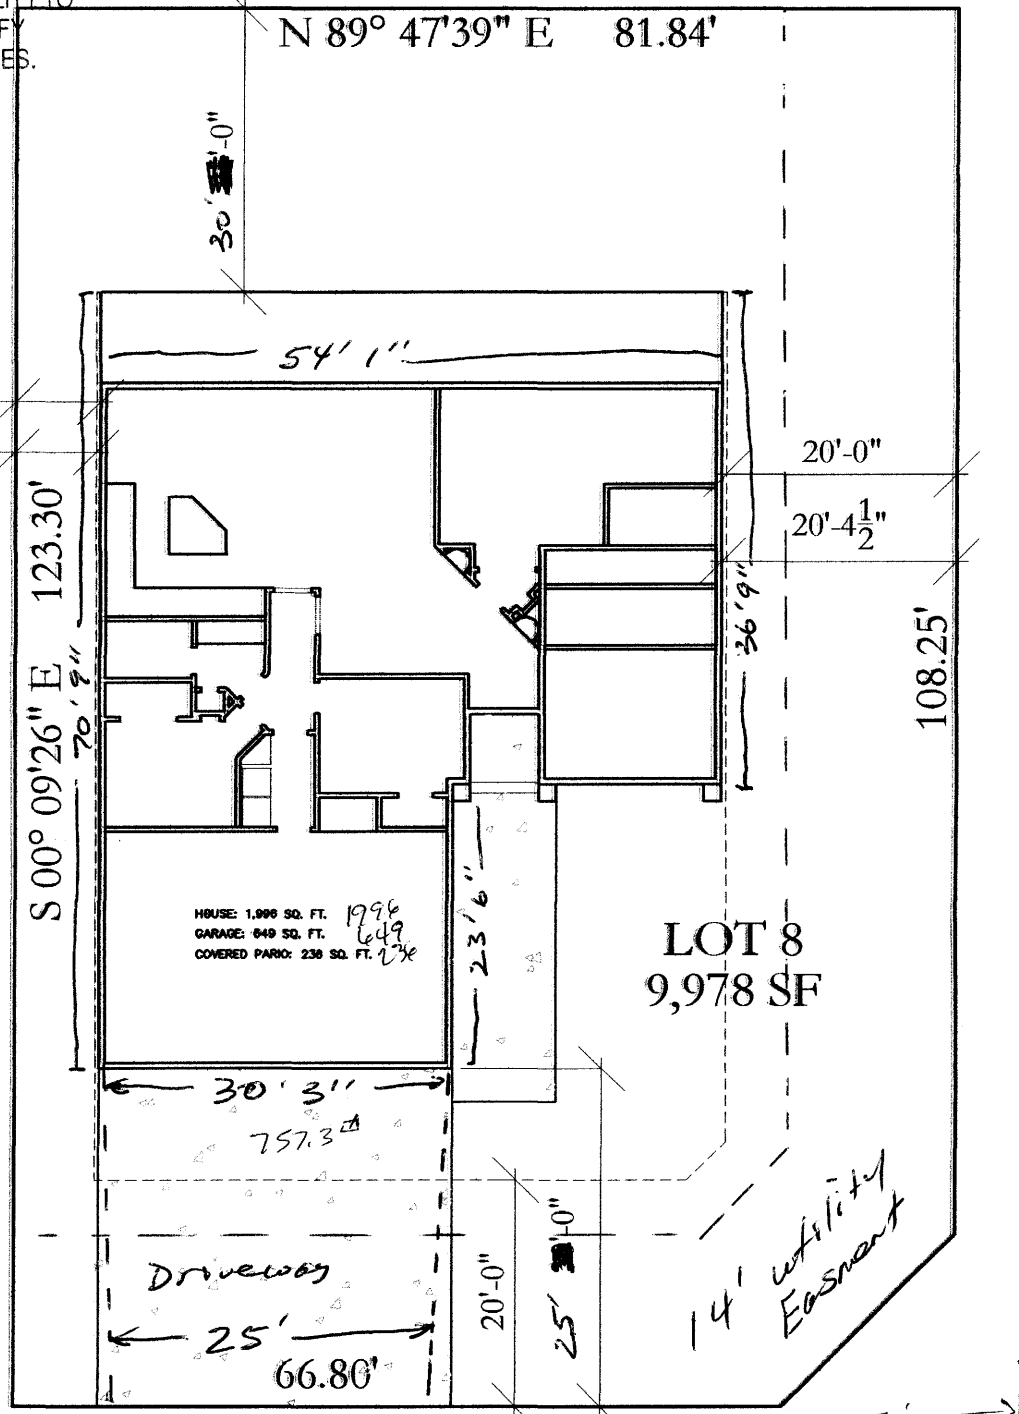

MERLE'S WAY

2948 *Drive OK Post 6/10/08*
MARGARET DRIVE

1 SITE PLAN
C1 N.T.S.