

FEE \$	10 ⁰⁰
TCP \$	/
SIF \$	/

PLANNING CLEARANCE
 (Single Family Residential and Accessory Structures)
Community Development Department

BLDG PERMIT NO. _____

Building Address 3324 Music Ln
 Parcel No. 2945-023-17-018
 Subdivision Northridge
 Filing _____ Block _____ Lot _____

No. of Existing Bldgs 1 No. Proposed 1
 Sq. Ft. of Existing Bldgs 3050 Sq. Ft. Proposed 768
 Sq. Ft. of Lot / Parcel 1620
 Sq. Ft. Coverage of Lot by Structures & Impervious Surface
 (Total Existing & Proposed) _____
 Height of Proposed Structure _____

OWNER INFORMATION:

Name Ed Riddle
 Address 3324 Music Ln
 City / State / Zip Shand Jet, Ca 91506

DESCRIPTION OF WORK & INTENDED USE:

New Single Family Home (*check type below)
 Interior Remodel Addition
 Other (please specify): SHED 16x24

APPLICANT INFORMATION:

Name Ed Riddle
 Address 3324 Music Ln
 City / State / Zip 91506
 Telephone 243-2712

***TYPE OF HOME PROPOSED:**

Site Built Manufactured Home (UBC)
 Manufactured Home (HUD)
 Other (please specify): _____

NOTES: _____

REQUIRED: One plot plan, on 8 1/2" x 11" paper, showing all existing & proposed structure location(s), parking, setbacks to all property lines, ingress/egress to the property, driveway location & width & all easements & rights-of-way which abut the parcel.

THIS SECTION TO BE COMPLETED BY COMMUNITY DEVELOPMENT DEPARTMENT STAFF	
ZONE <u>R-4</u>	Maximum coverage of lot by structures <u>50%</u>
SETBACKS: Front <u>20/25</u> from property line (PL)	Permanent Foundation Required: YES _____ NO _____
Side <u>7/3</u> from PL Rear <u>25/5</u> from PL	Parking Requirement _____
Maximum Height of Structure(s) <u>35'</u>	Special Conditions _____
Voting District _____	Driveway _____
_____	Location Approval _____ (Engineer's Initials)

Modifications to this Planning Clearance must be approved, in writing, by the Community Development Department. The structure authorized by this application cannot be occupied until a final inspection has been completed and a Certificate of Occupancy has been issued, if applicable, by the Building Department (Section 305, Uniform Building Code).

I hereby acknowledge that I have read this application and the information is correct; I agree to comply with any and all codes, ordinances, laws, regulations or restrictions which apply to the project. I understand that failure to comply shall result in legal action, which may include but not necessarily be limited to non-use of the building(s).

Applicant Signature Ed Riddle Date 6-4-08
 Department Approval Pat Dunlop Date 6/4/08

Additional water and/or sewer tap fee(s) are required:	YES	NO <input checked="" type="checkbox"/>	W/O No.
Utility Accounting <u>C. Bensley</u>	Date <u>6/4/08</u>		


VALID FOR SIX MONTHS FROM DATE OF ISSUANCE (Section 2.2.C.1 Grand Junction Zoning & Development Code)
 (White: Planning) (Yellow: Customer) (Pink: Building Department) (Goldenrod: Utility Accounting)

PAID
TB

3324 Music Lane



SCALE 1 : 215

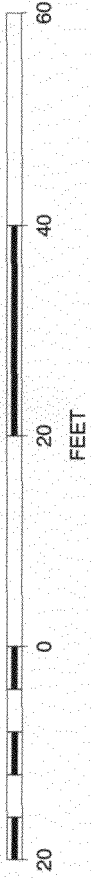

ACCEPTED *Pat Dunlop 6/4/08*
ANY CHANGE OF SETBACKS MUST BE
APPROVED BY THE CITY PLANNING DIVISION.
IT IS THE APPLICANT'S RESPONSIBILITY TO
PROPERLY LOCATE AND IDENTIFY
EASEMENTS AND PROPERTY LINES.