

FEE \$	10-
TCP \$	1589-
SIF \$	460-

PLANNING CLEARANCE
 (Single Family Residential and Accessory Structures)
Community Development Department

BLDG PERMIT NO. _____

Building Address 583 Pacino Way
 Parcel No. 2993-071-62-004
 Subdivision Legend East
 Filing 2 Block 1 Lot 4

No. of Existing Bldgs 0 No. Proposed 1
 Sq. Ft. of Existing Bldgs 0 Sq. Ft. Proposed 1572
 Sq. Ft. of Lot / Parcel 5802.5 SQ. FT.
 Sq. Ft. Coverage of Lot by Structures & Impervious Surface
 (Total Existing & Proposed) 2782 SQ. FT.
 Height of Proposed Structure 17

OWNER INFORMATION:

Name Legend Partners
 Address P.O. Box 1765
 City / State / Zip GRAND Junction, CO 81502

DESCRIPTION OF WORK & INTENDED USE:

New Single Family Home (*check type below)
 Interior Remodel Addition
 Other (please specify): _____

APPLICANT INFORMATION:

Name Legend Partners
 Address P.O. Box 1765
 City / State / Zip GRAND Junction, CO 81502
 Telephone 970-244-9986 #17

***TYPE OF HOME PROPOSED:**

Site Built Manufactured Home (UBC)
 Manufactured Home (HUD)
 Other (please specify): _____

NOTES: Engineered foundation required

REQUIRED: One plot plan, on 8 1/2" x 11" paper, showing all existing & proposed structure location(s), parking, setbacks to all property lines, ingress/egress to the property, driveway location & width & all easements & rights-of-way which abut the parcel.

THIS SECTION TO BE COMPLETED BY COMMUNITY DEVELOPMENT DEPARTMENT STAFF	
ZONE <u>R-8</u>	Maximum coverage of lot by structures <u>70%</u>
SETBACKS: Front <u>20</u> from property line (PL)	Permanent Foundation Required: YES <input checked="" type="checkbox"/> NO <input type="checkbox"/>
Side <u>5</u> from PL Rear <u>10</u> from PL	Parking Requirement <u>2</u>
Maximum Height of Structure(s) <u>35</u>	Special Conditions _____
Voting District <u>D</u> Driveway Location Approval <u>PD</u> (Engineer's Initials)	_____

Modifications to this Planning Clearance must be approved, in writing, by the Community Development Department. The structure authorized by this application cannot be occupied until a final inspection has been completed and a Certificate of Occupancy has been issued, if applicable, by the Building Department (Section 305, Uniform Building Code).


I hereby acknowledge that I have read this application and the information is correct; I agree to comply with any and all codes, ordinances, laws, regulations or restrictions which apply to the project. I understand that failure to comply shall result in legal action, which may include but not necessarily be limited to non-use of the building(s).

Applicant Signature [Signature] Date 01-16-08
 Department Approval PD Paul Hempel Date 1/24/08

Additional water and/or sewer tap fee(s) are required: YES <input checked="" type="checkbox"/> NO <input type="checkbox"/>	W/O No. <u>20853</u>
Utility Accounting <u>[Signature]</u>	Date <u>1-24-08</u>

VALID FOR SIX MONTHS FROM DATE OF ISSUANCE (Section 2.2.C.1 Grand Junction Zoning & Development Code)
 (White: Planning) (Yellow: Customer) (Pink: Building Department) (Goldenrod: Utility Accounting)

ACCEPTED *Paul Hoban*
 ANY CHANGE OF SETBACKS MUST BE APPROVED BY THE CITY PLANNING DIVISION. IT IS THE APPLICANT'S RESPONSIBILITY TO PROPERLY LOCATE AND IDENTIFY EASEMENTS AND PROPERTY LINES.

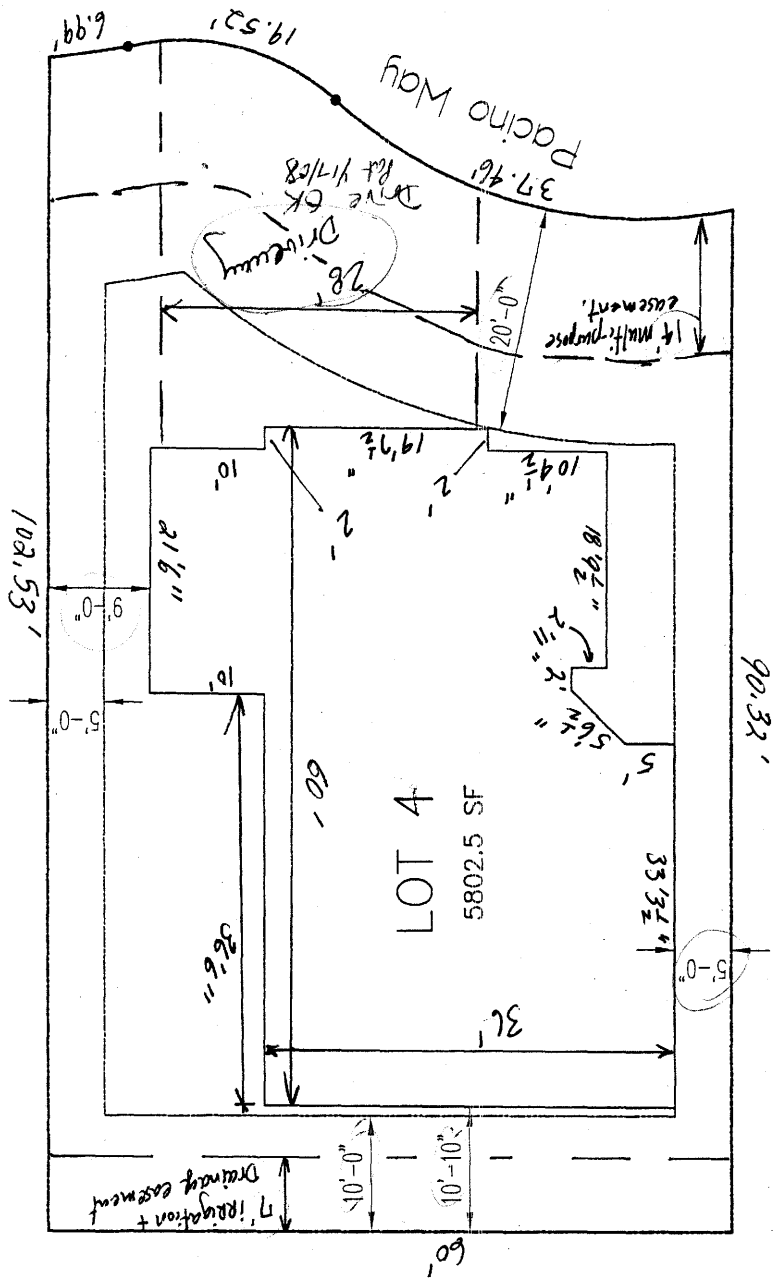

DATE: 01/06/08

SPEC HOME

PLAN: Sundance - 3 car garage
 583 PACINO WAY
 LEGENDS SUBDIVISION

SETBACKS	MIN	ACTUAL
FRONT:	20'	20'
REAR:	10'	10'10"
SIDE:	5'	5' SOUTH, 9' NORTH

SITE PLAN
 SCALE: 1" = 16"

