

FEE \$	10 ⁰⁰
TCP \$	1589 ⁰⁰
SIF \$	460 ⁰⁰

PLANNING CLEARANCE
 (Single Family Residential and Accessory Structures)
Community Development Department

BLDG PERMIT NO. _____

Building Address 447 SAN JUAN
 Parcel No. 2943-173-47-002
 Subdivision SIENA VIEW
 Filing 1 Block 2 Lot 2

No. of Existing Bldgs 0 No. Proposed ONE
 Sq. Ft. of Existing Bldgs 0 Sq. Ft. Proposed 1714
 Sq. Ft. of Lot / Parcel 4680
 Sq. Ft. Coverage of Lot by Structures & Impervious Surface (Total Existing & Proposed) 2170
 Height of Proposed Structure 16 FT.

OWNER INFORMATION:

Name G.D. BUILDERS INC.
 Address 3183 BIRD
 City / State / Zip G.J. CO 81503

DESCRIPTION OF WORK & INTENDED USE:

- New Single Family Home (*check type below)
 Interior Remodel Addition
 Other (please specify): _____

APPLICANT INFORMATION:

Name SAME
 Address _____
 City / State / Zip _____
 Telephone 712-3975

***TYPE OF HOME PROPOSED:**

- Site Built Manufactured Home (UBC)
 Manufactured Home (HUD)
 Other (please specify): _____

NOTES: _____

REQUIRED: One plot plan, on 8 1/2" x 11" paper, showing all existing & proposed structure location(s), parking, setbacks to all property lines, ingress/egress to the property, driveway location & width & all easements & rights-of-way which abut the parcel.

THIS SECTION TO BE COMPLETED BY COMMUNITY DEVELOPMENT DEPARTMENT STAFF	
ZONE <u>R-8</u>	Maximum coverage of lot by structures <u>70%</u>
SETBACKS: Front <u>20'</u> from property line (PL)	Permanent Foundation Required: YES <u>X</u> NO _____
Side <u>5'</u> from PL Rear <u>10'</u> from PL	Parking Requirement <u>2</u>
Maximum Height of Structure(s) <u>35'</u>	Special Conditions _____
Voting District <u>C</u> Driveway Location Approval <u>PD</u> (Engineer's Initials)	_____

Modifications to this Planning Clearance must be approved, in writing, by the Community Development Department. The structure authorized by this application cannot be occupied until a final inspection has been completed and a Certificate of Occupancy has been issued, if applicable, by the Building Department (Section 305, Uniform Building Code).

I hereby acknowledge that I have read this application and the information is correct; I agree to comply with any and all codes, ordinances, laws, regulations or restrictions which apply to the project. I understand that failure to comply shall result in legal action, which may include but not necessarily be limited to non-use of the building(s).


Applicant Signature [Signature] Date 5/27/08
 Department Approval PD Indiana Rose Date _____

Additional water and/or sewer tap fee(s) are required:	YES <input checked="" type="checkbox"/> NO <input type="checkbox"/>	W/O No. <u>6/21/08</u>
Utility Accounting <u>[Signature]</u>	Date <u>6/17/08</u>	


VALID FOR SIX MONTHS FROM DATE OF ISSUANCE (Section 2.2.C.1 Grand Junction Zoning & Development Code)
 (White: Planning) (Yellow: Customer) (Pink: Building Department) (Goldenrod: Utility Accounting)

SAN JUAN STREET

ACCEPTED *Dr. J. ...*
 ANY CHANGE OF SETBACKS MUST BE
 APPROVED BY THE CITY PLANNING DIVISION.
 IT IS THE APPLICANT'S RESPONSIBILITY TO
 PROPERLY LOCATE AND IDENTIFY
 EASEMENTS AND PROPERTY LINES.

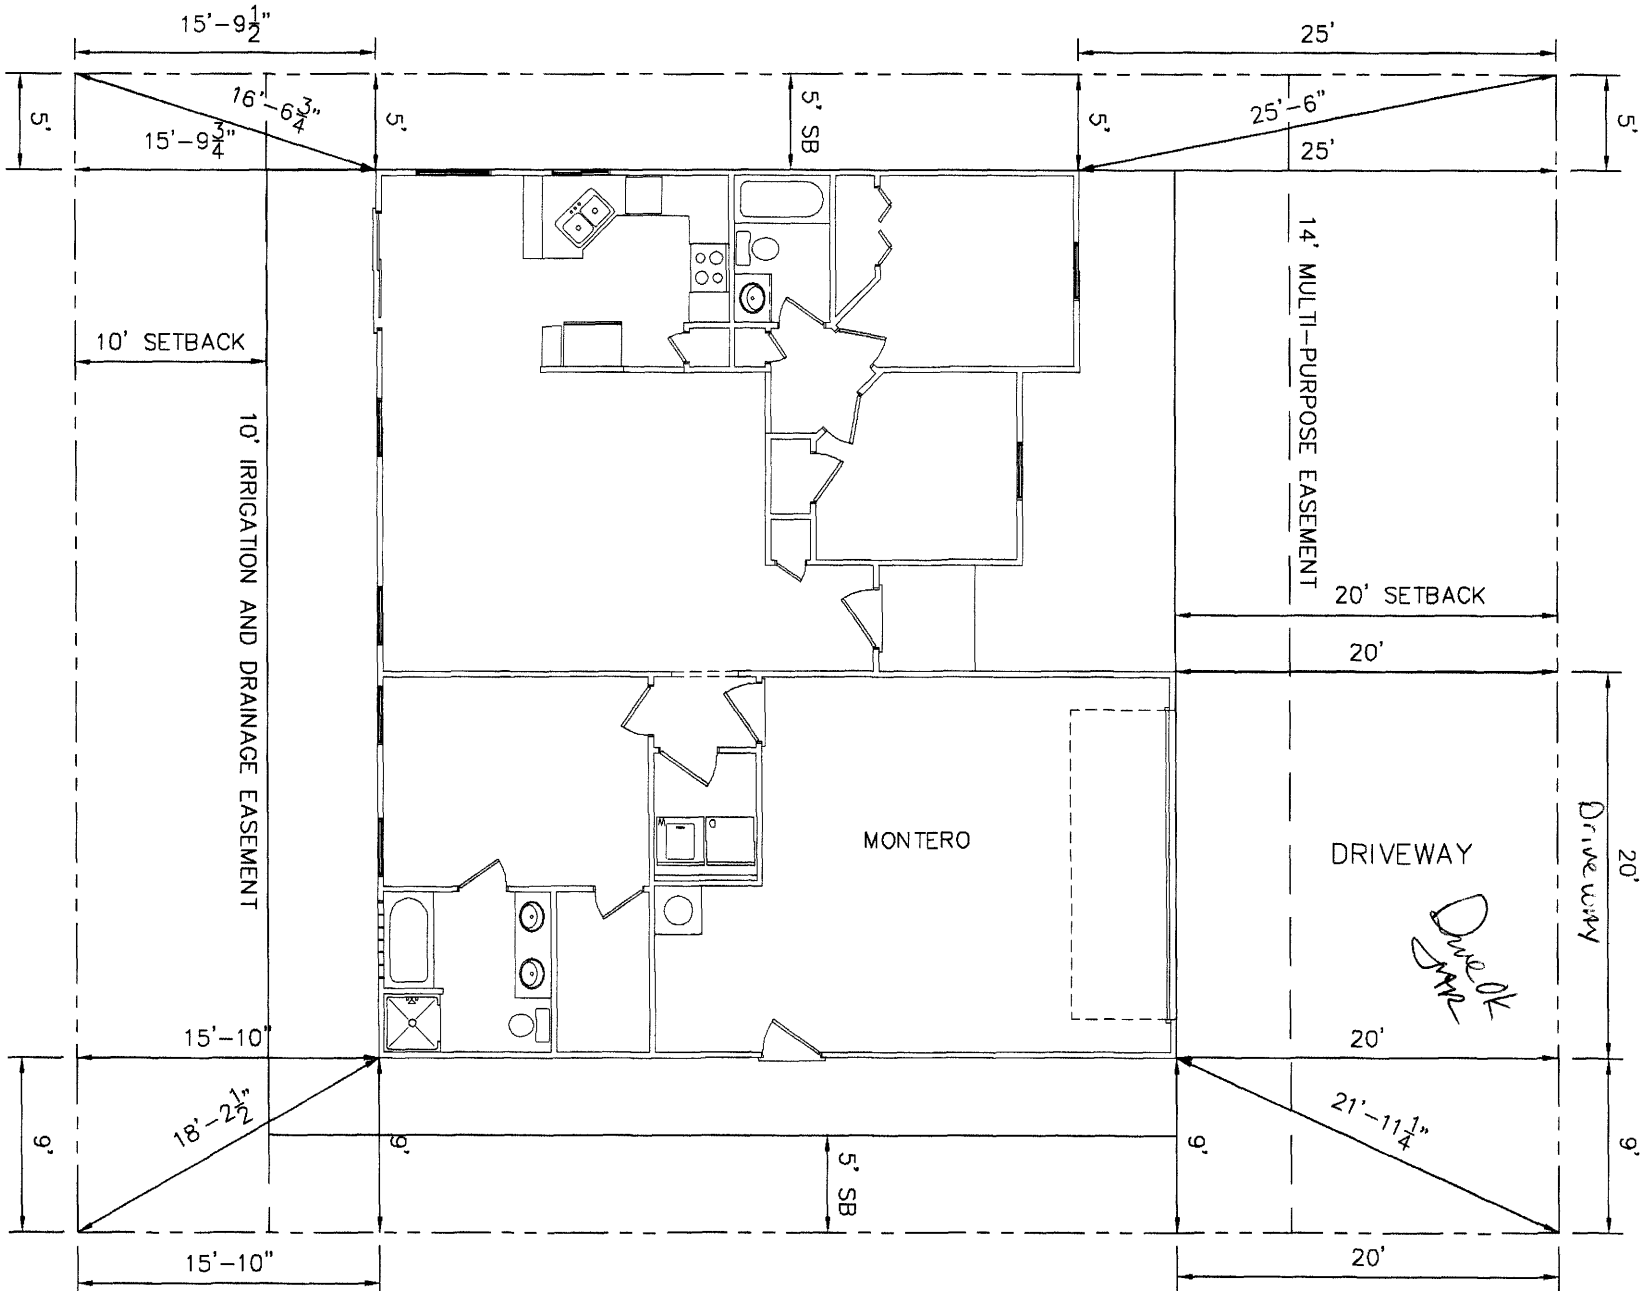

LIABILITY DISCLAIMER
 It is the responsibility of client/representative of client to verify all information on the attached plans.

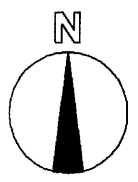

SITE PLAN

SCALE: 1" = 10'

SUBDIVISION NAME-	SIENA VIEW
FILING NUMBER-	1
LOT NUMBER-	2
BLOCK NUMBER-	2
LOT SQ. FT.-	4669 SF
ADDRESS-	447 SAN JUAN STREET
COUNTY-	MESA
CITY-	GRAND JUNCTION