

FEE \$	10
TCP \$	1589
SIF \$	460

PLANNING CLEARANCE
 (Single Family Residential and Accessory Structures)
Community Development Department

BLDG PERMIT NO. 12

*Amended 7/17/08
PH*

Building Address 588 Sinatra Way
 Parcel No. 2943-071-62-024
 Subdivision LEGENDS EAST
 Filing 2 Block 1 Lot 24

No. of Existing Bldgs 0 No. Proposed 1
 Sq. Ft. of Existing Bldgs 0 Sq. Ft. Proposed 1572
 Sq. Ft. of Lot / Parcel 5050 SQ. FT.
 Sq. Ft. Coverage of Lot by Structures & Impervious Surface (Total Existing & Proposed) 2582 sq. ft *5106*
 Height of Proposed Structure 17'

OWNER INFORMATION:

Name Legend Partners
 Address P.O. Box 1765
 City / State / Zip GRAND JUNCTION, CO 81502

DESCRIPTION OF WORK & INTENDED USE:

- New Single Family Home (*check type below)
- Interior Remodel Addition
- Other (please specify): _____

APPLICANT INFORMATION:

Name Legend Partners
 Address P.O. Box 1765
 City / State / Zip GRAND JUNCTION, CO 81502
 Telephone 970-234-5682

***TYPE OF HOME PROPOSED:**

- Site Built Manufactured Home (UBC)
- Manufactured Home (HUD)
- Other (please specify): _____

NOTES: _____

REQUIRED: One plot plan, on 8 1/2" x 11" paper, showing all existing & proposed structure location(s), parking, setbacks to all property lines, ingress/egress to the property, driveway location & width & all easements & rights-of-way which abut the parcel.


THIS SECTION TO BE COMPLETED BY COMMUNITY DEVELOPMENT DEPARTMENT STAFF	
ZONE <u>R-8</u>	Maximum coverage of lot by structures <u>70%</u>
SETBACKS: Front <u>20</u> from property line (PL)	Permanent Foundation Required: YES <input checked="" type="checkbox"/> NO <input type="checkbox"/>
Side <u>5</u> from PL Rear <u>10</u> from PL	Parking Requirement <u>2</u>
Maximum Height of Structure(s) <u>35</u>	Special Conditions <u>Engineered Foundation</u>
Voting District <u>ED</u> Driveway Location Approval <u>PH</u> <small>(Engineer's Initials)</small>	<u>required</u>

Modifications to this Planning Clearance must be approved, in writing, by the Community Development Department. The structure authorized by this application cannot be occupied until a final inspection has been completed and a Certificate of Occupancy has been issued, if applicable, by the Building Department (Section 305, Uniform Building Code).


I hereby acknowledge that I have read this application and the information is correct; I agree to comply with any and all codes, ordinances, laws, regulations or restrictions which apply to the project. I understand that failure to comply shall result in legal action, which may include but not necessarily be limited to non-use of the building(s).

Applicant Signature [Signature] Date 6-23-08
 Department Approval PH Lydia Reynolds Date 6/25/08

Additional water and/or sewer tap fee(s) are required:	YES	NO	W/O No. <u>21106</u>
Utility Accounting <u>[Signature]</u>	Date <u>6/26/08</u>		

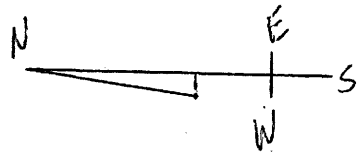

Scale 1" = 10'

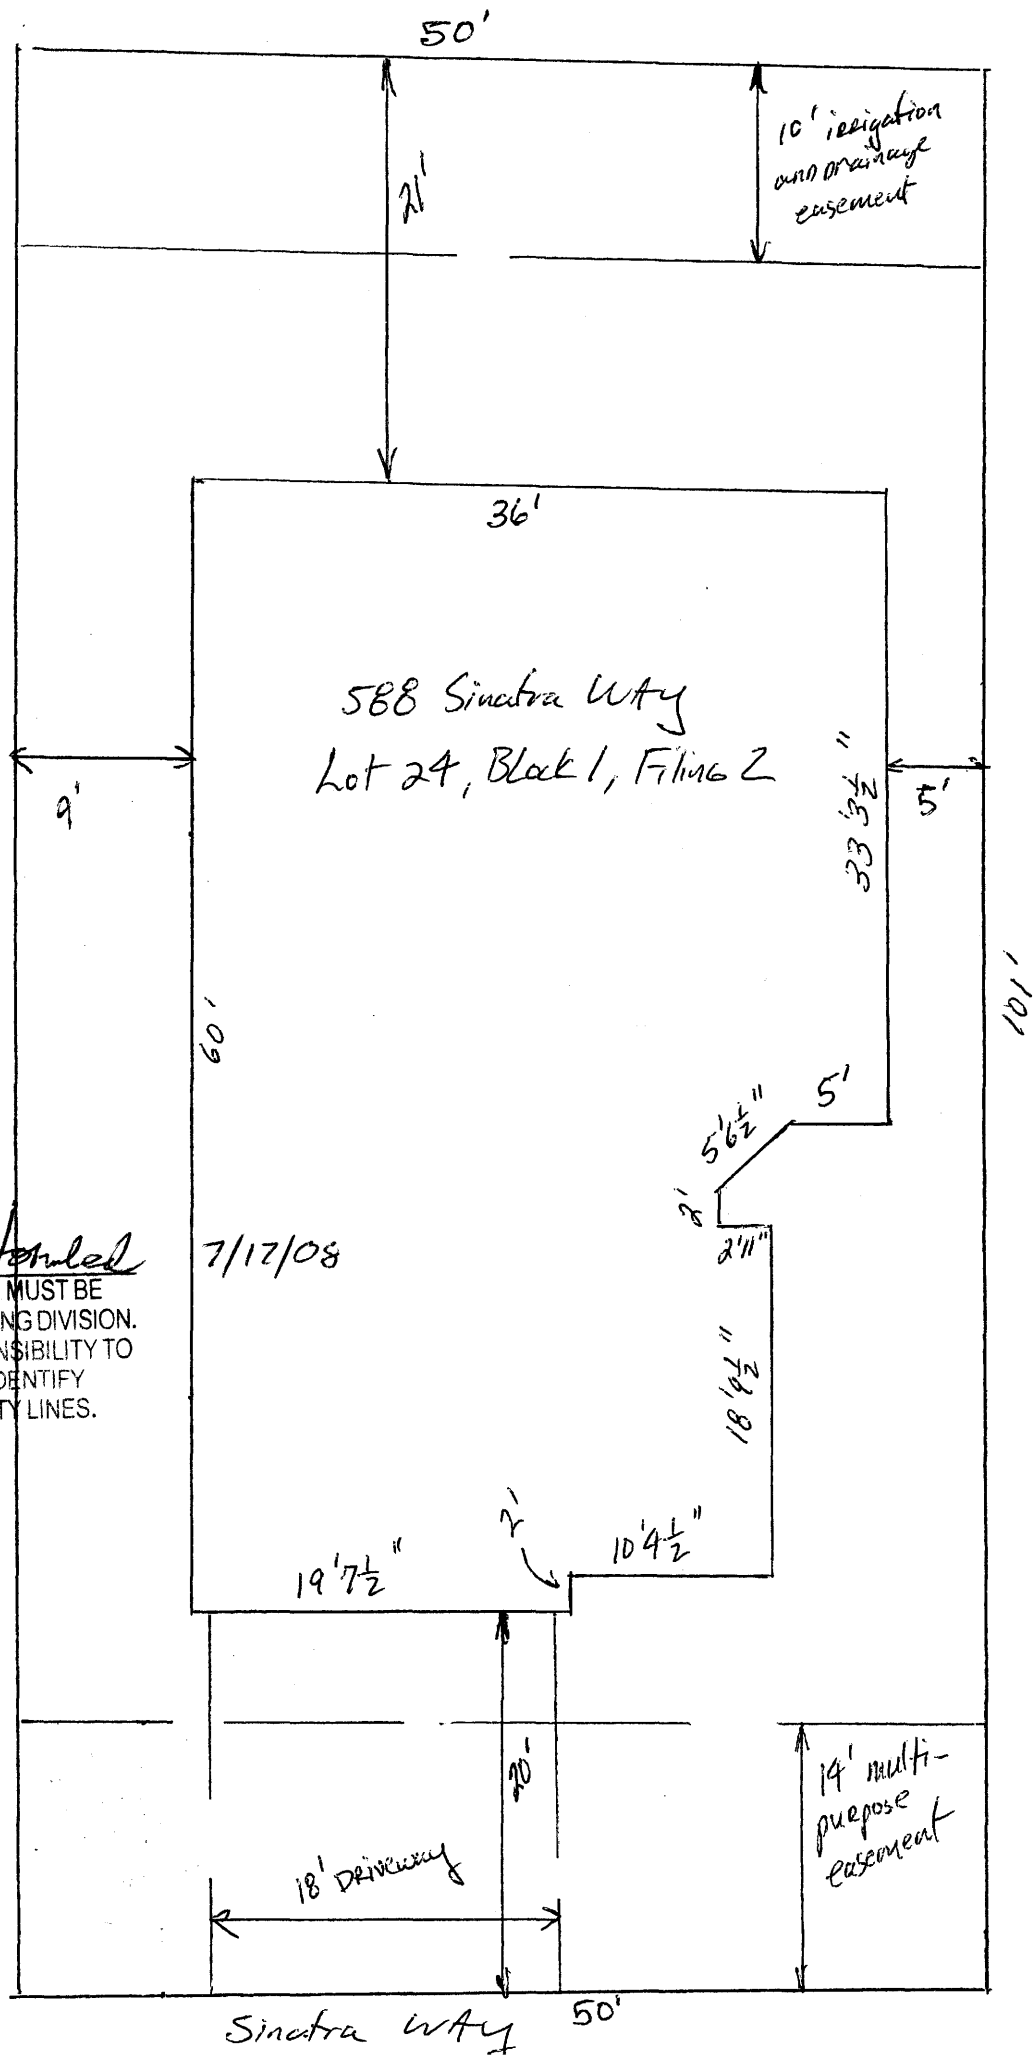

ACCEPTED *Paul H. ...*
ANY CHANGE OF SETBACKS MUST BE APPROVED BY THE CITY PLANNING DIVISION. IT IS THE APPLICANT'S RESPONSIBILITY TO PROPERLY LOCATE AND IDENTIFY EASEMENTS AND PROPERTY LINES.