

FEE \$	10
TCP \$	
SIF \$	

**PLANNING CLEARANCE**  
 (Single Family Residential and Accessory Structures)  
**Community Development Department**

BLDG PERMIT NO. \_\_\_\_\_

Building Address 2805 Texas Ave  
 Parcel No. 2943-073-00-058  
 Subdivision \_\_\_\_\_  
 Filing \_\_\_\_\_ Block \_\_\_\_\_ Lot \_\_\_\_\_

No. of Existing Bldgs \_\_\_\_\_ No. Proposed \_\_\_\_\_  
 Sq. Ft. of Existing Bldgs 680" Sq. Ft. Proposed 1424  
 Sq. Ft. of Lot / Parcel \_\_\_\_\_  
 Sq. Ft. Coverage of Lot by Structures & Impervious Surface  
 (Total Existing & Proposed) \_\_\_\_\_  
 Height of Proposed Structure \_\_\_\_\_

**OWNER INFORMATION:**

Name Ian Penney  
 Address 2805 Texas Ave  
 City / State / Zip Grand Jct. CO 81501

DESCRIPTION OF WORK & INTENDED USE:  
 New Single Family Home (\*check type below)  
 Interior Remodel  Addition  
 Other (please specify): \_\_\_\_\_

**APPLICANT INFORMATION:**

Name Ian Penney  
 Address 2805 Texas Ave  
 City / State / Zip Grand Jct. CO 81501  
 Telephone 970 250-0611

\*TYPE OF HOME PROPOSED:  
 Site Built  Manufactured Home (UBC)  
 Manufactured Home (HUD)  
 Other (please specify): \_\_\_\_\_

NOTES: \_\_\_\_\_

**REQUIRED: One plot plan, on 8 1/2" x 11" paper, showing all existing & proposed structure location(s), parking, setbacks to all property lines, ingress/egress to the property, driveway location & width & all easements & rights-of-way which abut the parcel.**

THIS SECTION TO BE COMPLETED BY COMMUNITY DEVELOPMENT DEPARTMENT STAFF	
ZONE <u>R-8</u>	Maximum coverage of lot by structures <u>70%</u>
SETBACKS: Front <u>20</u> from property line (PL)	Permanent Foundation Required: YES _____ NO _____
Side <u>5</u> from PL Rear <u>10</u> from PL	Parking Requirement <u>PAID</u>
Maximum Height of Structure(s) <u>35</u>	Special Conditions <u>MAR 18 2008</u>
Voting District _____ Driveway Location Approval _____ (Engineer's Initials)	<u>FB</u>

Modifications to this Planning Clearance must be approved, in writing, by the Community Development Department. The structure authorized by this application cannot be occupied until a final inspection has been completed and a Certificate of Occupancy has been issued, if applicable, by the Building Department (Section 305, Uniform Building Code).

I hereby acknowledge that I have read this application and the information is correct; I agree to comply with any and all codes, ordinances, laws, regulations or restrictions which apply to the project. I understand that failure to comply shall result in legal action, which may include but not necessarily be limited to non-use of the building(s).

Applicant Signature [Signature] Date 3/18/08  
 Department Approval [Signature] Date 3/18/08

Additional water and/or sewer tap fee(s) are required:	YES	NO <input checked="" type="checkbox"/>	W/O No.
Utility Accounting <u>[Signature]</u>	Date <u>3/18/08</u>		

VALID FOR SIX MONTHS FROM DATE OF ISSUANCE (Section 2.2.C.1 Grand Junction Zoning & Development Code)  
 (White: Planning) (Yellow: Customer) (Pink: Building Department) (Goldenrod: Utility Accounting)

↑  
North


Current Set Back  
West Side

Proposed New Set Back

Existing Home

$$\begin{array}{r} 24 \\ 16 \\ \hline 84 \\ 14 \\ \hline 224 \\ 100 \\ \hline 4204 \\ 74360 \\ \hline 1680 \\ 744 \\ \hline 1424 \end{array}$$

$$\begin{array}{r} 14 \\ 30 \\ \hline 420 \end{array}$$

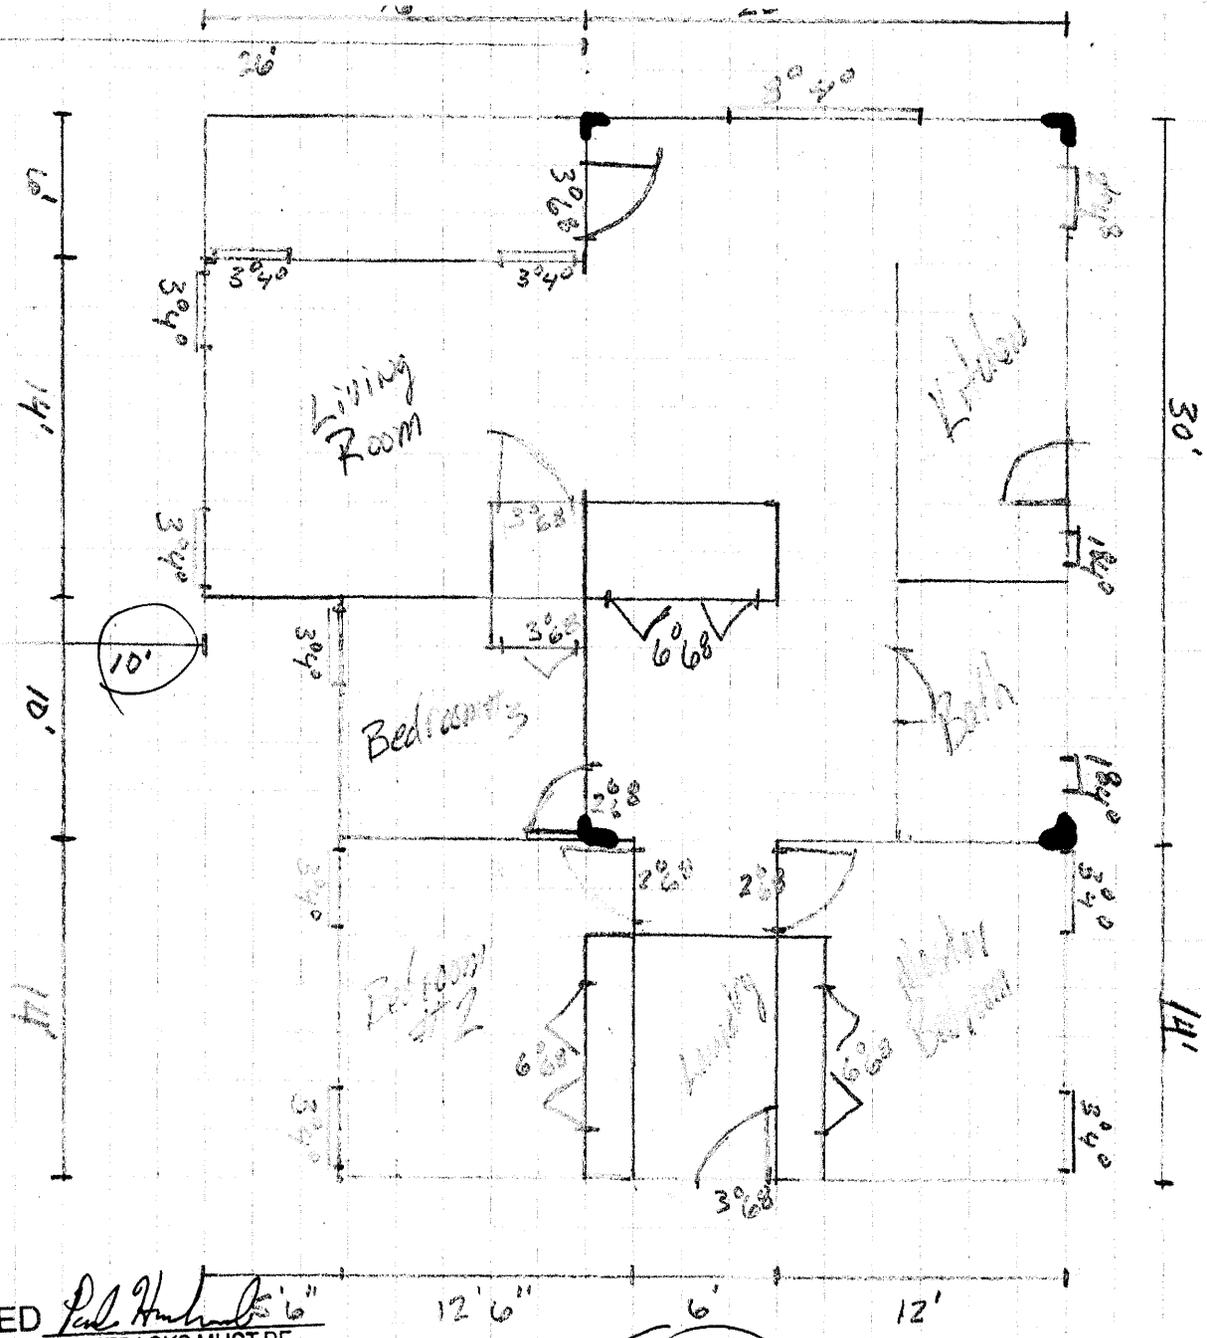

ACCEPTED Paul Humboldt's 6"  
 ANY CHANGE OF SETBACKS MUST BE  
 APPROVED BY THE CITY PLANNING DIVISION.  
 IT IS THE APPLICANT'S RESPONSIBILITY TO  
 PROPERLY LOCATE AND IDENTIFY  
 EASEMENTS AND PROPERTY LINES.

710'