
| FEE \$ 10 00 PLANNING CLEARA  | BLDG PERMIT NO.  |  |
|---|--|--|
| TCP \$ (Single Family Residential and Accessed  |  |  |
| SIF \$ Community Development Department   |  |  |
| L   |  |  |
|   | of Existing Bldgs/ No. Proposed  |  |
| Parcel No2701-353-64-001 Sq.  | ቆጋንኖሩ ት<br>Ft. of Existing Bldgs Sq. Ft. Proposed                                    |  |
| Subdivision 2020 GROAD Sub Sq.  | Ft. of Lot / Parcel 1259   |  |
| Filing Block Lot Sq. (Tot   | Ft. Coverage of Lot by Structures & Impervious Surface                               |  |
| OWNER INFORMATION: Heig   | ht of Proposed Structure   |  |
|   | CRIPTION OF WORK & INTENDED USE:<br>ew Single Family Home (*check type below)        |  |
| Address 2621 WESTWA   | terior Remodel Addition  |  |
| City / State / Zip  |  |  |
| APPLICANT INFORMATION: *TY  | PE OF HOME PROPOSED:   |  |
| Name Quality Hone Concrepts [] M  | te Built Manufactured Home (UBC)<br>anufactured Home (HUD)<br>ther (please specify): |  |
|   |  |  |
| City/State/Zip Grand Junction Co_ NOTES:  |  |  |
| City/State/Zip <u>Grand Junction Co</u> NOTES:<br>8150/<br>Telephone <u>(970) Z61-9739</u>  |  |  |
| REQUIRED: One plot plan, on 8 1/2" x 11" paper, showing all existing & proposed structure location(s), parking, setbacks to all<br>property lines, ingress/egress to the property, driveway location & width & all easements & rights-of-way which abut the parcel.   |  |  |
| THIS SECTION TO BE COMPLETED BY COMMUNIT  |  |  |
|   | imum coverage of lot by structures   |  |
|   | nanent Foundation Required: YESNO  |  |
| Side <u>5/3</u> from PL Rear <u>25/5</u> from PL Parl   | ing Requirement  |  |
| Maximum Height of Structure(s) <u>35</u> Spe  | cial Conditions  |  |
| Driveway<br>Voting District Location Approval<br>(Engineer's Initials)  | TE   |  |
| Modifications to this Planning Clearance must be approved, in writing, by the Community Development Department. The structure authorized by this application cannot be occupied until a final inspection has been completed and a Certificate of Occupancy has been issued, if applicable, by the Building Department (Section 305, Uniform Building Code). |  |  |

I hereby acknowledge that I have read this application and the information is correct; I agree to comply with any and all codes, ordinances, laws, regulations or restrictions which apply to the project. I understand that failure to comply shall result in legal action, which may include but not necessarily be limited to non-use of the building(s).

| Applicant Signature Wash Winggin   | Date         |
|--|--------------|
| Department Approval Werdy Spure  | Date 2/29/08 |
| Additional water and/or sewer tap fee(s) are required: YES   | NO' W/O No.  |
| Utility Accounting (Bensley)   | Date 2/29/08 |
| VALID FOR SIX MONTHS FROM DATE OF ISSUANCE (Section 2.2.C.1 Grand Junction Zoning & Development Code)   (White: Planning) (Yellow: Customer) (Pink: Building Department) (Goldenrod: Utility Accounting) |              |

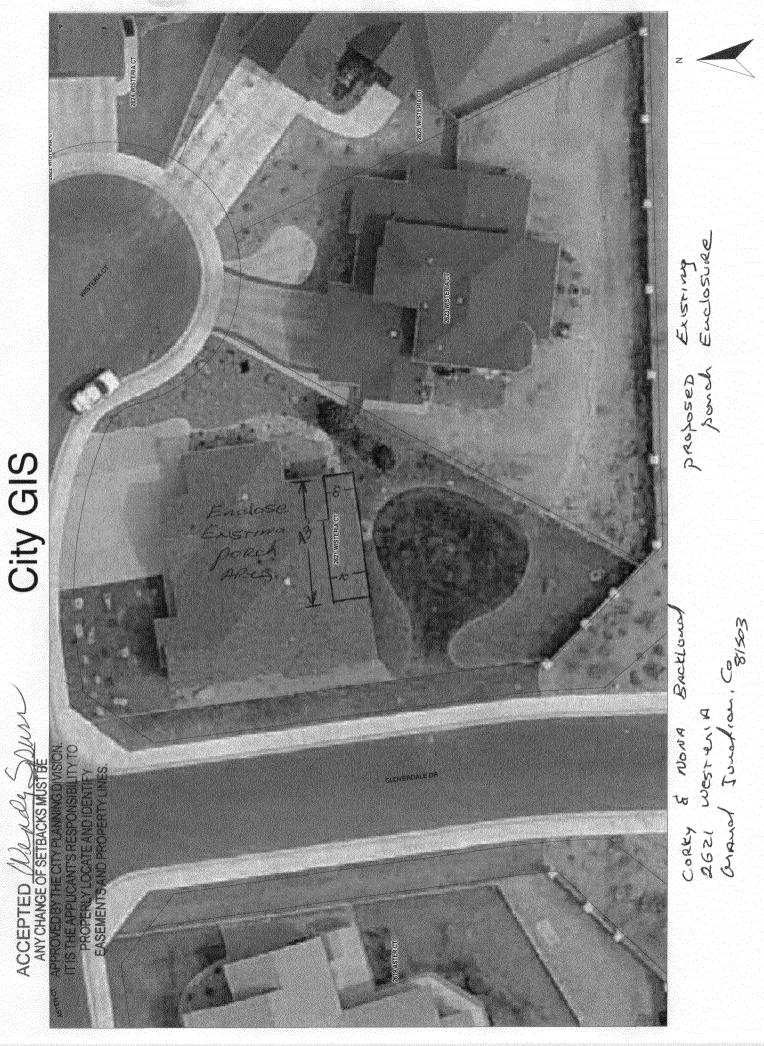

http://gis-web-fs.ci.grandjct.co.us/maps6/Zoning\_Map1.mwf

Wednesday, February 27, 2008 4:21 PM