TCP\$	Planning \$ 1500
Drainage \$ PLANNING CL	FARANCE Bldg Permit #
SIF\$ (Multifamily & Nonresidential Rem	
Inspection \$ Public Works & Plan	ning Department
Building Address 701 Main Street	Multifamily Only: No. of Existing Units No. Proposed
Parcel No. 2945-144-20-013	
Subdivision	Sq. Ft. of ExistingSq. Ft. Proposed
Filing Block Lot	Sq. Ft. of Lot / Parcel
OWNER INFORMATION:	Sq. Ft. Coverage of Lot by Structures & Impervious Surface (Total Existing & Proposed)
Name Mary C. Donlan Address 1104 Main St.	DESCRIPTION OF WORK & INTENDED USE:
Address 1164 Main St.	Remodel Change of Use (*Specify uses below) Addition Change of Business Other: Lower Canal
City/State/Zip Grand June 114 60	
APPLICANT INFORMATION: \$1501	* FOR CHANGE OF USE:
Name E.T. Technologies, Inc. Address 10000 S. Dransfeldtettion	*Existing Use: Vatant
	*Proposed Use: Day appment room
City/State/Zip Parker, Co 80134	Estimated Remodeling Cost \$ 5,000
Telephone 303-680-9414	Current Fair Market Value of Structure \$ 434,300.
	cisting & proposed structure location(s), parking, setbacks to all n & width & all easements & rights-of-way which abut the parcel.
THIS SECTION TO BE COMPLETED BY PLANNING STAFF	
ZONE 6-2	Maximum coverage of lot by structures
SETBACKS: Frontfrom property line (PL)	Landscaping/Screening-Required: YESNO
Sidefrom PL Rearfrom PL	Parking Requirement
Maximum Height of Structure(s)	Floodplain Certificate Required: YESNO
Voting District Ingress / Egress Location Approval (Engineer's Initials)	Special Conditions:
	in writing, by the Public Works & Planning Department. The ntil a final inspection has been completed and a Certificate of partment.
I hereby acknowledge that Have read this application and the ordinances, laws, regulations of restrictions which apply to the action, which may include but not necessarily be limited to no Applicant Signature	information is correct; I agree to comply with any and all codes, project. I understand that failure to comply shall result in legal n-use of the building(s). Date 9/21/09
Planning Approval Wandsharn Spure	Date 9/2/09

VALID FOR SIX MONTHS FROM DATE OF ISSUANCE (Section 2.2.C.4 Grand Junction Zoning & Development Code)

YES

(White: Planning)

Utility Accounting


(Yellow: Customer)

Additional water and/or eewer tap fee(s) are required:

(Pink: Building Department)

W/O No:

(Goldenrod: Utility Accounting)

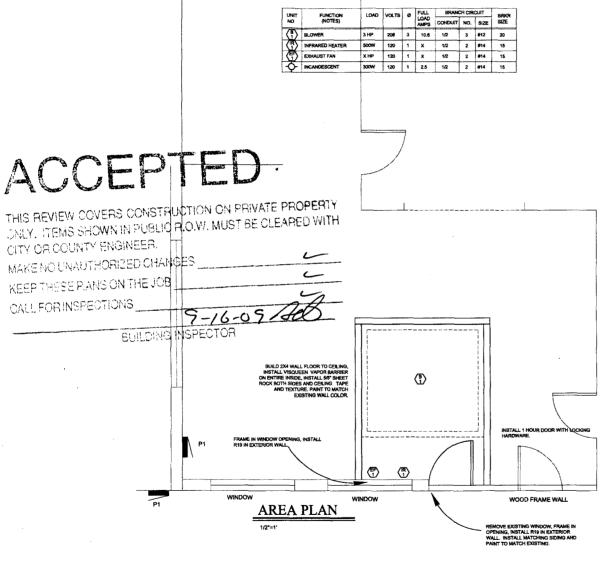

GENERAL NOTES

1. MARANCH AS DESIGN FOR REMODELING AND/OR REHABILITATION REQUIRES THAT CERTAIN ASSUMPTIONS BE MADE REGARDING EXISTING CONDITIONS, AND BECAUSE SOME OF THESE ASSUMPTIONS CANNOT BE VERIFIED WITHOUT DESTROYING OTHERWISE AND RELIGIOUS OF THE BULDING, THE ENGINEER WITHOUT DESTROYING OTHERWISE AND OTHER CONTROL THAT THE PROPERSIONAL CONDITIONS OF HER BULDING, THE ENGINEER CONTROL THE CONTROL THAT THE PROPERSIONAL CONTROL THE AND REPORT BEING THE BULDING THE WORK MAST MADE REASONABLE ALLOWANCES FOR UNFORESEEN CONTRICENCES.

2. CONTRACTOR SHALL FIELD VERRY PLAL CONTROLLING FACTORS BEFORE BEGINNING ANY WORK AND REPORT DISCREPANCIES TO THE ENGINEER.


3. ALL ELECTRICAL WORK SHALL COMPLY WITH LATEST EDITION OF INCLINING ALL APPLICABLE LOCAL CODES.

4. THESE DRAWNINGS ARE DIAGRAMMATIC. FIELD VERBY FULL REGISTRESHIPS FOR THE ON ANY MORE.

4. THESE DRAWNINGS ARE DIAGRAMMATIC. FIELD VERBY FULL REGISTRESHIPS FOR TO NAY MORE.

4. THESE DRAWNINGS ARE DIAGRAMMATIC. FIELD VERBY FULL REGISTRESHIPS FOR TO ROUGH-IN. COORDINATE ANY MORE AND ALL MINISTAN FIRE-RATINGS FOR ALL CONDUIT PENETRATIONS THROUGH FIRE-RATED CONSTRUCTIONS.

8. THE CONTRACTOR SHALL MAIN FAIR FIRE-RATINGS FOR ALL CONDUIT PERETRATIONS CONSTRUCTION. 7. ALL EQUIPMENT LOCATED IN CLASSIFIED AREAS SHALL BE RATED FOR THOSE AREAS.

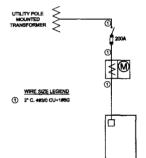

	THE PARTY NAMED IN
LOAD TYPE	CONSTRUCTED MAY ALEXE
LIGHTING AND CONTRICUS	211
NECEPTAGLES	e
MECHANICAL ROLLANDS	u
LANGEST MOTOR	1.5
MIC ROPPING	ж
TOTAL KM	XX.
AUTUME .	×.
TOTAL	779

ACCEPTED Wandy Sour ANY CHANGE OF SETBACKS MUST BE APPROVED BY THE CITY PLANNING DIVISION. IT IS THE APPLICANT'S RESPONSIBILITY TO PROPERLY LOCATE AND IDENTIFY FASEMENTS AND PROPERTY LINES.

