

Planning \$ <u>10<sup>00</sup></u>	Drainage \$
TCP \$ <u>2554<sup>00</sup></u>	School Impact \$ <u>460<sup>00</sup></u>
Inspection \$	

Bldg Permit No.
File #

## PLANNING CLEARANCE

(site plan review, multi-family development, non-residential development)

### Grand Junction Public Works & Planning Department

BUILDING ADDRESS 655 SERENITY LANE TAX SCHEDULE NO. 2945 041 37 - 045

SUBDIVISION BROOKWILLOW SQ. FT. OF EXISTING BLDG(S) 0

FILING III BLK N/A LOT 45 SQ. FT. OF PROPOSED BLDG(S)/ADDITONS 1367

OWNER DARTER LLC MULTI-FAMILY:  
 NO. OF DWELLING UNITS: BEFORE 0 AFTER 6  
 CONSTRUCTION

ADDRESS 786 VALLEY CT NO. OF BLDGS ON PARCEL: BEFORE 0 AFTER 1  
 CITY/STATE/ZIP GJ CO 81505 CONSTRUCTION

APPLICANT GRACE HOMES USE OF ALL EXISTING BLDG(S) RESIDENTIAL TOWN HOME

ADDRESS 786 VALLEY CT DESCRIPTION OF WORK & INTENDED USE: NEW HOME CONSTRUCTION

CITY/STATE/ZIP GJ CO 81505

TELEPHONE 248 8532

*Submittal requirements are outlined in the SSID (Submittal Standards for Improvements and Development) document.*

*Note B*

THIS SECTION TO BE COMPLETED BY PLANNING STAFF

ZONE <u>PD</u>	LANDSCAPING/SCREENING REQUIRED: YES ___ NO ___
SETBACKS: FRONT: <u>20'</u> from Property Line (PL) or from center of ROW, whichever is greater	PARKING REQUIREMENT: <u>2</u>
SIDE: <u>0</u> from PL REAR: <u>10'</u> from <u>landscape easement</u>	FLOODPLAIN CERTIFICATE REQUIRED: YES ___ NO <u>X</u>
MAX. HEIGHT _____	SPECIAL CONDITIONS: <u>Approved per plan;</u> <u>10' side setback between buildings to north</u>
MAX. COVERAGE OF LOT BY STRUCTURES _____	

Modifications to this Planning Clearance must be approved, in writing, by the Public Works & Planning Department Director. The structure authorized by this application cannot be occupied until a final inspection has been completed and a Certificate of Occupancy has been issued by the Building Department (Section 307, Uniform Building Code). Required improvements in the public right-of-way must be guaranteed prior to issuance of a Planning Clearance. All other required site improvements must be completed or guaranteed prior to issuance of a Certificate of Occupancy. Any landscaping required by this permit shall be maintained in an acceptable and healthy condition. The replacement of any vegetation materials that die or are in an unhealthy condition is required by the Grand Junction Zoning and Development Code.

Four (4) sets of final construction drawings must be submitted and stamped by City Engineering prior to issuing the Planning Clearance. One stamped set must be available on the job site at all times.

I hereby acknowledge that I have read this application and the information is correct; I agree to comply with any and all codes, ordinances, laws, regulations, or restrictions which apply to the project. I understand that failure to comply shall result in legal action, which may include but not necessarily be limited to non-use of the building(s).


Applicant's Signature \_\_\_\_\_ Date \_\_\_\_\_

Planning Approval PD C McKee Date 9/24/09

Additional water and/or sewer tap fee(s) are required:	YES <input checked="" type="checkbox"/>	NO <input type="checkbox"/>	W/O No. <u>21518</u>
Utility Accounting <u>Dottie Kanavel</u>	Date <u>9-24-09</u>		

VALID FOR SIX MONTHS FROM DATE OF ISSUANCE (Section 2.2.C.1 Grand Junction Zoning and Development Code)

(White: Planning)      (Yellow: Customer)      (Pink: Building Department)      (Goldenrod: Utility Accounting)

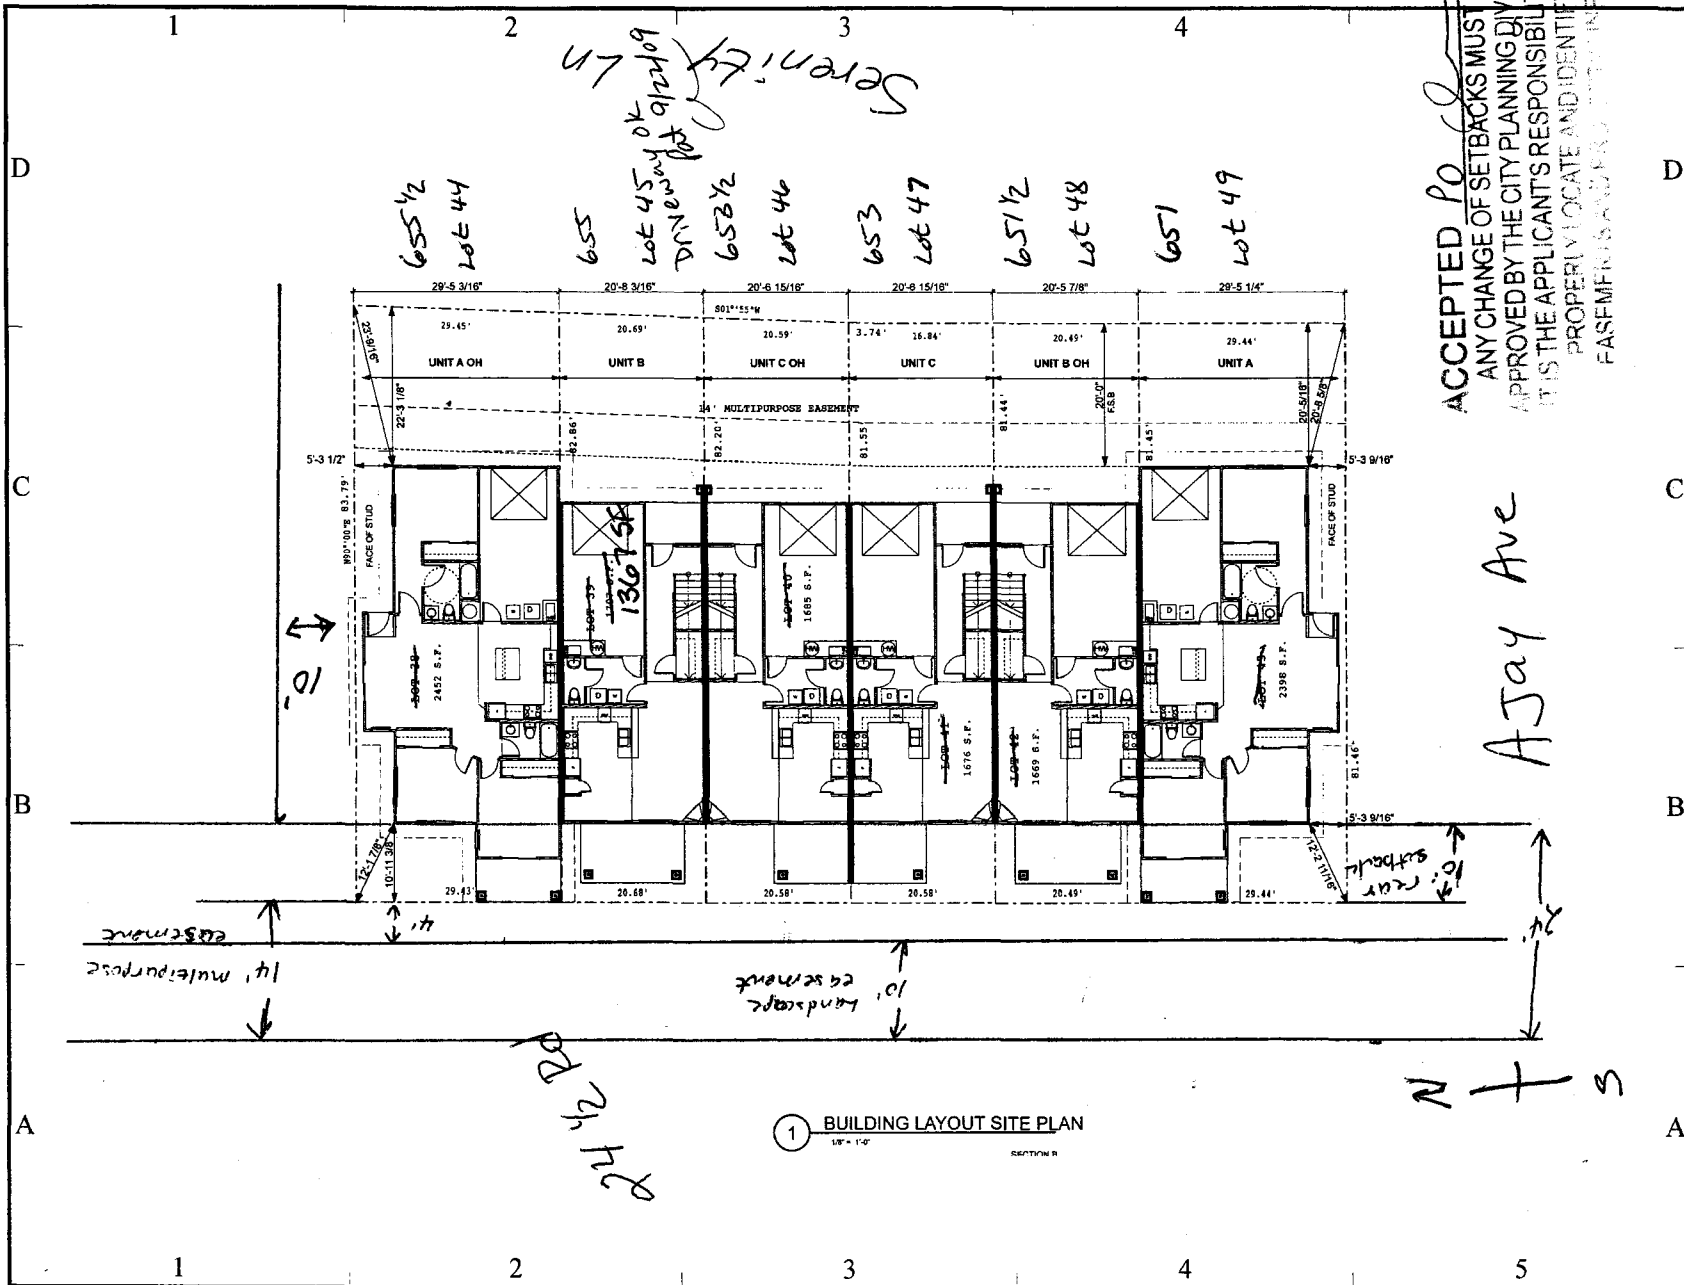

**GENESIS DESIGNS:**  
 Architecture + Planning, P.C.  
 P.O. Box 1851  
 Grand Junction, Colorado 81502  
 (P) 970.245.8083  
 (F) 970.245-7588  
 www.genesisarchitect.com

**COPYRIGHT NOTICE**  
 These drawings are an instrument of services and are property of Genesis Designs Architecture + Planning, P.C. No reproduction of this sheet or any other, in whole or in part, for this or any other project, shall be done without written authorization from Genesis Designs Architecture + Planning, P.C. Copyright

**CONSULTANTS**

**Brookwillow 6-Plex**  
 Lots 44-49  
 Grand Junction, CO

MARK	DATE	DESCRIPTION
	01.08.09	CONSTRUCTION ISSUE

DRAWN BY: HM  
 CHKD BY: Marc Maurer  
 COPYRIGHT:  
 Genesis Designs Architecture + Planning, P.C.  
 01.08.09

**SHEET TITLE**  
 BUILDING LAYOUT SITE PLAN