TCP\$	/
Drainage \$	
SIF\$	
Inspection \$	

PLANNING CLEARANCE

(Multifamily & Nonresidential Remodels and Change of Use)


Planning \$	1000	
Bldg Permit #		
File #		

·ι	_ つ	7	-0
\ 1	•	0	

Inspection \$ / Public Works & Pla	mning Department 432 -0
Building Address 914 SOUTH AVE	Multifamily Only: No. of Existing Units No. Proposed
Parcel No. 2945 - 144 - 39 - 017	
Subdivision G.J.	Sq. Ft. of Existing Sq. Ft. Proposed 216 5F+240SF
	Sq. Ft. of Lot / Parcel
Filing Block152	Sq. Ft. Coverage of Lot by Structures & Impervious Surface
OWNER INFORMATION: MICHAEL KRUGER	(Total Existing & Proposed) 216 SF + 240 SF
Name 914 SOUTH AVENUE, LLC	DESCRIPTION OF WORK & INTENDED USE:
Address 914 South Ave	Remodel Change of Use (*Specify uses below) Addition Change of Business
/Idadess	Other: 9 x 24' STORAGE SHED - PORTABLE
City / State / Zip <u>G.J.</u> , <u>CO</u> <u>8150</u>	10' x 24' STORAGE SHED - PORTABLE * FOR CHANGE OF USE: NO UTILITIES
APPLICANT INFORMATION:	TORCHANGE OF OSE. NO DIVELLES
Name MOR STORAGE	*Existing Use:
	*Proposed Use:APR 1 5 2009
Address <u>3010 L-70 B</u>	RB
City / State / Zip <u>G.J., CO</u> 81504	
Telephone 254 - 0460	Current Fair Market Value of Structure \$ 8,000.
property lines, ingress/egress to the property, driveway locati	existing & proposed structure location(s), parking, setbacks to all ion & width & all easements & rights-of-way which abut the parcel.
THIS SECTION TO BE COM	PLETED BY PLANNING STAFF
zone <u> </u>	Maximum coverage of lot by structures
SETBACKS: Front 15/25 from property line (PL)	
Sidefrom PL Rearfrom PL	Parking Requirement
Maximum Height of Structure(s)	_ Floodplain Certificate Required: YES NO
Ingress / Egress	Special Conditions:
Voting District Location Approval (Engineer's Initials	s)
	l, in writing, by the Public Works & Planning Department. The until a final inspection has been completed and a Certificate of epartment.
	e information is correct; I agree to comply with any and all codes, ne project. I understand that failure to comply shall result in legal non-use of the building(s).
Applicant Signature K Block	Date 3-19-09
Planning Approval <u>Pat Den Gos</u>	Date 4/15/09
	ES NOX W/O No. W with Source
Utility Accounting	Date 4/15/09
	ection 2.2.C.4 Grand Junction Zoning & Development Code)
TALLE FOR SIX MONTHS FROM DATE OF ISSUANCE (SI	oction E.E.O.T Grand Janetion Lonling & Development Code)

(White: Planning) (Pink: Building Department) (Goldenrod: Utility Accounting) (Yellow: Customer)

City of Grand Junction GIS Zoning Map ©

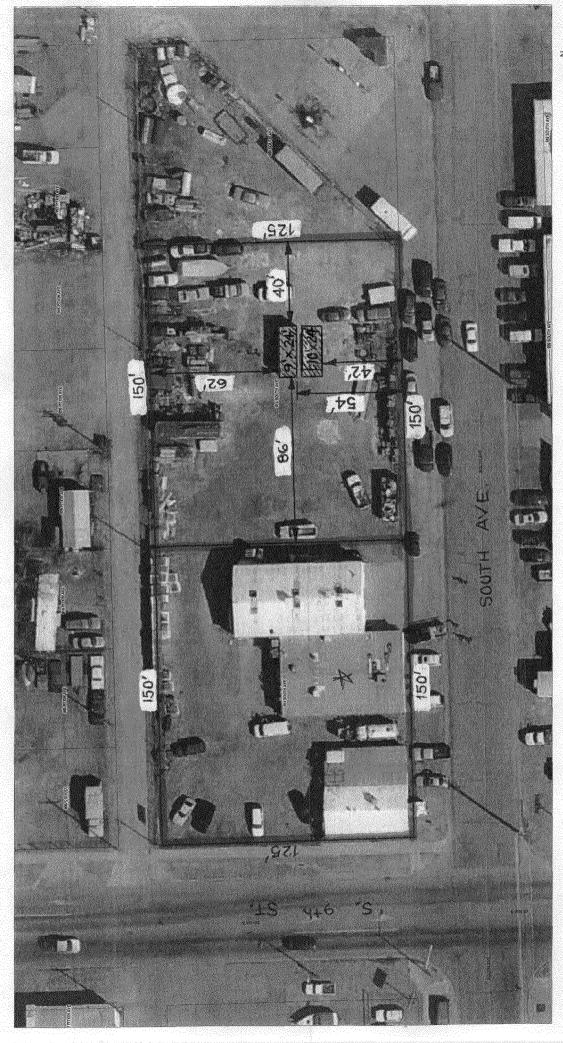

914 South are

Miles Kruger Roofing

IT IS THE APPLICANT'S RESPONSIBILITY TO PPROVED BY THE CITY PLANNING DIVISION ANY CHANGE OF SETBACKS MUST BE FASEMENTS AND PROPERTY LINES. PROPERLY LOCATE AND IDENTIFY

