FEE \$ /0		
TCP \$2554		
SIF ¢	460	


PLANNING CLEARANCE

BLDG PERMIT NO.	

(Single Family Residential and Accessory Structures)

Public Works & Planning Department

Building Address 199 Winter Hawk Dr	No. of Existing Bldgs No. Proposed
Parcel No. 2943-321-28-019	Sq. Ft. of Existing Bldgs Sq. Ft. Proposed 600 9 G
Subdivision HAWKS NEST	Sq. Ft. of Lot / Parcel <u>8459</u>
Filing Two Block Lot 19	Sq. Ft. Coverage of Lot by Structures & Impervious Surface (Total Existing & Proposed)
OWNER INFORMATION:	Height of Proposed Structure 30'
Name 30 Road LLC	DESCRIPTION OF WORK & INTENDED USE:
Address 710 S. 15th St	New Single Family Home (*check type below) Interior Remodel Addition
City / State / Zip GJ, CO 81501	Other (please specify):
APPLICANT INFORMATION:	*TYPE OF HOME PROPOSED:
Name RITEWAY Systems LLC	Site Built Manufactured Home (UBC) Manufactured Home (HUD) Other (please specify): PAID
Address 761 25 Rd	Other (piedac speedly).
City / State / Zip GJ CO 8 1505	OCT 0.9 2009
Telephone 250-7244	íB
	xisting & proposed structure location(s), parking, setbacks to all on & width & all easements & rights-of-way which abut the parcel.
THIS SECTION TO BE COMP	PLETED BY PLANNING STAFF
ZONE R-4	Maximum coverage of lot by structures
SETBACKS: Front 2015 from property line (PL)	Permanent Foundation Required: YESNO
Side 7/3 from PL Rear 25/5 from PL	
201	Floodplain Certificate Required: YESNO/
Maximum Height of Structure(s)35 '	Floodplain Certificate Required: YESNO Parking Requirement
Voting District Driveway Location Approval (Engineer's Initials	Parking Requirement
Voting District Driveway Location Approval (Engineer's Initials Modifications to this Planning Clearance must be approved,	Parking Requirement
Voting District Driveway Location Approval (Engineer's Initials Modifications to this Planning Clearance must be approved, structure authorized by this application cannot be occupied to Occupancy has been issued, if applicable, by the Building Delinereby acknowledge that I have read this application and the	Parking Requirement
Voting District Driveway Location Approval (Engineer's Initials) Modifications to this Planning Clearance must be approved, structure authorized by this application cannot be occupied to Occupancy has been issued, if applicable, by the Building Delinereby acknowledge that I have read this application and the ordinances, laws, regulations of restrictions which apply to the	Parking Requirement
Voting District Driveway Location Approval (Engineer's Initials) Modifications to this Planning Clearance must be approved, structure authorized by this application cannot be occupied to Occupancy has been issued, if applicable, by the Building Deliner of the ordinances, laws, regulations of restrictions which apply to the action, which may include but not necessarily be limited to not the ordinance.	Parking Requirement
Voting District Driveway Location Approval (Engineer's Initials) Modifications to this Planning Clearance must be approved, structure authorized by this application cannot be occupied to Occupancy has been issued, if applicable, by the Building De I hereby acknowledge that I have read this application and the ordinances, laws, regulations of restrictions which apply to the action, which may include but not necessarily be limited to not Applicant Signature	Parking Requirement

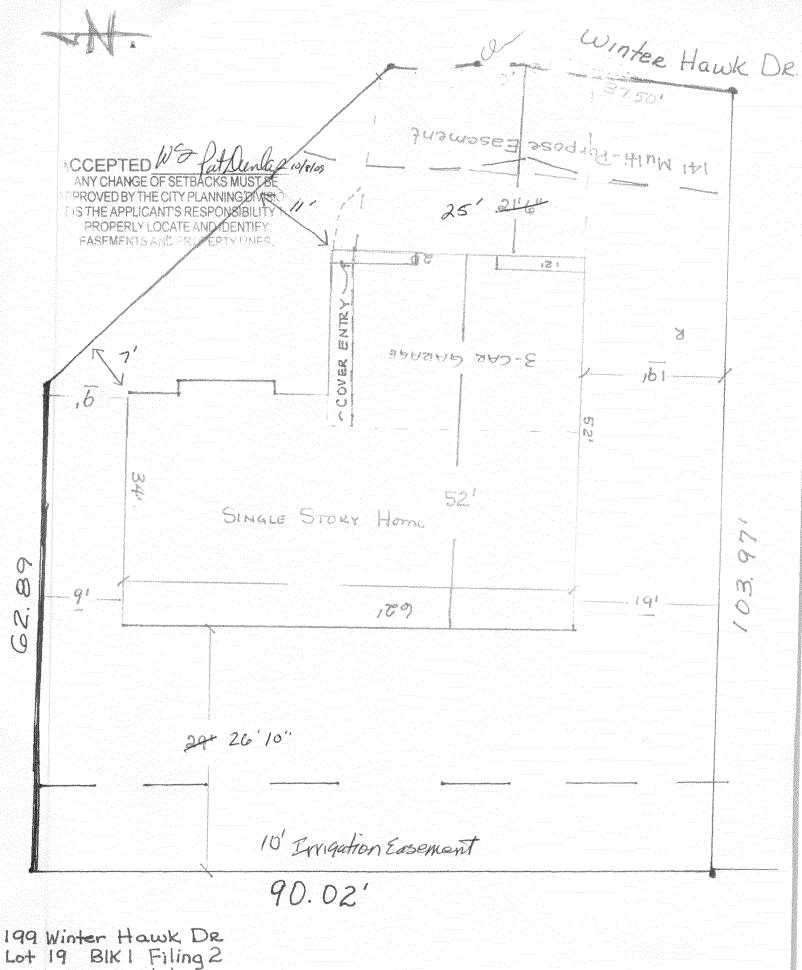

199 Winter Hawk Dr Lot 19 BIK 1 Filing 2 Hawks Nest Subd. 8550 \$