
FEE \$ 10 <sup>42</sup> PLANNING CLEA	BANCE BLDG PERMIT NO.
TCP \$ 2 554 <sup>14</sup> (Single Family Residential and Ad	
SIF \$ 460 SIF \$ Public Works & Plannir	
Building Address <u>654 Levi</u> CF.	No. of Existing Bldgs No. Proposed
Parcel No. <u>2945-024-30-004</u>	Sq. Ft. of Existing Bldgs Sq. Ft. Proposed 🚁 3033
Subdivision Logan Creek	Sq. Ft. of Lot / Parcel 10487
Filing Block Lot	Sq. Ft. Coverage of Lot by Structures & Impervious Surface
OWNER INFORMATION:	(Total Existing & Proposed) <u>47を</u> Height of Proposed Structure <u>33</u>
Name Eben Abstire Harry Horry Horriton	DESCRIPTION OF WORK & INTENDED USE:
Address 101 MPSG UIEN Dr. 595 Pioneur Rd.	New Single Family Home (*check type below)     Interior Remodel     Addition
City / State / Zip 6.J. (09/503/63. (09/504)	Other (please specify):
APPLICANT INFORMATION:	*TYPE OF HOME PROPOSED:
Name Jason Thompson	Site Built Manufactured Home (HUD) Other (please specify):
Address LSL Lev. (7.	
City/State/Zip Grand Jct. (0 SISCI	NOTES:
Telephone <u>G70 201 3460</u>	
	xisting & proposed structure location(s), parking, setbacks to all n & width & all easements & rights-of-way which abut the parcel.
	LETED BY PLANNING STAFF
zone	Maximum coverage of lot by structures5_0
SETBACKS: Front from property line (PL)	Permanent Foundation Required: YES X NO
Side 7 from PL Rear from PL	Floodplain Certificate Required: YESNO
Maximum Height of Structure(s)35	Parking Requirement 2
Voting District Driveway Location Approval (Engineer's Initials)	Special Conditions
	in writing, by the Public Works & Planning Department. The ntil a final inspection has been completed and a Certificate of partment.
	information is correct; I agree to comply with any and all codes, project. I understand that failure to comply shall result in legal n-use of the building(s).
Applicant Signature	Date <u>2/26/16</u>
Planning Approval 10/Mexcep Spuce	Date 5-11-10
Additional water and/or sewer tap fee(s) are required: YES	NO W/O No. $2/(299)$
Utility Accounting (Busley	Date 5////(C
VALID FOR SIX MONTHS FROM DATE OF ISSUANCE (Ser (White: Planning) (Yellow: Customer) (Pink:	ction 2.2.C.4 Grand Junction Zoning & Development Code) Building Department (Goldenrod: Utility Accounting)

(White: Planning)	(Yellow: Customer)
(minutes i normining)	

(Goldenrod: Utility Accounting)

<sup>(</sup>Pink: Building Department)

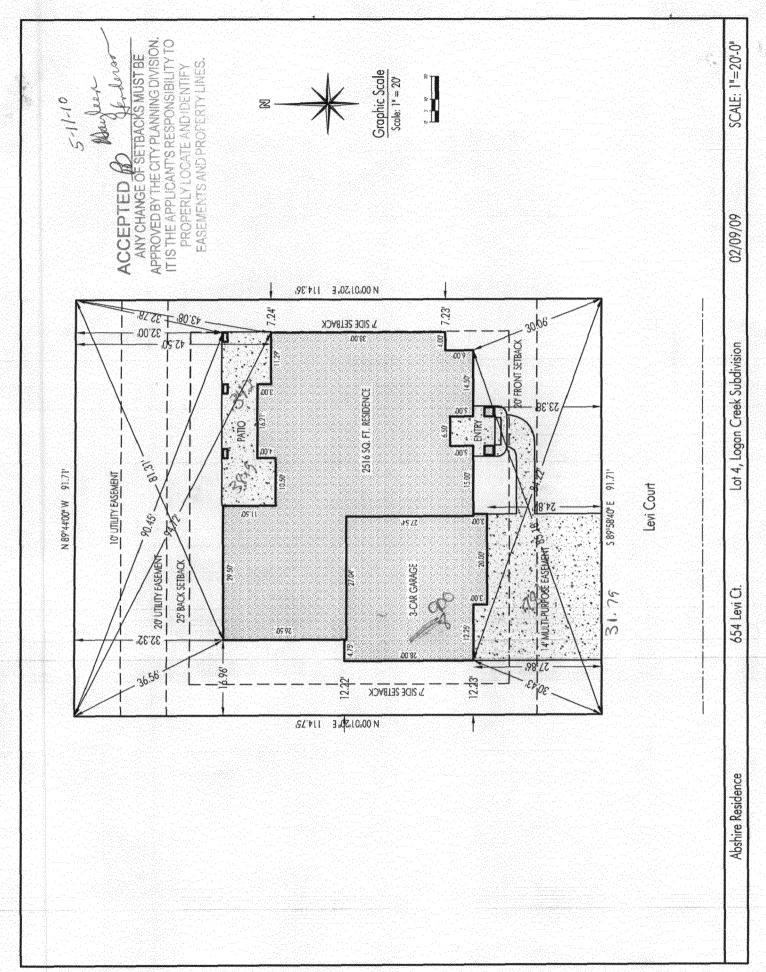

. .