

FEE \$	10.00
TCP \$	Ø
SIF \$	Ø

PLANNING CLEARANCE
 (Single Family Residential and Accessory Structures)
Public Works & Planning Department

BLDG PERMIT NO.

8053-0

Building Address 300 McFarland Ct.
 Parcel No. 2945-112-22-014
 Subdivision _____
 Filing _____ Block _____ Lot _____

No. of Existing Bldgs 1 No. Proposed _____
 Sq. Ft. of Existing Bldgs _____ Sq. Ft. Proposed _____
 Sq. Ft. of Lot / Parcel _____
 Sq. Ft. Coverage of Lot by Structures & Impervious Surface
 (Total Existing & Proposed) _____
 Height of Proposed Structure _____

OWNER INFORMATION:

Name Earl Stults
 Address 300 McFarland Ct.
 City / State / Grand Junction, CO 81501

DESCRIPTION OF WORK & INTENDED USE:

New Single Family Home (*check type below)
 Interior Remodel Addition
 Other (please specify): _____

APPLICANT INFORMATION:

Name Same
 Address _____
 City / State / _____
 Telephone 255-1511

***TYPE OF HOME PROPOSED:**

Site Built Manufactured Home (UBC)
 Manufactured Home (HUD)
 Other (please specify): _____

NOTES: Cover over hot tub

REQUIRED: One plot plan, on 8 1/2" x 11" paper, showing all existing & proposed structure location(s), parking, setbacks to all property lines, ingress/egress to the property, driveway location & width & all easements & rights-of-way which abut the parcel.

THIS SECTION TO BE COMPLETED BY PLANNING STAFF	
ZONE <u>R-4</u>	Maximum coverage of lot by structures <u>50%</u>
SETBACKS: Front <u>20'/25'</u> from property line (PL)	Permanent Foundation Required: YES <input checked="" type="checkbox"/> NO <input type="checkbox"/>
Side <u>7'/3'</u> from PL Rear <u>25'/5'</u> from PL	Floodplain Certificate Required: YES <input type="checkbox"/> NO <input checked="" type="checkbox"/>
Maximum Height of Structure(s) <u>40'</u>	Parking Requirement <u>2</u>
Voting District _____ Driveway Location Approval _____	Special Conditions _____
(Engineer's Initials)	

Modifications to this Planning Clearance must be approved, in writing, by the Public Works & Planning Department. The structure authorized by this application cannot be occupied until a final inspection has been completed and a Certificate of Occupancy has been issued, if applicable, by the Building Department.


I hereby acknowledge that I have read this application and the information is correct; I agree to comply with any and all codes, ordinances, laws, regulations or restrictions which apply to the project. I understand that failure to comply shall result in legal action, which may include but not necessarily be limited to non-use of the building(s).

Applicant Signature Earl Stults Date 8-31-2010
 Planning Approval Gayleen Henderson Date 8-31-2010

Additional water and/or sewer tap fee(s) are required:	YES	NO <input checked="" type="checkbox"/>	W/O No. <u>no sewer / water</u>
Utility Accounting	<u>Done</u>	Date	<u>8/31/10</u>

VALID FOR SIX MONTHS FROM DATE OF ISSUANCE (Section 21.02.070(b) Grand Junction Municipal Code)
 (White: Planning) (Yellow: Customer) (Pink: Building Department) (Goldenrod: Utility Accounting)

City of Grand Junction GIS Master Map ©

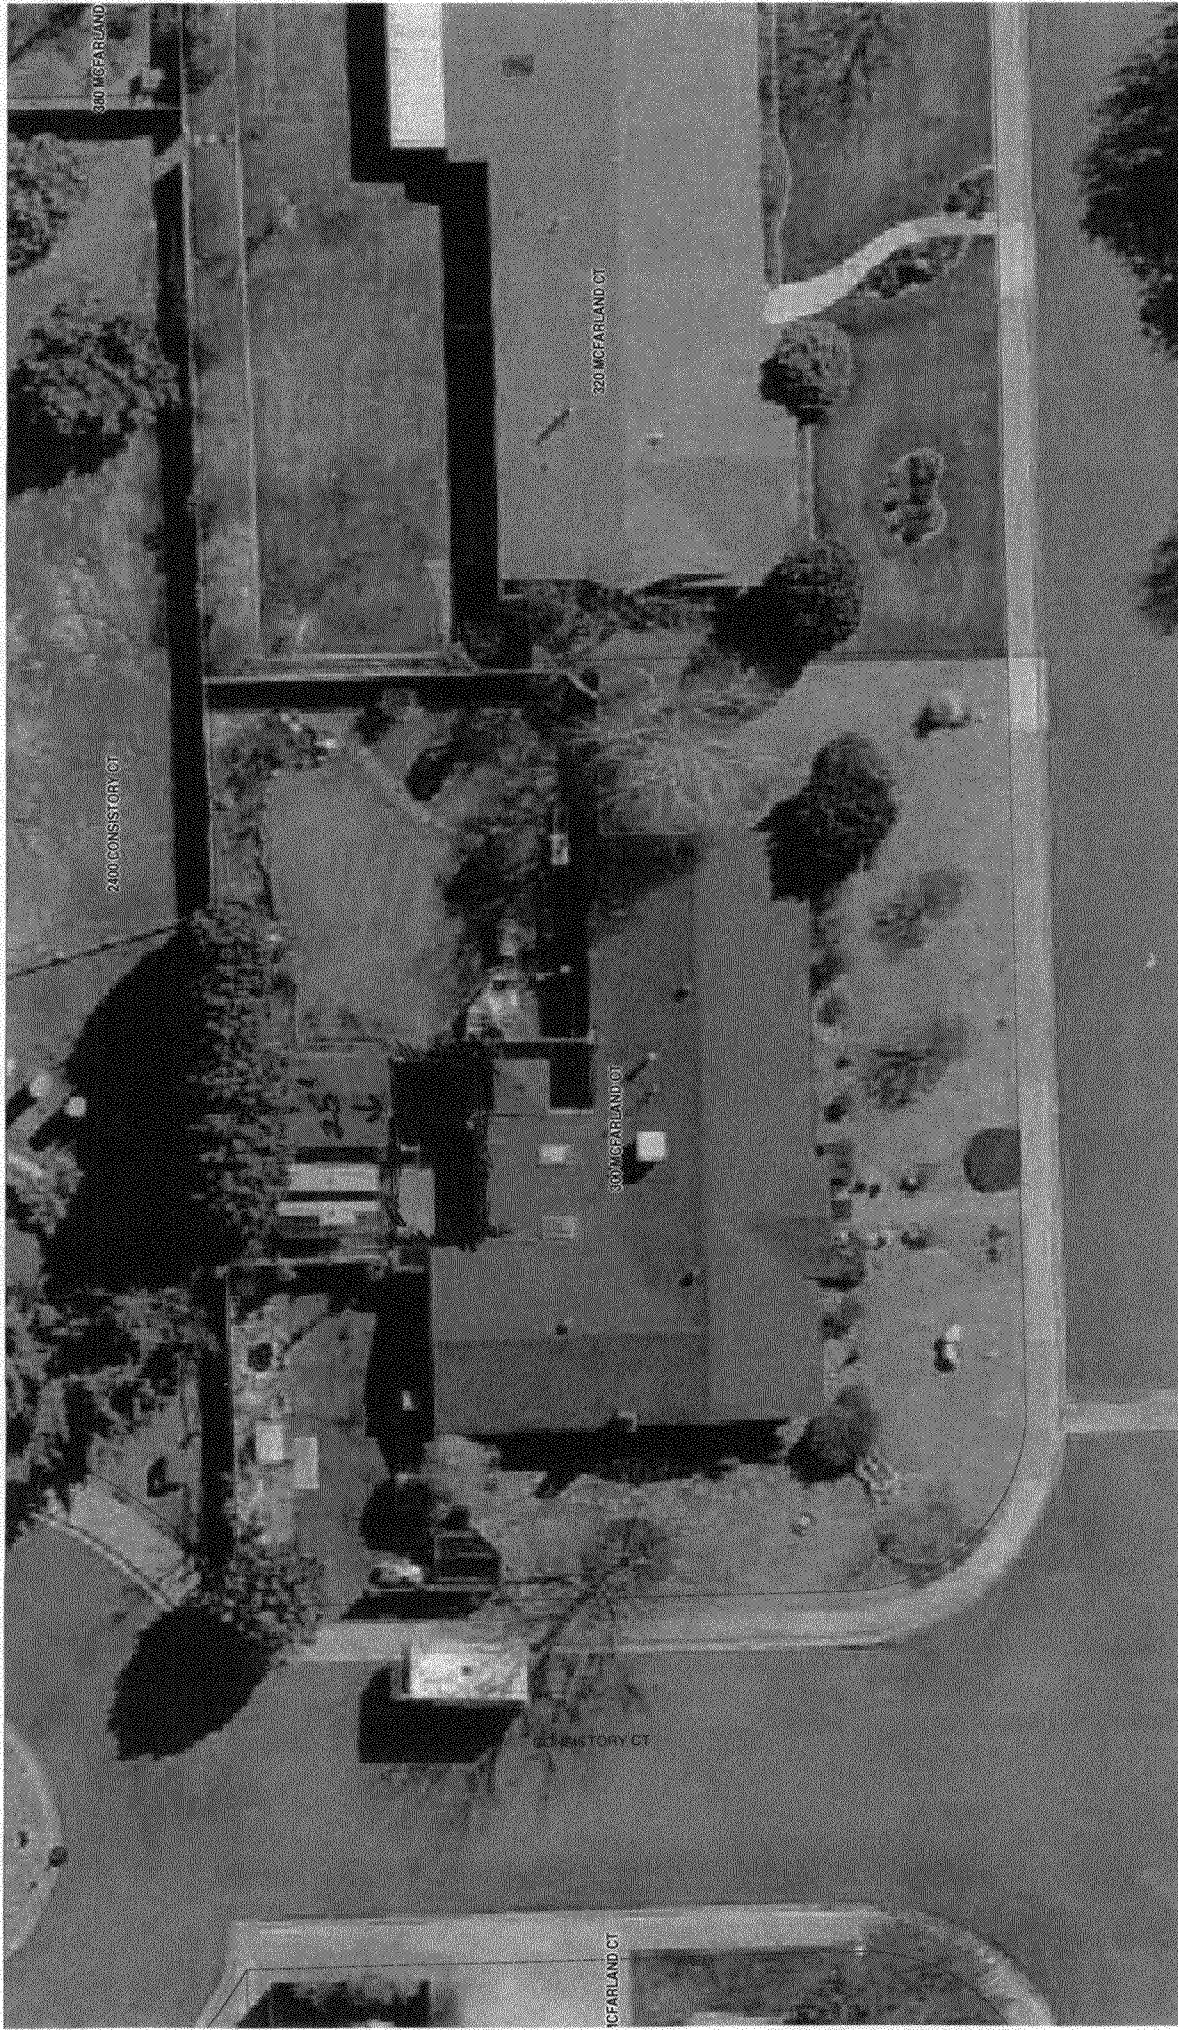

ACCEPTED *Gayle Anderson* 8-31-10
ANY CHANGE OF SETBACKS MUST BE APPROVED BY THE CITY PLANNING DIVISION. IT IS THE APPLICANT'S RESPONSIBILITY TO PROPERLY LOCATE AND IDENTIFY EASEMENTS AND PROPERTY LINES

