PCP-2011-121	
FEE \$ 10 7 PLANNING CLEA	ARANCE BLDG PERMIT NO. 10-0058/
TCP \$ 3554 (Single Family Residential and A	Accessory Structures) DEFERREID
SIF \$ 460 Community Developm	-
Building Address 210 M& A Dow Pt DR,	No. of Existing Bldgs No. Proposed
Parcel No. 2943-304-47-00 2	Sq. Ft. of Existing Bldgs Sq. Ft. Proposed 2008
Subdivision Chipeta Heights	Sq. Ft. of Lot / Parcel 9477
Filing 1 Block 3 Lot 2	Sq. Ft. Coverage of Lot by Structures & Impervious Surface (Total Existing & Proposed)
OWNER INFORMATION:	Height of Proposed Structure
Name JRJ BUILDERS IX Address 3/57 MADDIE CT City/State/Zip CJCo 4/503	DESCRIPTION OF WORK & INTENDED USE: New Single Family Home (*check type below) Interior Remodel Other (please specify):
	TVD5 05 U0U5 DB00055
APPLICANT INFORMATION:	*TYPE OF HOME PROPOSED: Site Built Manufactured Home (UBC)
Name JRJ BUILDERS INC	Manufactured Home (HUD) Other (please specify):
Address	PAID
City / State / Zip	IOTES:
Telephone 340-0546	
REQUIRED: One plot plan, on 8 1/2" x 11" paper, showing all existing & proposed structure location(s), parking, setbacks to all property lines, ingress/egress to the property, driveway location & width & all easements & rights-of-way which abut the parcel.	
THIS SECTION TO BE COMPLETED BY COMMUNITY DEVELOPMENT DEPARTMENT STAFF	
ZONE R-4	Maximum coverage of lot by structures 50 6
SETBACKS: Front <u>30/15</u> from property line (PL)	Permanent Foundation Required: YESNONONONoNO
Side 1/3 from PL Rear 35/5 from PL	Parking Requirement
Maximum Height of Structure(s)	Special Conditions
Voting District Driveway Location Approval(Engineer's Initial	
Modifications to this Planning Clearance must be approved, in writing, by the Community Development Department. The structure authorized by this application cannot be occupied until a final inspection has been completed and a Certificate of Occupancy has been issued, if applicable, by the Building Department (Section 305, Uniform Building Code).	
I hereby acknowledge that I have read this application and the information is correct; I agree to drupy with any and all codes, ordinances, laws, regulations or restrictions which apply to the project. I understand that failure to comply shall result in legal action, which may include but not necessarily be limited to non-use of the building(s).	
Applicant Signature dim densen	Date
Department Approval WI Red Ounds	Date 3/19/10

VALID FOR SIX MONTHS FROM DATE OF SSUANCE (Section 2.2.C.1 Grand Junction Zoning & Development Code)
(White: Planning) (Yellow: Customer) (Pink: Building Department) (Goldenrod: Utility Accounting)

YES


Additional water and/or sewer tap fee(s) are required:


Utility Accounting

NO

Date

W/O No.

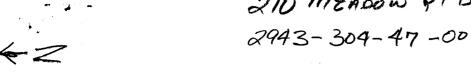

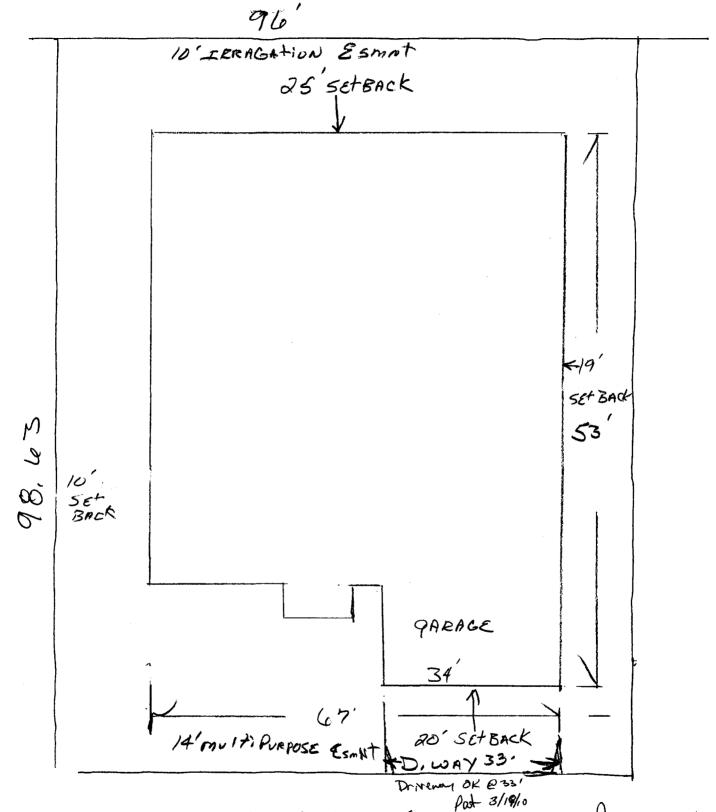

JRJ BUILDERS 260-0546

TIS THE APPLICANT'S RESPONSIBILITY TO

ROPERLY LOCATE / NO IDENTIFY PARENTO LATER YOU PREVIOUS