

FEE \$	10
TCP \$	2,254
SIF \$	460

PLANNING CLEARANCE
 (Single Family Residential and Accessory Structures)
Public Works & Planning Department

BLDG PERMIT NO. _____

Building Address 665 MUIRFIELD DRIVE
 Parcel No. 2943-052-95-001
 Subdivision WALNUT ESTATES
 Filing 1 Block 1 Lot 1

No. of Existing Bldgs 0 No. Proposed 1
 Sq. Ft. of Existing Bldgs — Sq. Ft. Proposed 1926
 Sq. Ft. of Lot / Parcel 9,463
 Sq. Ft. Coverage of Lot by Structures & Impervious Surface
 (Total Existing & Proposed) 3300 34%
 Height of Proposed Structure 20'0"

OWNER INFORMATION:

Name SNEDDON CONSTRUCTION INC.
 Address 2452 HOME RANCH CT.
 City / State / Zip GT/CO/81505

DESCRIPTION OF WORK & INTENDED USE:

New Single Family Home (*check type below)
 Interior Remodel Addition
 Other (please specify): _____

APPLICANT INFORMATION:

Name SNEDDON CONSTRUCTION INC.
 Address 2452 HOME RANCH CT.
 City / State / Zip GT/CO/81505
 Telephone 970-201-9098

***TYPE OF HOME PROPOSED:**

Site Built Manufactured Home (UBC)
 Manufactured Home (HUD)
 Other (please specify): _____

NOTES: _____

REQUIRED: One plot plan, on 8 1/2" x 11" paper, showing all existing & proposed structure location(s), parking, setbacks to all property lines, ingress/egress to the property, driveway location & width & all easements & rights-of-way which abut the parcel.

THIS SECTION TO BE COMPLETED BY PLANNING STAFF

ZONE R-5 Maximum coverage of lot by structures 60
 SETBACKS: Front 20 from property line (PL) Permanent Foundation Required: YES NO
 Side 5 from PL Rear 25 from PL Floodplain Certificate Required: YES NO
 Maximum Height of Structure(s) 35 Parking Requirement 2
 Voting District D Driveway Location Approval PP Special Conditions _____
 (Engineer's Initials)

Modifications to this Planning Clearance must be approved, in writing, by the Public Works & Planning Department. The structure authorized by this application cannot be occupied until a final inspection has been completed and a Certificate of Occupancy has been issued, if applicable, by the Building Department.

I hereby acknowledge that I have read this application and the information is correct; I agree to comply with any and all codes, ordinances, laws, regulations or restrictions which apply to the project. I understand that failure to comply shall result in legal action, which may include but not necessarily be limited to non-use of the building(s).

Applicant Signature [Signature] Date 3/30/10
 Planning Approval [Signature] Date 4/8/10


Additional water and/or sewer tap fee(s) are required:	YES	NO	W/O No. <u>21653</u>
Utility Accounting <u>[Signature]</u>	Date <u>4-23-10</u>		

VALID FOR SIX MONTHS FROM DATE OF ISSUANCE (Section 2.2.C.4 Grand Junction Zoning & Development Code)
 (White: Planning) (Yellow: Customer) (Pink: Building Department) (Goldenrod: Utility Accounting)

665 MUIRFIELD DRIVE - LOT 1 - BLOCK 1 - FILING 1 - WALNUT ESTATES
 SITE/PLOT PLAN - DOUGLAS MODEL - 20 SCALE - PREPARED BY SAEDON CONST



BRODICKWAY

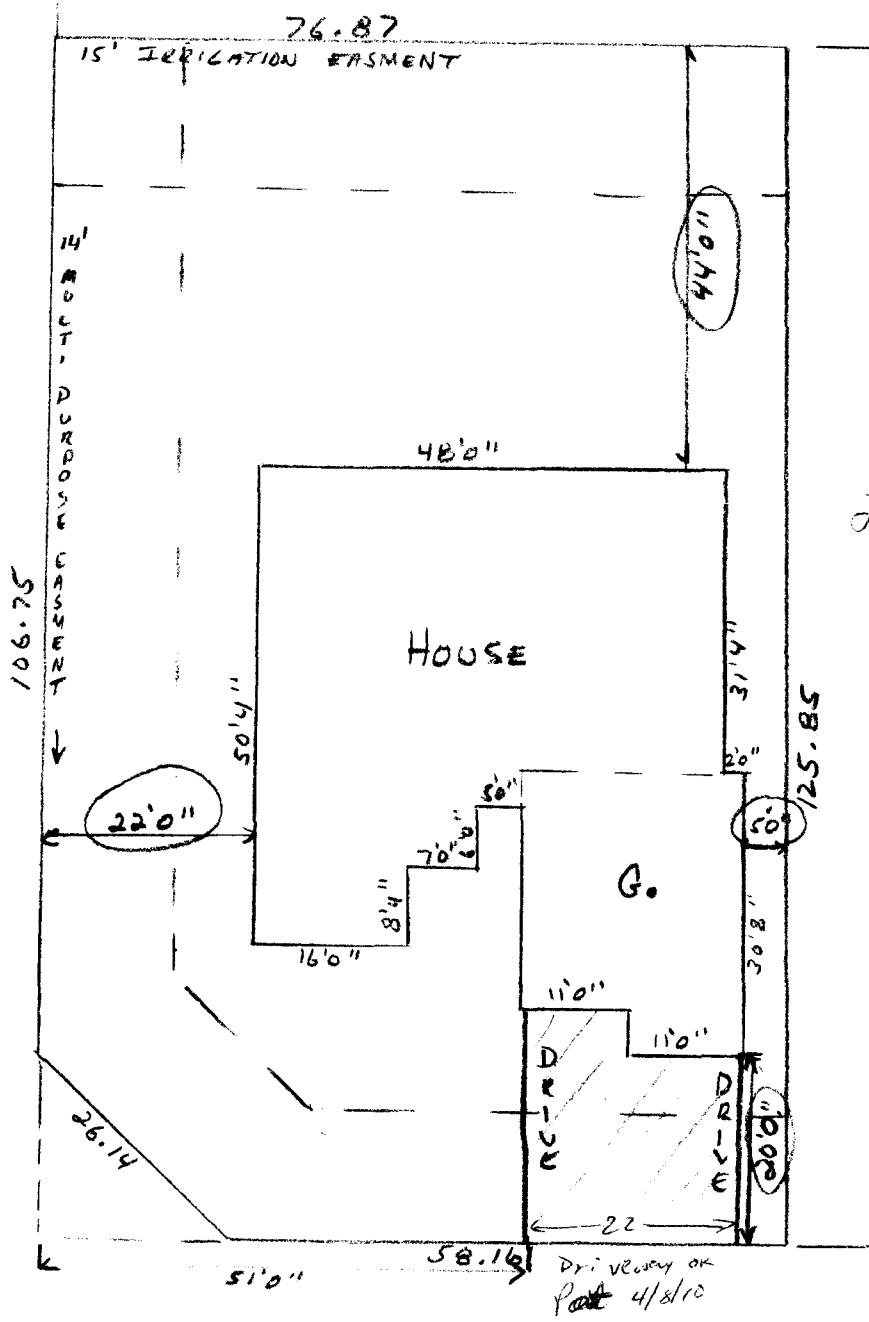

Lot 2

ACCEPTED BY Pat O'Connell 4/8/10

MUIRFIELD DRIVE