
1,00	ed tees
FEE \$ 1000 PLANNING CLEARA	ANCE BLDG PERMIT NO.
TCP \$ 2554 5 Single Family Residential and Acces  SIF \$ 460 0 Public Works & Planning De	epartment ZONIOU)
OCH Date T	00361 06698 SSV COV
Building Address Zlob 6 Summalfill ct 815x	b. of Existing Bldgs No. Proposed
Parcel No. 2701-261-47-002 sq	n. Ft. of Existing Bldgs <u>6 -</u> Sq. Ft. Proposed <u>7700</u>
Subdivision <u>Summer hill Filther</u> sq	q. Ft. of Lot / Parcel 6258 6229 08
	n. Ft. Coverage of Lot by Structures & Impervious Surface otal Existing & Proposed)
	eight of Proposed Structure
Name LGD Construction for DE  Address Po Box 1925  City/State/Zip 65. Co 81562	SCRIPTION OF WORK & INTENDED USE:  New Single Family Home (*check type below) Interior Remodel Addition Other (please specify):
	YPE OF HOME PROPOSED:
Name LGD Construction true	Site Built
Address Po Box 1925	Other (please specify): TEC 0.2 2010
	OTES:
Telephone 250-9614	
REQUIRED: One plot plan, on 8 1/2" x 11" paper, showing all existing property lines, ingress/egress to the property, driveway location & v	
THIS SECTION TO BE COMPLET	
ZONE Ma	
ZONE Ma SETBACKS: Front ZO 1/40 from property line (PL) Pe	ED BY PLANNING STAFF
ZONE	red by Planning Staff aximum coverage of lot by structures
ZONE	ermanent Foundation Required: YES NO
ZONE	ermanent Foundation Required: YESNO
ZONE	remanent Foundation Required: YES X NO
SETBACKS: Front 20/40 from property line (PL) Perside 7/3 from PL Rear /5/10 from PL Flow Maximum Height of Structure(s) 32 Part Voting District B Driveway Location Approval Congineer's Initials)  Modifications to this Planning Clearance must be approved, in we structure authorized by this application cannot be occupied until a Occupancy has been issued, if applicable, by the Building Departure I hereby acknowledge that I have read this application and the information, which may include but not processarily be limited to non-use.	responsible to the structures
SETBACKS: Front 20/40 from property line (PL) Perside 7/3 from PL Rear 15/10 from PL Flow Maximum Height of Structure(s) 32 Part Voting District B Driveway Location Approval Po (Engineer's Initials) Part Modifications to this Planning Clearance must be approved, in we structure authorized by this application cannot be occupied until a Occupancy has been issued, if applicable, by the Building Depart I hereby acknowledge that I have read this application and the information or restrictions which apply to the project of the proj	respectively. The second structures arising Requirement Tournations.  The second structures arising Requirement Tournations.  The second structures arising Requirement Tournation second structures.  The second structure of
SETBACKS: Front 20/40 from property line (PL) Perside 7/3 from PL Rear /5/10 from PL Flow Maximum Height of Structure(s) 32 Particular Property line (PL) Particular Property line (PL) Particular Par	respectively. The properties of lot by structures
SETBACKS: Front 20/40 from property line (PL) Perside 7/3 from PL Rear /5/10 from PL Flow Maximum Height of Structure(s) 32' Particular Particu	riting, by the Public Works & Planning Department. The a final inspection has been completed and a Certificate of ment.  rmation is correct; I agree to comply with any and all codes, eiget. I understand that failure to comply shall result in legal se of the building(s).
SETBACKS: Front 20/40 from property line (PL)  Side 7/3 from PL Rear 15/10 from PL Flow Maximum Height of Structure(s) 32'  Pa  Voting District B Driveway Location Approval (Engineer's Initials)  Modifications to this Planning Clearance must be approved, in we structure authorized by this application cannot be occupied until a Occupancy has been issued, if applicable, by the Building Departs I hereby acknowledge that I have read this application and the information ordinances, laws, regulations or restrictions which apply to the projection, which may include but not processarily be limited to non-used Applicant Signature  Planning Approval Departs Signature Planning Approval Planning App	remanent Foundation Required: YES X NO

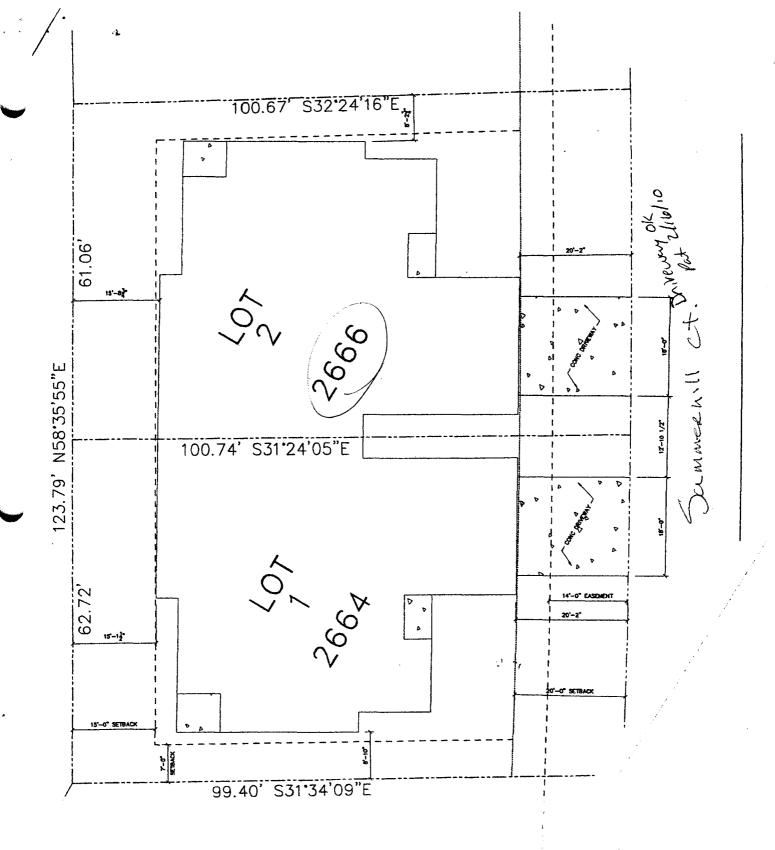

ACCEPTED POLICY ANY CHANGE OF SETBACKS MUST BE APPROVED BY THE CITY PLANNING DIVISION.

THIS THE APPLICANT'S RESPONSIBILITY TO TROPER ON COME AND COME.

Cherled by Lopia Raproleds