
| TCP \$ 2554 0 (Single Family Residential and )  | Accessory Structures)   |
|---|---|
| SIF \$ 460 <sup>50</sup> Public Works & Plann   | ing Department  |
|   | $\sim$  |
| Building Address 162 Wonter Hawk Dr   | No. of Existing Bldgs No. Proposed  |
| Parcel No. 293-321-31-012   | Sq. Ft. of Existing Bldgs Sq. Ft. Proposed 701 G  |
| Subdivision tauks Met   | Sq. Ft. of Lot / Parcel 9132 9147, 6  |
| Filing Block Lot 12   | Sq. Ft. Coverage of Lot by Structures & Impervious Surface<br>(Total Existing & Proposed) 3857  |
| OWNER INFORMATION:  | (Total Existing & Proposed) <u>3887</u> <u>9</u> <u>4</u> 00<br>Height of Proposed Structure <u>33</u>  |
| Name 30 Rd UC   | DESCRIPTION OF WORK & INTENDED USE:   |
| Address 710518th  | New Single Family Home (*check type below)  |
| City/State/Zip GJC0 &VD1  | Other (please specify):   |
|   |   |
| APPLICANT INFORMATION:  | *TYPE OF HOME PROPOSED:   |
| Name Steardy Const UC   | Manufactured Home (HUD)   |
| Address 761252  | Other (please specify): PATE  |
| City / State / Zip <u>65 CO 名いのち</u>  | PAID<br>NOTES:  |
|   |   |
| Telephone <u>200-7244</u>   |   |
| REQUIRED: One plot plan, on 8 1/2" x 11" paper, showing all   | existing & proposed structure location(s), parking, setbacks to all   |
| REQUIRED: One plot plan, on 8 1/2" x 11" paper, showing all property lines, ingress/egress to the property, driveway locati   | TR  |
| REQUIRED: One plot plan, on 8 1/2" x 11" paper, showing all property lines, ingress/egress to the property, driveway locati   | existing & proposed structure location(s), parking, setbacks to all<br>on & width & all easements & rights-of-way which abut the parcel.  |
| REQUIRED: One plot plan, on 8 1/2" x 11" paper, showing all<br>property lines, ingress/egress to the property, driveway locati<br>THIS SECTION TO BE COM  | existing & proposed structure location(s), parking, setbacks to all<br>on & width & all easements & rights-of-way which abut the parcel.<br>PLETED BY PLANNING STAFF<br>Maximum coverage of lot by structures5076   |
| REQUIRED: One plot plan, on 8 1/2" x 11" paper, showing all property lines, ingress/egress to the property, driveway locati<br>THIS SECTION TO BE COM   | existing & proposed structure location(s), parking, setbacks to all<br>on & width & all easements & rights-of-way which abut the parcel.<br>PLETED BY PLANNING STAFF  |
| REQUIRED: One plot plan, on 8 1/2" x 11" paper, showing all property lines, ingress/egress to the property, driveway locati         THIS SECTION TO BE COM         CONE         ZONE         SETBACKS: Front  | existing & proposed structure location(s), parking, setbacks to all<br>on & width & all easements & rights-of-way which abut the parcel.<br>PLETED BY PLANNING STAFF<br>Maximum coverage of lot by structures   |
| REQUIRED: One plot plan, on 8 1/2" x 11" paper, showing all property lines, ingress/egress to the property, driveway location         THIS SECTION TO BE COM         ZONE         R-4         SETBACKS: Front         20         from property line (PL)         Side         Triveway         Driveway   | existing & proposed structure location(s), parking, setbacks to all<br>on & width & all easements & rights-of-way which abut the parcel.<br>PLETED BY PLANNING STAFF<br>Maximum coverage of lot by structures <u>50%</u><br>Permanent Foundation Required: YES <u>X</u> NO <u></u><br>Floodplain Certificate Required: YES <u>NO X</u><br>Parking Requirement <u>2</u>  |
| REQUIRED: One plot plan, on 8 1/2" x 11" paper, showing all property lines, ingress/egress to the property, driveway location         THIS SECTION TO BE COM         CONE         R-4         SETBACKS: Front         20         from property line (PL)         Side         7         from PL       Rear         AC         Maximum Height of Structure(s)         Uoting District         Driveway         Location Approval $PD$ Modifications to this Planning Clearance must be approved  | existing & proposed structure location(s), parking, setbacks to all<br>on & width & all easements & rights-of-way which abut the parcel.<br>PLETED BY PLANNING STAFF<br>Maximum coverage of lot by structures <u>50%</u><br>Permanent Foundation Required: YES <u>X</u> NO<br>Floodplain Certificate Required: YES <u>NO</u><br>Parking Requirement <u>2</u><br>Special Conditions<br>s)<br>I, in writing, by the Public Works & Planning Department. The<br>until a final inspection has been completed and a Certificate of   |
| REQUIRED: One plot plan, on 8 1/2" x 11" paper, showing all property lines, ingress/egress to the property, driveway location         THIS SECTION TO BE COM         CONE         R-4         SETBACKS: Front         20         from property line (PL)         Side         7         from PL         Rear         25         from PL         Maximum Height of Structure(s)         Uvoting District         Driveway         Location Approval         PD         Woting District         Driveway         Location Approval         PD         (Engineer's Initial         Modifications to this Planning Clearance must be approved         structure authorized by this application cannot be occupied         Occupancy has been issued, if applicable, by the Building D         I hereby acknowledge that I happer read this application and th | existing & proposed structure location(s), parking, setbacks to all<br>on & width & all easements & rights-of-way which abut the parcel.<br>PLETED BY PLANNING STAFF<br>Maximum coverage of lot by structures <u>50%</u><br>Permanent Foundation Required: YES <u>NO</u><br>Floodplain Certificate Required: YES <u>NO</u><br>Parking Requirement <u>2</u><br>Special Conditions<br>s)<br>I, in writing, by the Public Works & Planning Department. The<br>until a final inspection has been completed and a Certificate of<br>the partment.<br>e information is correct; I agree to comply with any and all codes,<br>he project. I understand that failure to comply shall result in legal  |
| REQUIRED: One plot plan, on 8 1/2" x 11" paper, showing all property lines, ingress/egress to the property, driveway location         THIS SECTION TO BE COM         X-4         ZONE         X-4         SETBACKS: Front       20         from PL       Rear       25         Side       7       from PL       Rear       25         Maximum Height of Structure(s)         Voting District       E       Driveway         Location Approval       D         Modifications to this Planning Clearance must be approved       Structure authorized by this application cannot be occupied       Occupancy has been issued, if applicable, by the Building D         I hereby acknowledge that I have read this application and th ordinances, laws, regulations or restrictions which apply to the  | existing & proposed structure location(s), parking, setbacks to all<br>on & width & all easements & rights-of-way which abut the parcel.<br>PLETED BY PLANNING STAFF<br>Maximum coverage of lot by structures <u>50%</u><br>Permanent Foundation Required: YES <u>NO</u><br>Floodplain Certificate Required: YES <u>NO</u><br>Parking Requirement <u>2</u><br>Special Conditions<br>s)<br>I, in writing, by the Public Works & Planning Department. The<br>until a final inspection has been completed and a Certificate of<br>the partment.<br>e information is correct; I agree to comply with any and all codes,<br>he project. I understand that failure to comply shall result in legal  |
| REQUIRED: One plot plan, on 8 1/2" x 11" paper, showing all property lines, ingress/egress to the property, driveway location         THIS SECTION TO BE COM         ZONE   | existing & proposed structure location(s), parking, setbacks to all<br>on & width & all easements & rights-of-way which abut the parcel.<br>PLETED BY PLANNING STAFF<br>Maximum coverage of lot by structures <u>50%</u><br>Permanent Foundation Required: YES <u>NO</u><br>Floodplain Certificate Required: YES <u>NO</u><br>Parking Requirement <u>2</u><br>Special Conditions<br>s)<br>I, in writing, by the Public Works & Planning Department. The<br>until a final inspection has been completed and a Certificate of<br>pertment.<br>e information is correct; I agree to comply with any and all codes,<br>he project. I understand that failure to comply shall result in legal<br>ion-use of the building(s).<br><u>Date</u> <u>6/10/10</u> |
| REQUIRED: One plot plan, on 8 1/2" x 11" paper, showing all property lines, ingress/egress to the property, driveway location THIS SECTION TO BE COM         THIS SECTION TO BE COM         ZONE  | existing & proposed structure location(s), parking, setbacks to all<br>on & width & all easements & rights-of-way which abut the parcel.<br>PLETED BY PLANNING STAFF<br>Maximum coverage of lot by structures <u>50%</u><br>Permanent Foundation Required: YES <u>NO</u><br>Floodplain Certificate Required: YES <u>NO</u><br>Parking Requirement <u>2</u><br>Special Conditions<br>s)<br>I, in writing, by the Public Works & Planning Department. The<br>until a final inspection has been completed and a Certificate of<br>permanent.<br>e information is correct; I agree to comply with any and all codes,<br>he project. I understand that failure to comply shall result in legal<br>ion-use of the building(s).                              |
| REQUIRED: One plot plan, on 8 1/2" x 11" paper, showing all property lines, ingress/egress to the property, driveway location THIS SECTION TO BE COM         THIS SECTION TO BE COM         ZONE  | existing & proposed structure location(s), parking, setbacks to all<br>on & width & all easements & rights-of-way which abut the parcel.<br><b>PLETED BY PLANNING STAFF</b><br>Maximum coverage of lot by structures $50/20$<br>Permanent Foundation Required: YES X_NO<br>Floodplain Certificate Required: YES NO X<br>Parking Requirement 2<br>Special Conditions<br>s)<br>I, in writing, by the Public Works & Planning Department. The<br>until a final inspection has been completed and a Certificate of<br>hepartment.<br>e information is correct; I agree to comply with any and all codes,<br>he project. I understand that failure to comply shall result in legal<br>ion-use of the building(s).<br>Date $6/10/10$                        |

3

 VALID FOR SIX MONTHS FROM DATE OF ISSUAN
 E (Section 2.2.C.4 Grand Junction Zoning & Development Code)

 (White: Planning)
 (Yellow: Customer)
 (Pink: Building Department)
 (Goldenrod: Utility Accounting)

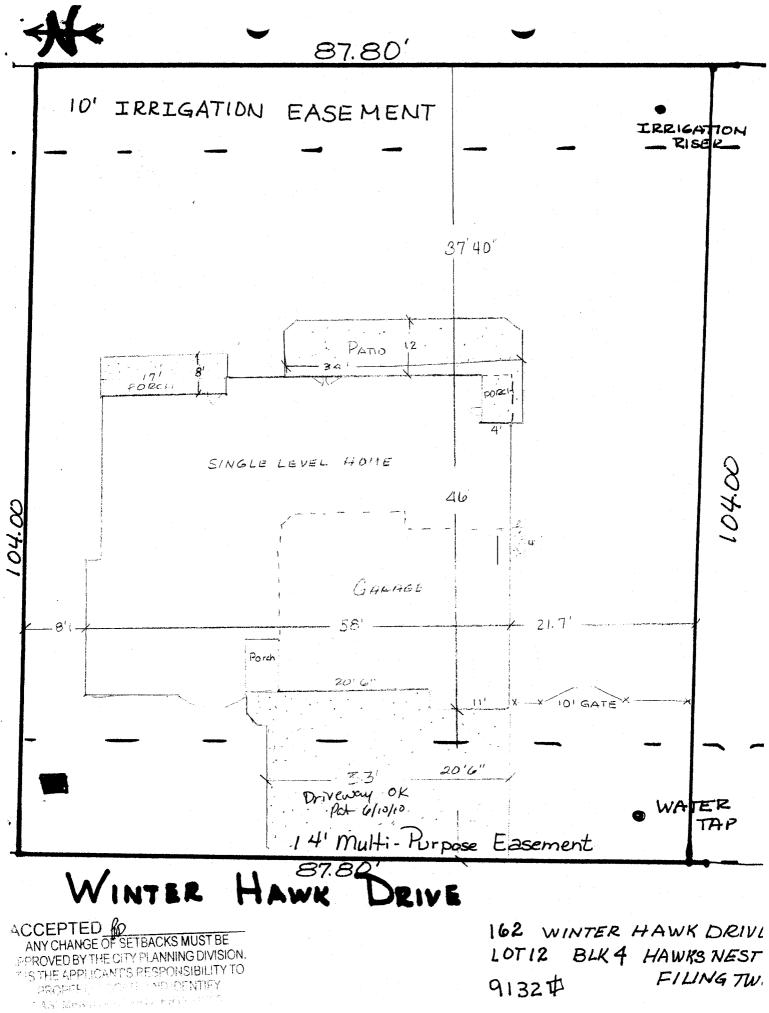

FILING TW. 9132中