	- (2
FEE\$	1000
TCP\$	2554 60
SIF \$	4600

(White: Planning)

(Yellow: Customer)

PLANING CLEARANCE

DG PERMIT NO.


(Goldenrod: Utility Accounting)

(Single Family Residential and Accessory Structures)

Public Works & Planning Department

Building Address 169 Winter Hawk 12k	No. of Existing Bldgs No. Proposed
Parcel No. 2943-321-32-006	Sq. Ft. of Existing Bldgs Sq. Ft. Proposed 12&40
Subdivision Hawks Nest	Sq. Ft. of Lot / Parcel 9129 9147, 6
Filing 2 Block 5 Lot 6	Sq. Ft. Coverage of Lot by Structures & Impervious Surface (Total Existing & Proposed) 4550
OWNER INFORMATION:	Height of Proposed Structure 33
Name 30 Rd Com LLC	DESCRIPTION OF WORK & INTENDED USE:
Address 710 S 15" S#	New Single Family Home (*check type below) Interior Remodel Addition
City / State / Zip 6 0 0 8 150 1	Other (please specify):
APPLICANT INFORMATION:	*TYPE OF HOME PROPOSED:
Name Steady Const UC	Site Built
Address 761 25 Rd	Other (please specify): PAID
City / State / Zip 65 65 505	NOTES: JUN 1 1 2010
Telephone 250 (7244)	2014 11 5010
	existing & proposed structure location(s), parking, setbacks to all on & width & all easements & rights-of-way which abut the parcel.
THIS SECTION TO BE COM	PLETED BY PLANNING STAFF
zone R-4	PLETED BY PLANNING STAFF Maximum coverage of lot by structures5でん
ρ_{A}	~ C7
ZONE	Maximum coverage of lot by structures
ZONE	Maximum coverage of lot by structures
ZONE	Maximum coverage of lot by structures
SETBACKS: Front 20 from property line (PL) Side 7 from PL Rear 25 from PL Maximum Height of Structure(s) Uriveway Voting District Driveway Location Approval (Engineer's Initials) Modifications to this Planning Clearance must be approved	Maximum coverage of lot by structures
SETBACKS: Front 20 from property line (PL) Side 7 from PL Rear 25 from PL Maximum Height of Structure(s) Uriveway Voting District Driveway Location Approval (Engineer's Initials) Modifications to this Planning Clearance must be approved structure authorized by this application cannot be occupied Occupancy has been issued, if applicable, by the Building D. I hereby acknowledge that I have read this application and the	Maximum coverage of lot by structures
SETBACKS: Front 20 from property line (PL) Side 7 from PL Rear 25 from PL Maximum Height of Structure(s) Uriveway Location Approval (Engineer's Initials) Modifications to this Planning Clearance must be approved structure authorized by this application cannot be occupied Occupancy has been issued, if applicable, by the Building D I hereby acknowledge that I have read this application and the ordinances, laws, regulations or restrictions which apply to the	Maximum coverage of lot by structures
SETBACKS: Front 20 from property line (PL) Side 7 from PL Rear 25 from PL Maximum Height of Structure(s) Driveway Location Approval (Engineer's Initials) Modifications to this Planning Clearance must be approved structure authorized by this application cannot be occupied Occupancy has been issued, if applicable, by the Building D I hereby acknowledge that I have read this application and the ordinances, laws, regulations or restrictions which apply to the action, which may include but not necessarily be limited to necessarily.	Maximum coverage of lot by structures
SETBACKS: Front 20 from property line (PL) Side 7 from PL Rear 25 from PL Maximum Height of Structure(s) Voting District Driveway Location Approval (Engineer's Initials) Modifications to this Planning Clearance must be approved structure authorized by this application cannot be occupied Occupancy has been issued, if applicable, by the Building Delian I hereby acknowledge that I have read this application and the ordinances, laws, regulations or restrictions which apply to the action, which may include but not necessarily be limited to not applicant Signature 100 from PL Applicant Signature 100 from property line (PL) Area 25 from PL Driveway Location Approval (Engineer's Initials) (Engineer's Initials)	Maximum coverage of lot by structures
SETBACKS: Front 20 from property line (PL) Side 7 from PL Rear 25 from PL Maximum Height of Structure(s) Voting District Driveway Location Approval (Engineer's Initials) Modifications to this Planning Clearance must be approved structure authorized by this application cannot be occupied Occupancy has been issued, if applicable, by the Building D I hereby acknowledge that I have read this application and the ordinances, laws, regulations or restrictions which apply to the action, which may include but not necessarily be limited to not planning Approval Planning Approval Power and Application and Applicant Signature Planning Approval Power and Application and Applicant Signature Planning Approval Power and Application and Applicant Signature	Maximum coverage of lot by structures

(Pink: Building Department)

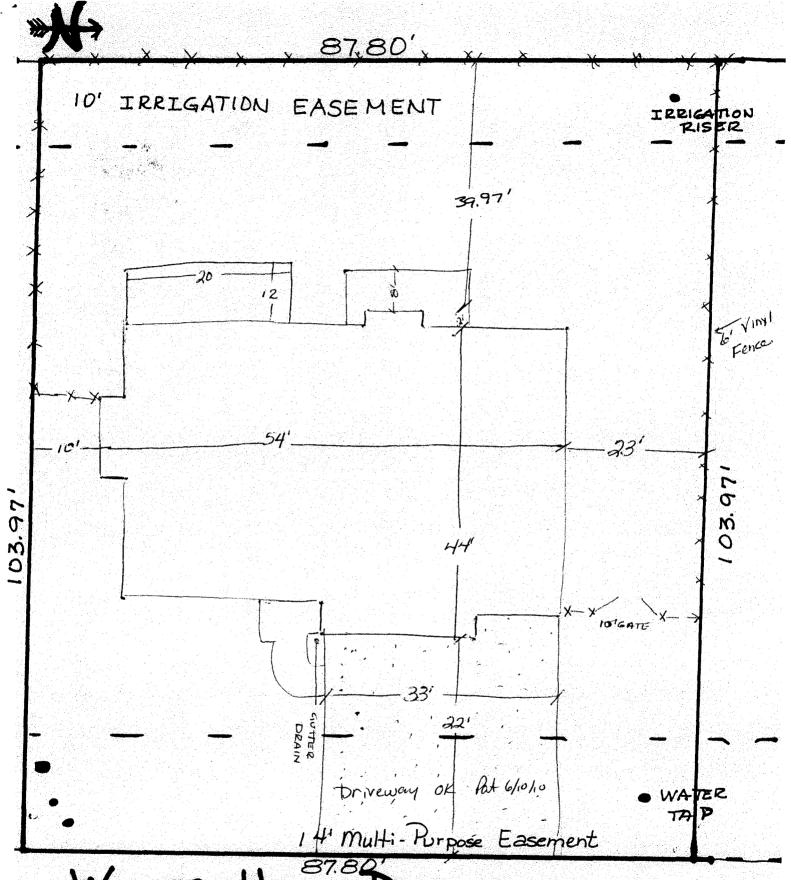

WINTER HAWK DRIVE

ACCEPTED AND ANY CHANGE OF SETBACKS MUST BE PEROVED BY THE CITY PLANNING DIVISION.
TIS THE APPLICANT'S RESPONSIBILITY TO PROPERLY LOCATE AND PROPE

169 WINTER HAWK DRIVE LOTE BLK5 HAWKS NEST 9129 # FILING TWO