

FEE \$	10 ⁰⁰
TCP \$	2554 ⁰⁰
SIF \$	460 ⁰⁰

PLANNING CLEARANCE
 (Single Family Residential and Accessory Structures)
Public Works & Planning Department

BLDG PERMIT NO. _____

Building Address 183 WINTER Hawk Dr No. of Existing Bldgs 0 No. Proposed 1
 Parcel No. 2943-321-28-027 Sq. Ft. of Existing Bldgs 0 Sq. Ft. Proposed 19220
 Subdivision Hawks Nest Sq. Ft. of Lot / Parcel 9365
 Filing 2 Block 1 Lot 27 Sq. Ft. Coverage of Lot by Structures & Impervious Surface (Total Existing & Proposed) 4600 + 4600 = 4970
 Height of Proposed Structure 33'

OWNER INFORMATION:

Name 30 Rd LLC
 Address 710 S 15 St
 City / State / Zip GJCO 81501

DESCRIPTION OF WORK & INTENDED USE:

- New Single Family Home (*check type below)
- Interior Remodel Addition
- Other (please specify): _____

APPLICANT INFORMATION:

Name Steady CONST, LLC
 Address 761 25 Rd
 City / State / Zip GR Jct, CO 81505
 Telephone 250-7244

***TYPE OF HOME PROPOSED:**

- Site Built Manufactured Home (UBC)
- Manufactured Home (HUD)
- Other (please specify): _____

NOTES: _____

REQUIRED: One plot plan, on 8 1/2" x 11" paper, showing all existing & proposed structure location(s), parking, setbacks to all property lines, ingress/egress to the property, driveway location & width & all easements & rights-of-way which abut the parcel.

THIS SECTION TO BE COMPLETED BY PLANNING STAFF

ZONE R-4 Maximum coverage of lot by structures 50%
 SETBACKS: Front 20 from property line (PL) Permanent Foundation Required: YES X NO _____
 Side 7 from PL Rear 25 from PL Floodplain Certificate Required: YES _____ NO X
 Maximum Height of Structure(s) 35 Parking Requirement 2 **PAID**
 Voting District E Driveway Location Approval PD Special Conditions _____
 (Engineer's Initials) **MAR 29 2010**


Modifications to this Planning Clearance must be approved, in writing, by the Public Works & Planning Department. The structure authorized by this application cannot be occupied until a final inspection has been completed and a Certificate of Occupancy has been issued, if applicable, by the Building Department.

I hereby acknowledge that I have read this application and the information is correct; I agree to comply with any and all codes, ordinances, laws, regulations or restrictions which apply to the project. I understand that failure to comply shall result in legal action, which may include but not necessarily be limited to non-use of the building(s).

Applicant Signature _____ Date 2-23-10
 Planning Approval PD Wendy Spurr Date 3/10/10

Additional water and/or sewer tap fee(s) are required:	YES <u>X</u>	NO _____	W/O No. <u>PD OTHSPD</u>
Utility Accounting <u>f. Bensley</u>	Date <u>3/29/10</u>		

VALID FOR SIX MONTHS FROM DATE OF ISSUANCE (Section 2.2.C.4 Grand Junction Zoning & Development Code)
 (White: Planning) (Yellow: Customer) (Pink: Building Department) (Goldenrod: Utility Accounting)

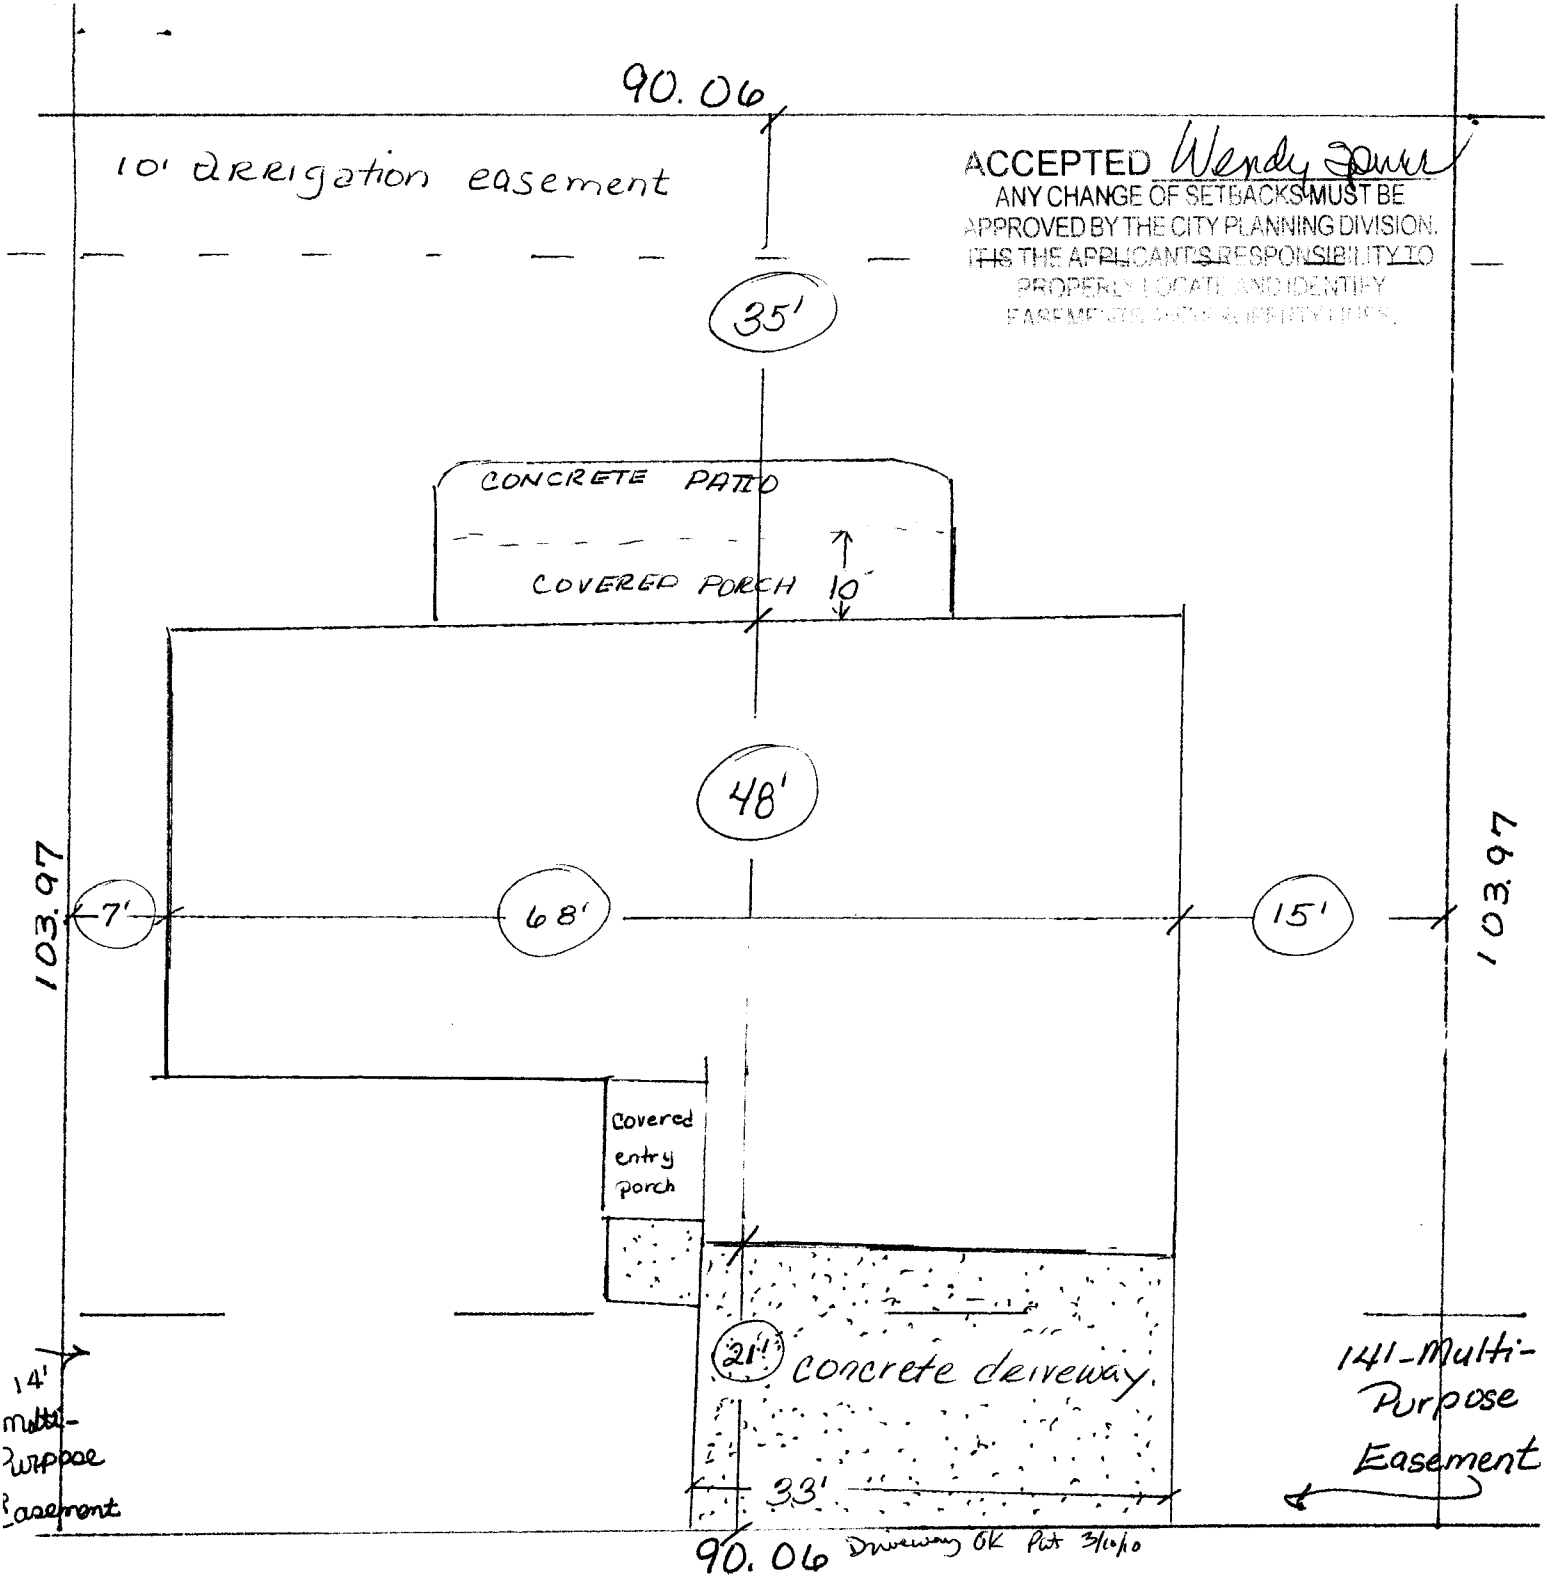

ACCEPTED *Wendy Jones*
 ANY CHANGE OF SETBACKS MUST BE APPROVED BY THE CITY PLANNING DIVISION. IT IS THE APPLICANT'S RESPONSIBILITY TO PROPERLY LOCATE AND IDENTIFY EASEMENTS AND EASEMENT LINES.

10' irrigation easement

CONCRETE PATIO
 COVERED PORCH 10'

48'

68'

15'

21' concrete driveway

33'
 90.06 Driveway OK Per 3/10/10

14' Multi-Use Easement

141-Multi-Purpose Easement



WINTER HAWK DRIVE

183 Winter Hawk Dr
 Lot 27 BIK 1 Hawks Nest S
 2943-321-28-027
 Fil.

