FEE\$ 15.63
TCP \$ 2554
SIF\$ 460

(White: Planning)

## PLANNING CLEARANCE

BLDG PERMIT NO	D.

(Goldenrod: Utility Accounting)

(Single Family Residential and Accessory Structures)


Public Works & Planning Department

Building Address 184 Winter Hawk DR	No. of Existing Bldgs No. Proposed
Parcel No. 2943-321-30-012	Sq. Ft. of Existing Bldgs Sq. Ft. Proposed 8329
Subdivision Hawks Nest	Sq. Ft. of Lot / Parcel 9794
Filing Two Block 3 Lot 12	Sq. Ft. Coverage of Lot by Structures & Impervious Surface (Total Existing & Proposed)
OWNER INFORMATION:	Height of Proposed Structure 33'
Name 30 Rd, LLC	DESCRIPTION OF WORK & INTENDED USE:
Address 710 5 15 St	New Single Family Home (*check type below) Interior Remodel Addition
City / State / Zip GJ CO 81501	Other (please specify):
APPLICANT INFORMATION:	*TYPE OF HOME PROPOSED:
Name Steady Const LLC	Site Built Manufactured Home (UBC) Manufactured Home (HUD)
Address 76/25 Rd	Other (please specify):
City/State/Zip GR Jct CO 81505	NOTES:
Telephone 250-7244	
REQUIRED: One plot plan, on 8 1/2" x 11" paper, showing all e property lines, ingress/egress to the property, driveway location	xisting & proposed structure location(s), parking, setbacks to all
property lines, ingress/egress to the property, univeway location	on & width & all easements & rights-or-way which abut the parcel.
	PLETED BY PLANNING STAFF
THIS SECTION TO BE COME	PLETED BY PLANNING STAFF
ZONE R-4	PLETED BY PLANNING STAFF  Maximum coverage of lot by structures
THIS SECTION TO BE COME  ZONE	PLETED BY PLANNING STAFF  Maximum coverage of lot by structures
THIS SECTION TO BE COME  ZONE	PLETED BY PLANNING STAFF  Maximum coverage of lot by structures
THIS SECTION TO BE COME  ZONE	Permanent Foundation Required: YES NO Floodplain Certificate Required: YES NO Floodpla

VALID FOR SIX MONTHS FROM DATE OF ISSUANCE (Section 2.2.C.4 Grand Junction Zoning & Development Code)

(Yellow: Customer)

(Pink: Building Department)

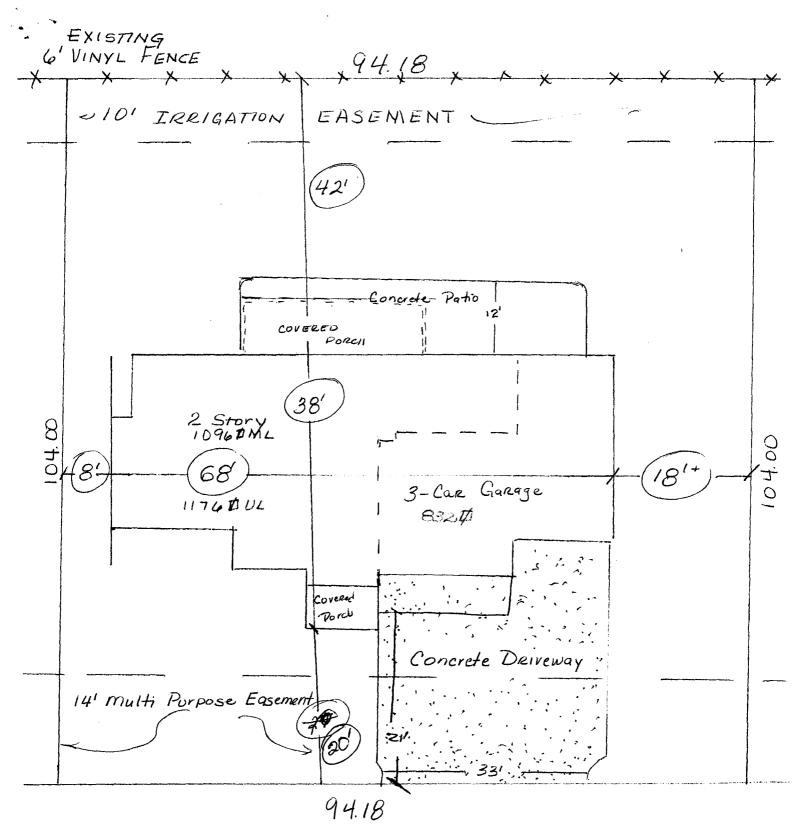

W

WINTER HOWK DRIVE

ACCEPTED

ANY CHANGE OF SATDACKS MUST BE
APPROVED BY THE CITY OLANNING DIVISION
THIS THE APPLICANT'S PESPONSIBILITY OF
PROPERLY OF COLOR OF A SEMINERAL PROPERTY OF COLOR OF THE SEMINERAL PROPERTY OF T

184 181 Winter Hawk DR LOT & BIK3 Hawks Nest Sub 1 2943-321-30-012