

CONDOMINIUM MAP OF
THYE CONDOMINIUMS

OWNER'S CERTIFICATE

GENE A. THYE, OWNER OF THE HEREIN DESCRIBED REAL PROPERTY, CERTIFIES THAT THIS CONDOMINIUM MAP OF THYE CONDOMINIUMS HAS BEEN PREPARED PURSUANT TO THE PURPOSES STATED IN THE CONDOMINIUM DECLARATION FOR THYE CONDOMINIUMS DATED MARCH 5TH, 1982, RECORDED COINCIDENT WITH THE FILING OF THIS MAP IN THE RECORDS OF MEBA COUNTY, COLORADO.

Gene A. Thye

LEGAL DESCRIPTION

LOT 6, BLOCK 2, BORKCLIFF TERRACE, MEBA COUNTY, COLORADO.

STATE OF COLORADO } 03
COUNTY OF MEBA. }

THE FOREGOING OWNER'S CERTIFICATE WAS ACKNOWLEDGED BEFORE ME THIS 30TH DAY OF APRIL, A.D. 1982 BY GENE A. THYE. WITNESS MY HAND AND OFFICIAL SEAL July 27TH 1982

W.D. Roy
NOTARY PUBLIC
Box 356
Grand Jct. Colo. 81502



CLERK AND RECORDER'S CERTIFICATE

STATE OF COLORADO }
COUNTY OF MEBA. } 55 1290245

I HEREBY CERTIFY THAT THIS INSTRUMENT WAS FILED IN MY OFFICE AT 2:35 O'CLOCK P. M., THIS 30TH DAY OF April, A.D. 1982 AND IS DULY RECORDED IN PLAT BOOK NO. _____, PAGE _____

Carl Sawyer
CLERK AND RECORDER

By *Theresa M. Huskey*
DEPUTY

FEE: 10.00

SURVEYOR'S CERTIFICATE

Filed - 5-88
3-85



I, FRANCIS A. COLLINS, A REGISTERED LAND SURVEYOR IN THE STATE OF COLORADO, DO HEREBY CERTIFY THAT THIS CONDOMINIUM MAP SUBSTANTIALLY DEPICTS THE LOCATION AND THE HORIZONTAL AND VERTICAL MEASUREMENTS OF THE BUILDING, THE UNITS, THE UNIT DESIGNATIONS, THE DIMENSIONS OF THE UNITS AND THE BUILDING DESIGNATION IF ANY.

Francis A. Collins
FRANCIS A. COLLINS
REGISTERED LAND SURVEYOR
COLORADO REGISTRATION NO. 17478


STATE OF COLORADO }
COUNTY OF MEBA. } 55

THE FOREGOING CERTIFICATES WERE ACKNOWLEDGED BEFORE ME THIS 30TH DAY OF APRIL, A.D. 1982 BY FRANCIS A. COLLINS, A REGISTERED LAND SURVEYOR. WITNESS MY HAND AND OFFICIAL SEAL July 27TH 1982

W.D. Roy
NOTARY PUBLIC
Box 356
Grand Jct. Colo. 81502

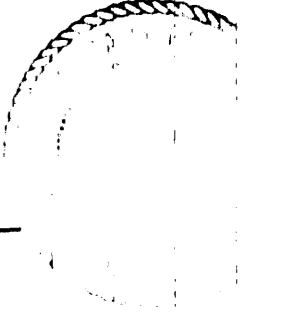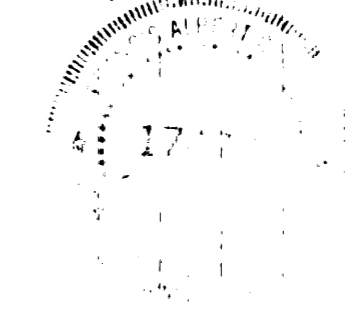


THIS CONDOMINIUM MAP OF THYE CONDOMINIUMS HAS BEEN PREPARED PURSUANT TO THE DECLARATION AS RECORDED ON _____, 1982, IN BOOK _____, PAGE _____, IN THE RECORDS OF MEBA COUNTY, COLORADO.

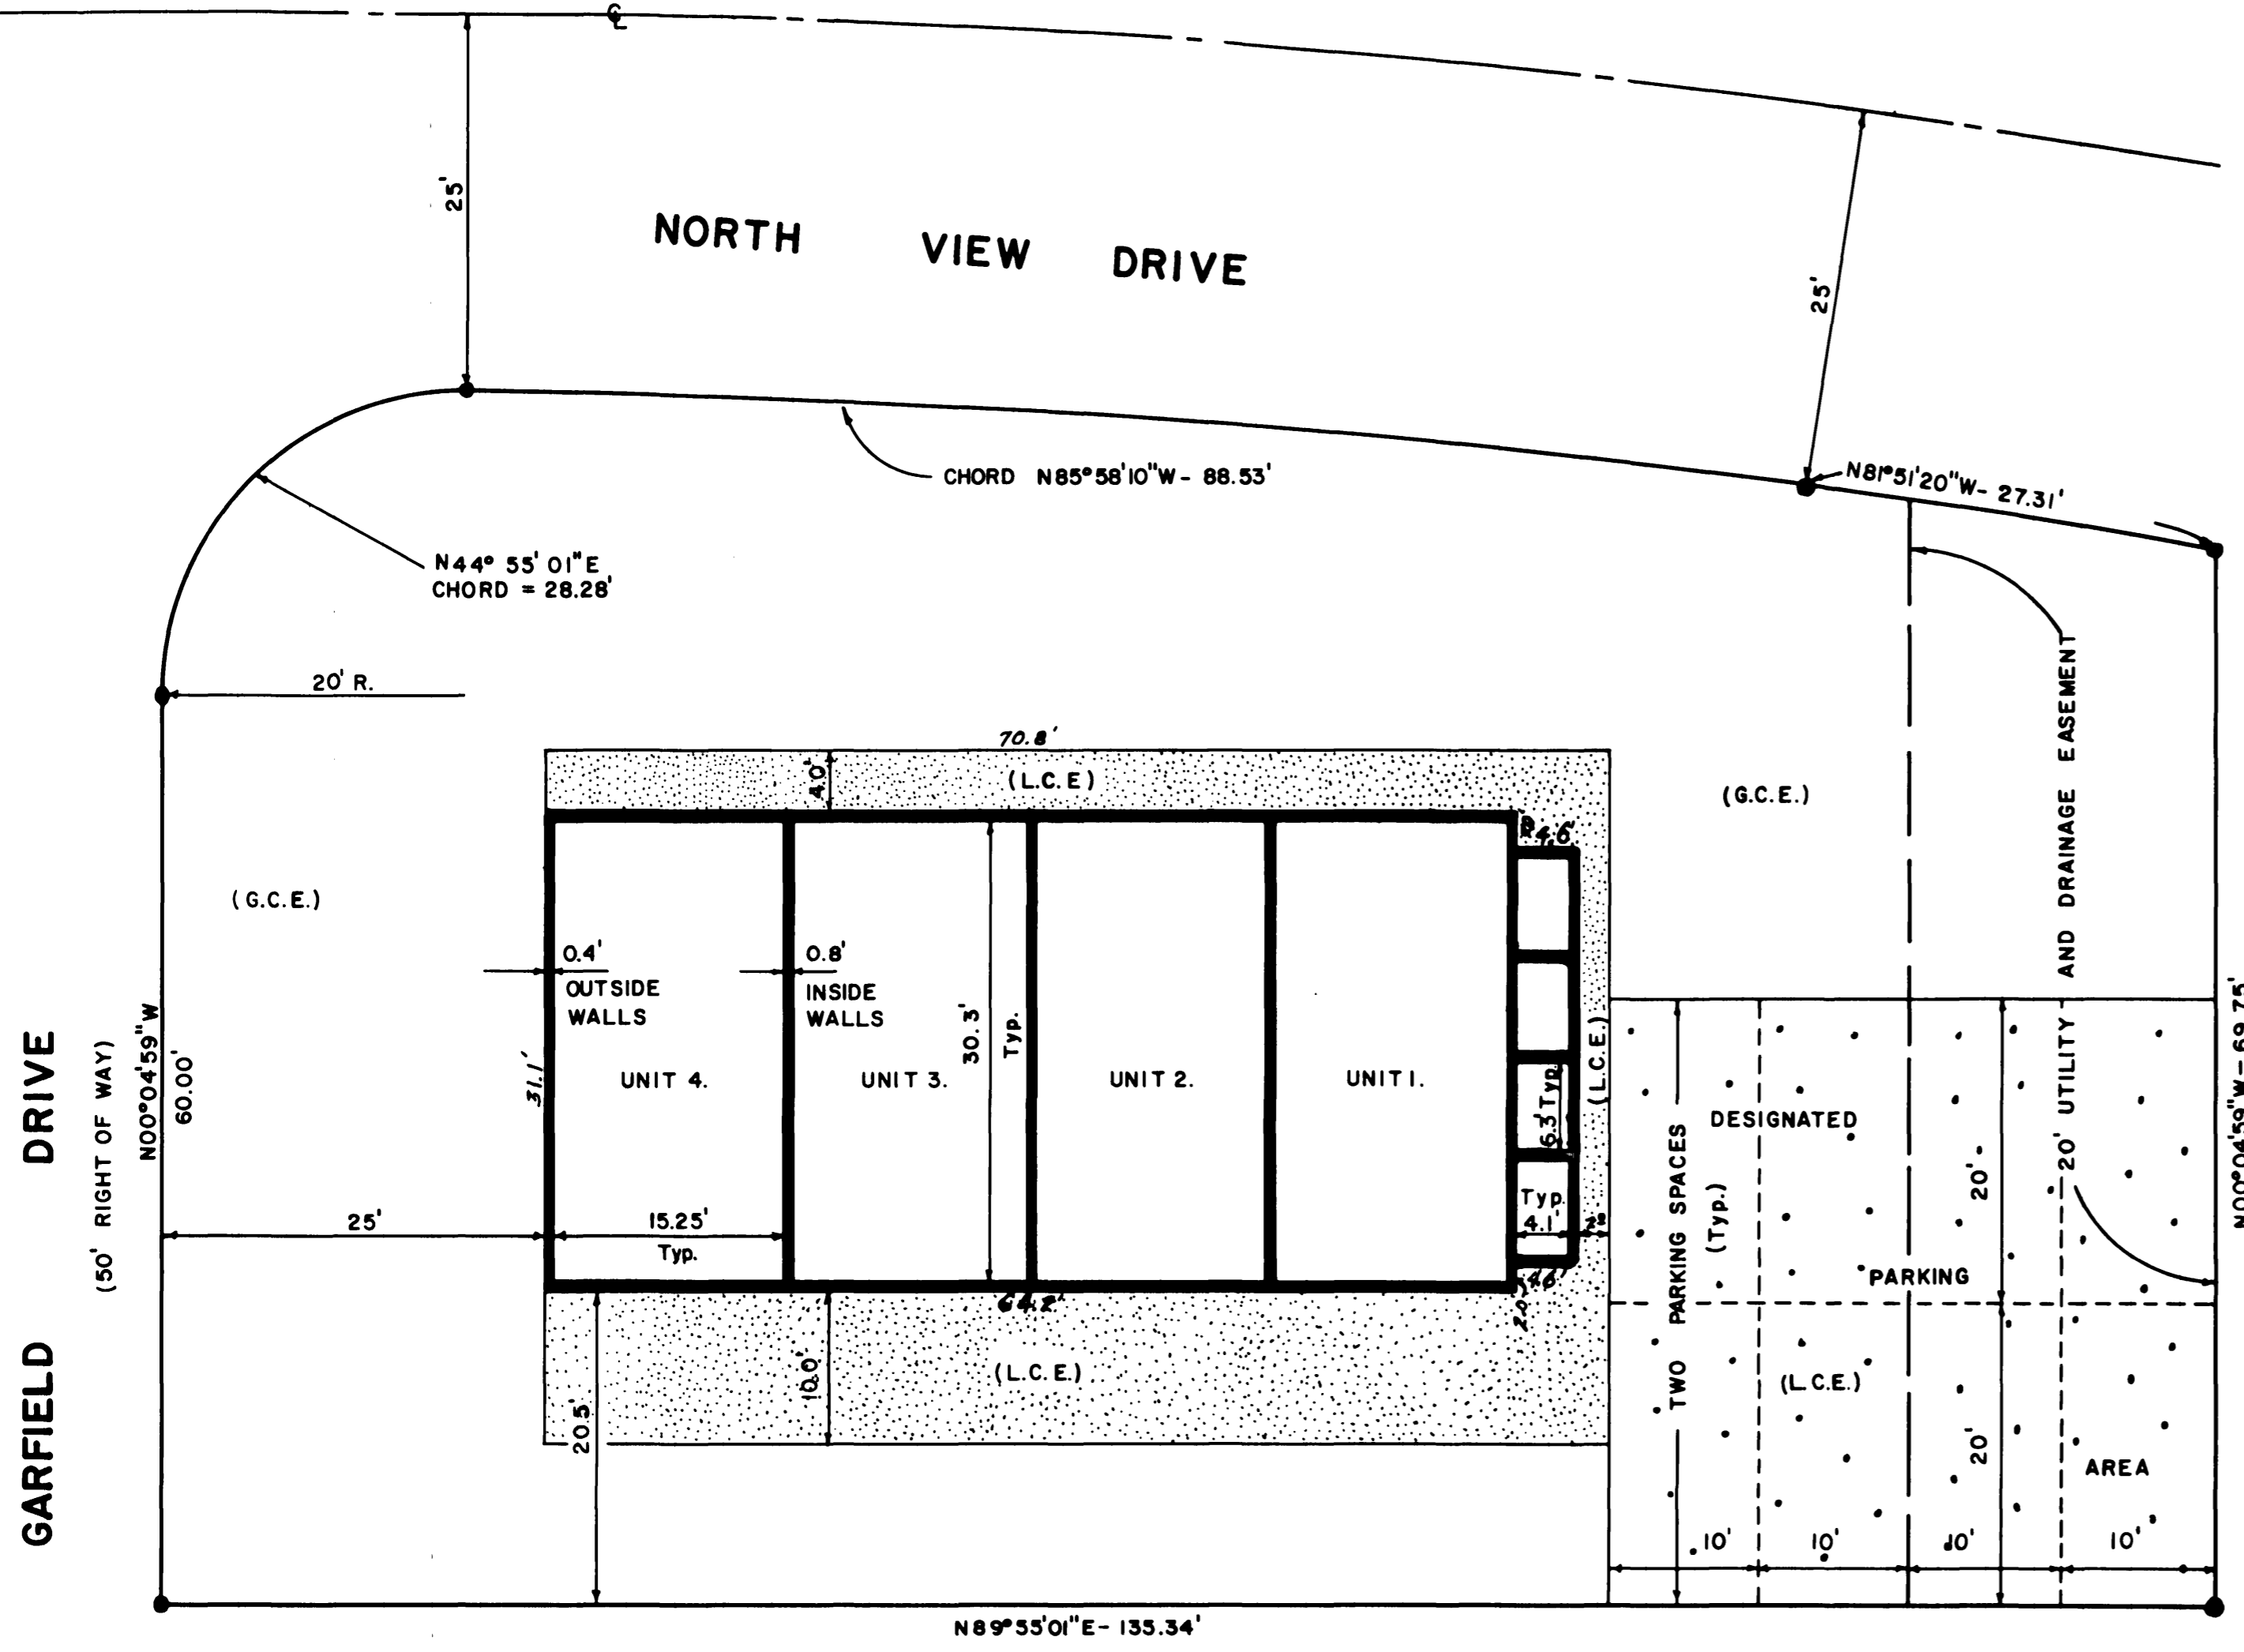

(Upper)	(Upper)	(Upper)	(Upper)
UNIT 4.	UNIT 3.	UNIT 2.	UNIT 1.
(Lower)	(Lower)	(Lower)	(Lower)

FIN. FL. EL. = 4685.75

FIN. FL. EL. = 4676.75

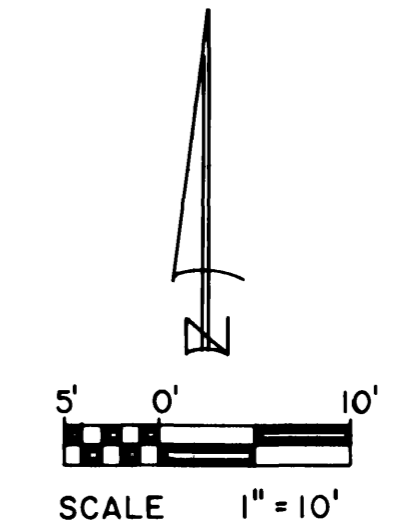

SCALE 1" = 10'
● FND. PROP. COR. No. 5 REBAR, EXTERIOR CORNERS OF LOT 6, BLOCK 2,
(G.C.E.) = GENERAL COMMON ELEMENT.
(L.C.E.) = LIMITED COMMON ELEMENT.

THYE CONDOMINIUMS	
SURVEYIT	
By Collins	
Surveyed by: BILL ROY	Date Surveyed: APRIL, 1982
Drawn by: N. JORGENSEN	Date Drawn: APRIL 8, 1982
Revision:	Scale: 1" = 10'