

FIRST AMENDED  
 CONDOMINIUM MAP OF  
**ROCK RIDGE CONDOMINIUMS**  
 MESA COUNTY, COLORADO

OWNERS CERTIFICATE

Design Structures of Grand Junction Inc., Dan Hunter, President, and Larry Kiebold, Secretary, as owners of the herein described real property, do hereby certify that this amended map of Rock Ridge Condominiums has been prepared pursuant to the declarations of Rock Ridge Condominiums recorded June 25, 1980, Book 1263, Page 377 and the Amendment to Condominium Declaration to Rock Ridge Condominiums recorded July 10, 1980, Book 1265, Page 387 in the records of Mesa County, Colorado.

Attest

DESIGN STRUCTURES OF GRAND JUNCTION, INC.

*Dan Hunter* Dan Hunter, President  
*Larry Kiebold* Larry Kiebold, Secretary

STATE OF COLORADO )  
 COUNTY OF MESA ) ss

The foregoing instrument was acknowledged before me this 14<sup>th</sup> day of October, A.D. 1980, by Dan Hunter, President, and Larry Kiebold, Secretary, as owners of Rock Ridge Condominiums.

Witness my hand and official seal

My commission expires 6/4/81

*James D. Livingston*  
 Notary Public

CLERK AND RECORDERS CERTIFICATE

STATE OF COLORADO )  
 COUNTY OF MESA ) ss

I hereby certify that this instrument was filed in my office at 10:30 o'clock A.M. this 16 day of October A.D. 1980 and is duly recorded in Plat Book No. \_\_\_\_\_, Page \_\_\_\_\_, Rec. # 1237409 File # S-18

*Earl Sawyer*  
 Clerk and Recorder

*Bonnie Gibson*  
 Deputy

Fees \$ 10.00

SURVEYOR'S CERTIFICATE

I, J. Boyd Peterson, do hereby certify that this plat was made from notes of a field survey made under my direct responsibility, supervision, and checking. Said plat represents the location of the Rock Ridge Condominiums on Lot 16 A, Block 7, Replat of Block Seven and a part of Block Seventeen, The Ridges Filing No. Three as filed in the Office of the Clerk and Recorder of Mesa County. And I further certify that the Condominium map substantially depicts the location of the building, the units, the unit designation, the dimensions of the units and the building symbol. Such condominium map was prepared subsequent to substantial completion of the improvements.

*J. Boyd Peterson*  
 J. Boyd Peterson, Colo. Reg. No. 5837





AMENDMENT CERTIFICATE

This map is an amendment to that certain condominium map relating to Lots 16A, 17A, and 18A, Block 7, Replat of Block 7 and a part of Block Seventeen, The Ridges Filing No. Three, previously recorded on June 25, 1980, at Book 12, Page 100 of the book of plats of the Clerk and Recorder of Mesa County Clerk and Recorders Office.


DESIGN STRUCTURES OF GRAND JUNCTION, INC.

*Dan Hunter* Dan Hunter, President  
*Larry Kiebold* Larry Kiebold, Secretary

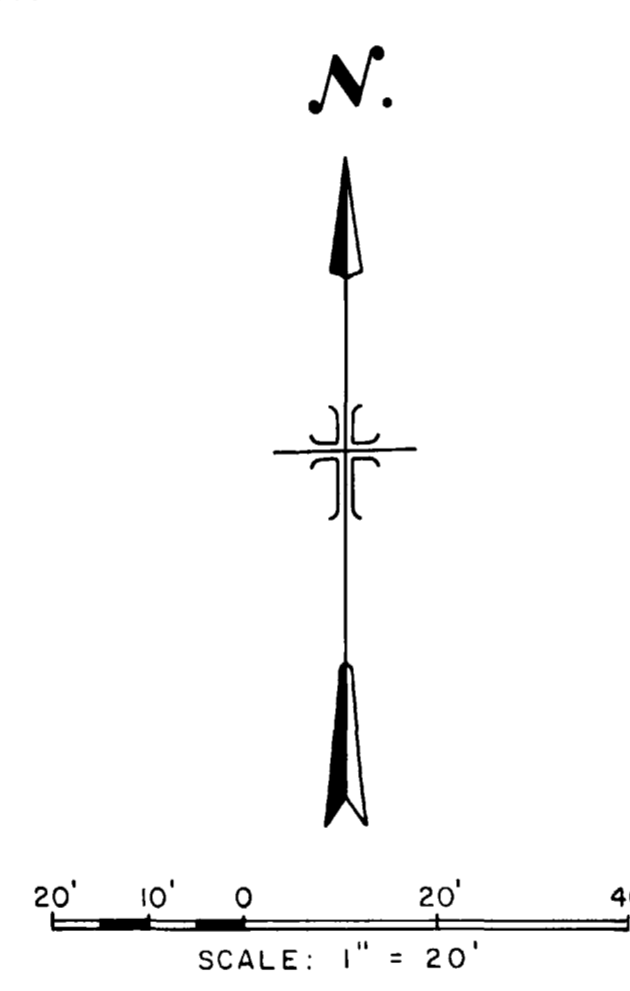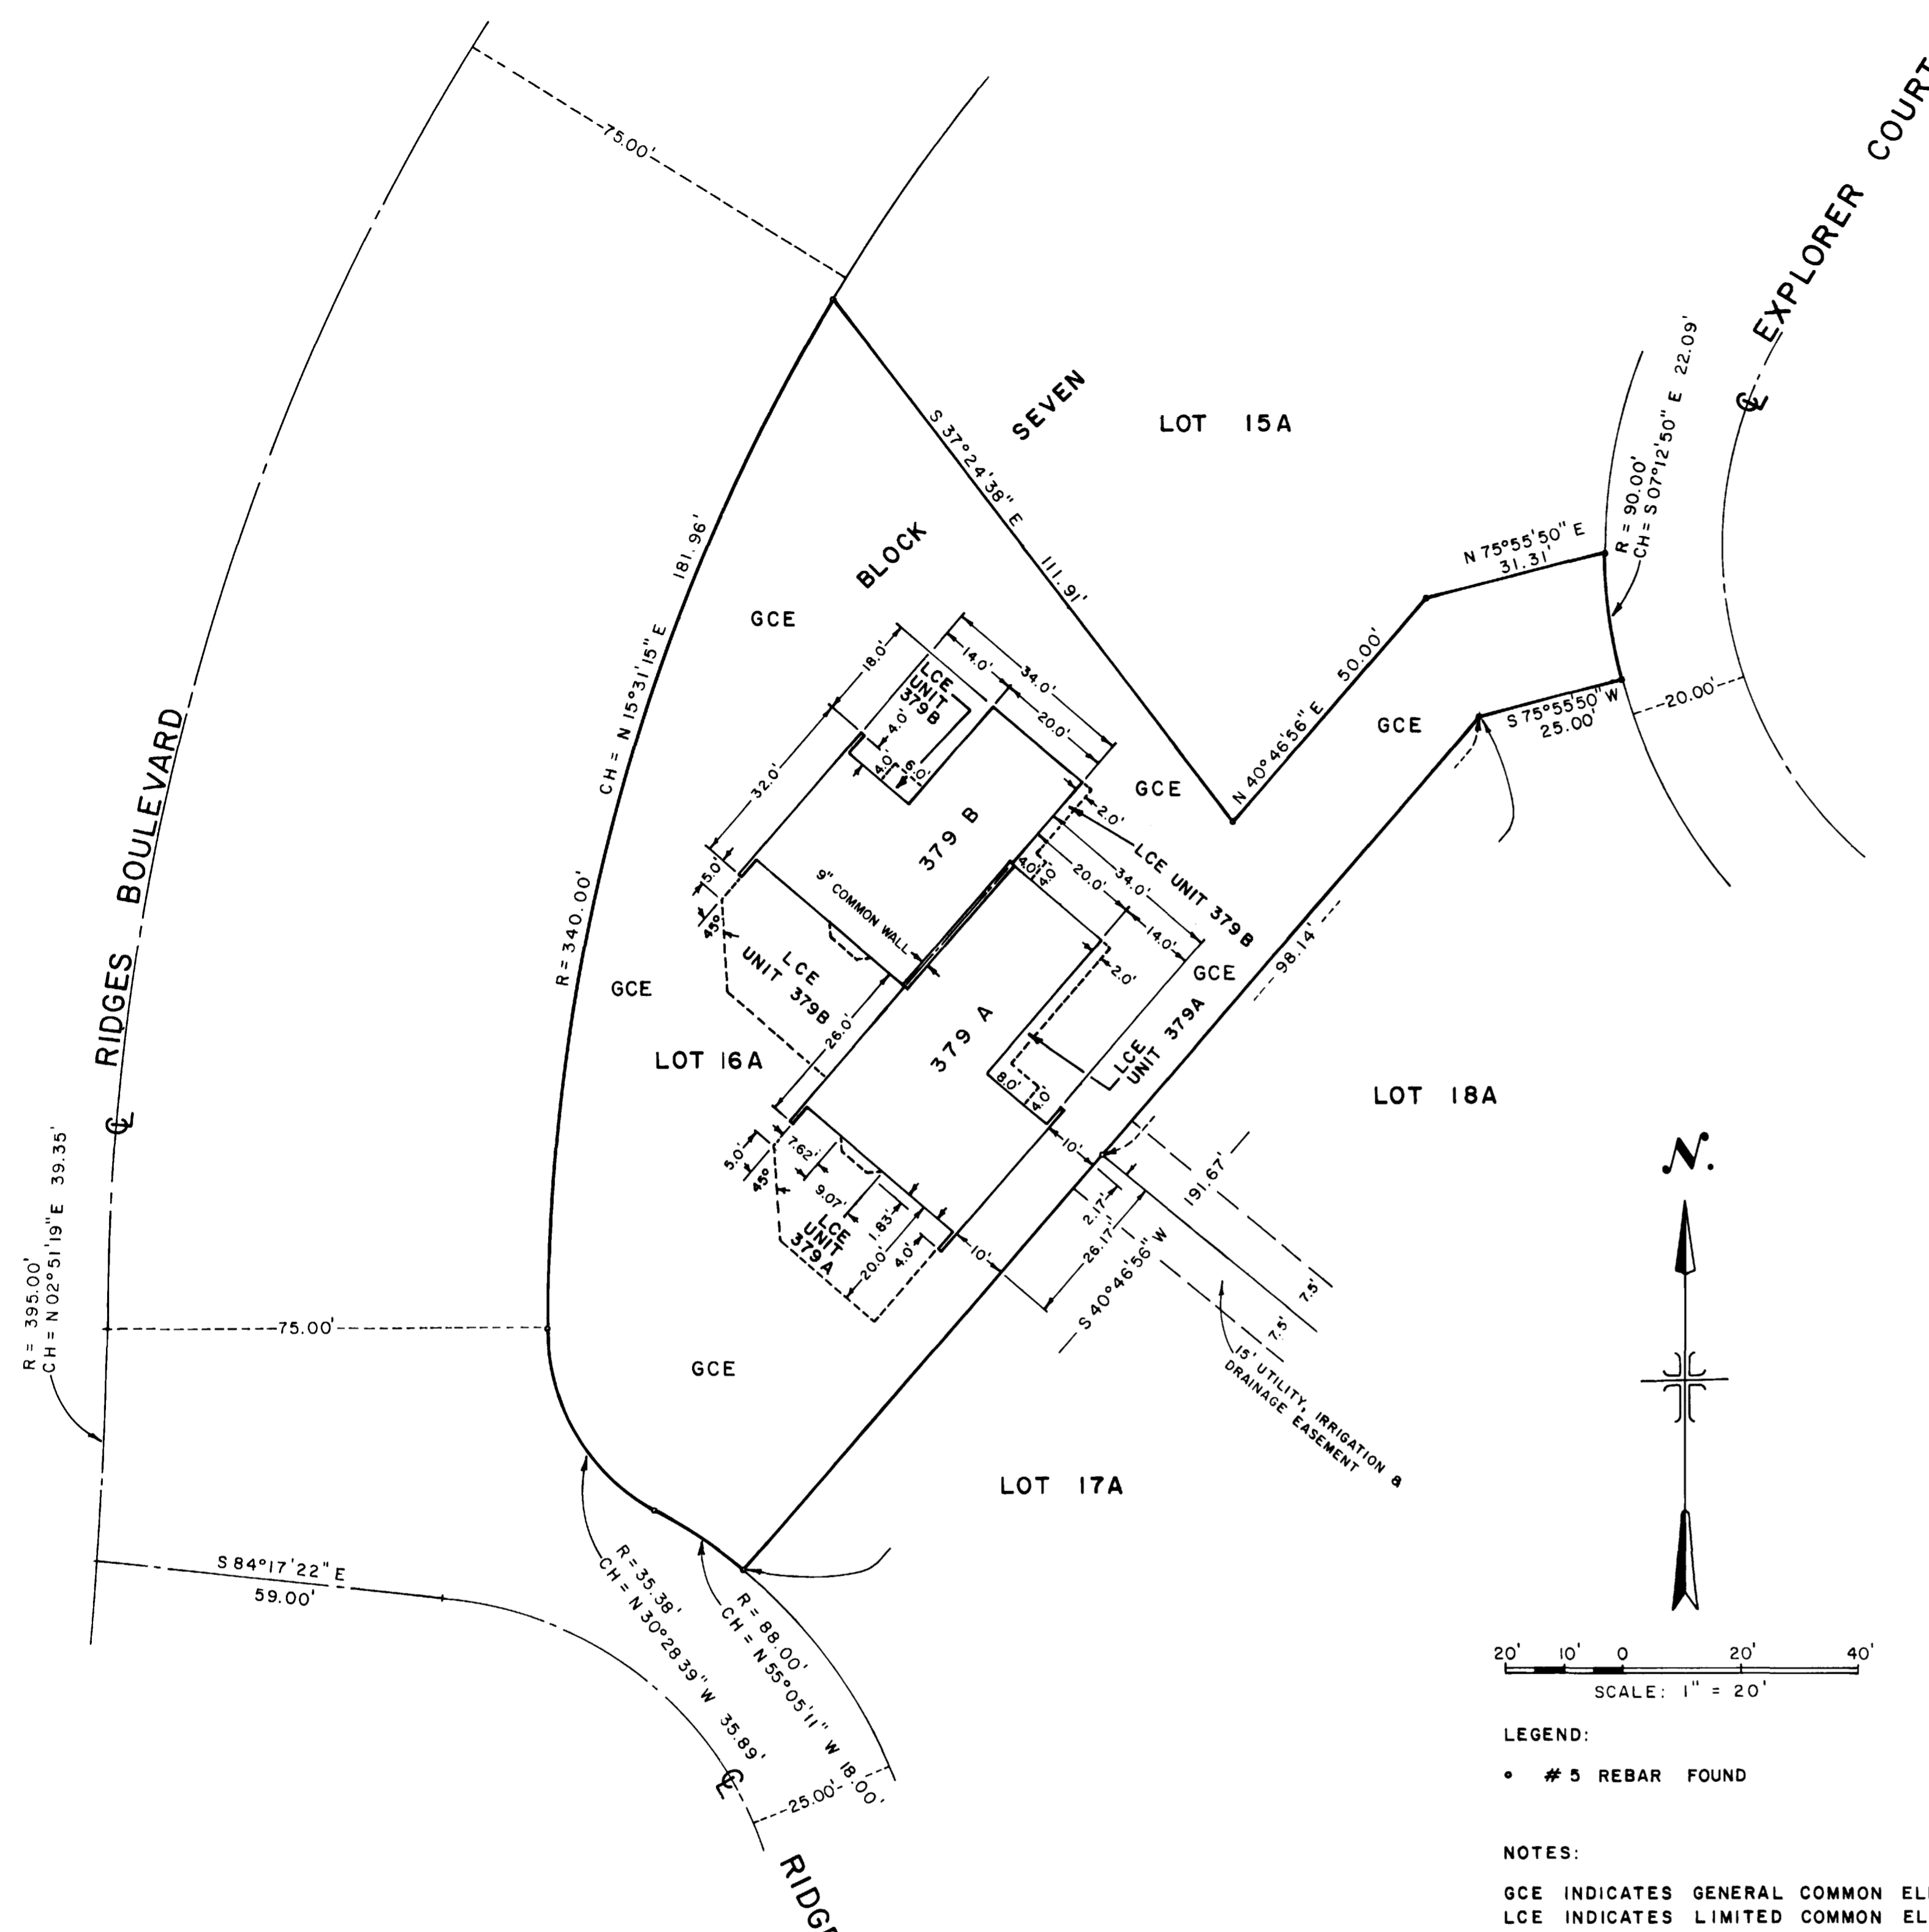


LEGEND:  
 • # 5 REBAR FOUND

NOTES:  
 GCE INDICATES GENERAL COMMON ELEMENT  
 LCE INDICATES LIMITED COMMON ELEMENT

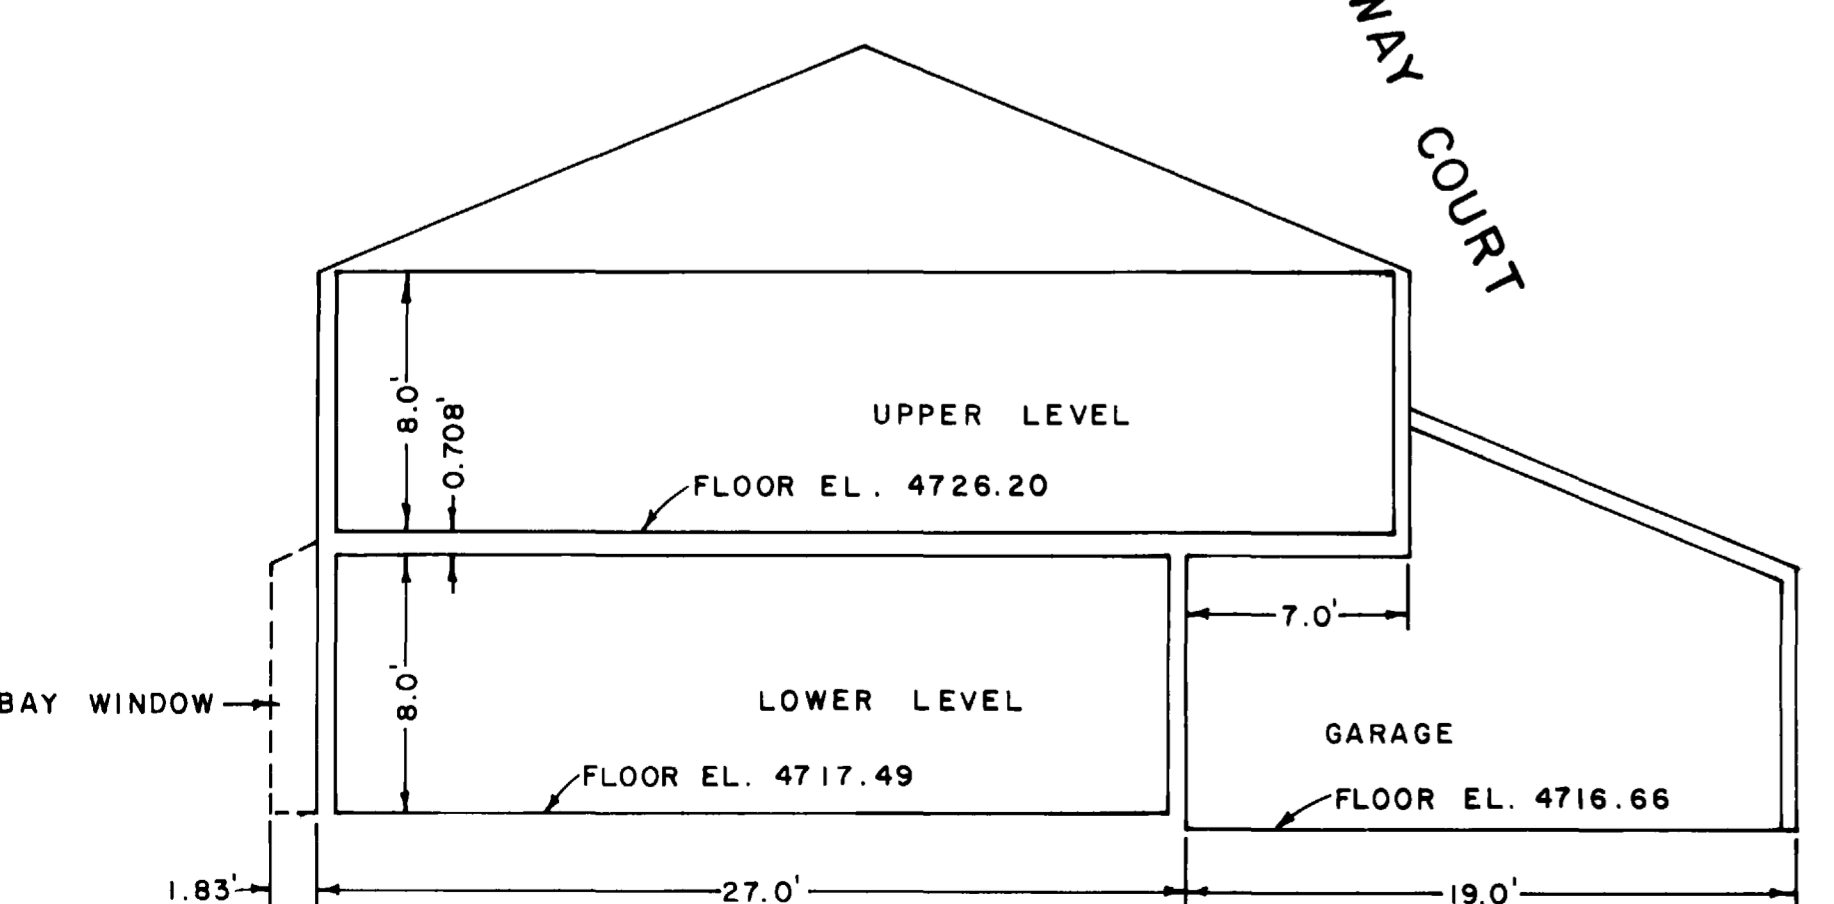

ELEVATION THRU UNIT 379 A  
 (LOOKING NORTHWEST)  
 SCALE: 1" = 6'

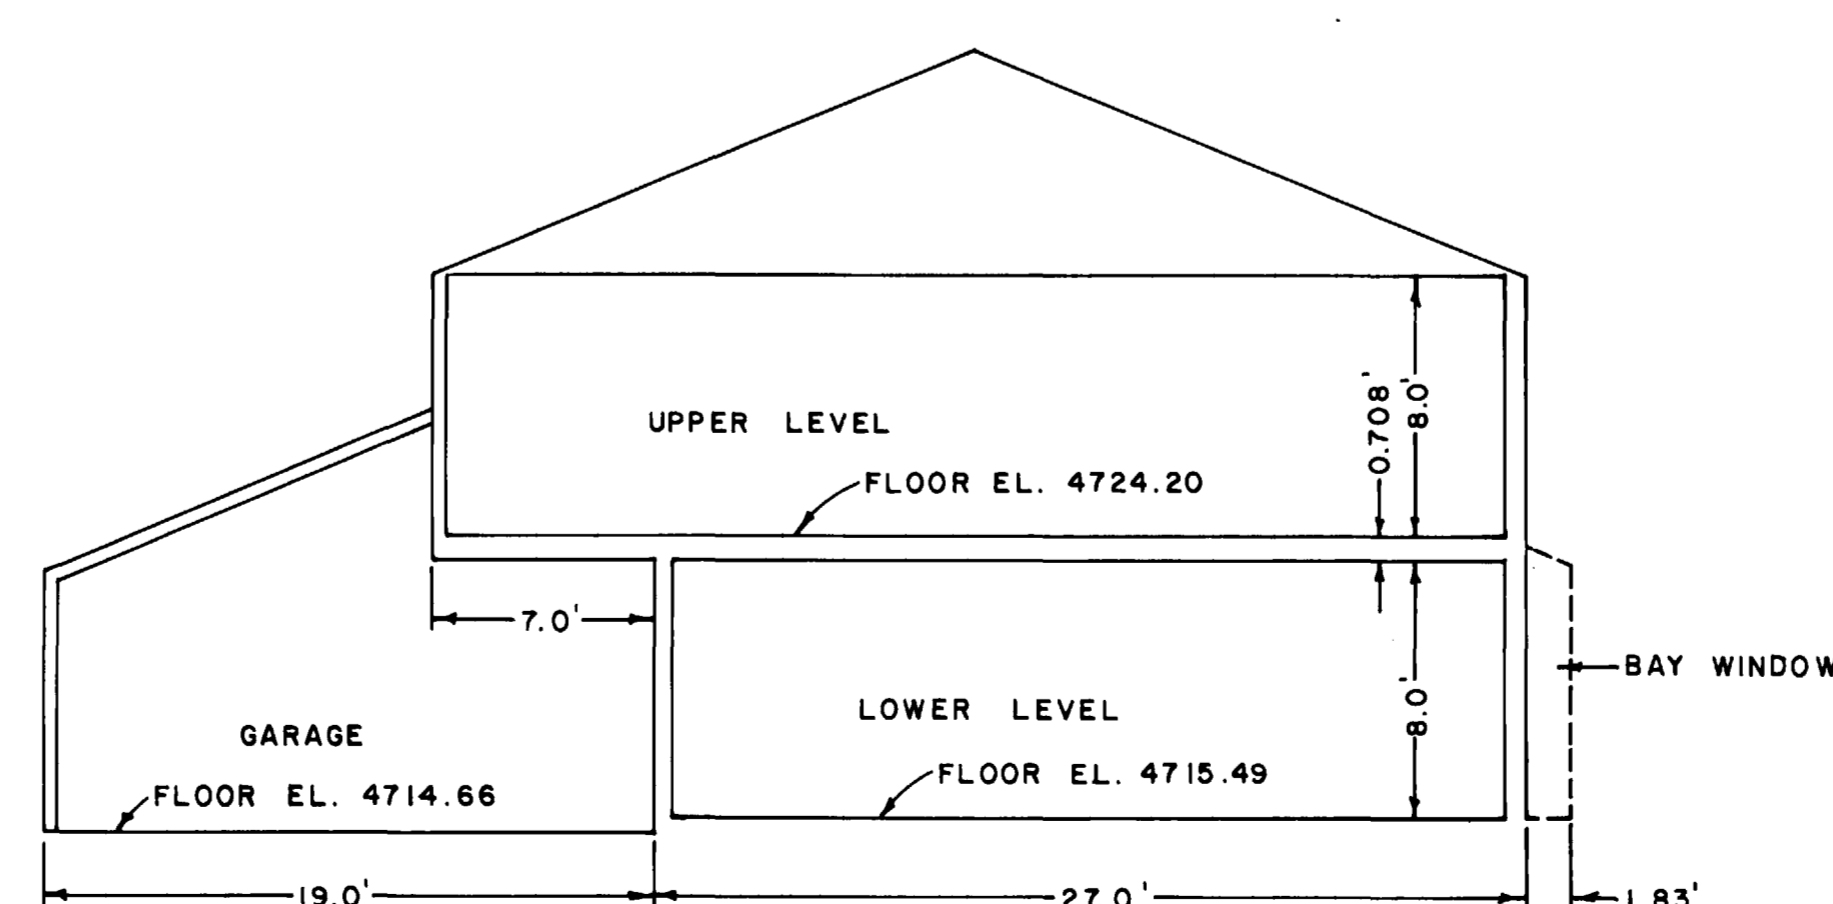

ELEVATION THRU UNIT 379 B  
 (LOOKING SOUTHEAST)  
 SCALE: 1" = 6'

EXHIBIT "B"

NOTICE: According to Colorado law you must commence any legal action based upon any defect in this survey within six years after you first discover such defect. In no event may any action based upon any defect in this survey be commenced more than ten years from the date of the certification shown herein.

WESTERN ENGINEERS, INC.  
 FIRST AMENDED CONDOMINIUM MAP OF  
**ROCK RIDGE CONDOMINIUMS**  
 UNITS 379 A AND 379 B  
 LOT 16 A - BLOCK 7  
 REPLAT OF BLOCK 7 & PART OF BLOCK 17  
 THE RIDGES FILING NO. 3  
 MESA COUNTY, COLORADO

2914 4 8/29/80