
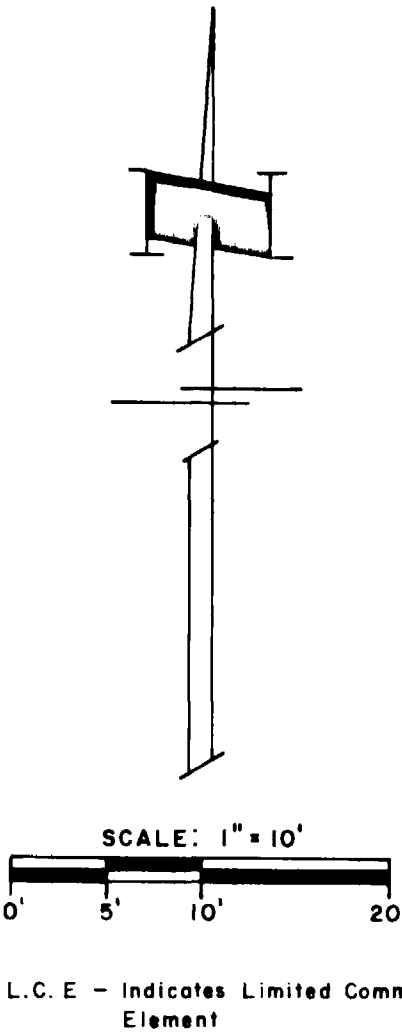


A CONDOMINIUM MAP FOR: HIDDEN VALLEY CONDOMINIUMS

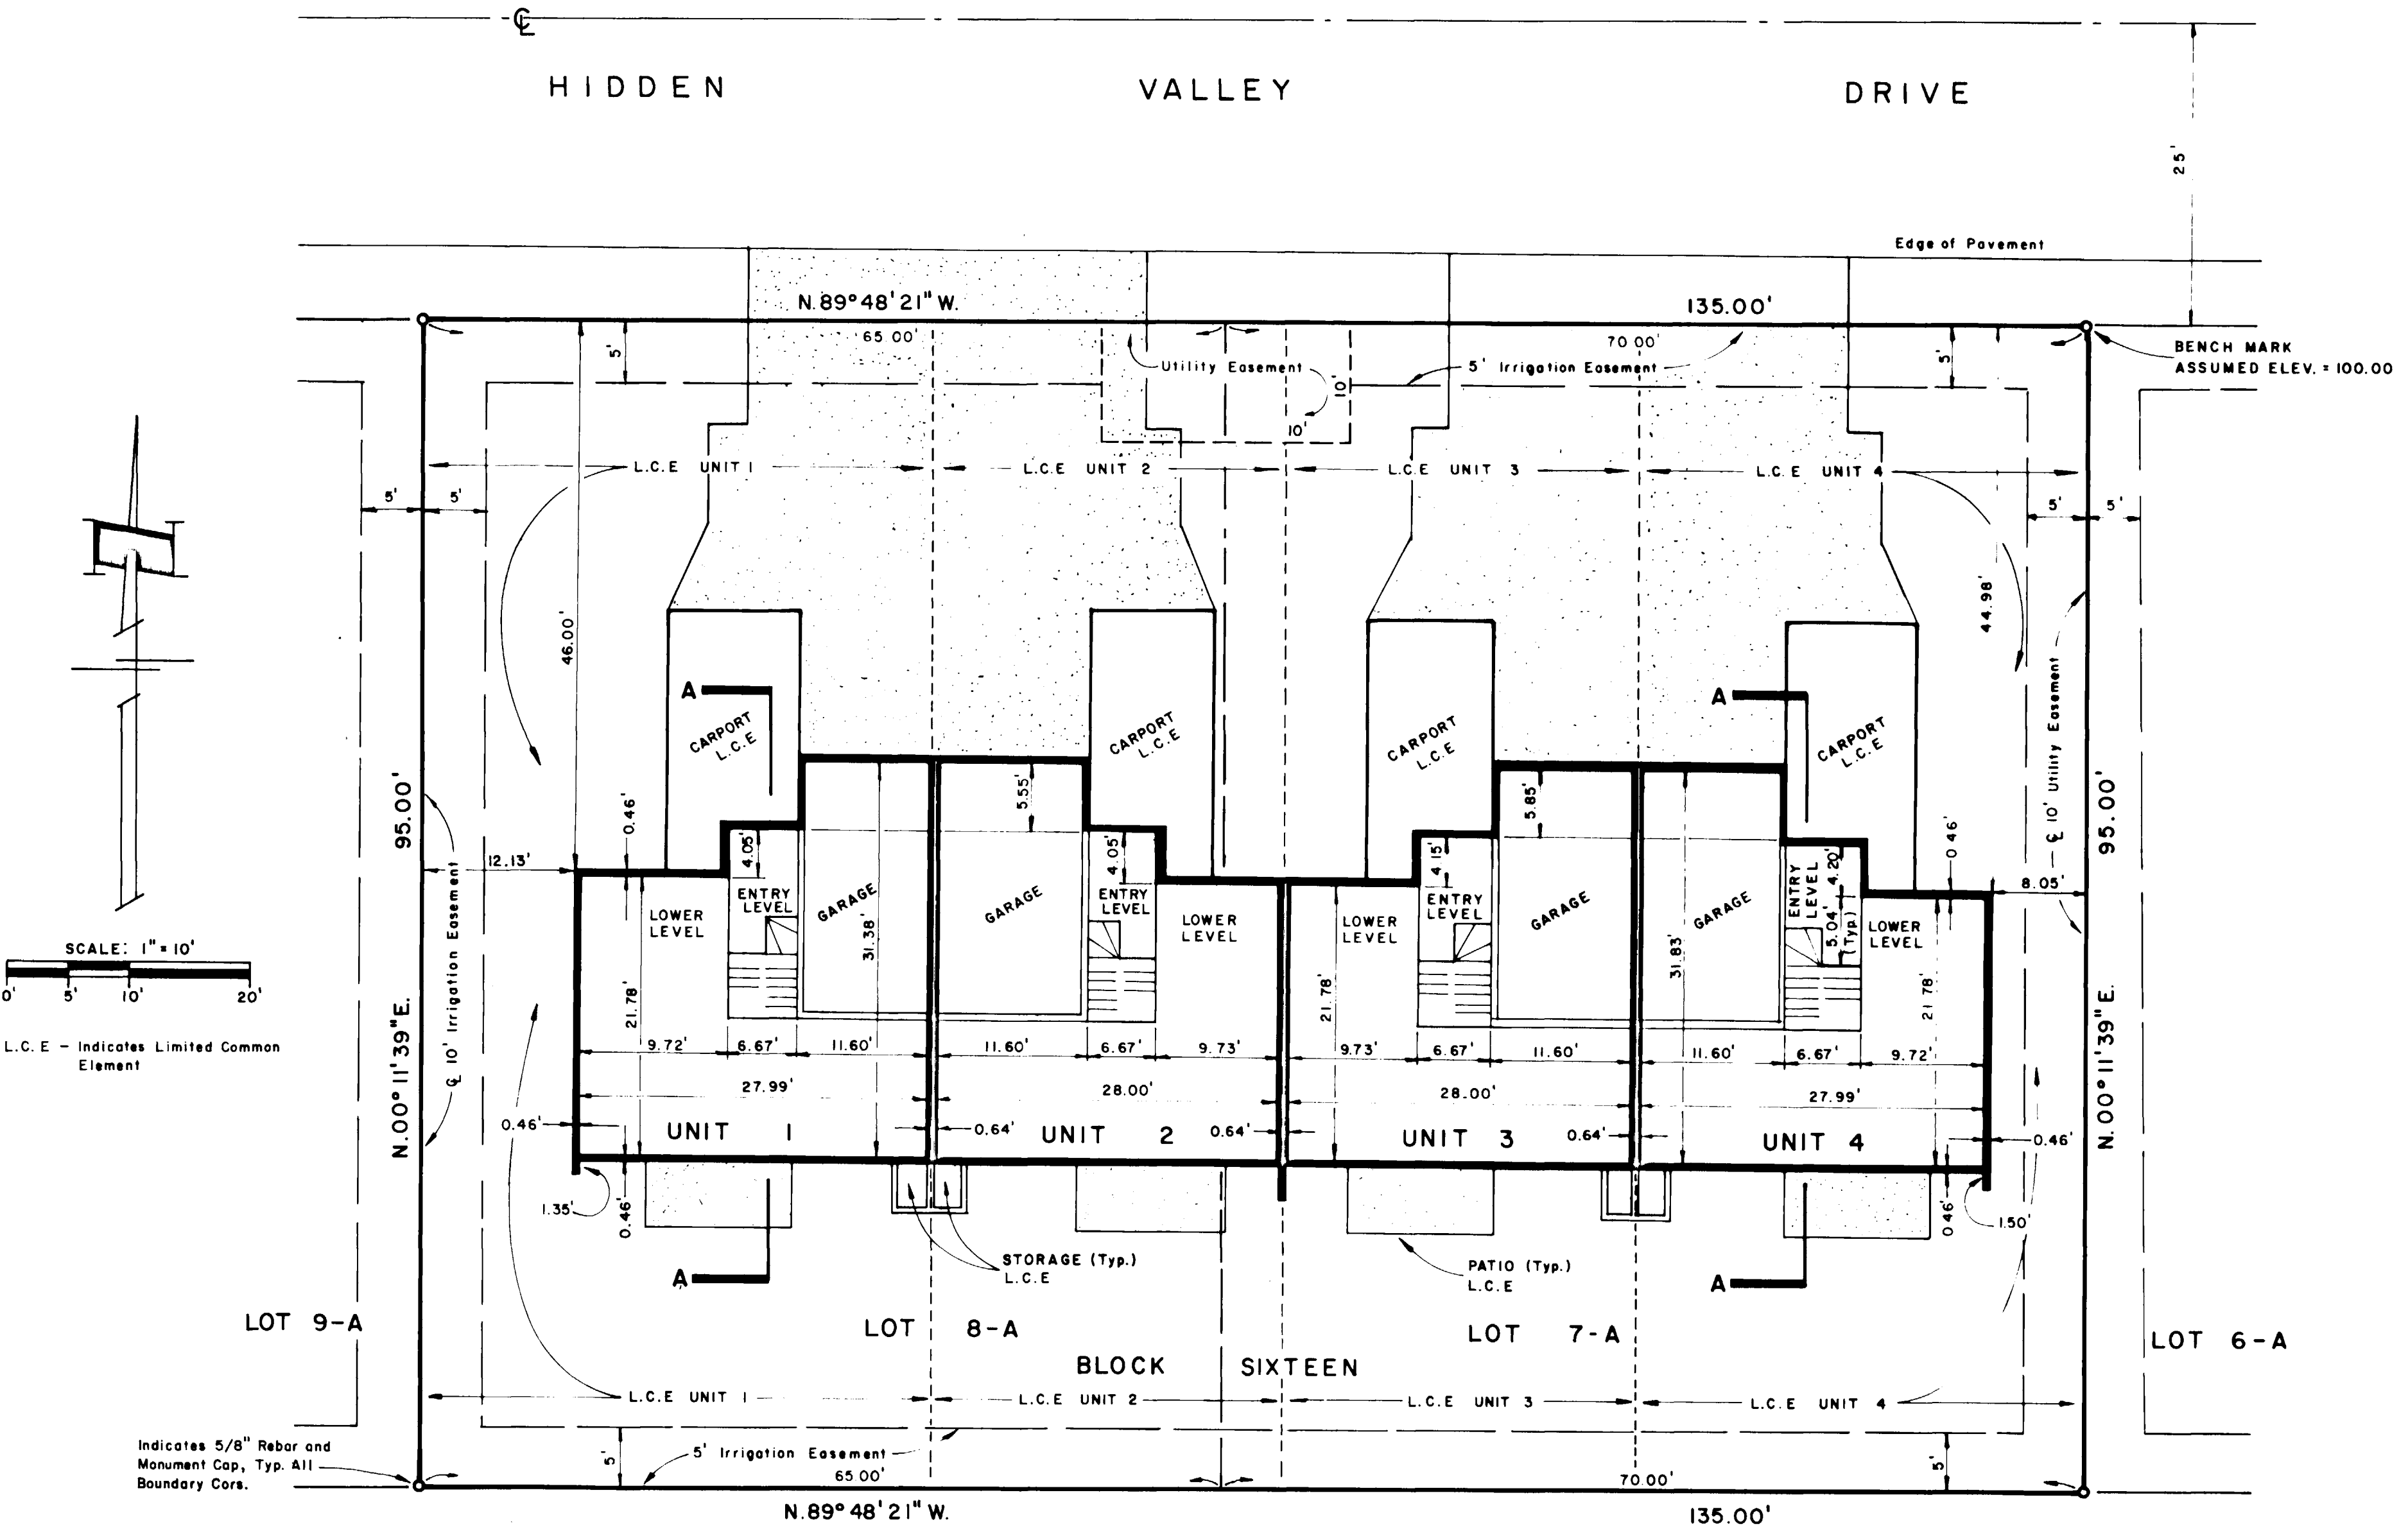

OWNER'S CERTIFICATE

William B. McDowell, owner of Lots 7-A and 8-A of Block Sixteen, The Ridges, Filing No. Three, Mesa County Colorado, certify that this Condominium Map of Hidden Valley Condominiums has been prepared pursuant to the purposes stated in the Condominium Declaration for Hidden Valley Condominiums dated May 25, 1984,

William B. McDowell
William B. McDowell

STATE OF COLORADO)
COUNTY OF MESA) SS

The foregoing Owner's Certificate was acknowledged before me this 24th day of July A.D., 1984 by William B. McDowell.

Witness My Hand and Official Seal,
My Commission expires: 5/19/87

Mary Ann Edwards
Notary Public

Address: 2252 N 14 Road
Grand Junction, Co

CLERK AND RECORDERS CERTIFICATE

STATE OF COLORADO)
COUNTY OF MESA) SS

I hereby certify that this instrument was filed in my office at 12:00 o'clock P.M. this 27th day of July A.D., 1984 and is duly recorded in Plat Book No. _____, at Page _____.

REGISTRATION # 1327511
FEES: \$ 10.00

Earl Sawyer *Richard L. Palmer*
Clerk and Recorder Deputy

FILED W-29

SURVEYOR'S CERTIFICATE

I, J. LeRoy Waugh, a land surveyor in the State of Colorado, do hereby certify that the accompanying Condominium Map was made under my direct supervision and do hereby certify that the accompanying Condominium Map substantially depicts the location of the horizontal and vertical measurements of the Building, the Units, the Unit designation, the dimensions of the Units, the elevation of the finished floors and ceilings as Constructed.

J. LeRoy Waugh
J. LeRoy Waugh
Registered Land Surveyor
Colo. Reg. No. 6700

