
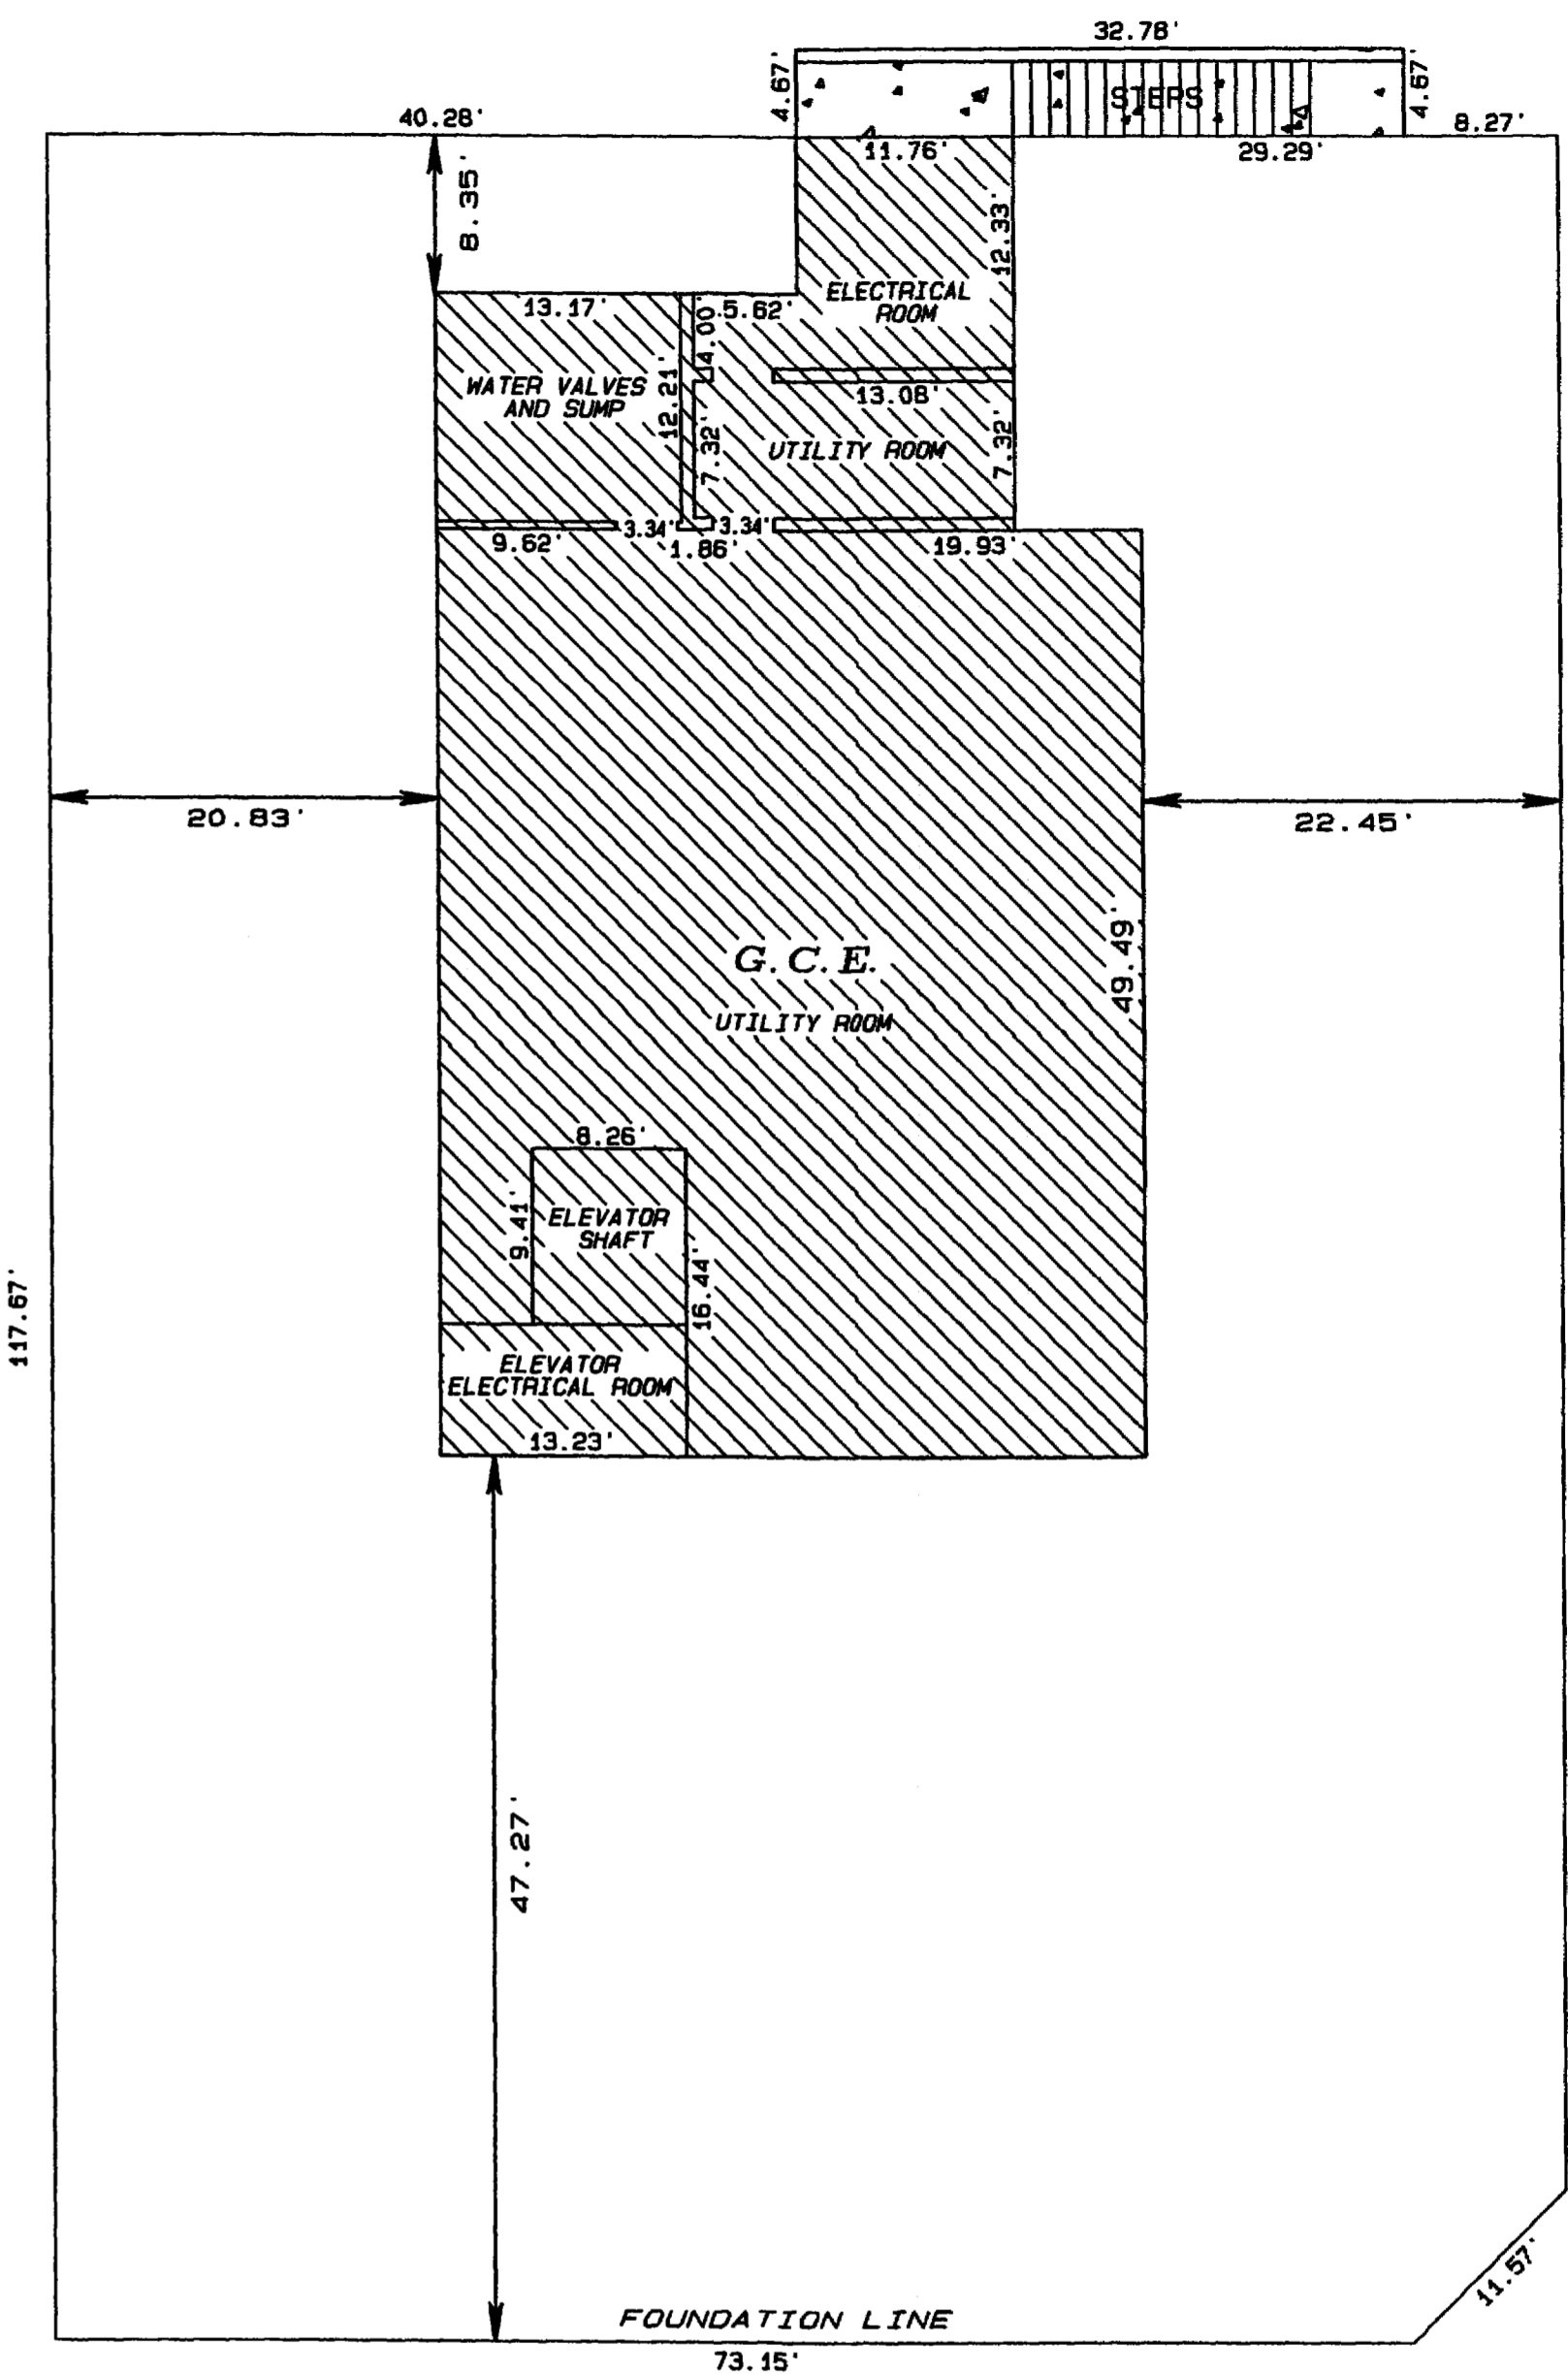
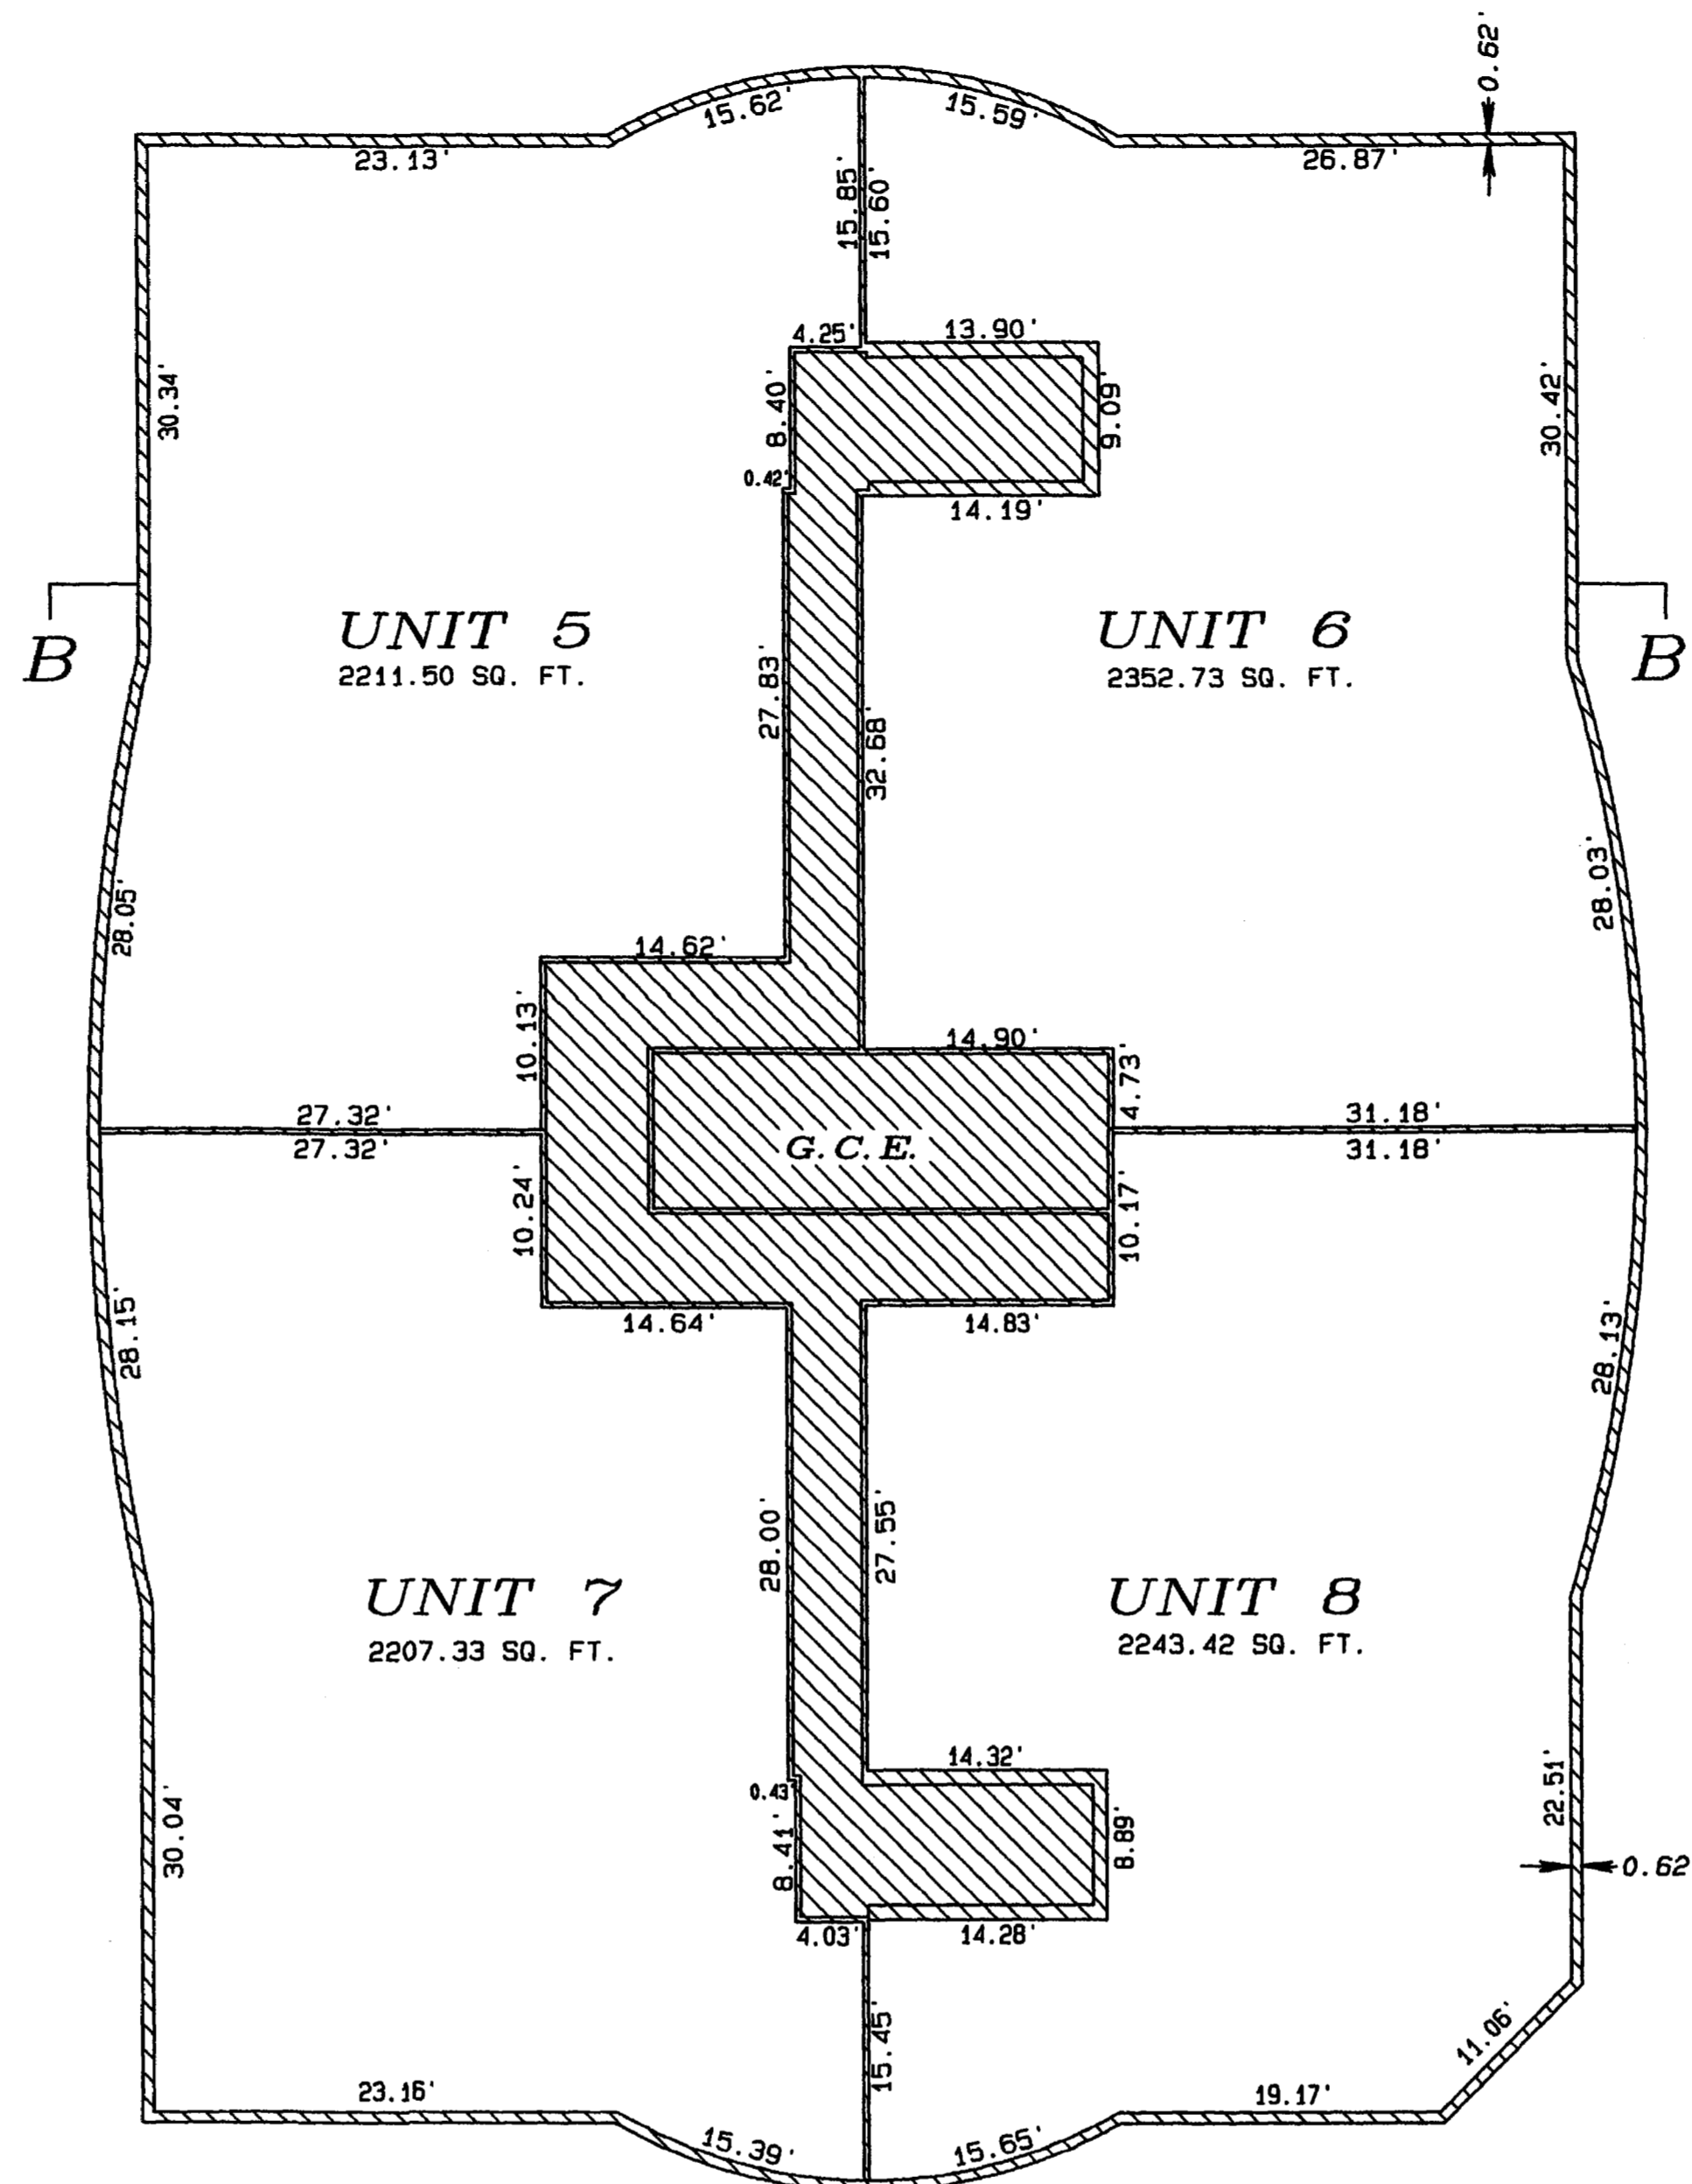


CONDOMINIUM MAP OF SULLIVAN CENTER CONDOMINIUM

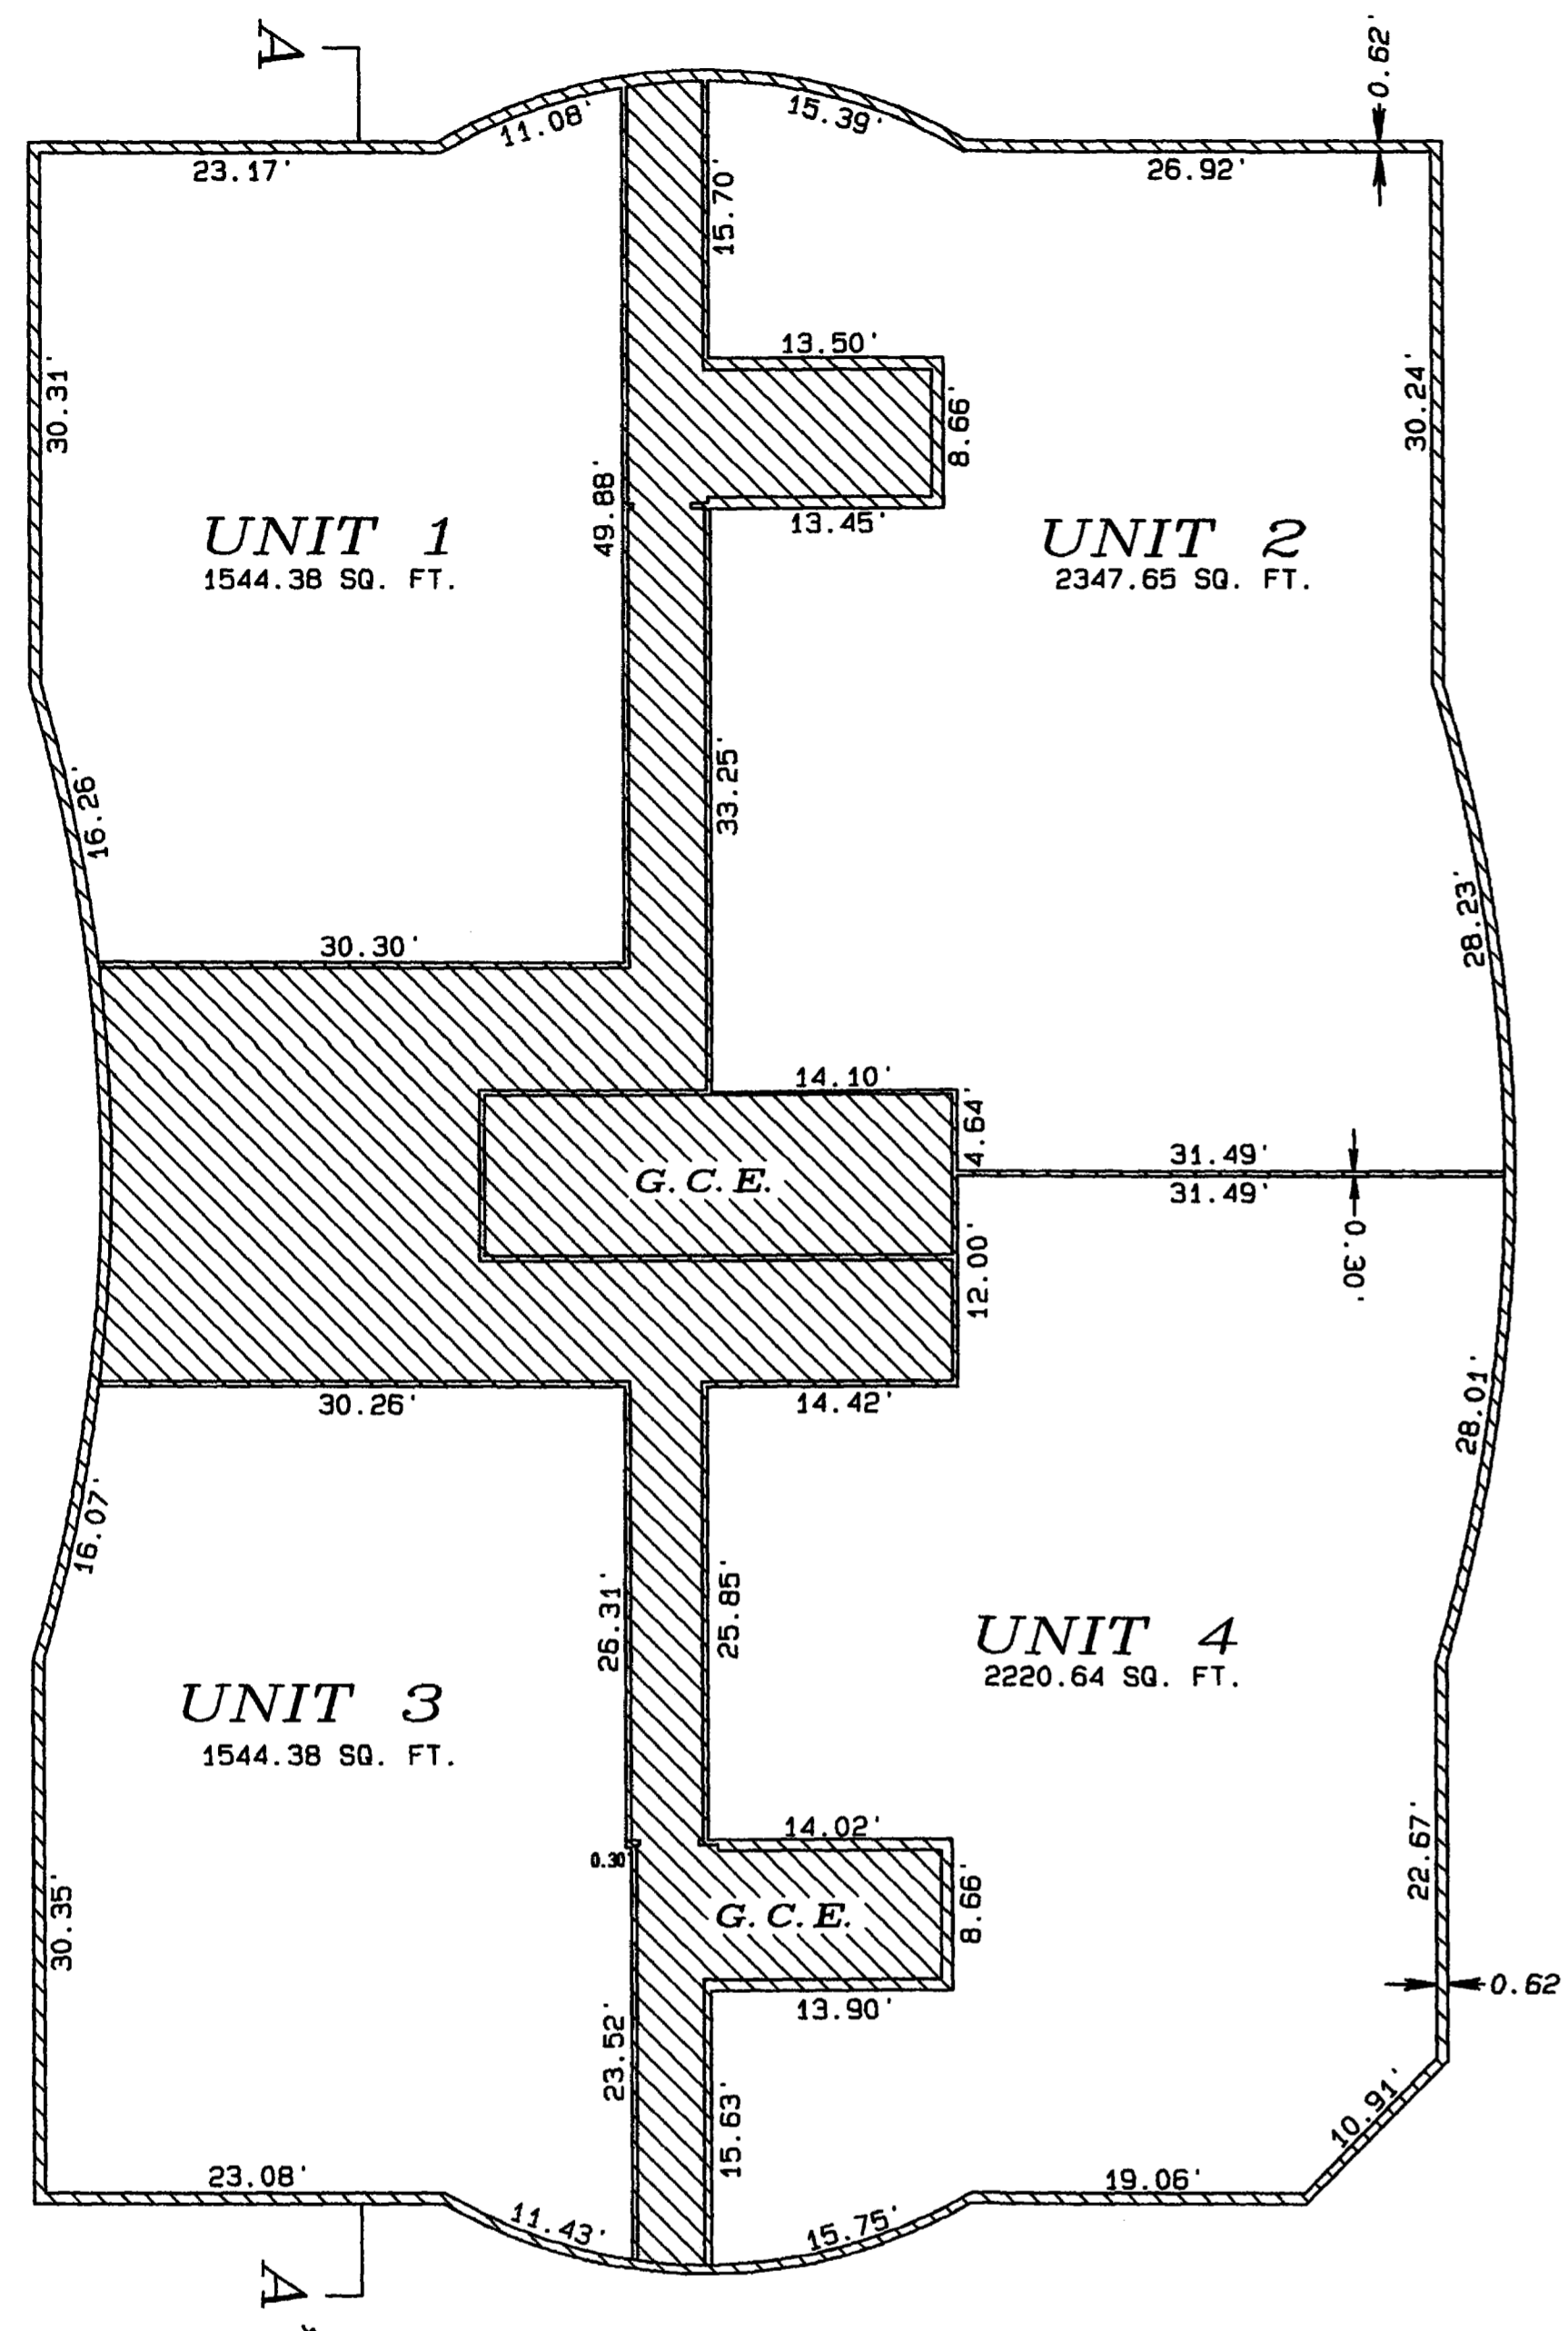

1st FLOOR PLAN VIEW
 FLOOR ELEVATION = 4655.99
 CEILING ELEVATION = 4665.49

2nd FLOOR PLAN VIEW
 FLOOR ELEVATION = 4668.44
 CEILING ELEVATION = 4677.94

BASEMENT PLAN VIEW
 FLOOR ELEVATION = 4645.49
 CEILING ELEVATION = 4654.29

SECTION A - A'

ROOF ELEV. = 4681.54

GENERAL COMMON ELEMENT

CEILING ELEV. = 4677.94

SECOND FLOOR ELEV. UNITS 5-8 = 4668.44

GENERAL COMMON ELEMENT

CEILING ELEV. = 4665.49

FIRST FLOOR ELEV. UNITS 1-4 = 4655.99

GENERAL COMMON ELEMENT

BASEMENT CEILING ELEV. = 4654.29

GENERAL COMMON ELEMENT

BASEMENT FLOOR ELEV. = 4645.49

0.33' BELOW FINISH FLOOR
IS PART OF UNITS 1 - 4

SECTION B - B'

ROOF ELEV. = 4681.54

GENERAL COMMON ELEMENT

CEILING ELEV. = 4677.94

SECOND FLOOR ELEV. UNITS 5-8 = 4668.44

GENERAL COMMON ELEMENT

CEILING ELEV. = 4665.49

FIRST FLOOR ELEV. UNITS 1-4 = 4655.99



GENERAL COMMON ELEMENT

BASEMENT CEILING ELEV. = 4654.29

GENERAL COMMON ELEMENT

BASEMENT FLOOR ELEV. = 4645.49

0.33' BELOW FINISH FLOOR
IS PART OF UNITS 5 - 8

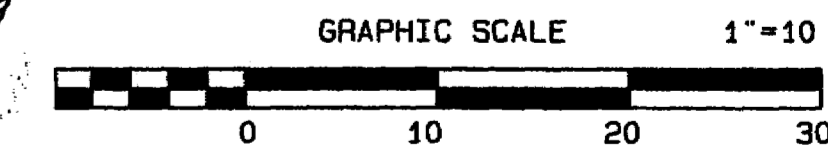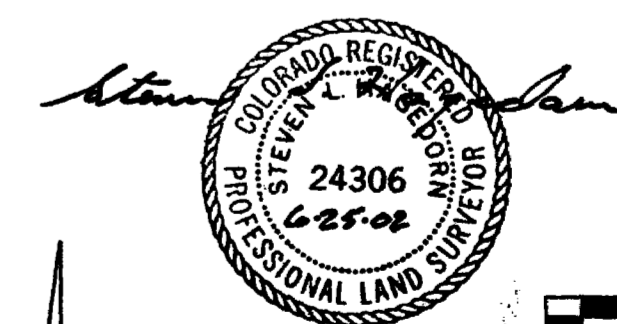

SULLIVAN CENTER CONDOMINIUM
 LOCATED IN THE
 NE1/4 NE1/4 SEC. 11, T1S, R1W, U.M.
 MESA COUNTY, COLORADO
D H SURVEYS INC.
 118 OURAY AVE. - GRAND JUNCTION, CO.
 (970) 245-8749

Designed By S.L.H. Checked By M.W.D. Job No. 587-00-01
 Drawn By TMODEL Date JUNE 2002 Sheet 2 OF 2