


STATE OF COLORADO, COUNTY OF MESA
 RECORDED AT 7:42 P.M. JAN 4 1978
 RECEPTION NO. 150044

Page 1
 FEDERAL ENGINEERS INC
 PART OF TRACT "C"
 LAKESIDE SUBDIVISION
 MESA, COLORADO

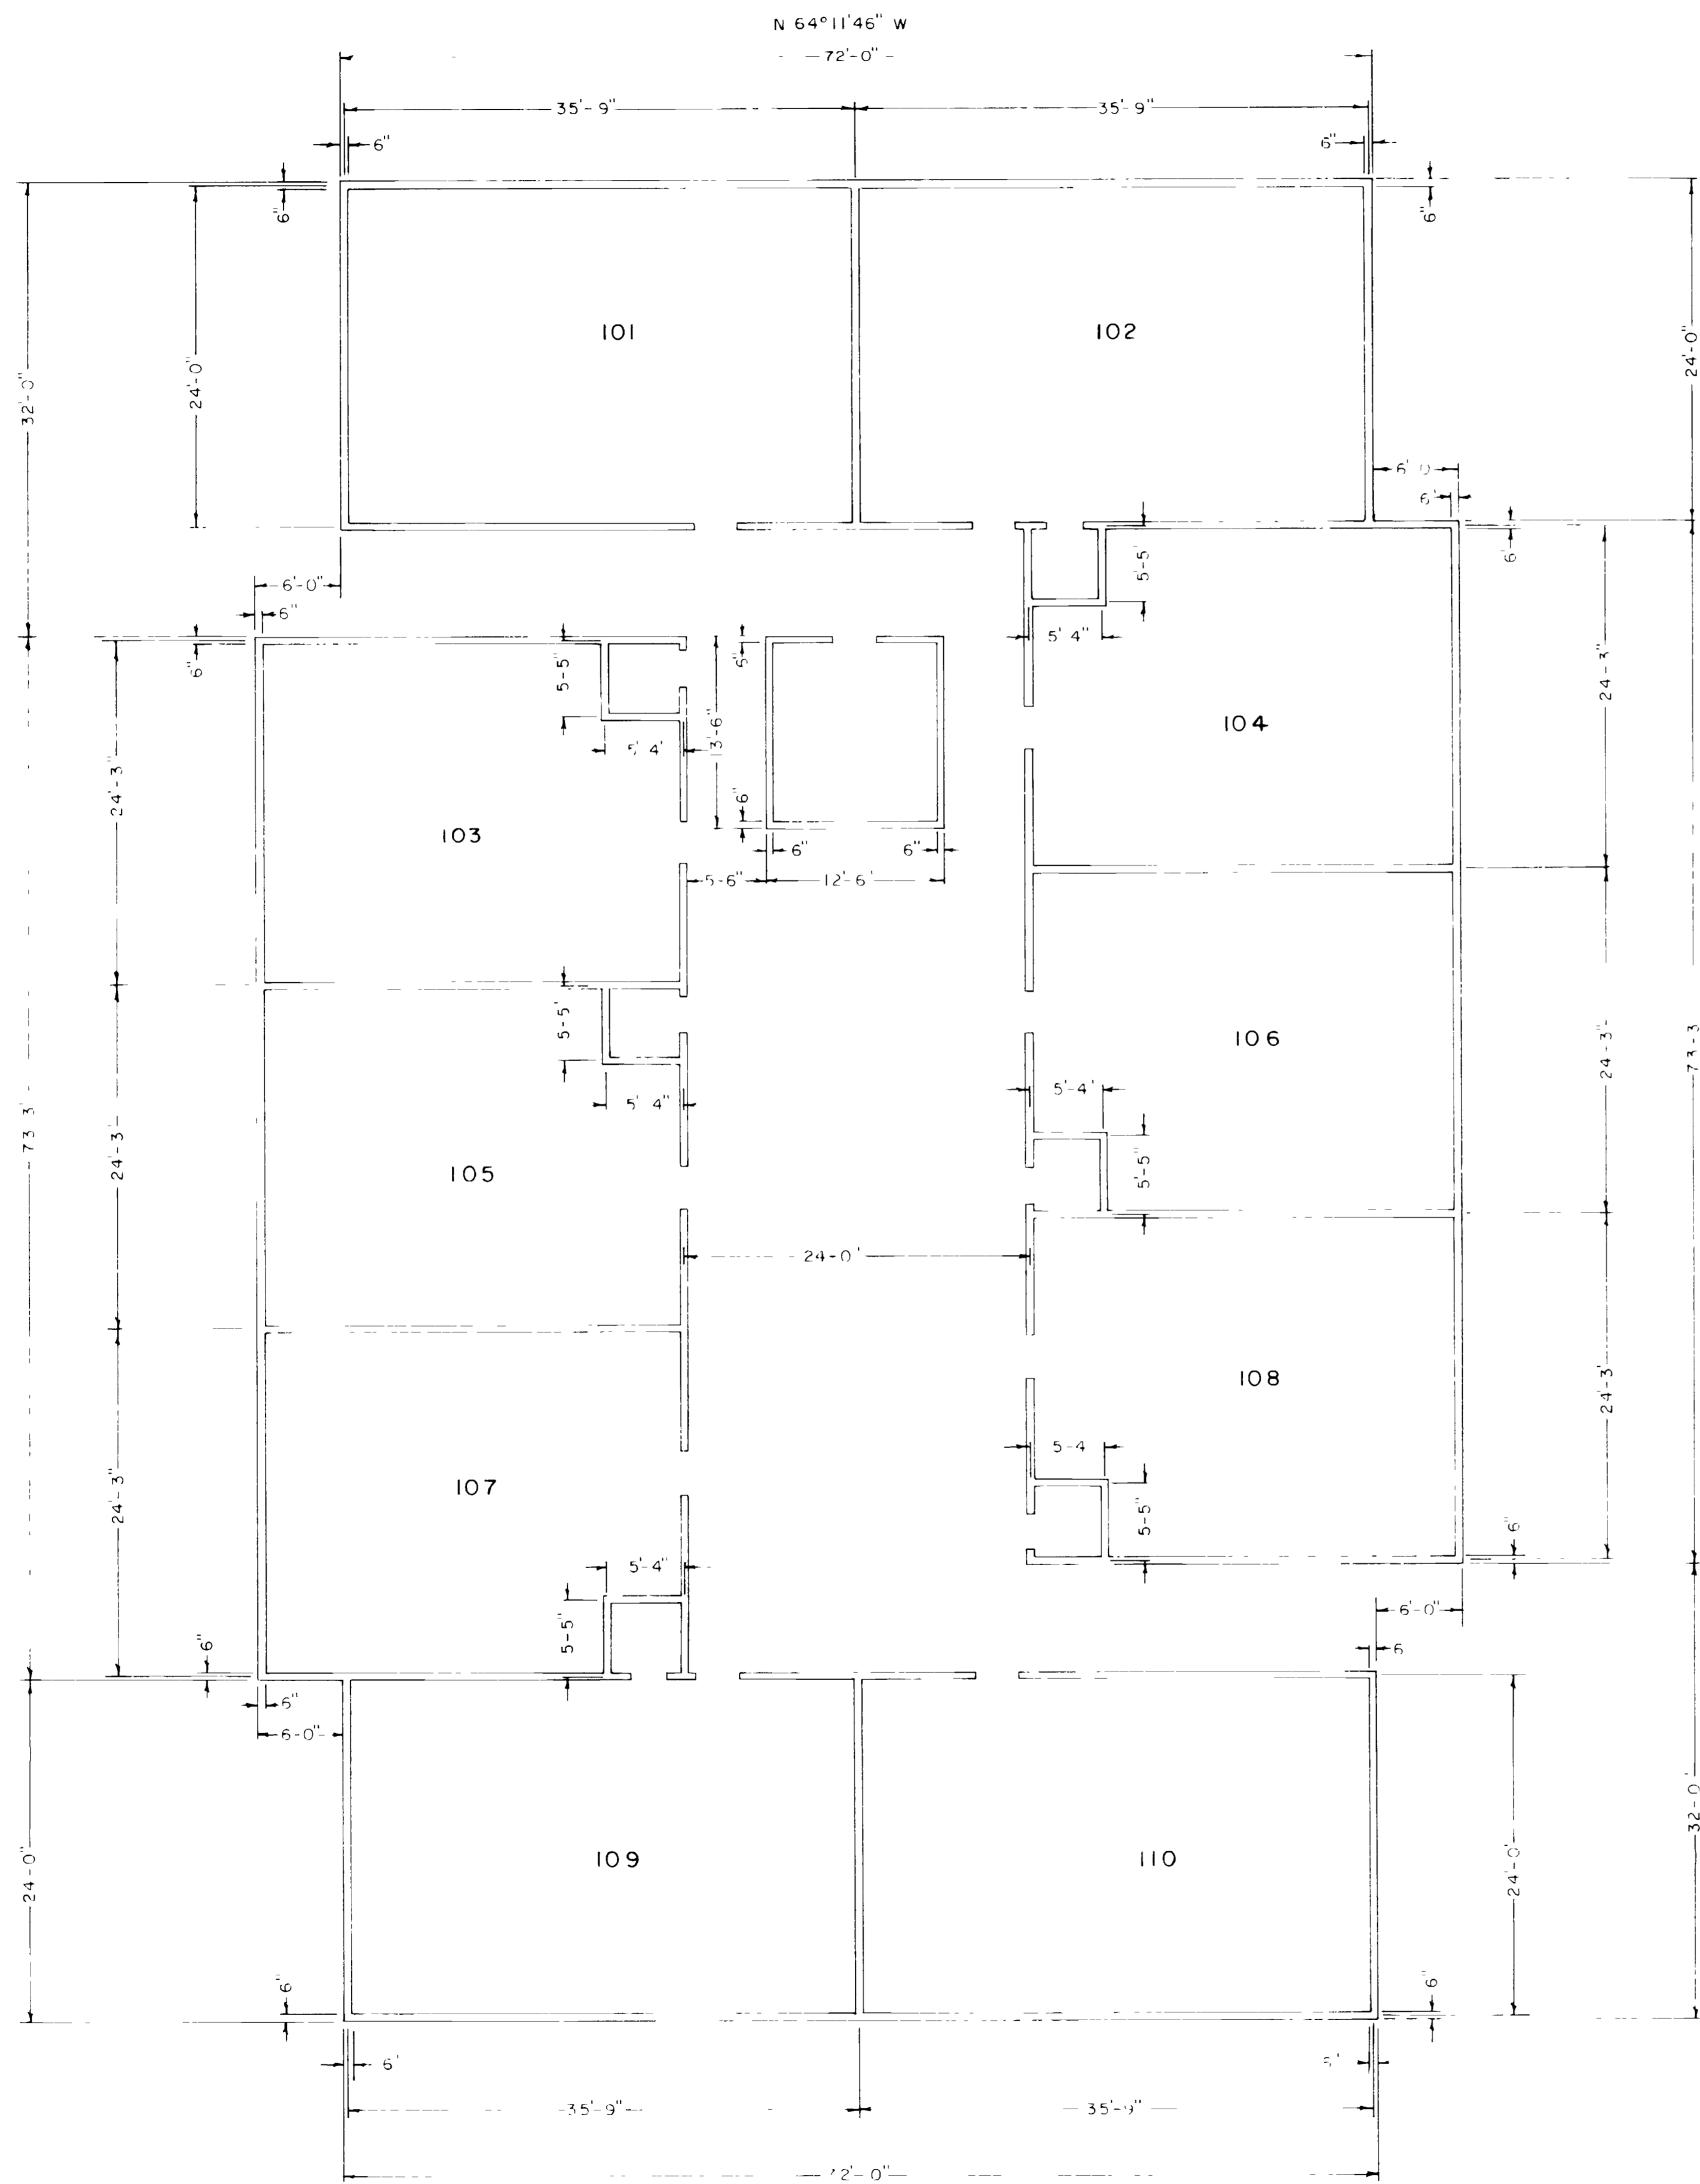


LOWER FLOOR
 ELEV. 4662.21


SCALE 1/8" = 1'-0" Page 2

BUILDING PLAN 3231 LAKESIDE DRIVE GLENBROOK IN LAKESIDE SUBDIVISION	
SURVEYED P.M. — DB	DRAWN — RWQ, CHECKED — CJB
WESTERN ENGINEERS INC. — GRAND JUNCTION, COLO. DWG. 1590-429-18	



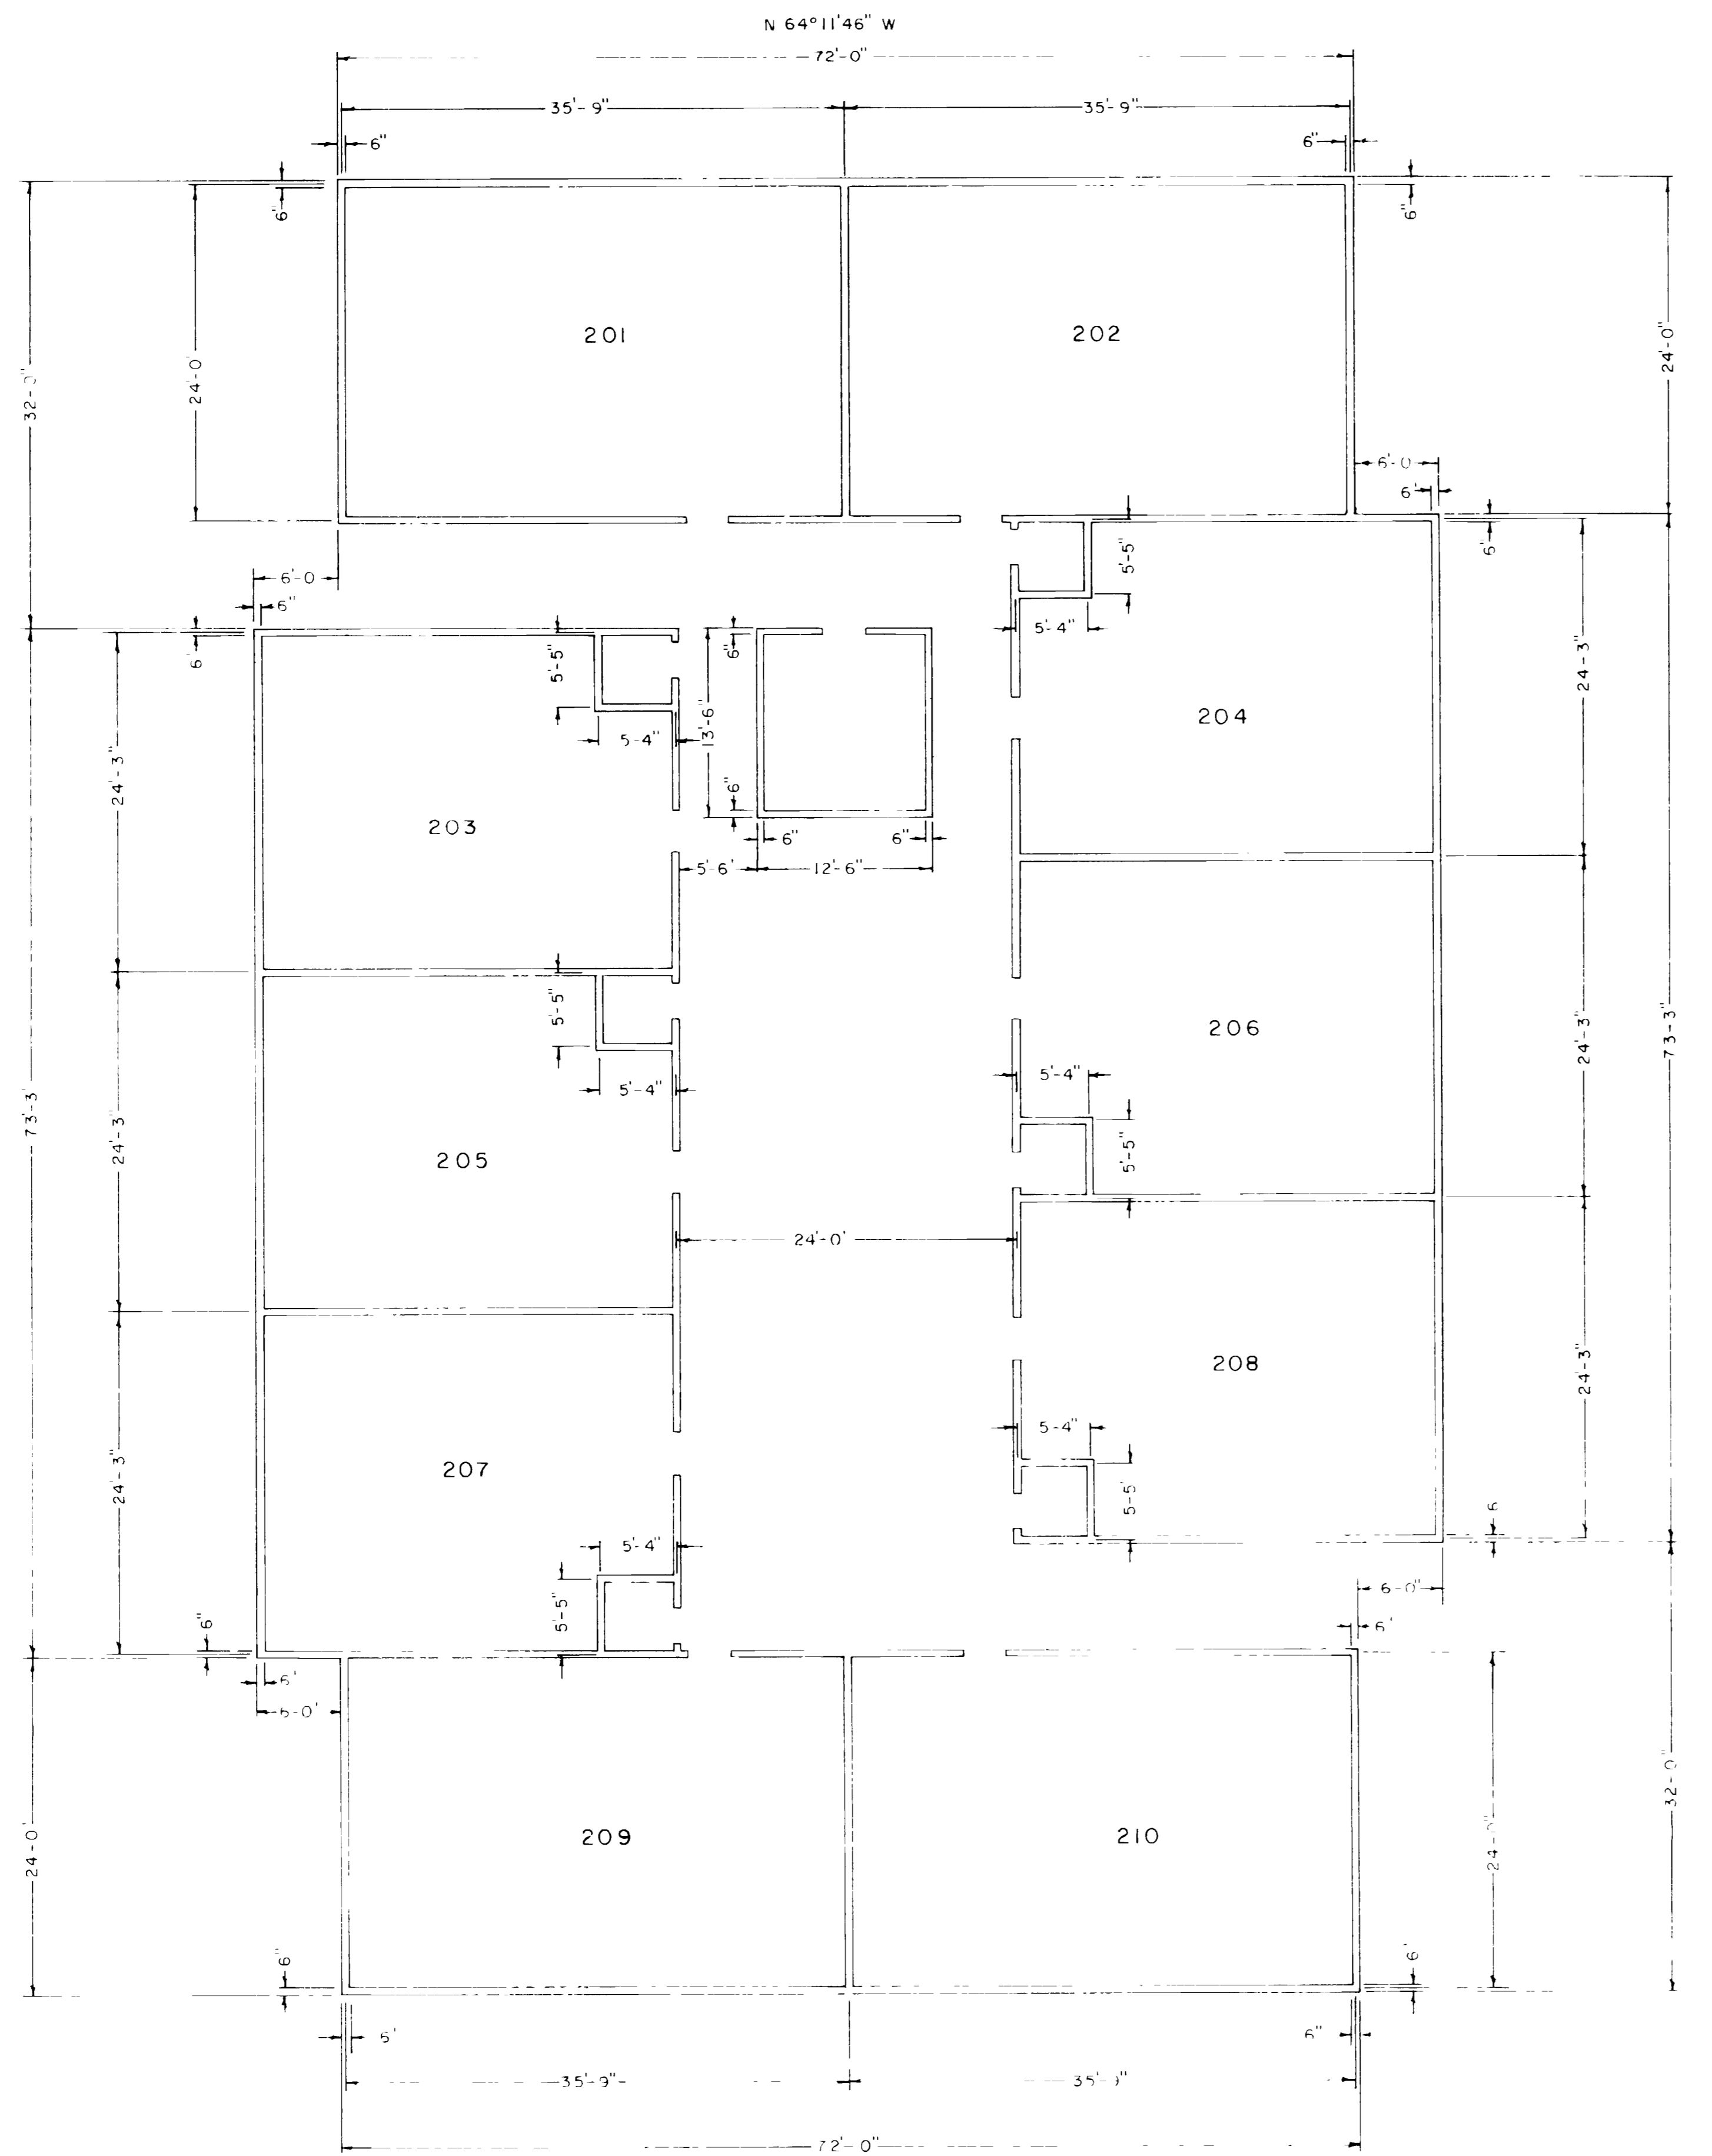



MIDDLE FLOOR
 FLEV. 4+71.24

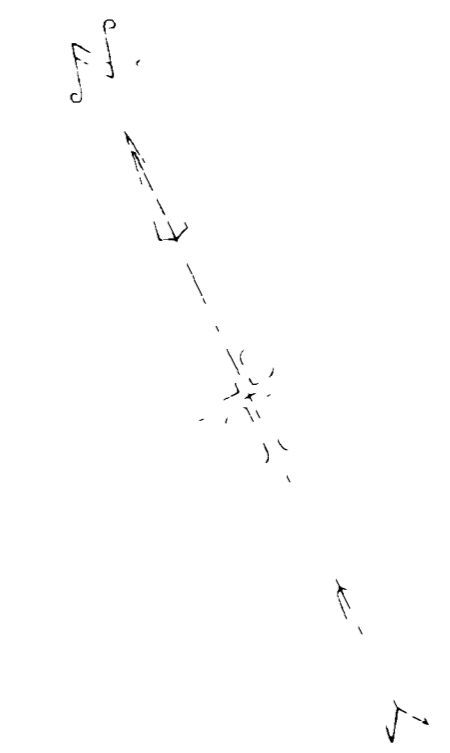

SCALE 1/8" = 1'-0" *Page 3*

BUILDING PLAN
 3231 LAKESIDE DRIVE
GLENBROOK
 IN
 LAKESIDE SUBDIVISION



SURVEYED BY: D.H. DB DRAWN: RWG CHECKED: C.J.R.
 WESTER ENGINEERS INC. - GRAND JUNCTION, CO. TEL: 970-429-1818

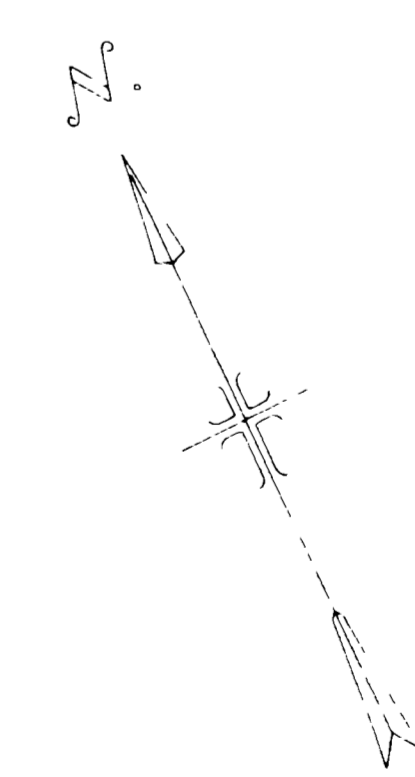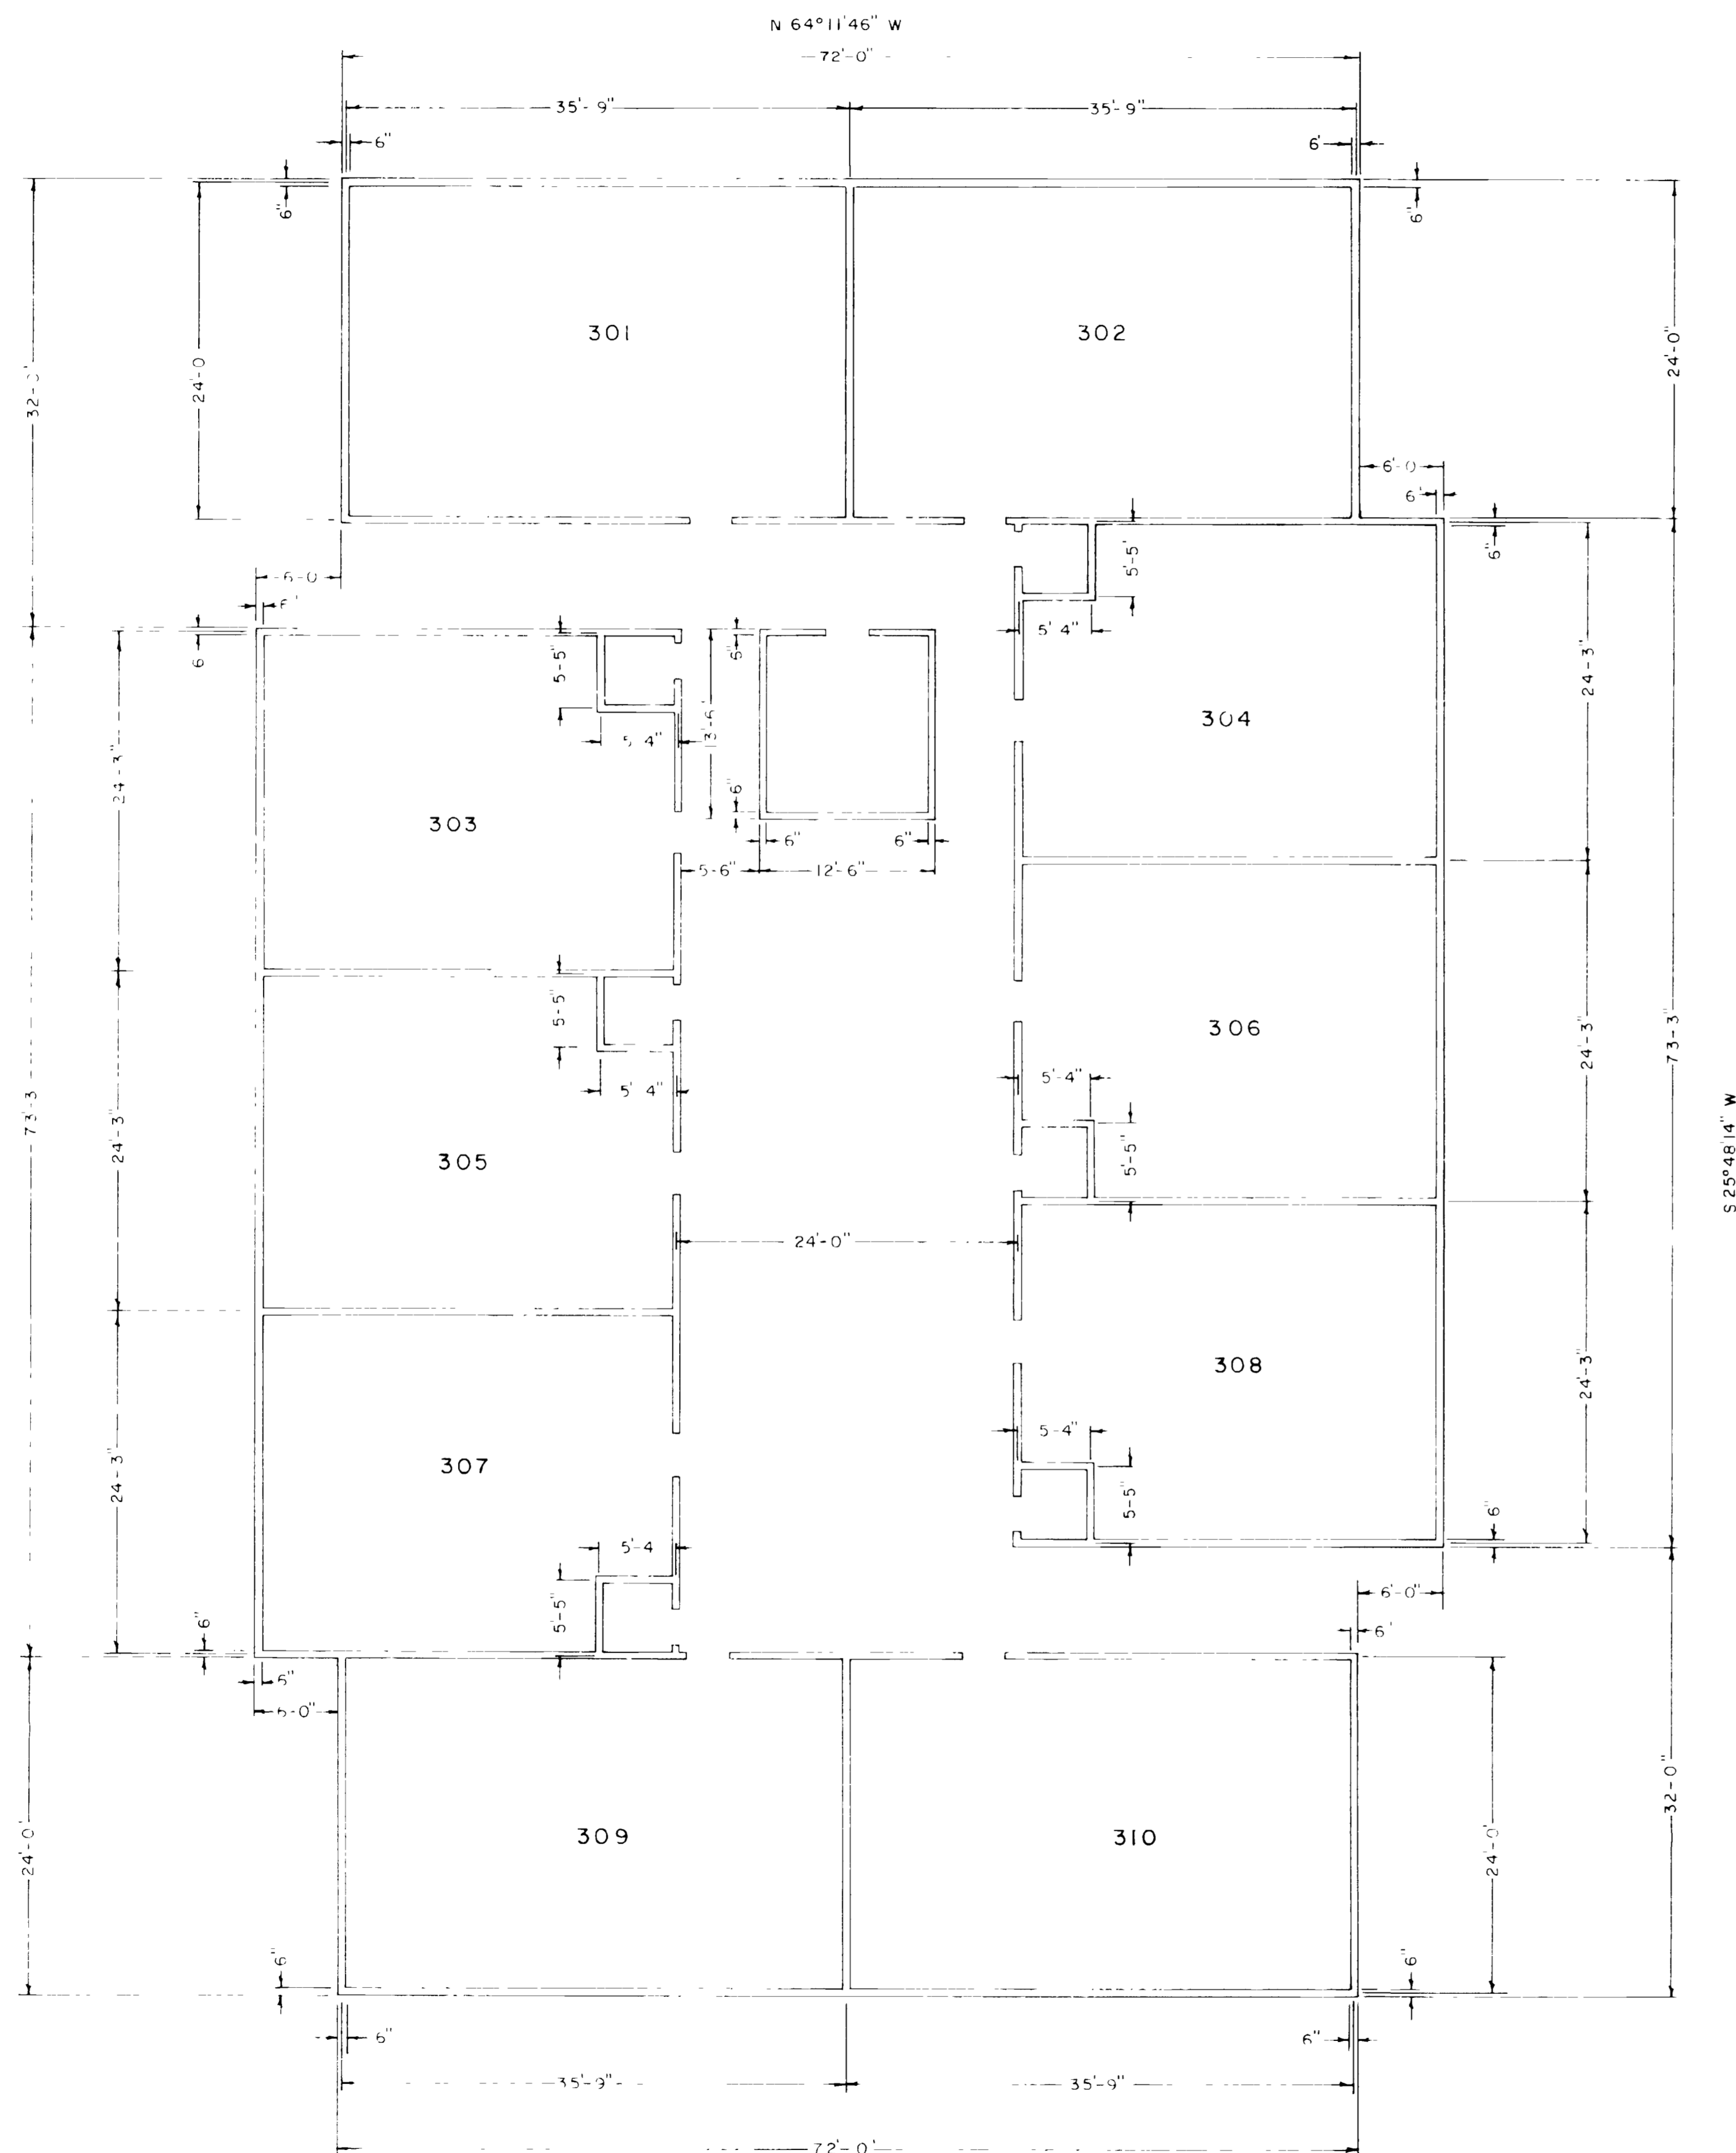

UPPER FLOOR
ELEV. 4679.87

SCALE 1/8" = 1'-0" *page 1*


BUILDING PLAN			
5231 LAKESIDE DRIVE			
GLENBROOK			
IN			
LAKESIDE SUBDIVISION			
SURVEYED D.H. - DB	DRAWN - RWQ	CHECKED - CJB	DATE
WESTERN ENGINEERS INC. - GRAND JUNCTION, COLO. DWG. 1590-429-35			

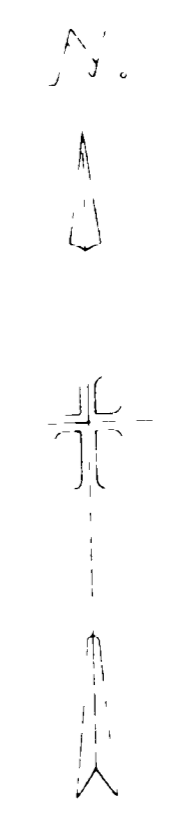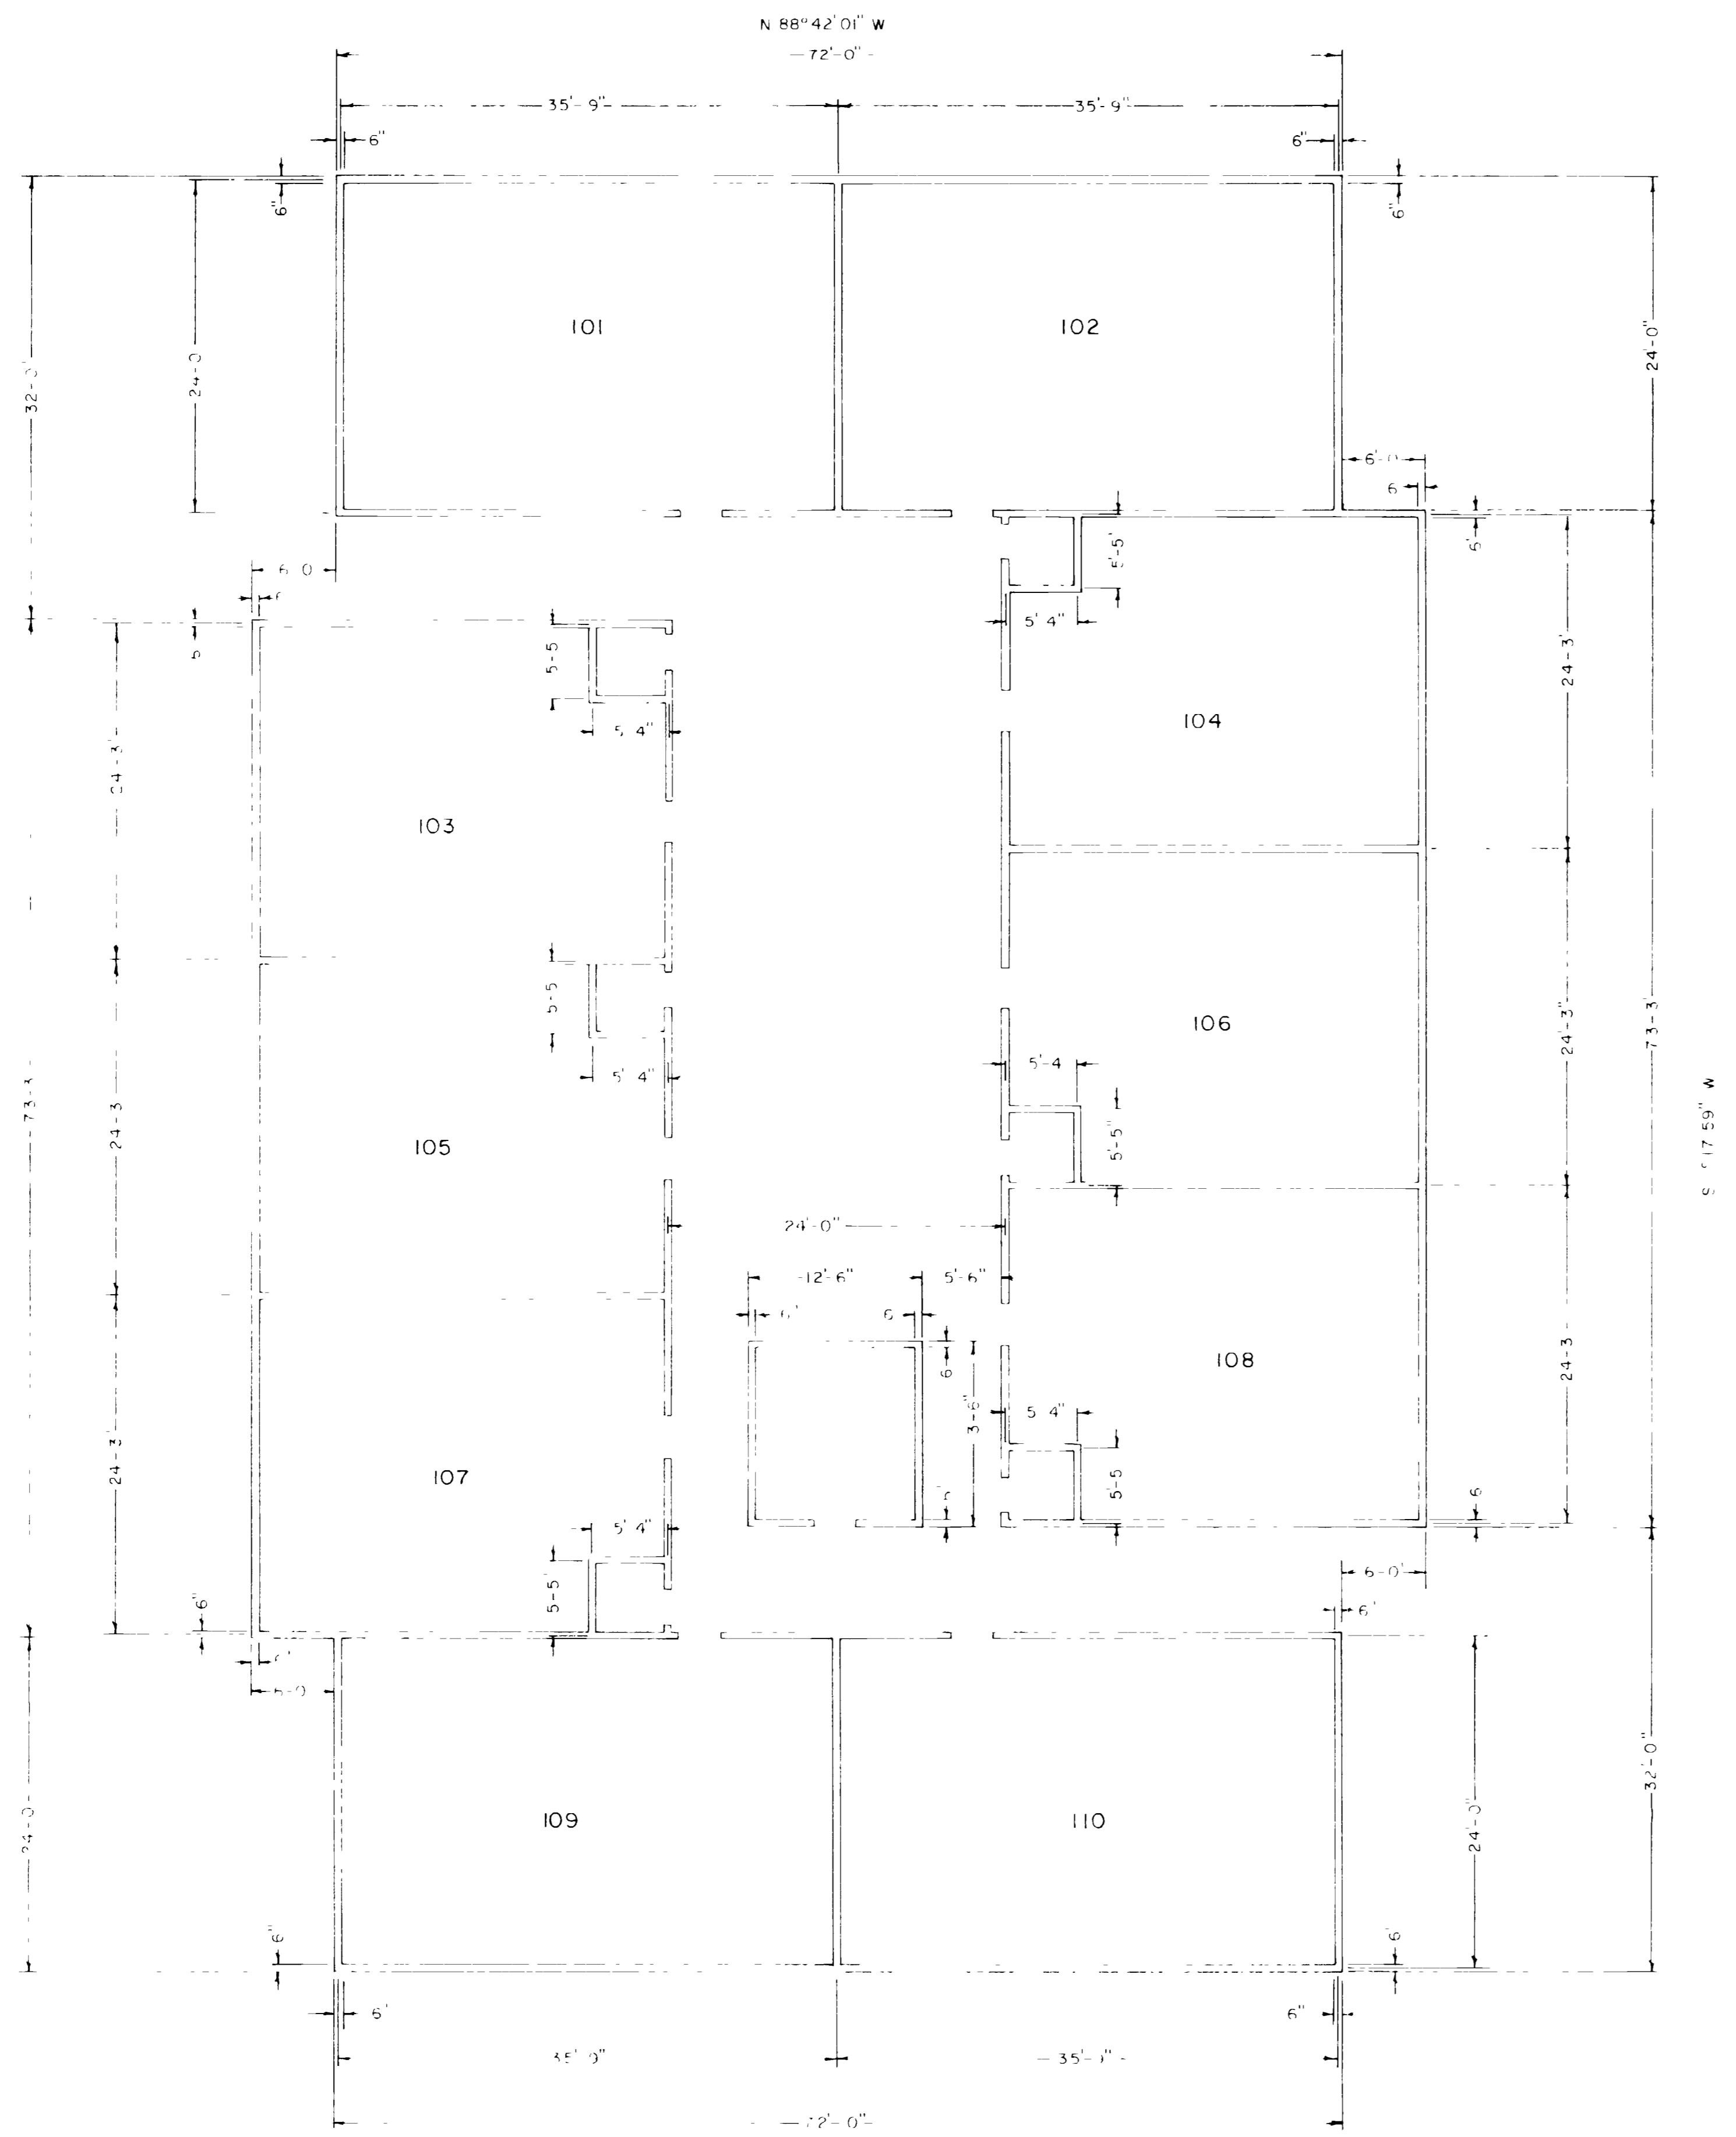

SCALE $\frac{1}{8}$ " = 1'-0" *page 5*

BUILDING PLAN
 3233 LAKESIDE DRIVE
 WILLOWOOD
 IN
 LAKESIDE SUBDIVISION
 SURVEYED, D.H. - D.B. DRAWN - B.W.O. CHECKED - C.J.B.
 WESTERN ENGINEERS, INC. - GRAND JUNCTION, COLO. DWG. 1990-429-38

LOWER FLOOR
 FLLV 466127

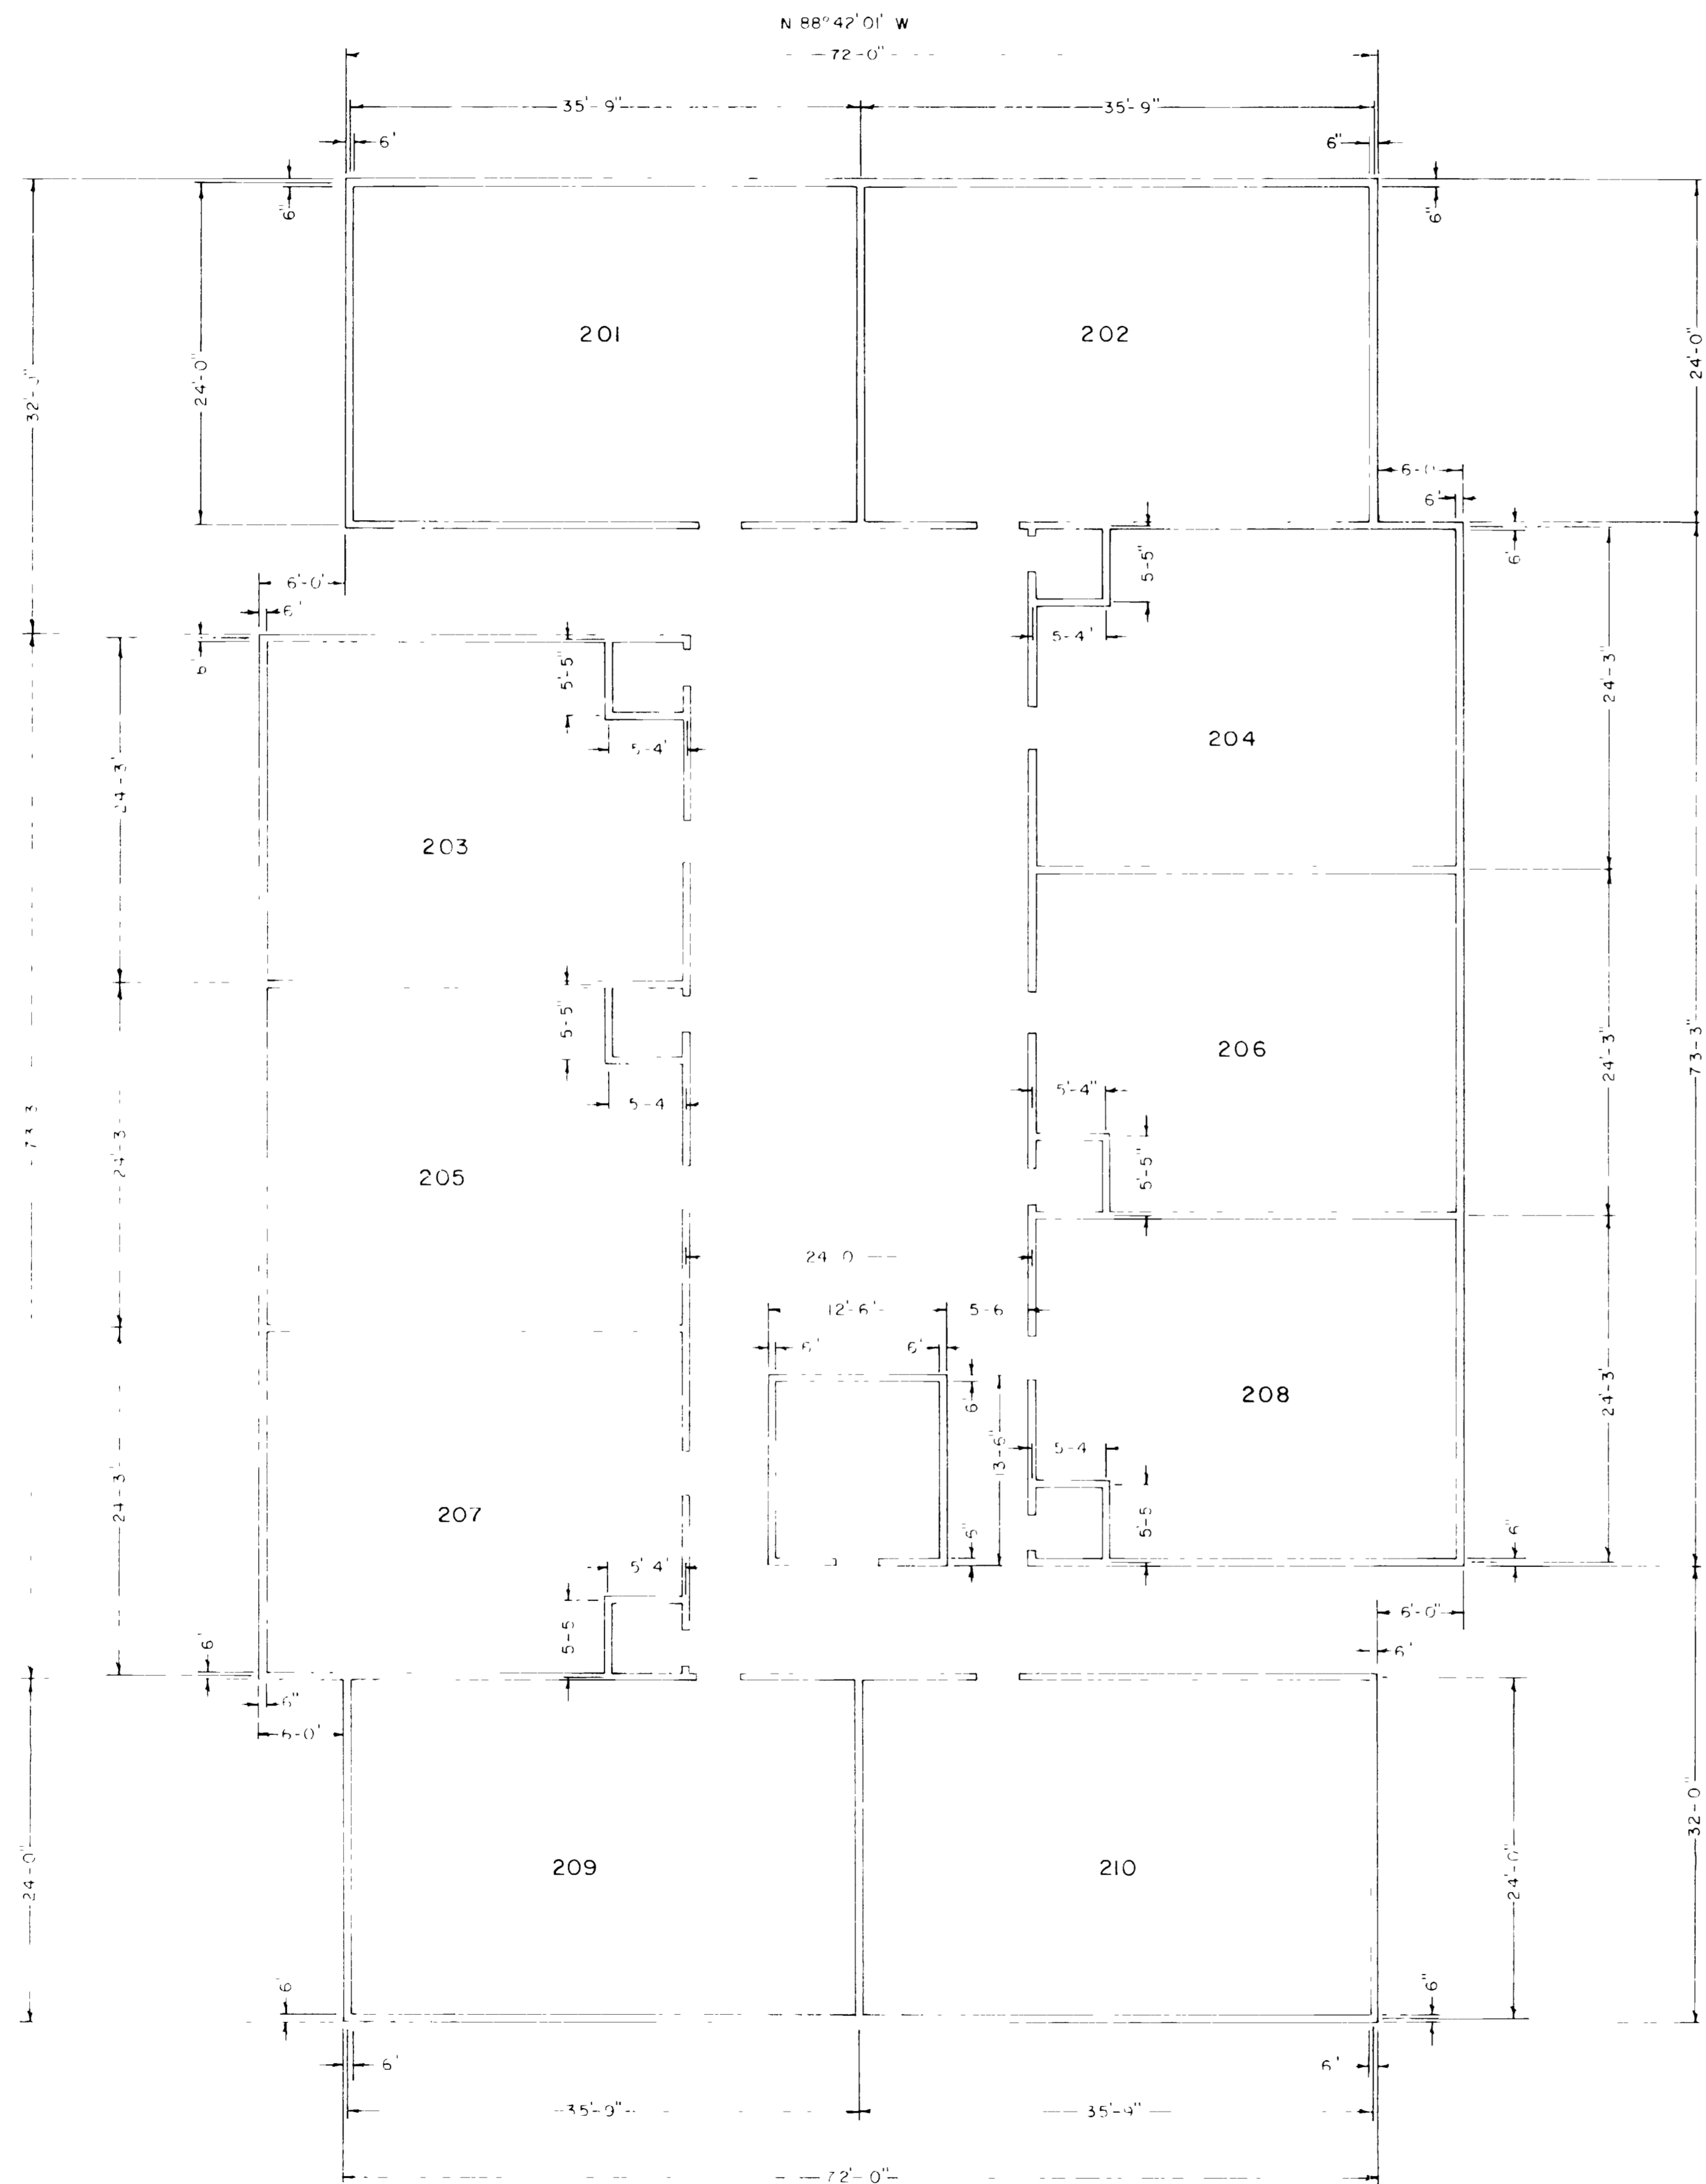

S 17° 59' W




SCALE 1/8" = 1'-0" Page 6


BUILDING PLAN
 3233 LAKESIDE DRIVE
WILLOWOOD
 IN
 LAKESIDE SUBDIVISION

SURVEYED: D.H.-D.B. DRAWN: R.W.G. CHECKED: C.J.B.
 WESTERN ENGINEERS, INC. - GRAND JUNCTION, COLO. DWG. 1590-429-18

MIDDLE FLOOR
 ELEV. 4670.10

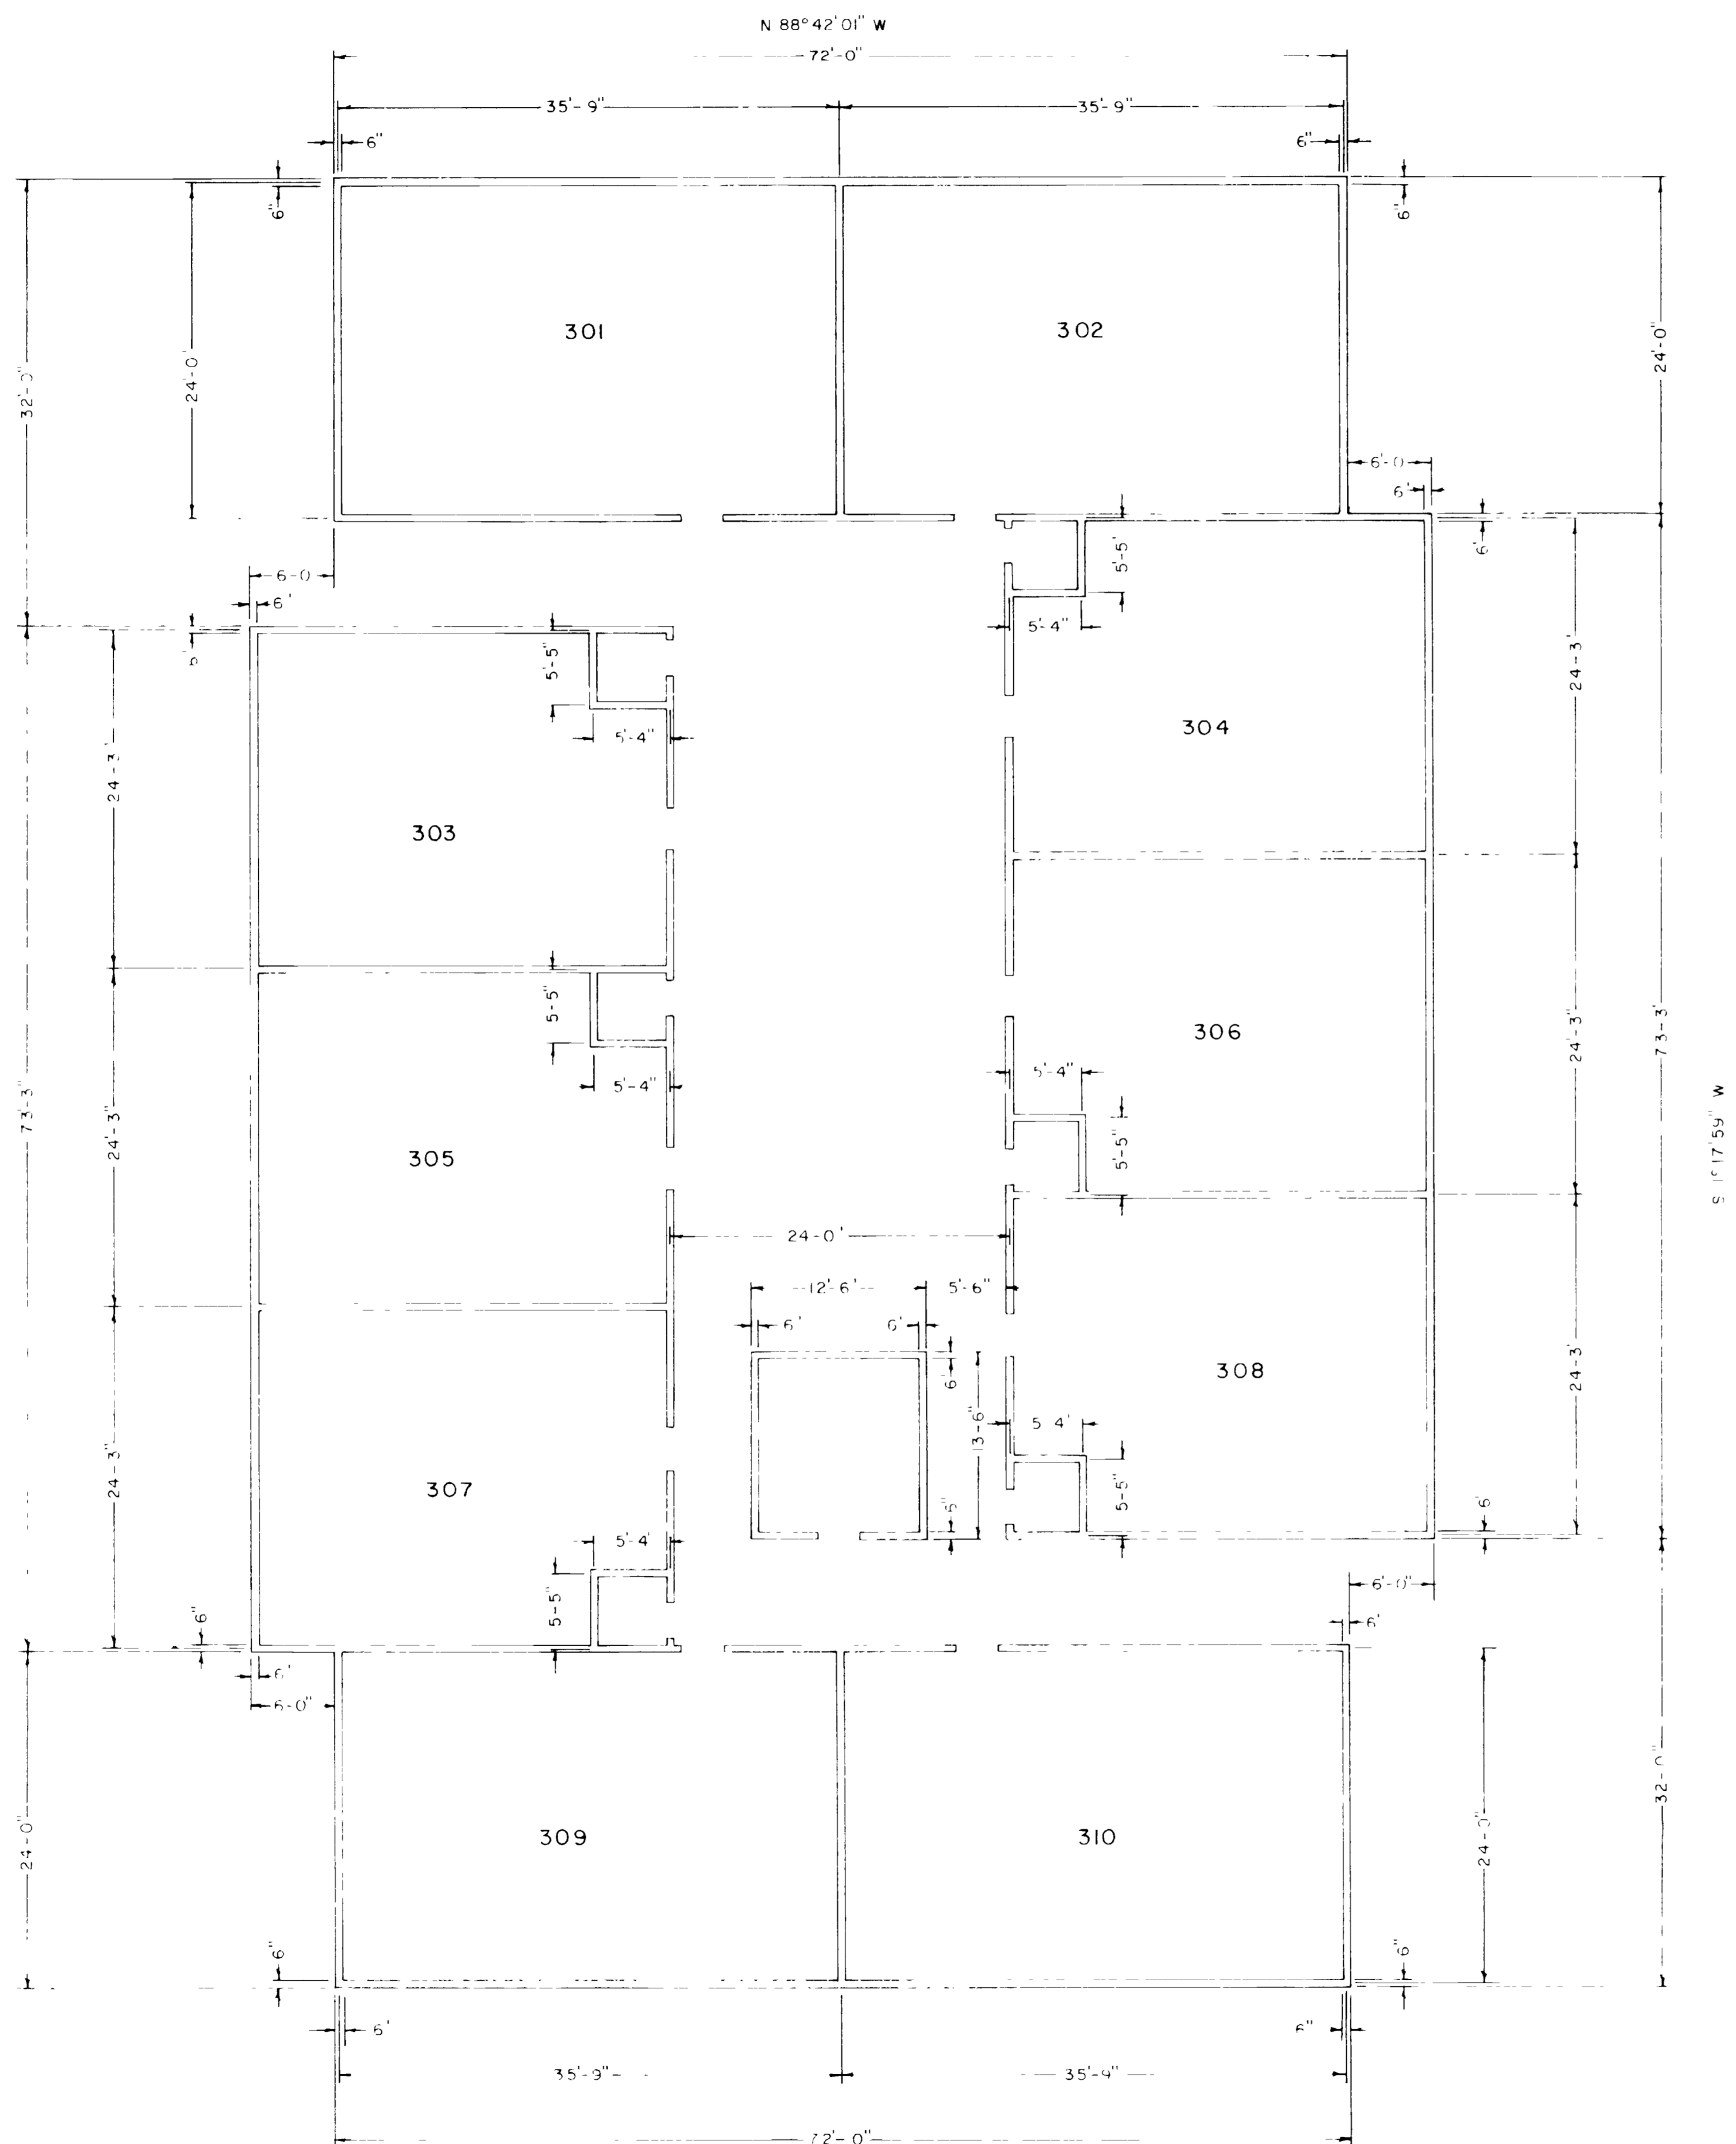

UPPER FLOOR
 F. E. V. 46/8 '13

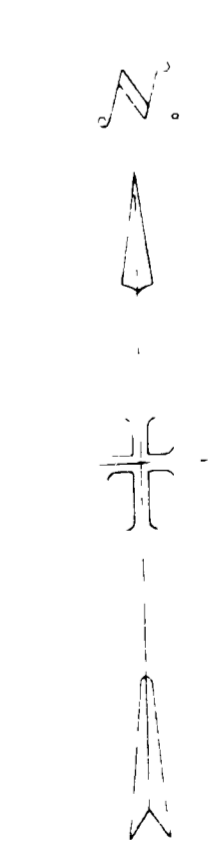

SCALE 1/8" = 1'-0" Page 7

BUILDING PLAN			
3233 LAKESIDE DRIVE			
WILLOWOOD			
114			
LAKESIDE SUBDIVISION			
SURVEYED	D.H. - BB	DRAWN	R.W.D. CHECKED
WESTERN ENGINEERS, INC. - GRAND JUNCTION, COLO.		DWG. 1590-429-38	