


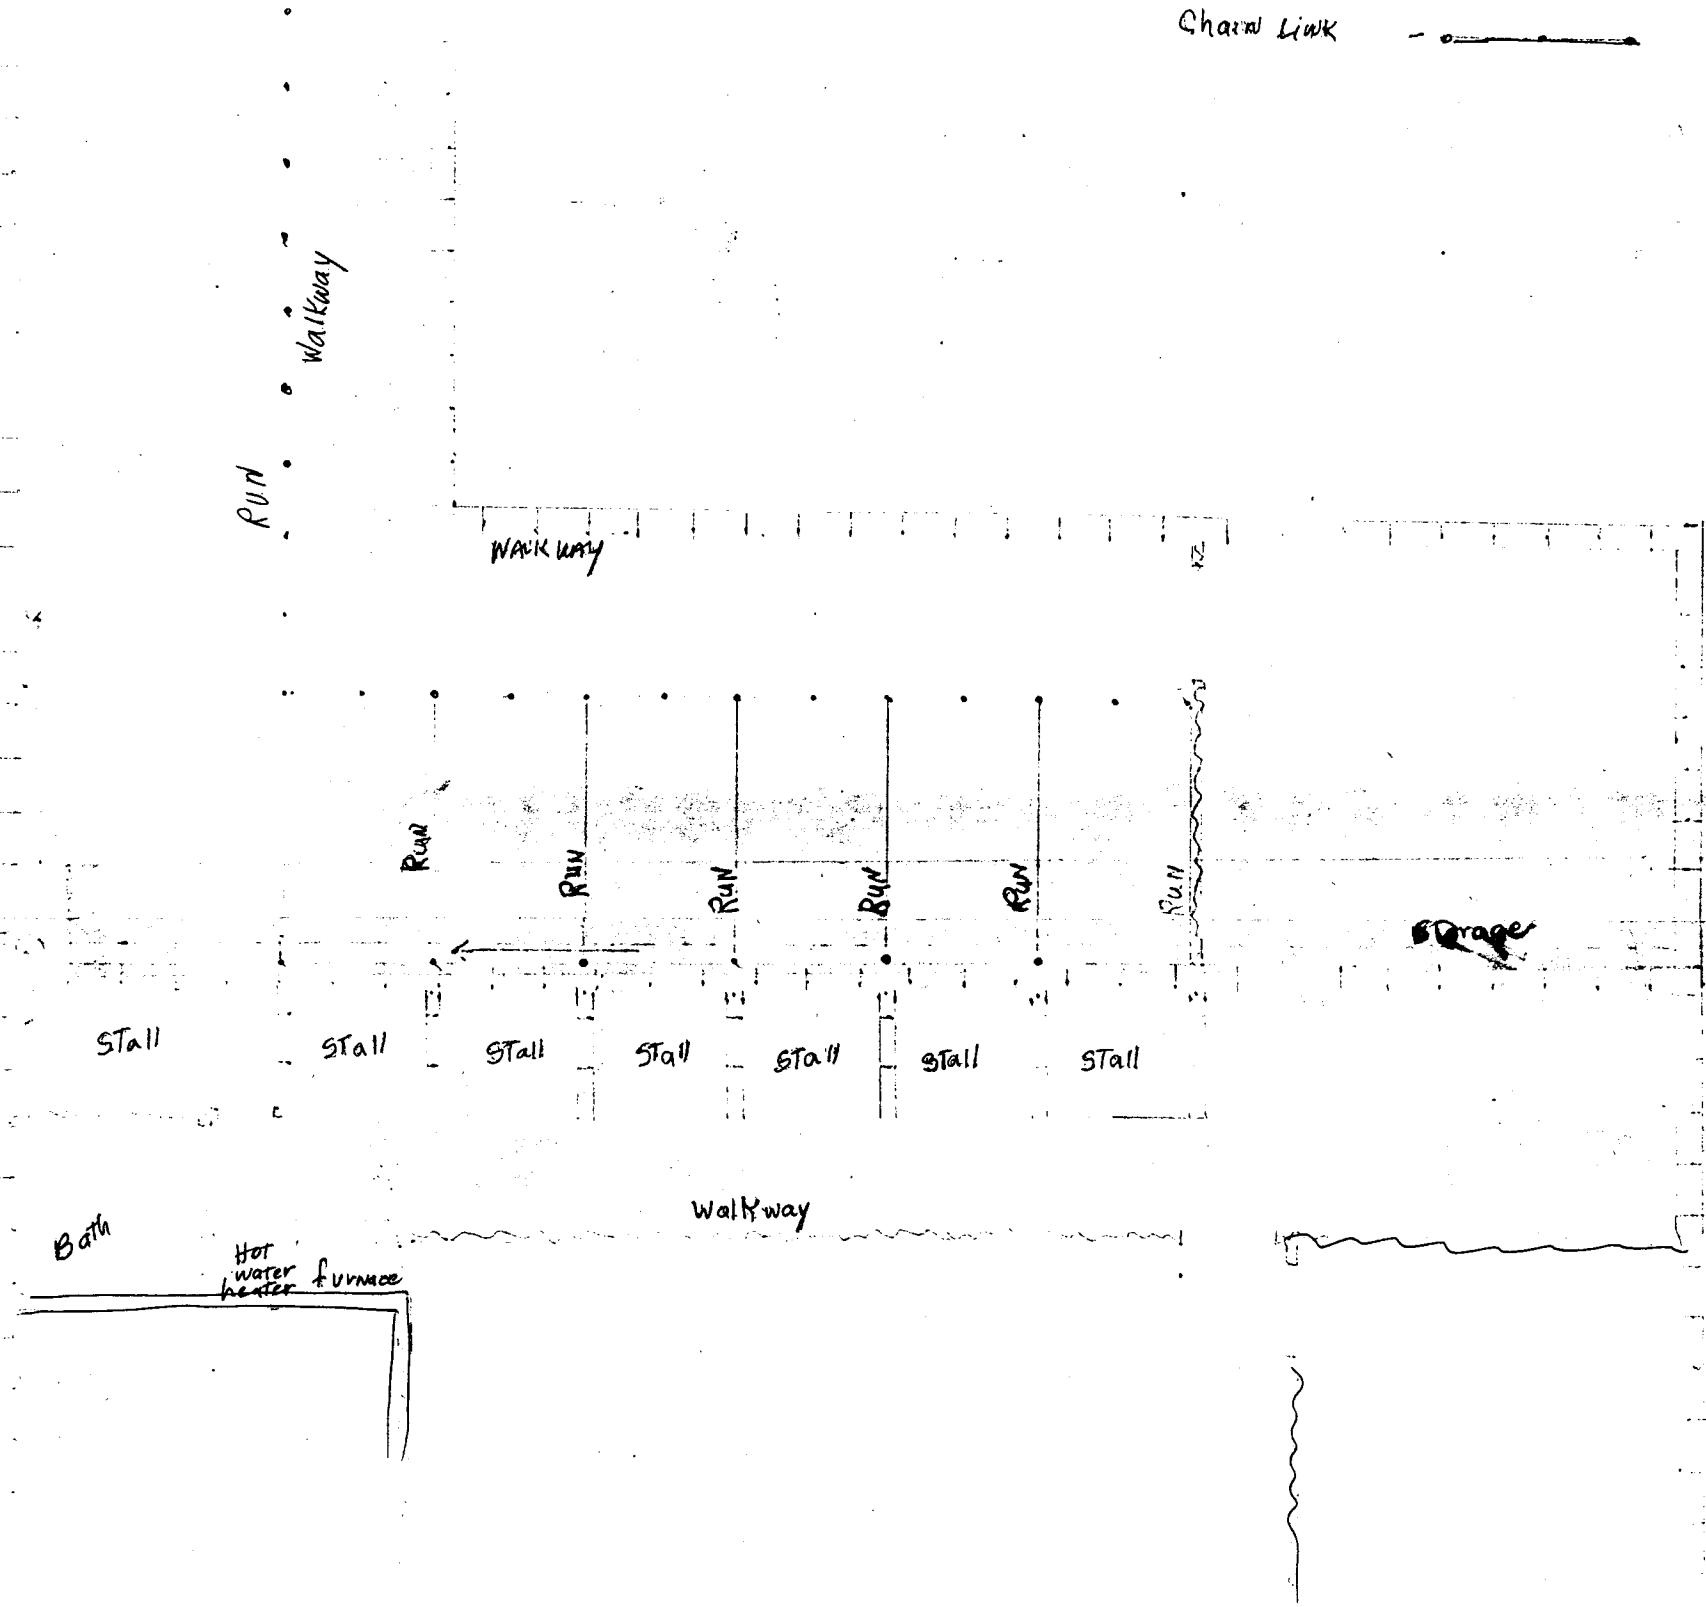

Chain Link

Ker  
Bo  
ME



Date Received: 12-26-72

Item # 3-73

Request: Conditional Use 5.7 (Dog Grooming)

~~Location:~~  
Location: 2860 1/2 North Ave.

Petitioner: Robert D. Kender

Address: \_\_\_\_\_ Phone: \_\_\_\_\_

Advertised: yes Date: 1-15-73

To Planning Comm: 1-31-73

Action: Approved as per sketch in file

Advertised: \_\_\_\_\_ Date: \_\_\_\_\_

To City Council: \_\_\_\_\_

Action: \_\_\_\_\_

Comments: \_\_\_\_\_