

Date Received: 12/1/74

Item # 63-73

Request: rezone R-3, P, B-2 to PdB

Location: _____
Location: NW corner of 12th & Patterson

Petitioner: CBW Builders

Address: _____ Phone: _____

Advertised: yes Date: 12/11/73

To Planning Comm: _____


Action: _____

Advertised: _____ Date: 2/8/74


To City Council: Final PUD 2/20/74

Action: Approved subject to comm. rec.

Comments: _____

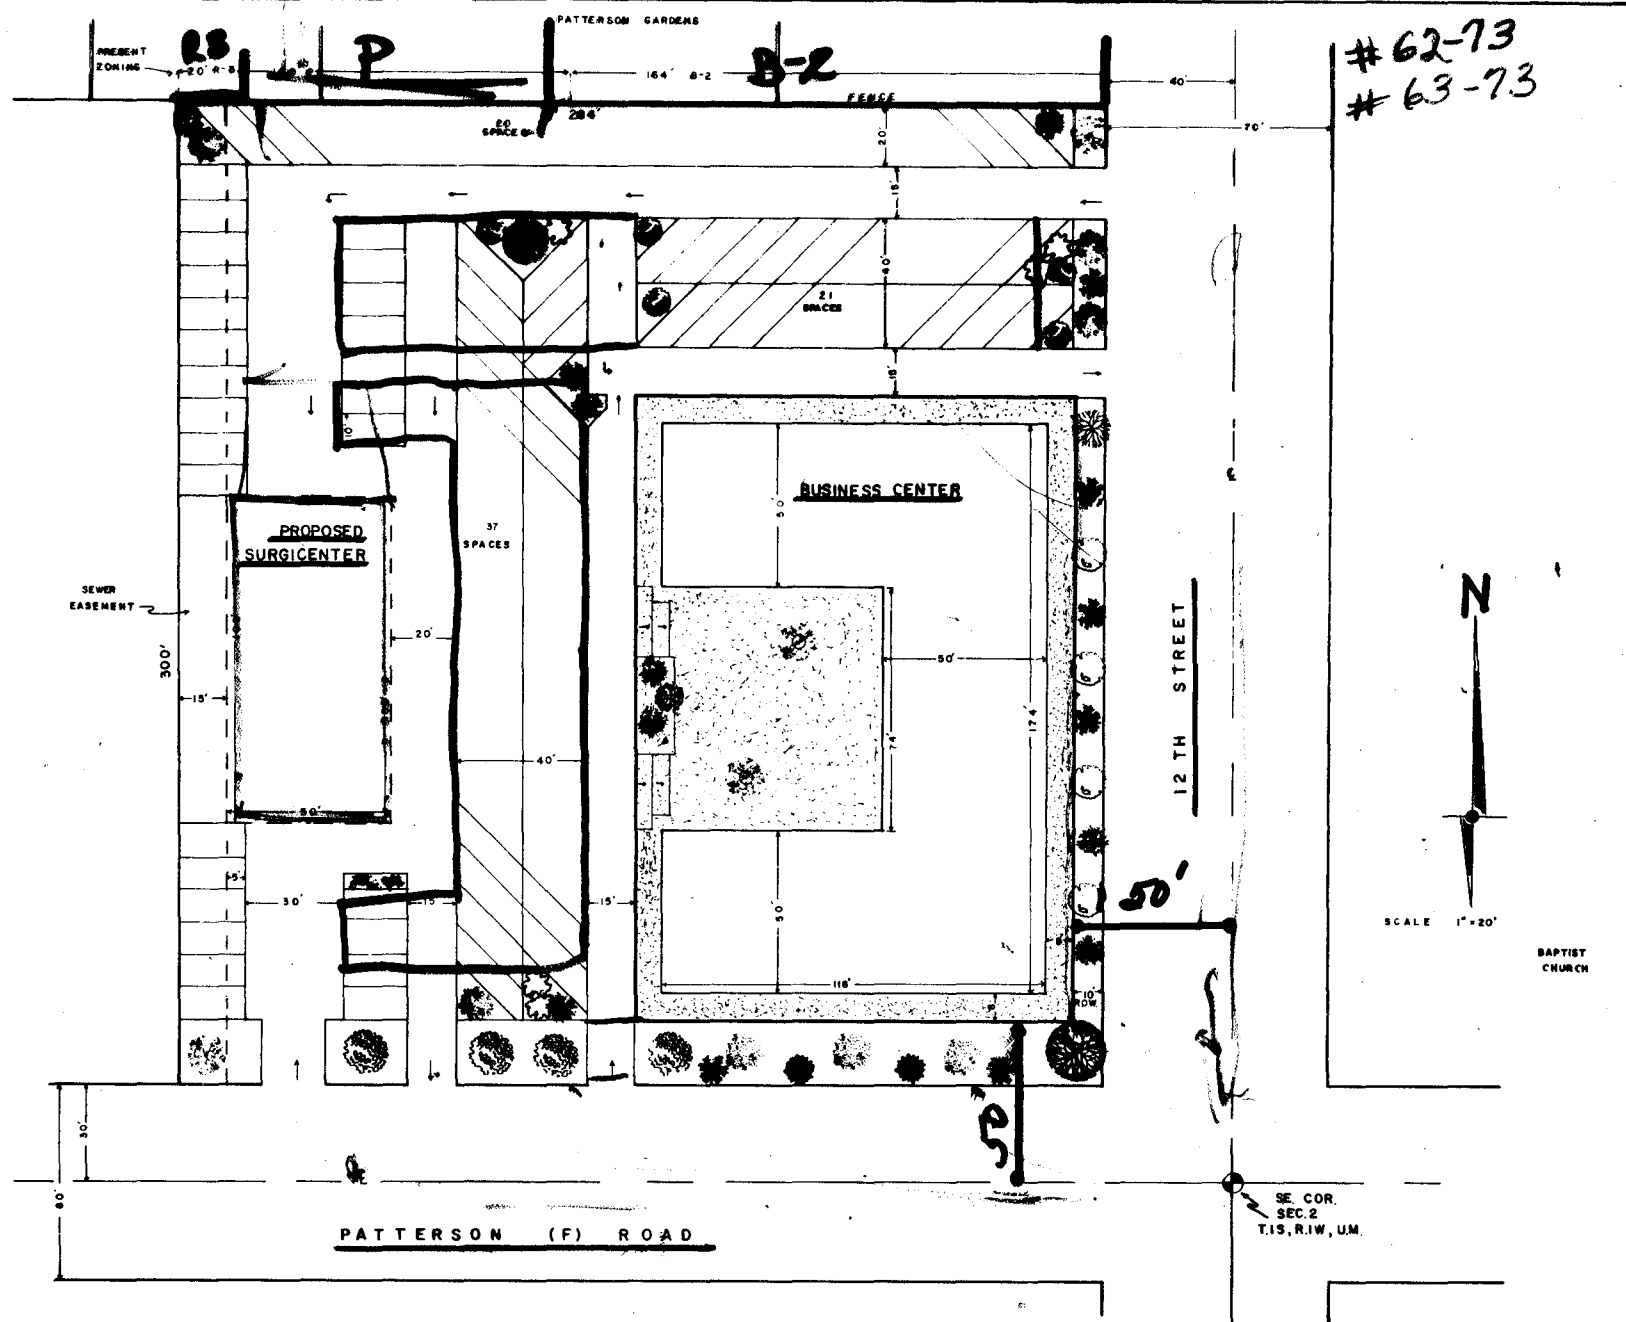

62-73
 # 63-73

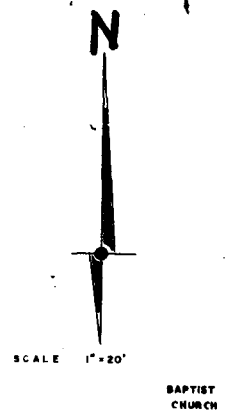

SE. COR.
 SEC. 2
 T.1S, R.1W, U.M.

SITE PLAN	
12 TH & PATTERSON ROAD	
	12-6-73 <i>OH</i>
C.W. BUILDERS BOX 2107 GRAND JCT., COLO.	