



Date Received: May 1, 1974

Item # 25-74

Request: Variance & Revocable permit for sub-  
surface bldg. footings & planters for off bldg.  
Location: SW corner of 7th & Bedford

Petitioner: Chambliss & Milton Assoc

Address: \_\_\_\_\_ Phone: \_\_\_\_\_

Advertised: yes Date: 5/11/74

To Planning Comm: \_\_\_\_\_


Action: \_\_\_\_\_

Advertised: yes Date: May 11, 1974

To City Council: July 3, 1974

Action: Approved

Comments: \_\_\_\_\_

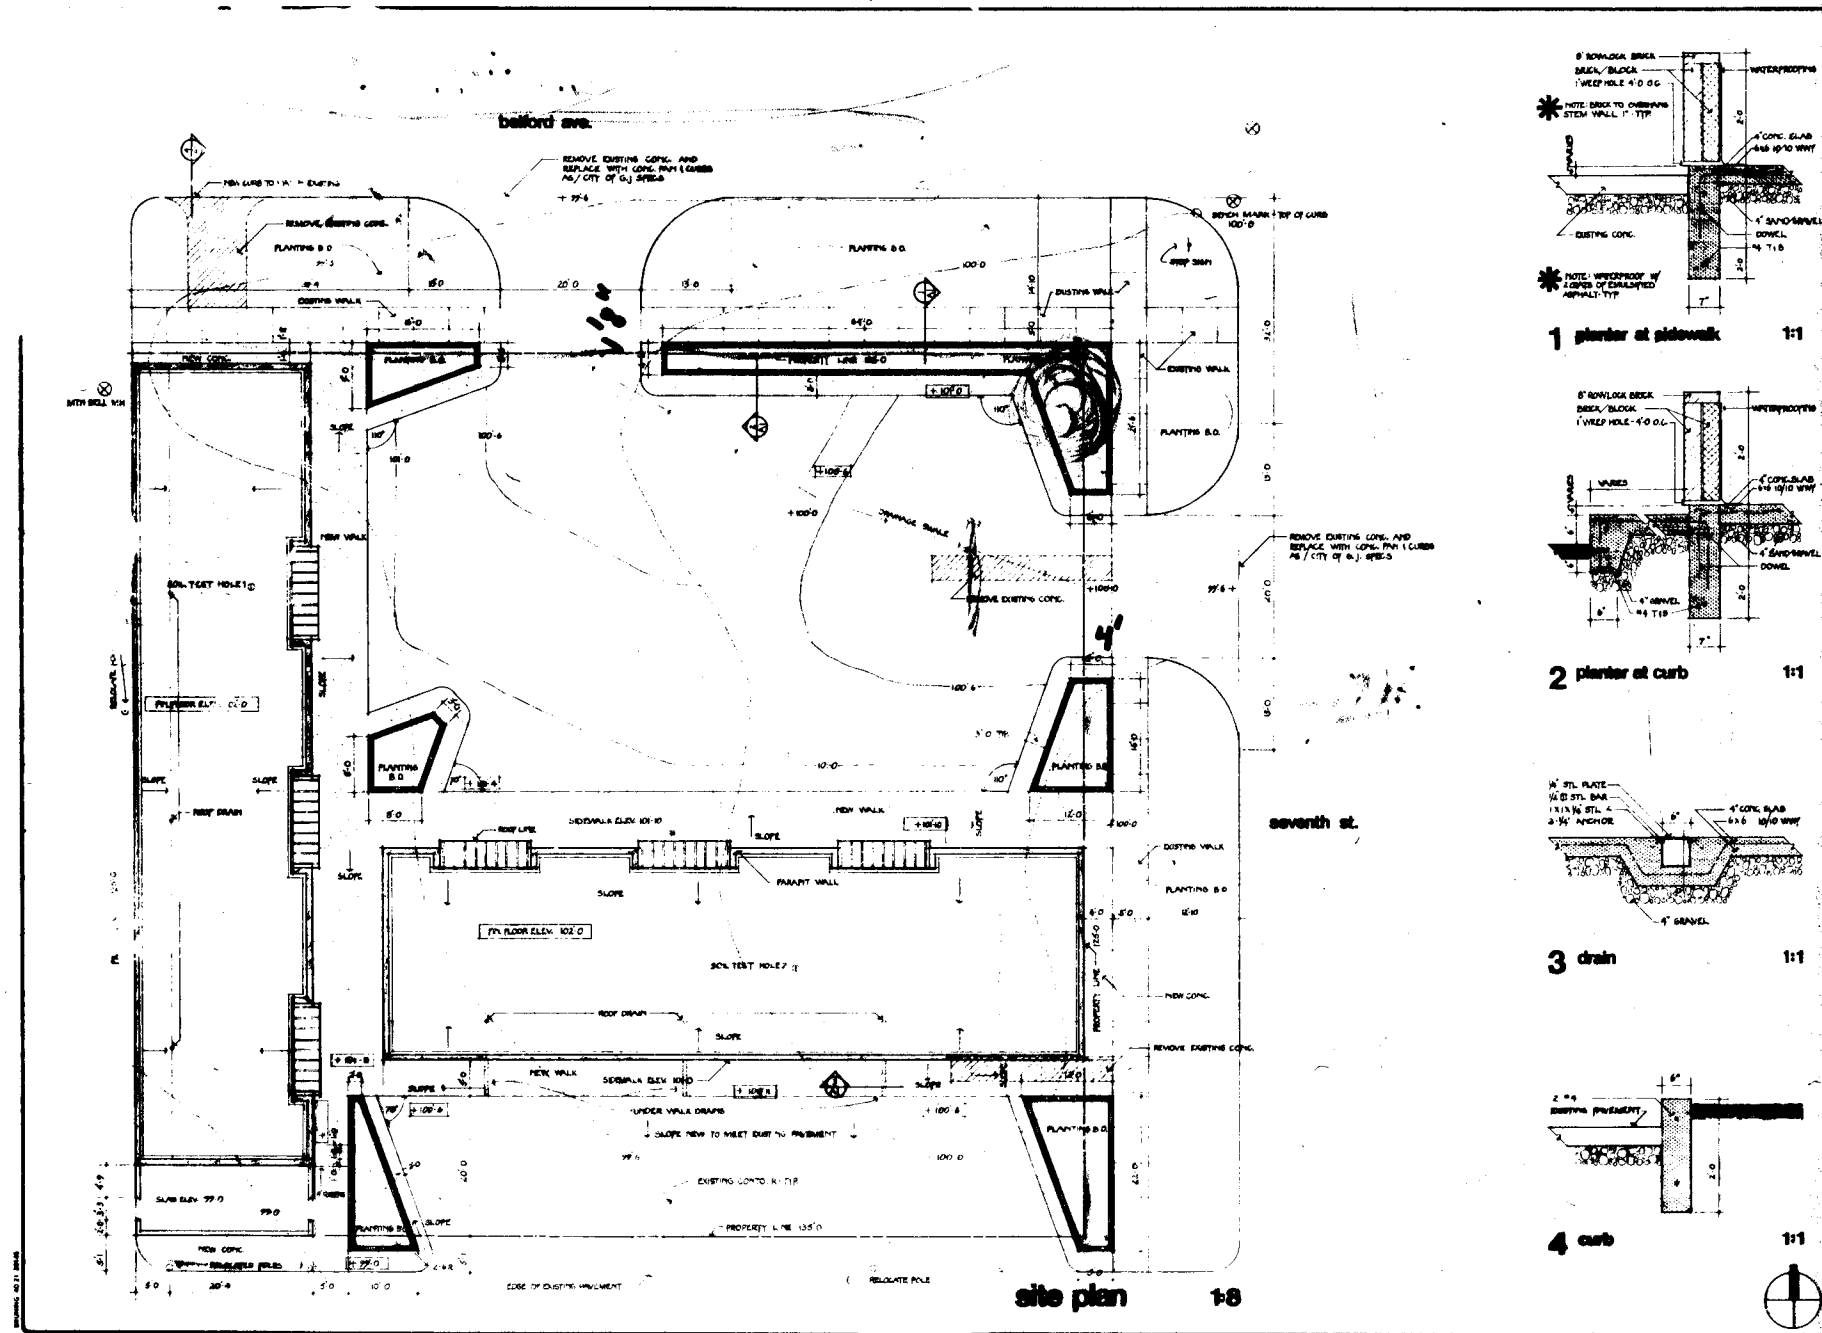

CHAMBERS, DILLON & ASSOCIATES

JOB NUMBER  
 DRAWN BY  
 CHECKED BY  
 REVIEWED BY

A1

A