

Subdivision _____

Date 1-14-76

Item # 5-26

Petitioner ALVIN RICKS

Preliminary
Review Agencies Comments

Final
Review Agencies Comments



Action Taken

Action Taken

P.C. PASSED 28 JAN 76

P.C. _____

C.C. PASSED 18 Feb 76

C.C. _____


Comments

Comments

NEED ORIGINAL

ITEMS REQUIRED FROM DEVELOPER

- | | | |
|-------------------|------------------------|--------------------------|
| ____ Check | ____ Utility Agreement | ____ Title Investigation |
| ____ Drainage | ____ Landscaping | ____ Covenants |
| ____ Improvements | ____ Guarantee | ____ Annexation |
| | | ____ Other (Specify) |

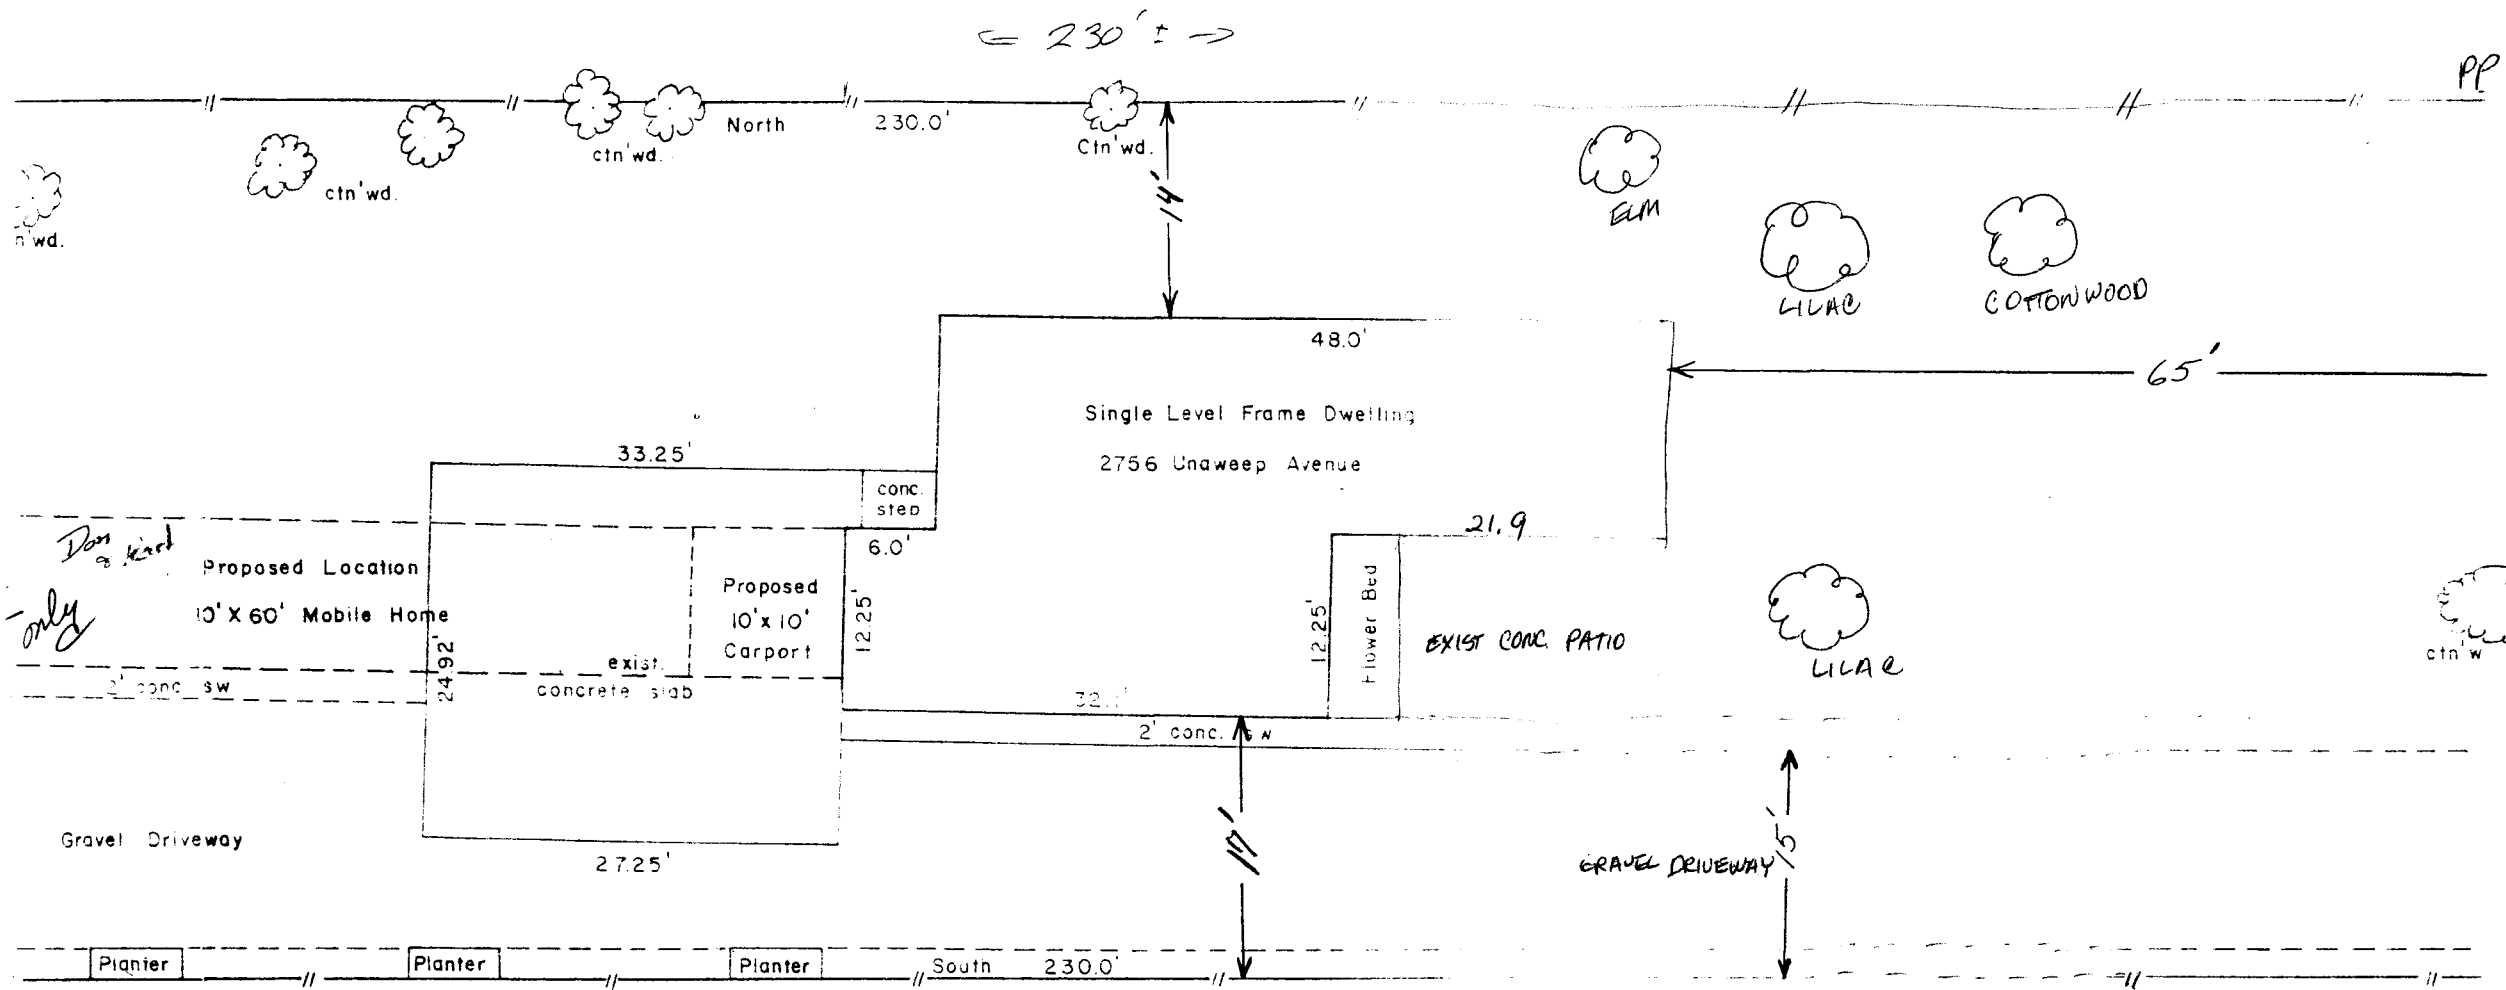

Vivian A. Raff
 2754 1/2 Unawep Ave.

30 days

This site plan of Alvin J. Ricks was approved and accepted this _____

Utilities Coord. Committee

City Mgr