
Table of Contents

÷

Fil	e	1976-0020						
Da	te	1/19/00 Project Name: Spring Valley						
P r e s e n t	S c n n e d	A few items are denoted with an asterisk (*), which means they are to be scanned for permanent record on the ISYS retrieval system. In some instances, not all entries designated to be scanned are present in the file. There are also documents specific to certain files, not found on the standard list. For this reason, a checklist has been included. Remaining items, (not selected for scanning), will be marked present on the checklist. This index can serve as a quick guide for the contents of each file. Files denoted with (**) are to be located using the ISYS Query System. Planning Clearance will need to be typed in full, as well as other entries such as Ordinances, Resolutions, Board of Appeals, and etc.						
X	X	*Summary Sheet – Table of Contents						
		Application form						
	-	Receipts for fees paid for anything						
		*Submittal checklist						
		*General project report						
		Reduced copy of final plans or drawings						
		Reduction of assessor's map						
		Evidence of title, deeds						
		*Mailing list						
		Public notice cards						
		Record of certified mail						
		Legal description						
		Appraisal of raw land						
		Reduction of any maps – final copy						
		*Final reports for drainage and soils (geotechnical reports)						
	_	Other bound or nonbound reports						
		Traffic studies						
		Individual review comments from agencies						
		*Consolidated review comments list						
		*Petitioner's response to comments						
		*Staff Reports						
		*Planning Commission staff report and exhibits						
L		*City Council staff report and exhibits						
		*Summary sheet of final conditions						
		*Letters and correspondence dated after the date of final approval (pertaining to change in conditions or expiration date)						
	1	DOCUMENTS SPECIFIC TO THIS DEVELOPMENT FILE:						
		DOCUMENTS STECIFIC TO THIS DEVELOT MENT FILE:						
X	X	Follow-Up Form						
X		Douing heets						
X	X	Let n Ronald Rish to David Durant - 3/2/78						
X		Irriga Plan & Profile						
X		Sanita y Sewer Profile						
x		Street Profile						
X	_	Street Plans and Catch Basin Detail						
X		Sanitary Sewer Plan						
A X		Miscellaneous Street Details						
	_							
X		Filing Four Map						
	_							
	_							

ate 📶		Item #	20-76	
etitioner	Perch			
Preli	minary		1	Final
Review Agen	cies Comment	s		ncies Comments
Public Servi	ce Requires	کا ــــــ ۳ ــــــ		
-1 into la	t easemen	. 🖬		
11	cine ()	20		
lant CAST	SIDE TOT		•	
	······································			
		 R	<u></u>	
· <u></u>				· · · · · · · · · · · · · · · · · · ·
		🖪		
· · · · · · · · · · · · · · · · · · ·		() ()	<u> </u>	- <u></u>
				tion Taken
.C. DRANNE	O SIMA	₽96 🗐 P.(<u>AC</u>	tion Taken
.c. <u>Approve</u> .c. <u>Approve</u>		4		
· ··· Maprou	ied 21 Hpt			
Comme	nts		Co	omments
Subject to r	CAUTERO CAS	M7.		
7	V		······································	· · · · · · · · · · · · · · · · · · ·
				<u></u>
	······		——————————————————————————————————————	
<u> </u>				
1920 (1921 (1920) (1920 (192) (1920 (192) (1920 (192) (192) (192)(1920 (192) (1920 (192) (1920 (192) (1920 (192) (1920 (192) (192) (192)(1920 (192) (1920 (192) (192) (192) (192)(192)(192)(192)(192)(192)(1920)(1920)(1920)(1920)(1920)(1920)(1920)(1920)(192)(192)(192)(192)(192)(192)(1			(30) (30) (30) (30) (30) (30) (30)) (20) (20) (20) (20) (20) (20) (20) (20
	ITEM	S REQUIRED	FROM DEVELOR	PER
Check Drainage	Util	ity Agreeme scaping	ent Tit	tle Investigation
	nts Guarante	e Ai	inexation	venants Other (Specify)
	•			

Gcale: 1"= 100' 100' 50' eòo

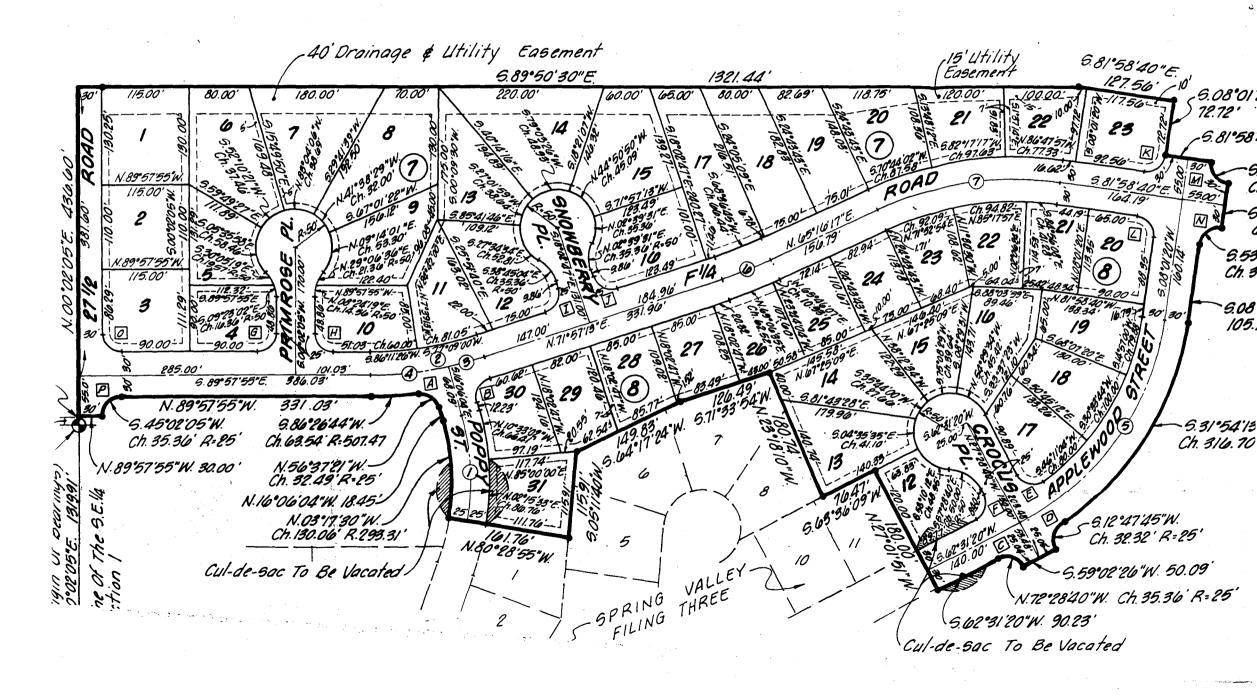



City of Grand Junction. Colorado 81501 250 North Fifth St., 303 243-2633

March 2, 1978

Mr. David C. Durant C. E. Maguire 760 Horizon Drive Grand Junction, CO 81501

Dear Dave:

RECEIVED MESA COUNTY DEVELOPMENT DEPARTMENT

MAR 2 - 19/8

Re: Spring Valley Subdivision-Filing No. 4

The streets and storm sewers constructed in the above subdivision were final inspected on November 28, 1977, and our recent reinspection showed that apparently all deficiencies have been corrected. We have received the required construction test results and they are satisfactory. We have also received the as-built drawings for the improvements.

The one remaining item of unfinished work is to construct the curb, gutter and sidewalk on the east side of 27½ Road to the north end of the filing as shown on your plans. As discussed with you, this work will be completed no later than June 1, 1978.

In light of all the above, and with the understanding the unfinished work mentioned above will be completed as agreed, the street and stormdrainage facilities for Spring Valley Filing No. 4 are accepted by the City, and we are now responsible for the maintenance of those facilities.

Thanks for your cooperation in these matters.

Very truly yours,

Ronald P. Rish, P.E. City Engineer-Public Works

RPR/hm

cc - Paul Barru Del Beaver Doug Cline Pharel Green John Kenney Jim Patterson