



May 11, 1993

Reynolds Polymer Technology, Inc.  
607 Hollingsworth  
Grand Junction, CO 81506

## IMPACT STATEMENT

Reynolds Polymer Technology, Inc., with offices and manufacturing facilities currently located in Santa Ana, California, propose a new 45,171 square foot manufacturing facility for lots 1, 2, and 3 of Block 3 in Foresight Park for Industry, Filing No. Two in Grand Junction, Colorado. The facility will be located on 4.6 acres directly west of the current U.S. Postal Mail Handling Annex, and will front on Burkey Street, Hollingsworth Street and Foresight Circle.

The building will provide for approximately 39,000 square feet of manufacturing space on one level, as well as an office area occupying approximately 6,200 square feet on two levels.

Employee and service traffic will enter parking and truck delivery drives from Foresight Circle, while executive and guest parking will enter from Hollingsworth Street. Thirty-six (36) parking spaces (including two van handicap spaces) will be provided along the employee/service drive to the west. Twelve (12) spaces (including one van handicap space) will be provided in the east parking area.

The building will have concrete walks and loading areas to the north and west, and concrete entrance walks to the east. The remaining portion of the site, not covered with building and hard surface, will be landscaped, combining rolling, grass-covered berms, deciduous and coniferous trees, and low shrubs at the building edge and surrounding a free-standing sign at the building entrance drive.

The exterior building materials will include a combination of painted concrete masonry and prefinished architectural grade metal siding. Large windows will break the wall surface on all sides of the building and will contribute natural light to both office and manufacturing areas.

The building and site will complement the Mail Handling Annex and will contribute to the well-established, planned development of Foresight Park.

# REVIEW COMMENTS

Page 1 of 4

**FILE NO. #56-93**

**TITLE HEADING:** Site Plan Review - Reynolds  
Polymer Technology

**LOCATION:** 607 Hollingsworth

**PETITIONER:** Reynolds Polymer

**PETITIONER'S ADDRESS/TELEPHONE:** 311 E Alton  
Santa Ana, CA

**PETITIONER'S REPRESENTATIVE:** Rob Jenkins  
Chamberlin Architects

**STAFF REPRESENTATIVE:** Kathy Portner

**NOTE: WRITTEN RESPONSE BY THE PETITIONER TO THE REVIEW COMMENTS IS  
REQUIRED ON OR BEFORE 5:00 P.M., JUNE 1, 1993.**

---

**CITY DEVELOPMENT ENGINEER**  
**Gerald Williams**

**5/19/93**  
**244-1591**

---

See attached comments (3 pages) and red-lined plans.

**COMMUNITY DEVELOPMENT**  
**Kathy Portner**

**5/20/93**  
**244-1446**

---

The site plan looks good. The development will be a nice addition to Foresight Park.

Approval of the Architectural Control Committee is required prior to issuance of a Planning Clearance.

Other review comments must be addressed.

**CITY POLICE DEPARTMENT**  
**Mark Angelo**

**5/18/93**  
**244-3587**

---

Along north side, Austrian pines need to spaced apart more. Along northeast side, Austrian pines closest to building need to be removed; same with southwest side. Replace with a dwarf shrub or if you want to keep a "tree type" at these location, replace with the Bechtel crab tree. Want to eliminate hiding places near building and also want to increase visibility of the building for patrol drive-bys. What type of lighting is proposed for the parking lot and for the exterior of the building? recommend an exterior type light over every access door. What type of exterior doors are you proposing? Is the address to the building going to be visible from the street? Also - do not use Mugo Pines near building, instead use a low ground cover juniper; example: Arcadia Juniper or Buffalo Juniper.

REVIEW COMMENTS  
ON  
REYNOLDS POLYMER TECHNOLOGY, INC.  
5/19/93

C1.2

1. Driveways must be 8" thick per City Standards, not 6".
2. Per City Code, a minimum of 25 feet traffic area is required behind 90° parking. The east parking lot does not conform.
3. Some of the section views are incorrect in location or direction of view.

C1.3

1. A few elevations are missing as noted on the attached plans. These must be provided, along with slopes, grade breaks, swales, etc.
2. Is erosion protection provided at the west entrance to the detention pond?
3. The pond bottom is too flat! Criteria requires a minimum of 2% to prevent bogs from irrigation water, although 1% may be acceptable. However, less than 0.6% is provided on the east side, and the main basin is flat, with no slope at all to the outlet. The volume provided may be more than adequate to meet drainage requirements, and slopes could be somewhat steeper.
4. Manhole rim elevations and invert elevations must be provided.
5. Show in plan view all utilities parallel, crossing, and near the proposed basin drain pipe. Provide a profile of the line, showing all conflicting utilities. With the information given, the pipe slope appears to be 0.5%, not 1.0%. The 12 inch pipe would still be adequate.
6. The trench drain outlet pipe lacks invert, cover, and pipe class information. It also appears that it will be very flat. Will it work?
7. What class of pipe shall the concrete culvert be? It has only 1.0 foot of finish cover, and much less during construction. Also, what are the invert elevations?

Drainage Report

1. The report mentions a 12" concrete pipe for the pond outlet. The drawings specify PVC. Which is correct?
2. The Tc values seem very high for the developed conditions. Please provide calculations and support data.
3. The detention pond volumes are based upon a preliminary grading plan, which apparently started at elevation 69. The information should match the final basin configuration and elevations, which may change again based upon above comments.

MEMORANDUM

TO: File #56-93  
FROM: Kathy Portner *KP*  
DATE: June 11, 1993

The petitioners did respond to comments satisfactorily. The revised plans were accepted by Don Newton on June 11, 1993 and are on file in the Public Works Department.

---

June 14, 1993


Mr. Rob Jenkins  
Chamberlain Architects  
437 Main Street  
Grand Junction, CO 81501

RE: REYNOLDS POLYNER TECHNOLOGY, INC.

Dear Rob,

I have reviewed the Contract Documents on the above project for the architectural control committee of Foresight Park. Acting as the architectural consultant for the committee, I approve the submittal. Everything appears to be in compliance with the Development Standards of Foresight Park.


Sincerely,

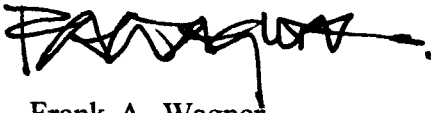


Frank A. Wagner  
Architect

FAW/sb

xc: Mr. Barney Barnett  
Valley Insurance

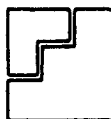

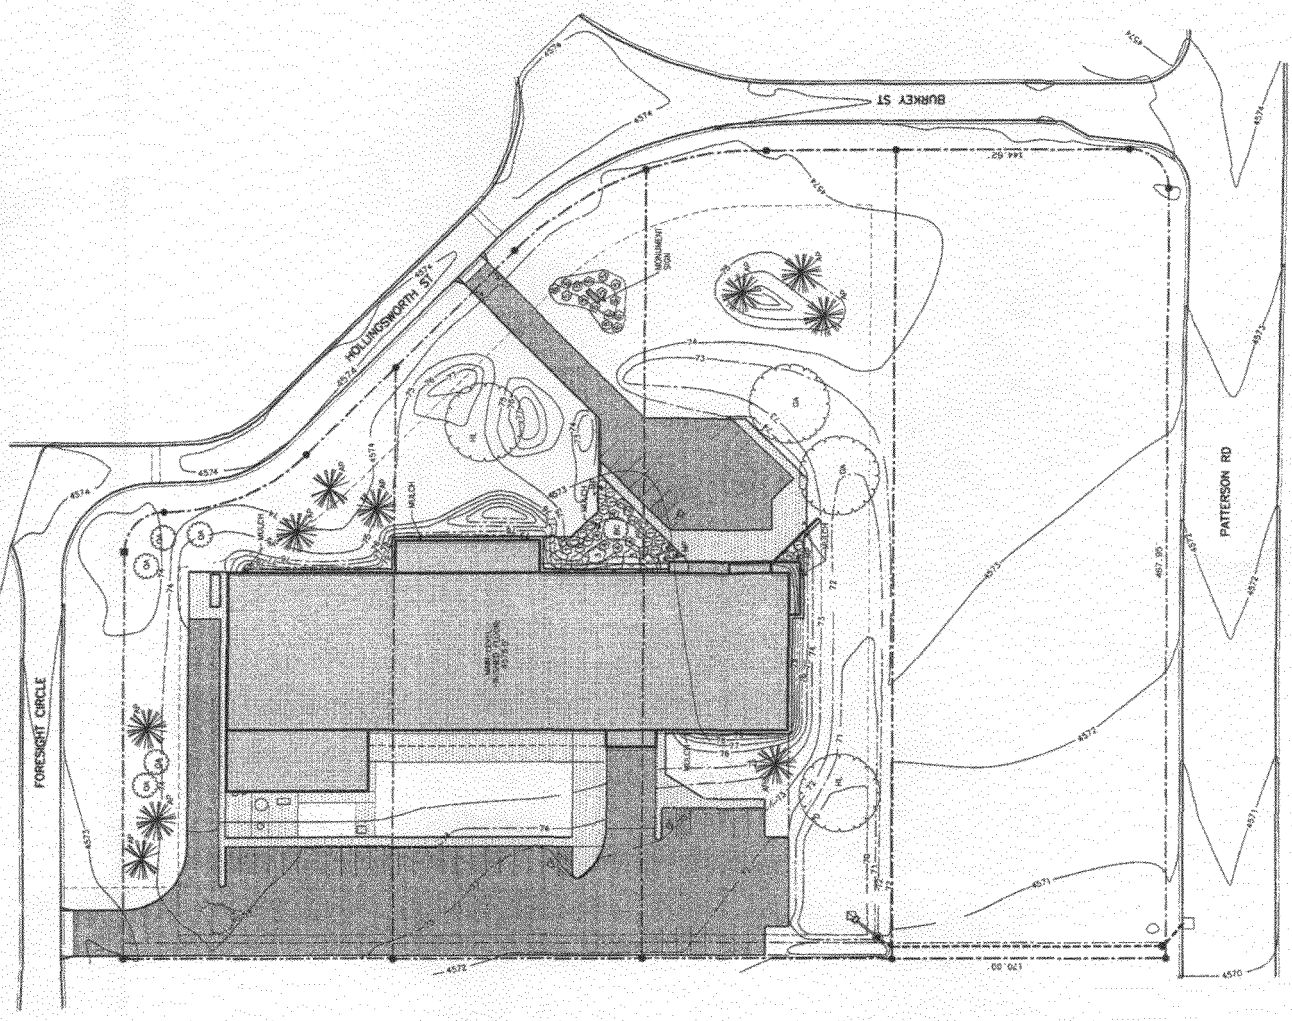


LANDSCAPE PLAN  
 1" = 40'-0"

LANDSCAPE SCHEDULE

| CODE | QUANT | COMMON NAME             | BOTANICAL NAME                               | SIZE        | HABIT                 |
|------|-------|-------------------------|--|-------------|-----------------------|
| AP   | 10    | AUSTRIAN PINE           | PRINUS NIDDA                                 | 8' TALL     | 50' HIGH, 30' SPREAD  |
| DA   | 5     | CHAMPAIGN WITCH         | POPULUS TREMULOIDES                          | 1.5 CALIPER | 40' HIGH, 15' SPREAD  |
| HL   | 2     | SHADBLASTER HONEYLOCUST | GLUCOSTEA TRIMACANTHOS BIFLORA 'SHADBLASTER' | 1.5 CALIPER | 30' HIGH, 50' SPREAD  |
| DA   | 2     | GREEN OSH               | FRAXINUS FRAXINOSIFOLIA LANCEOLATA           | 1.5 CALIPER | 40' HIGH, 30' SPREAD  |
| BC   | 1     | BROOKEL OMB             | MAULUS SPA. BROCKEL                          | 1.5 CALIPER |                       |
| MP   | 4     | MALD PINE               | PRINUS NERIO MARIUS                          | 5 DAL       | LOW VARIANTE          |
|      | 1     | BLUE MIST SPRUCE        | CARYOPHTERIS A. CLAVARINENSIS                | 5 DAL       | 3' HIGH, 3' SPREAD    |
|      | 5     | WEDDERSIA ABBOTSFORD    |  | 5 DAL       | 3' HIGH, 3' SPREAD    |
|      | 3     | CORNALBERT, HANCOCK     | SYMPLOCARPUS CHEHAUTI                        | 5 DAL       | 3' HIGH, 8-10' SPREAD |
|      | 4     | SEADIA HERRING          |  | 5 DAL       | 12' HIGH              |
|      | 5     | COTONWOODER, LOWFAST    | CONFIRMATER DAMAR LOWFAST                    | 5 DAL       | 12' HIGH, 10' SPREAD  |
|      | 6     | SANDWICH-SUMMER         | CERASTIUM THOMASII                           | 5 DAL       | 8' HIGH, SPREADING    |



GENERAL NOTES

1. BARK MULCH, 2" DEEP STRIP ADJACENT TO BUILDING ON SOUTH AND EAST, AND AS NOTED ON WEST AND NORTH.
2. METAL EDGING TO HOLD MULCH, TYPICAL.

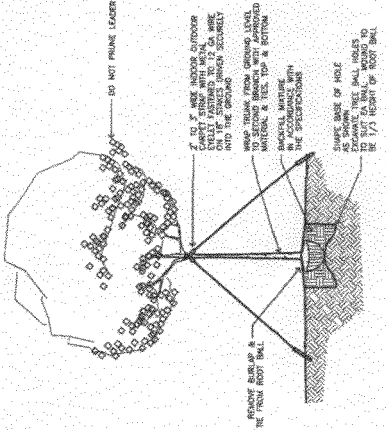


2 TREE PLANTING & GUYING DETAIL  
 C1.4




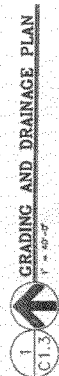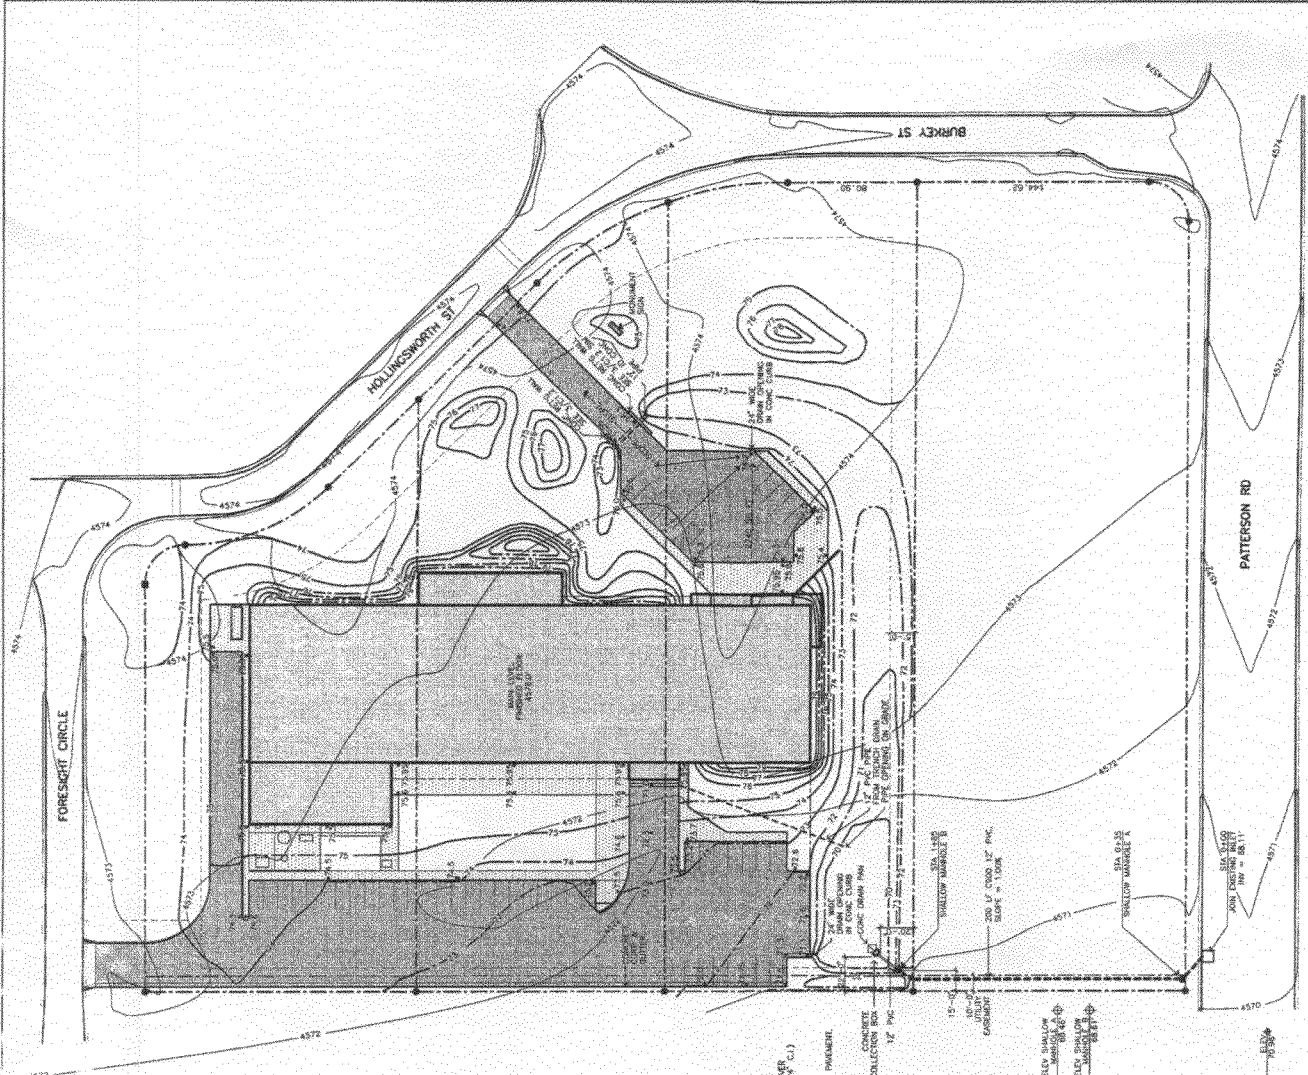


EXISTING CONTOUR: 4575  
 NEW CONTOUR: 4575  
 SPOT ELEVATION: 4575.3

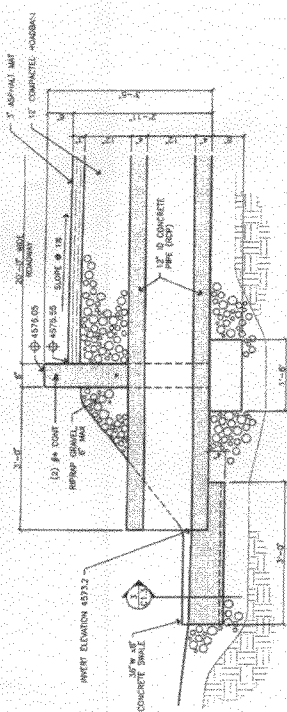

1 CONCRETE PIPE & CURB INLET @ EAST DRIVE  
 C1.3 3/4" = 1'-0"

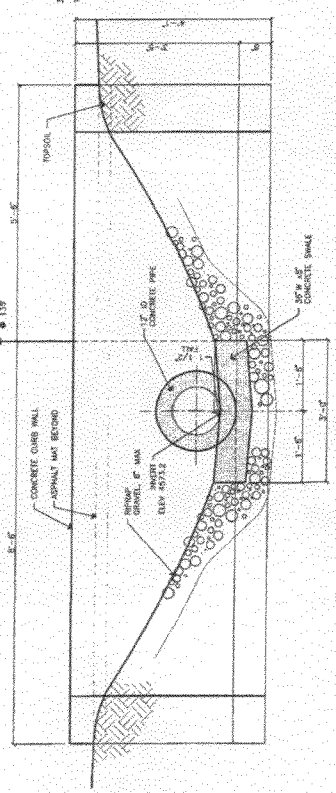


2 CONCRETE SWALE & PIPE DETAIL @ EAST DRIVE  
 C1.3 3/4" = 1'-0"

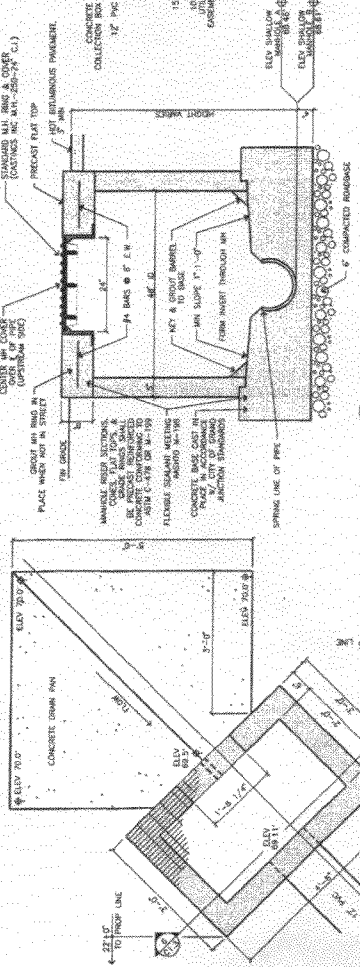


3 COLLECTION BOX PLAN  
 C1.3 3/4" = 1'-0"

4 STANDARD SHALLOW MANHOLE  
 C1.3 3/4" = 1'-0"

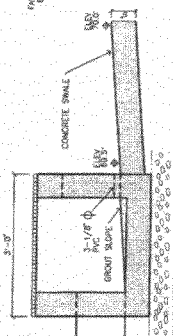


5 COLLECTION BOX SECTION  
 C1.3 3/4" = 1'-0"

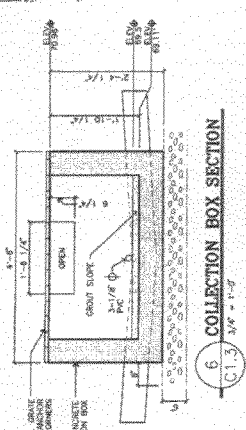

6 STANDARD SHALLOW MANHOLE SECTION  
 C1.3 3/4" = 1'-0"



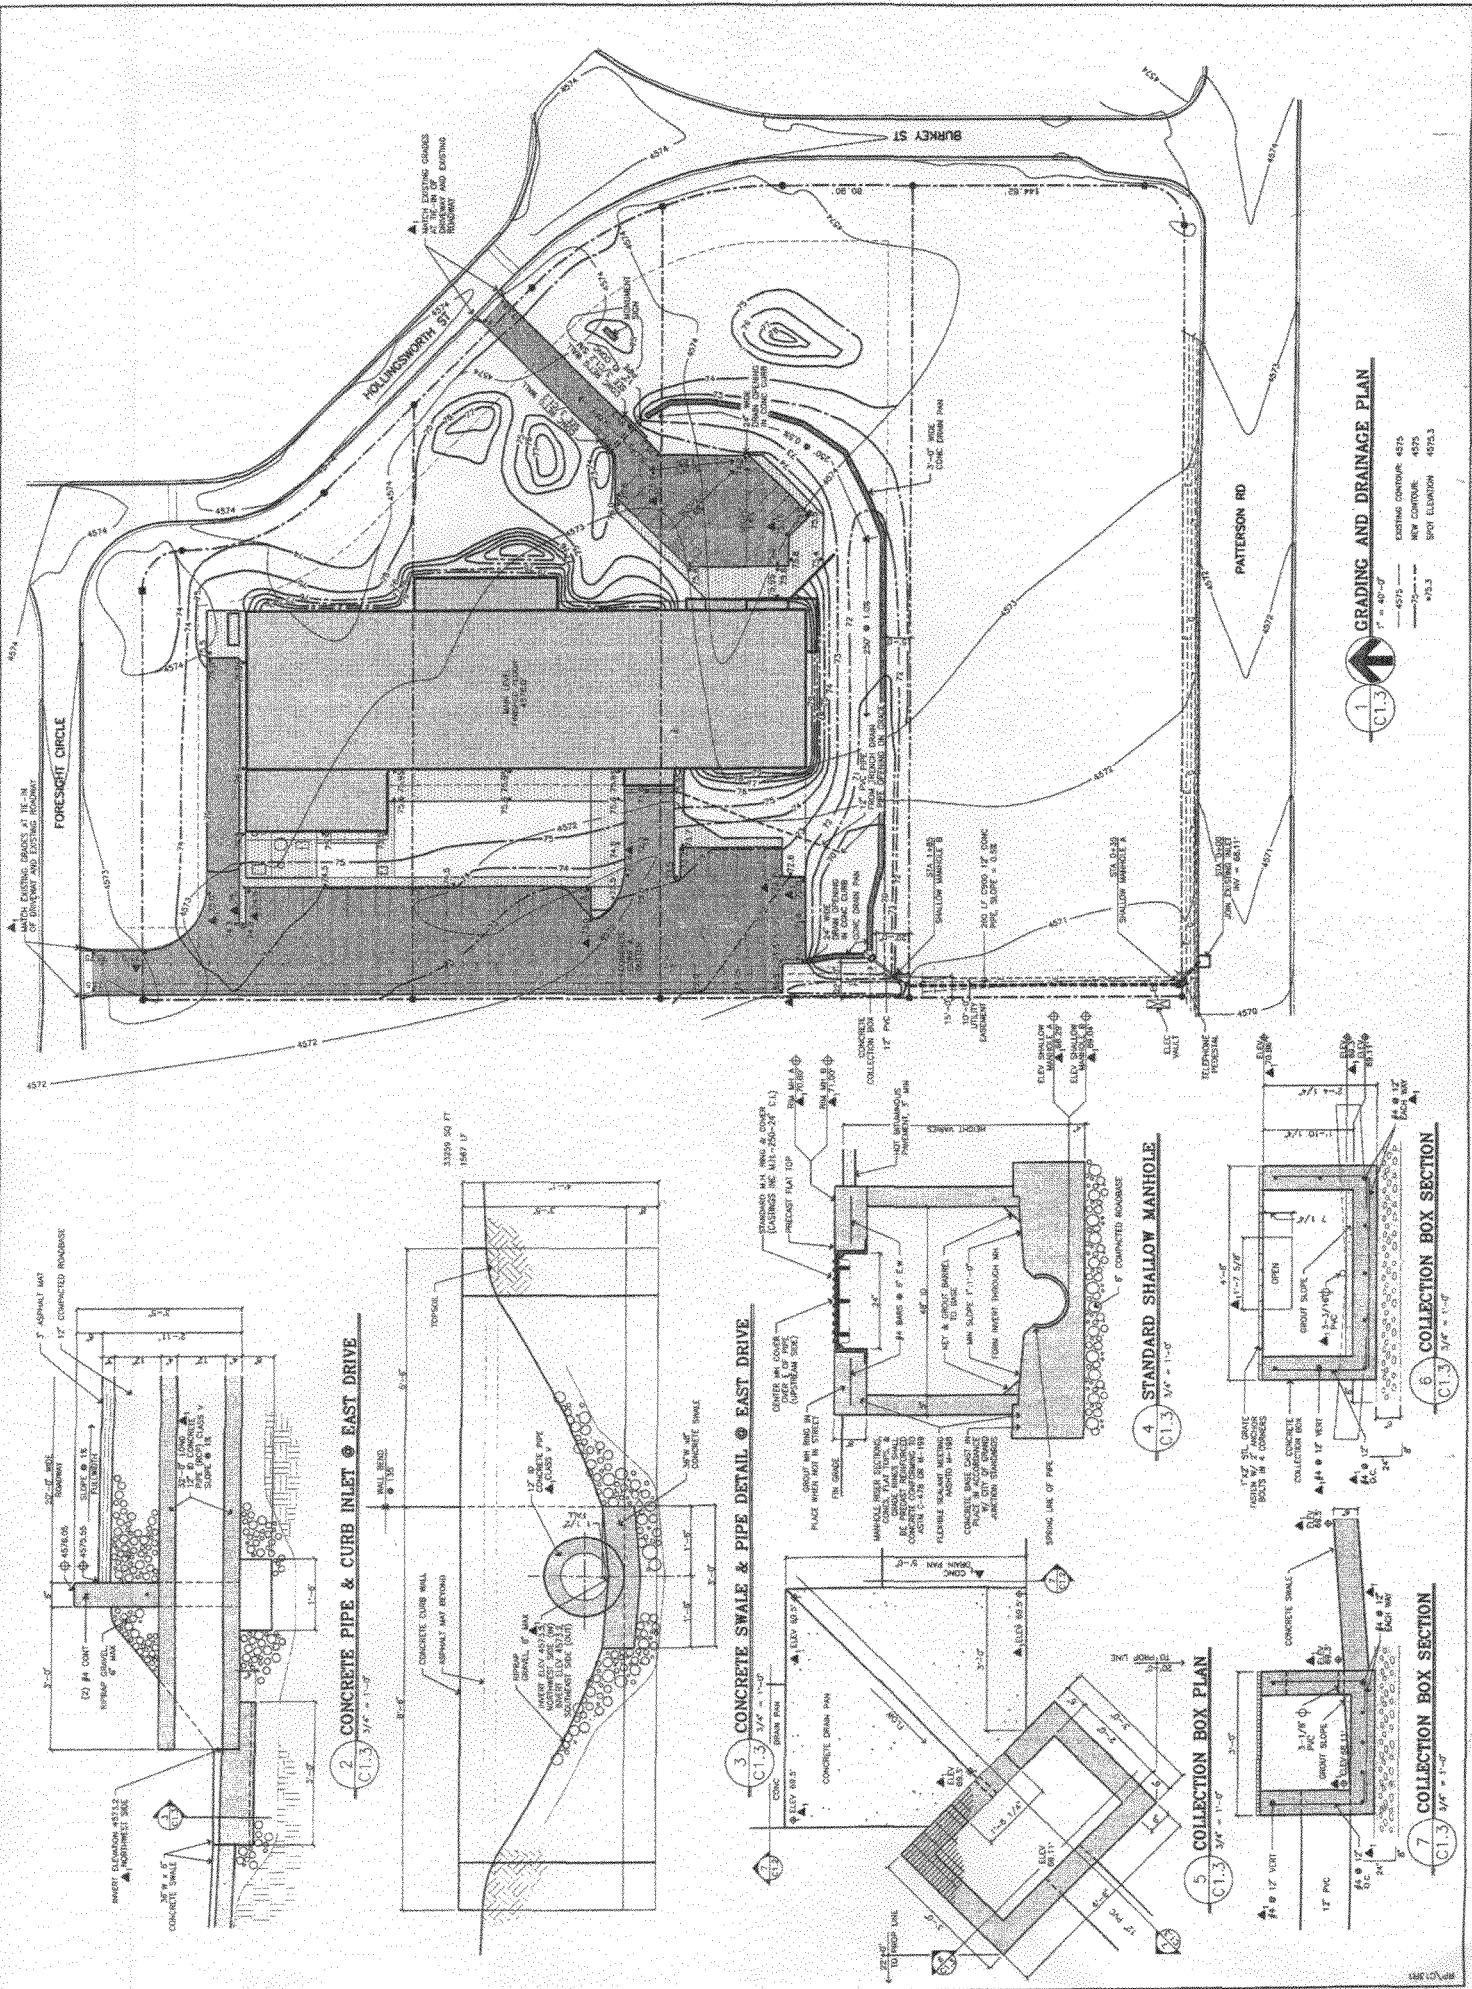

**1 GRADING AND DRAINAGE PLAN**  
 1" = 40'-0"  
 EXISTING CONTOUR: 4575  
 NEW CONTOUR: 4575  
 SPOT ELEVATION: 4570.3

**2 CONCRETE PIPE & CURB INLET @ EAST DRIVE**  
 C1.3 3/4" = 1'-0"



**3 CONCRETE SWALE & PIPE DETAIL @ EAST DRIVE**  
 C1.3 3/4" = 1'-0"

**4 STANDARD SHALLOW MANHOLE**  
 C1.3 3/4" = 1'-0"








**5 COLLECTION BOX PLAN**  
 C1.3 3/4" = 1'-0"

**7 COLLECTION BOX SECTION**  
 C1.3 3/4" = 1'-0"

**6 COLLECTION BOX SECTION**  
 C1.3 3/4" = 1'-0"

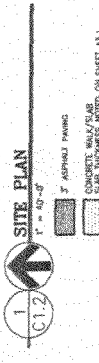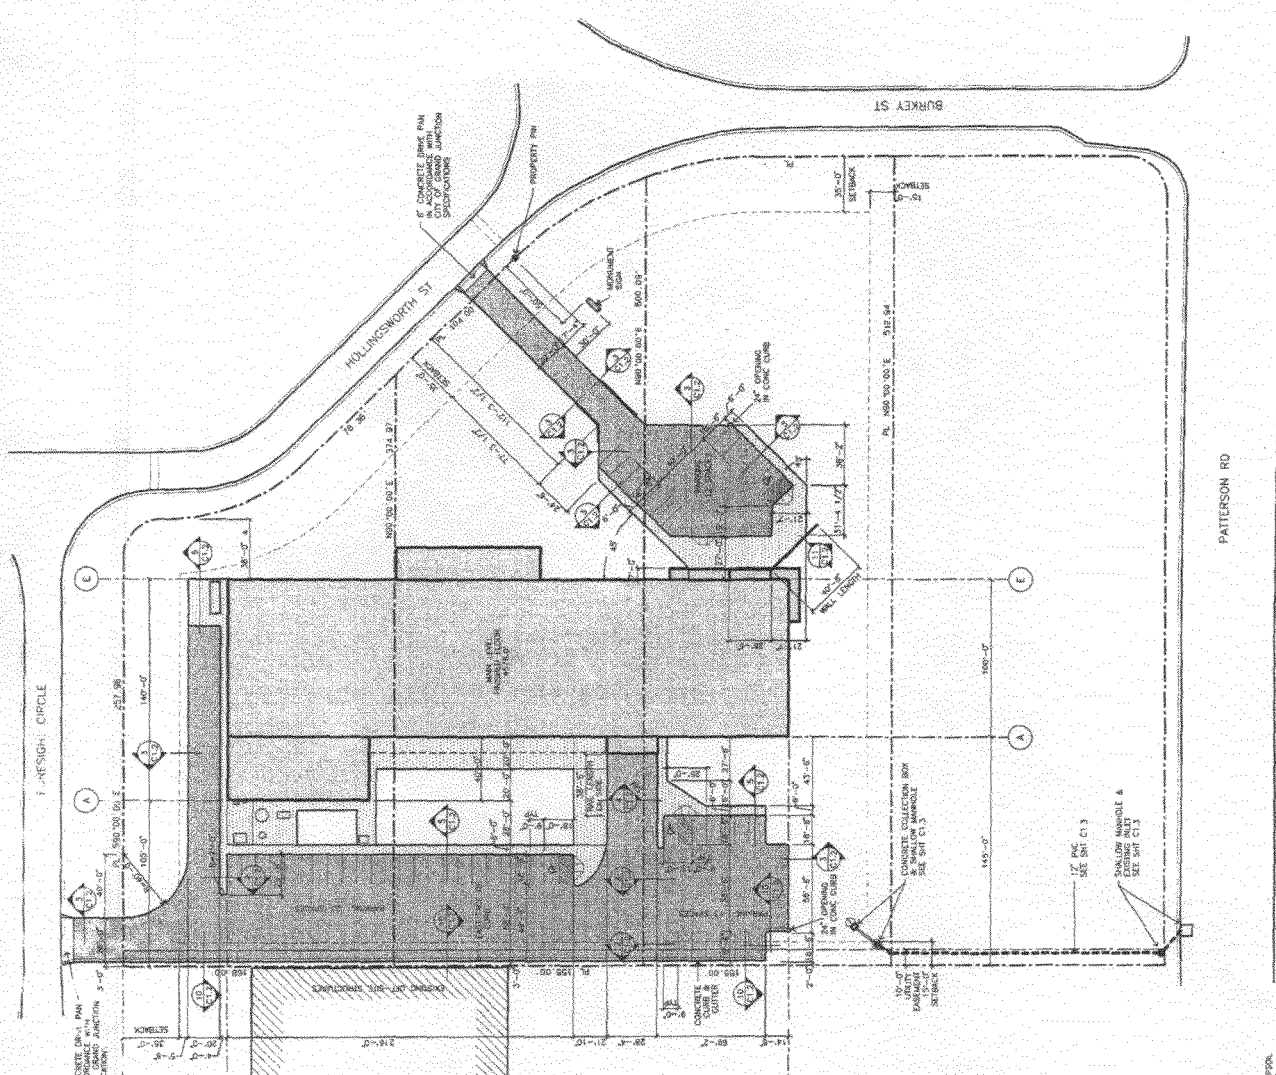


3" ASPHALT PAVING  
 CONCRETE WALK/SLAB  
 SLAB THICKNESS NOTED ON SHEET A3.1

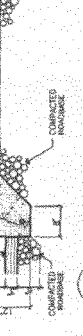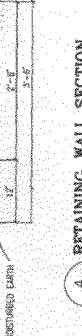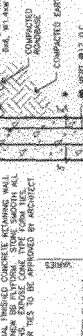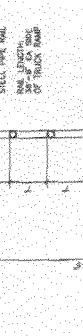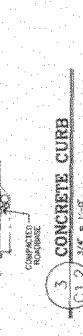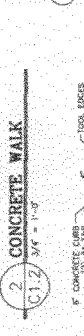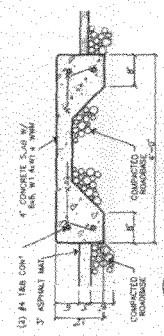


3" ASPHALT PAVING  
 CONCRETE WALK/SLAB  
 SLAB THICKNESS NOTED ON SHEET A3.1



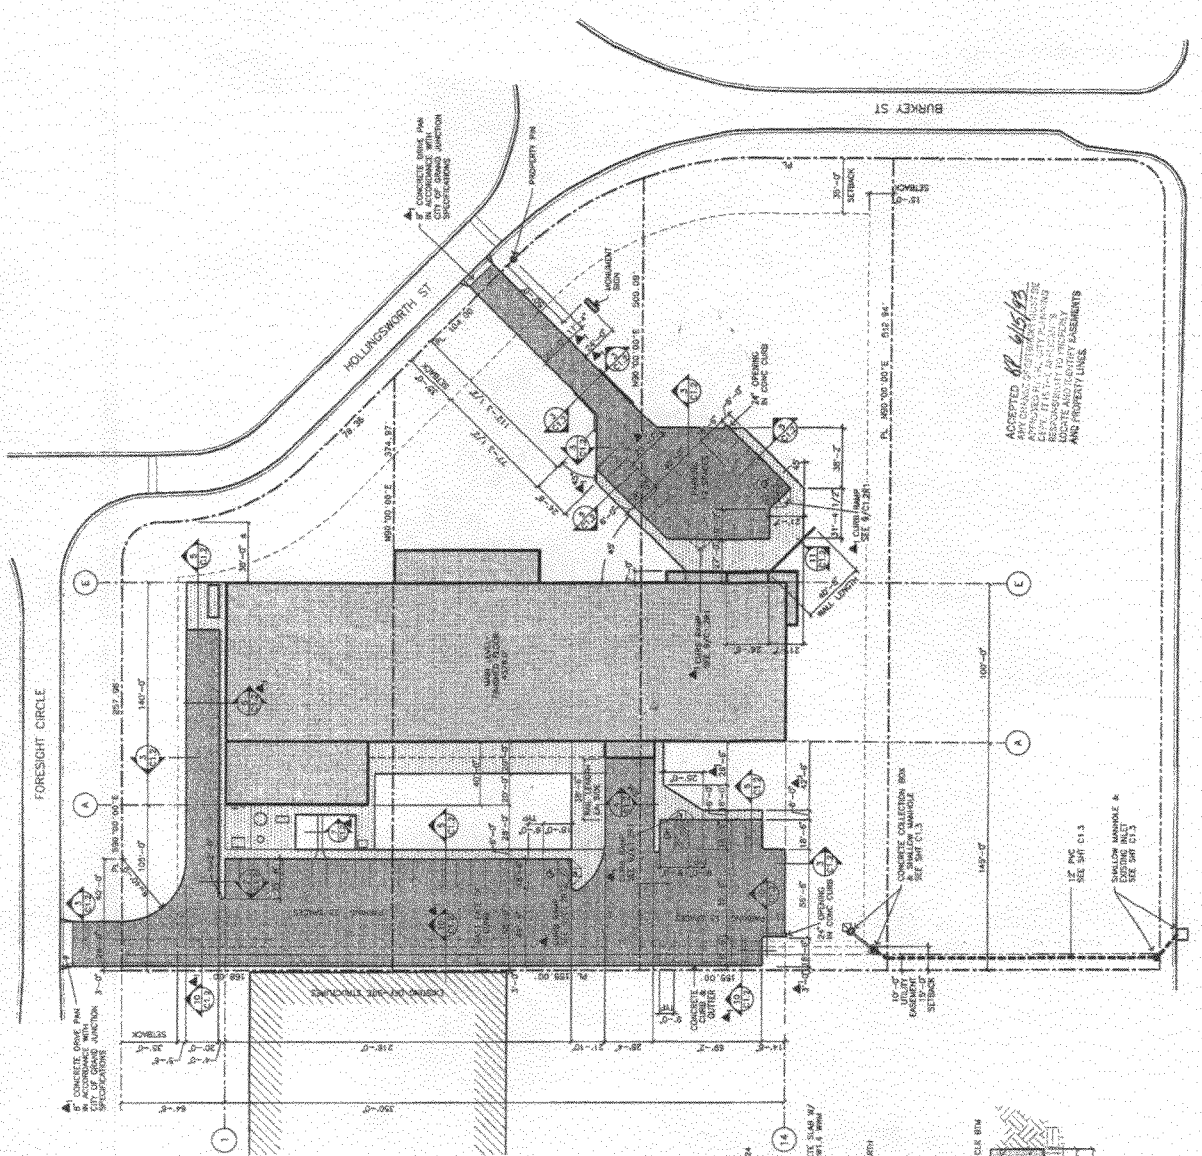


ACCEPTED *RP 6/15/93*  
 THE GRAND JUNCTION CITY ENGINEER HAS REVIEWED THIS PLAN AND APPROVES IT FOR CONSTRUCTION IN ACCORDANCE WITH THE CITY ENGINEER'S OFFICE RECORD DRAWINGS AND PROJECT EASEMENTS.

*Revised 6/15/93*

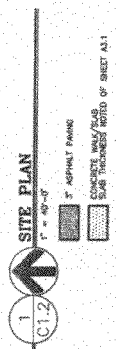

**SITE PLAN**  
 1/4" = 1'-0"

CONCRETE WALK/SLAB  
 SLAB THICKNESS NOTED ON SHEET A1.1

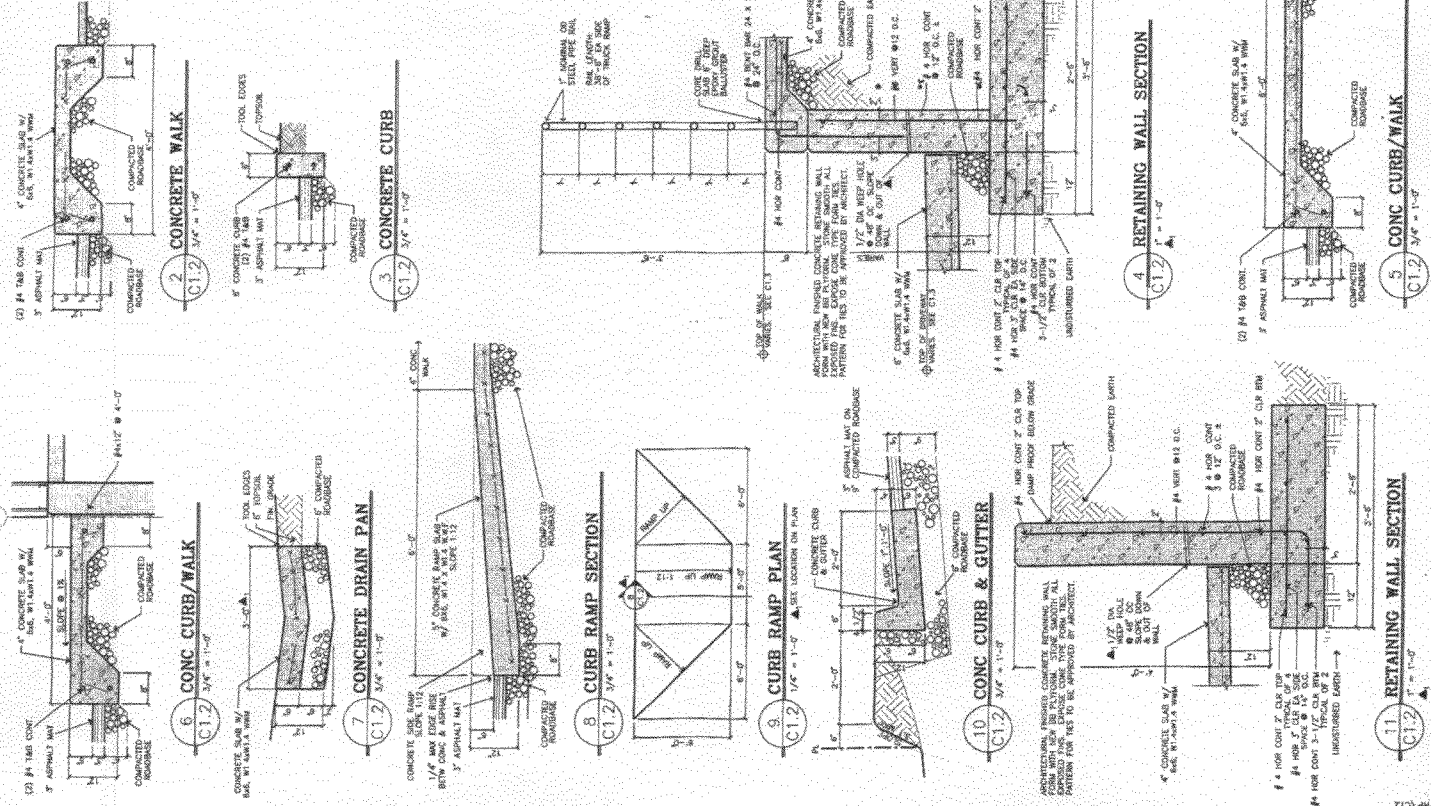

RE C1.2