


SPECIAL SANITARY SEWER DIST. 13

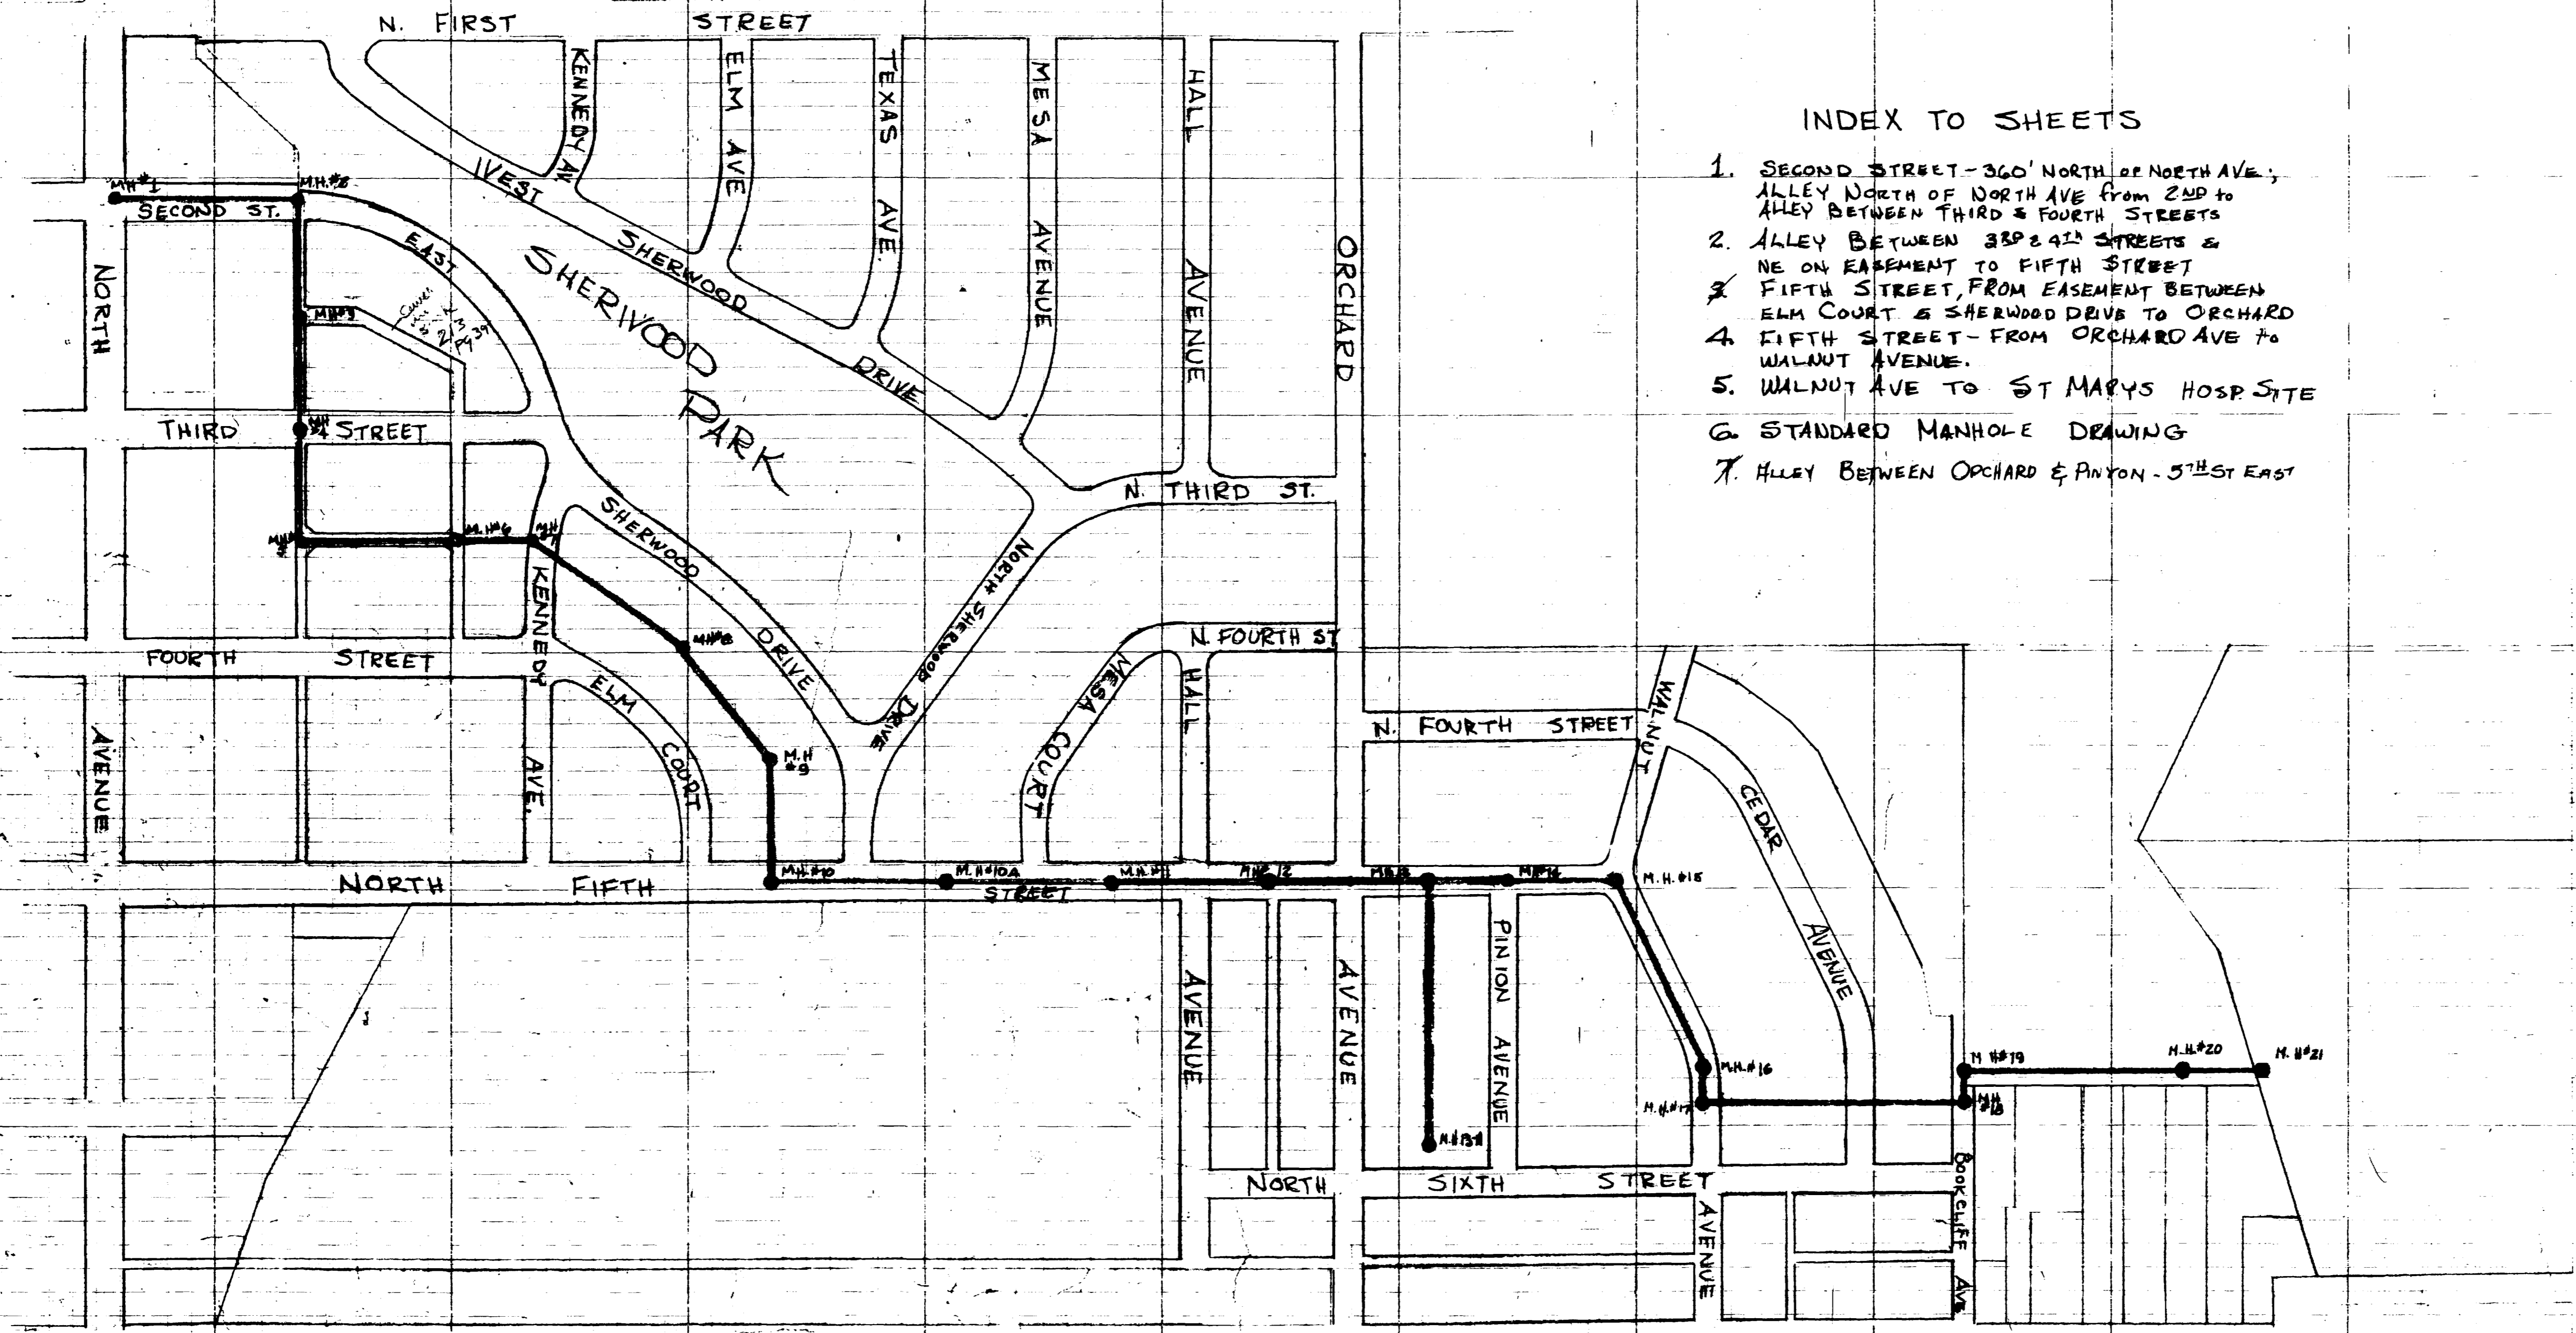


INDEX TO SHEETS

1. SECOND STREET - 360' NORTH OF NORTH AVE., ALLEY NORTH OF NORTH AVE FROM 2ND TO ALLEY BETWEEN THIRD & FOURTH STREETS
2. ALLEY BETWEEN 3RD & 4TH STREETS & NE ON EASEMENT TO FIFTH STREET
3. FIFTH STREET, FROM EASEMENT BETWEEN ELM COURT & SHERWOOD DRIVE TO ORCHARD
4. FIFTH STREET - FROM ORCHARD AVE TO WALNUT AVENUE.
5. WALNUT AVE TO ST MARYS HOSP SITE
6. STANDARD MANHOLE DRAWING
7. ALLEY BETWEEN ORCHARD & PINYON - 5TH ST EAST

Sewer Book 178

AS CONSTRUCTED

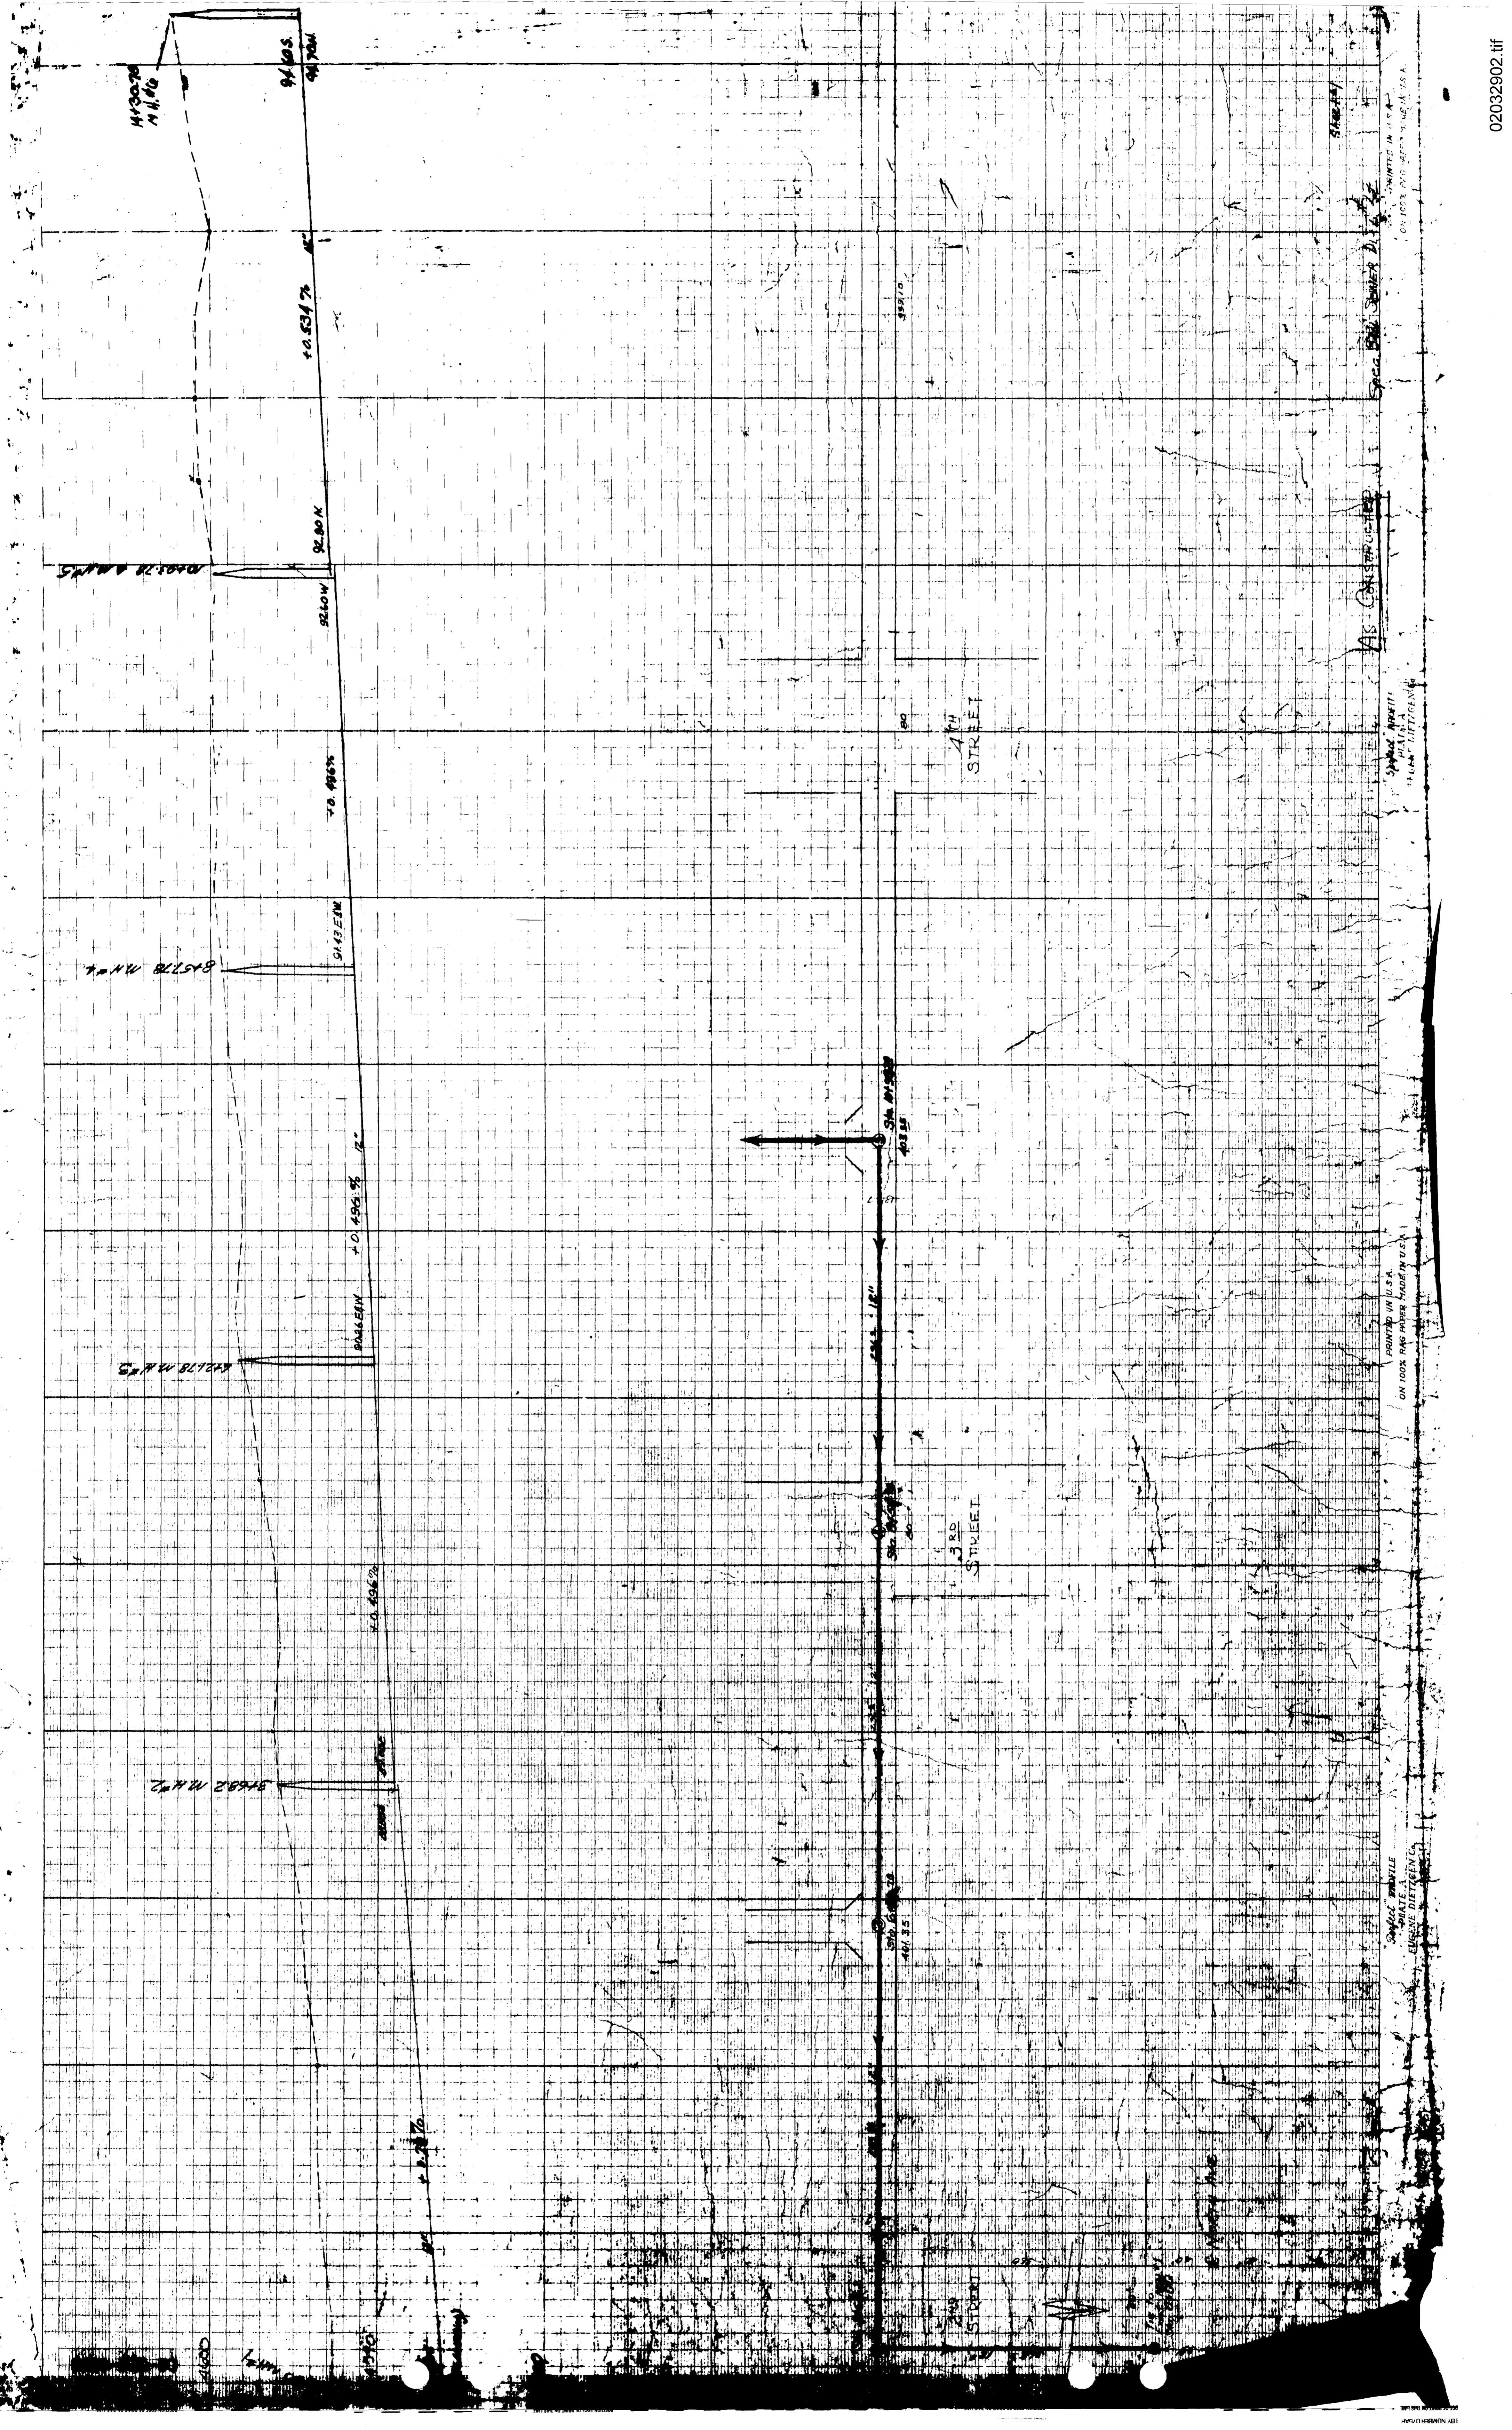

3768.2 M.H. 1/2

3768.2 M.H. 1/2

7.0

10.4965

51.15 E W

70.4965

92.60 W

10.6547

91.70 M

14.3078 M H. 1/2

3RD STREET

4TH STREET

PRINTED IN U.S.A.
ON 100% REC. PAPER MANUFACTURED IN U.S.A.


3768.2 M.H. 1/2
ENGINEER-DIETZEN CO.

PRINTED IN U.S.A.
ON 100% REC. PAPER MANUFACTURED IN U.S.A.

3768.2 M.H. 1/2
ENGINEER-DIETZEN CO.

PRINTED IN U.S.A.
ON 100% REC. PAPER MANUFACTURED IN U.S.A.

3768.2 M.H. 1/2
ENGINEER-DIETZEN CO.

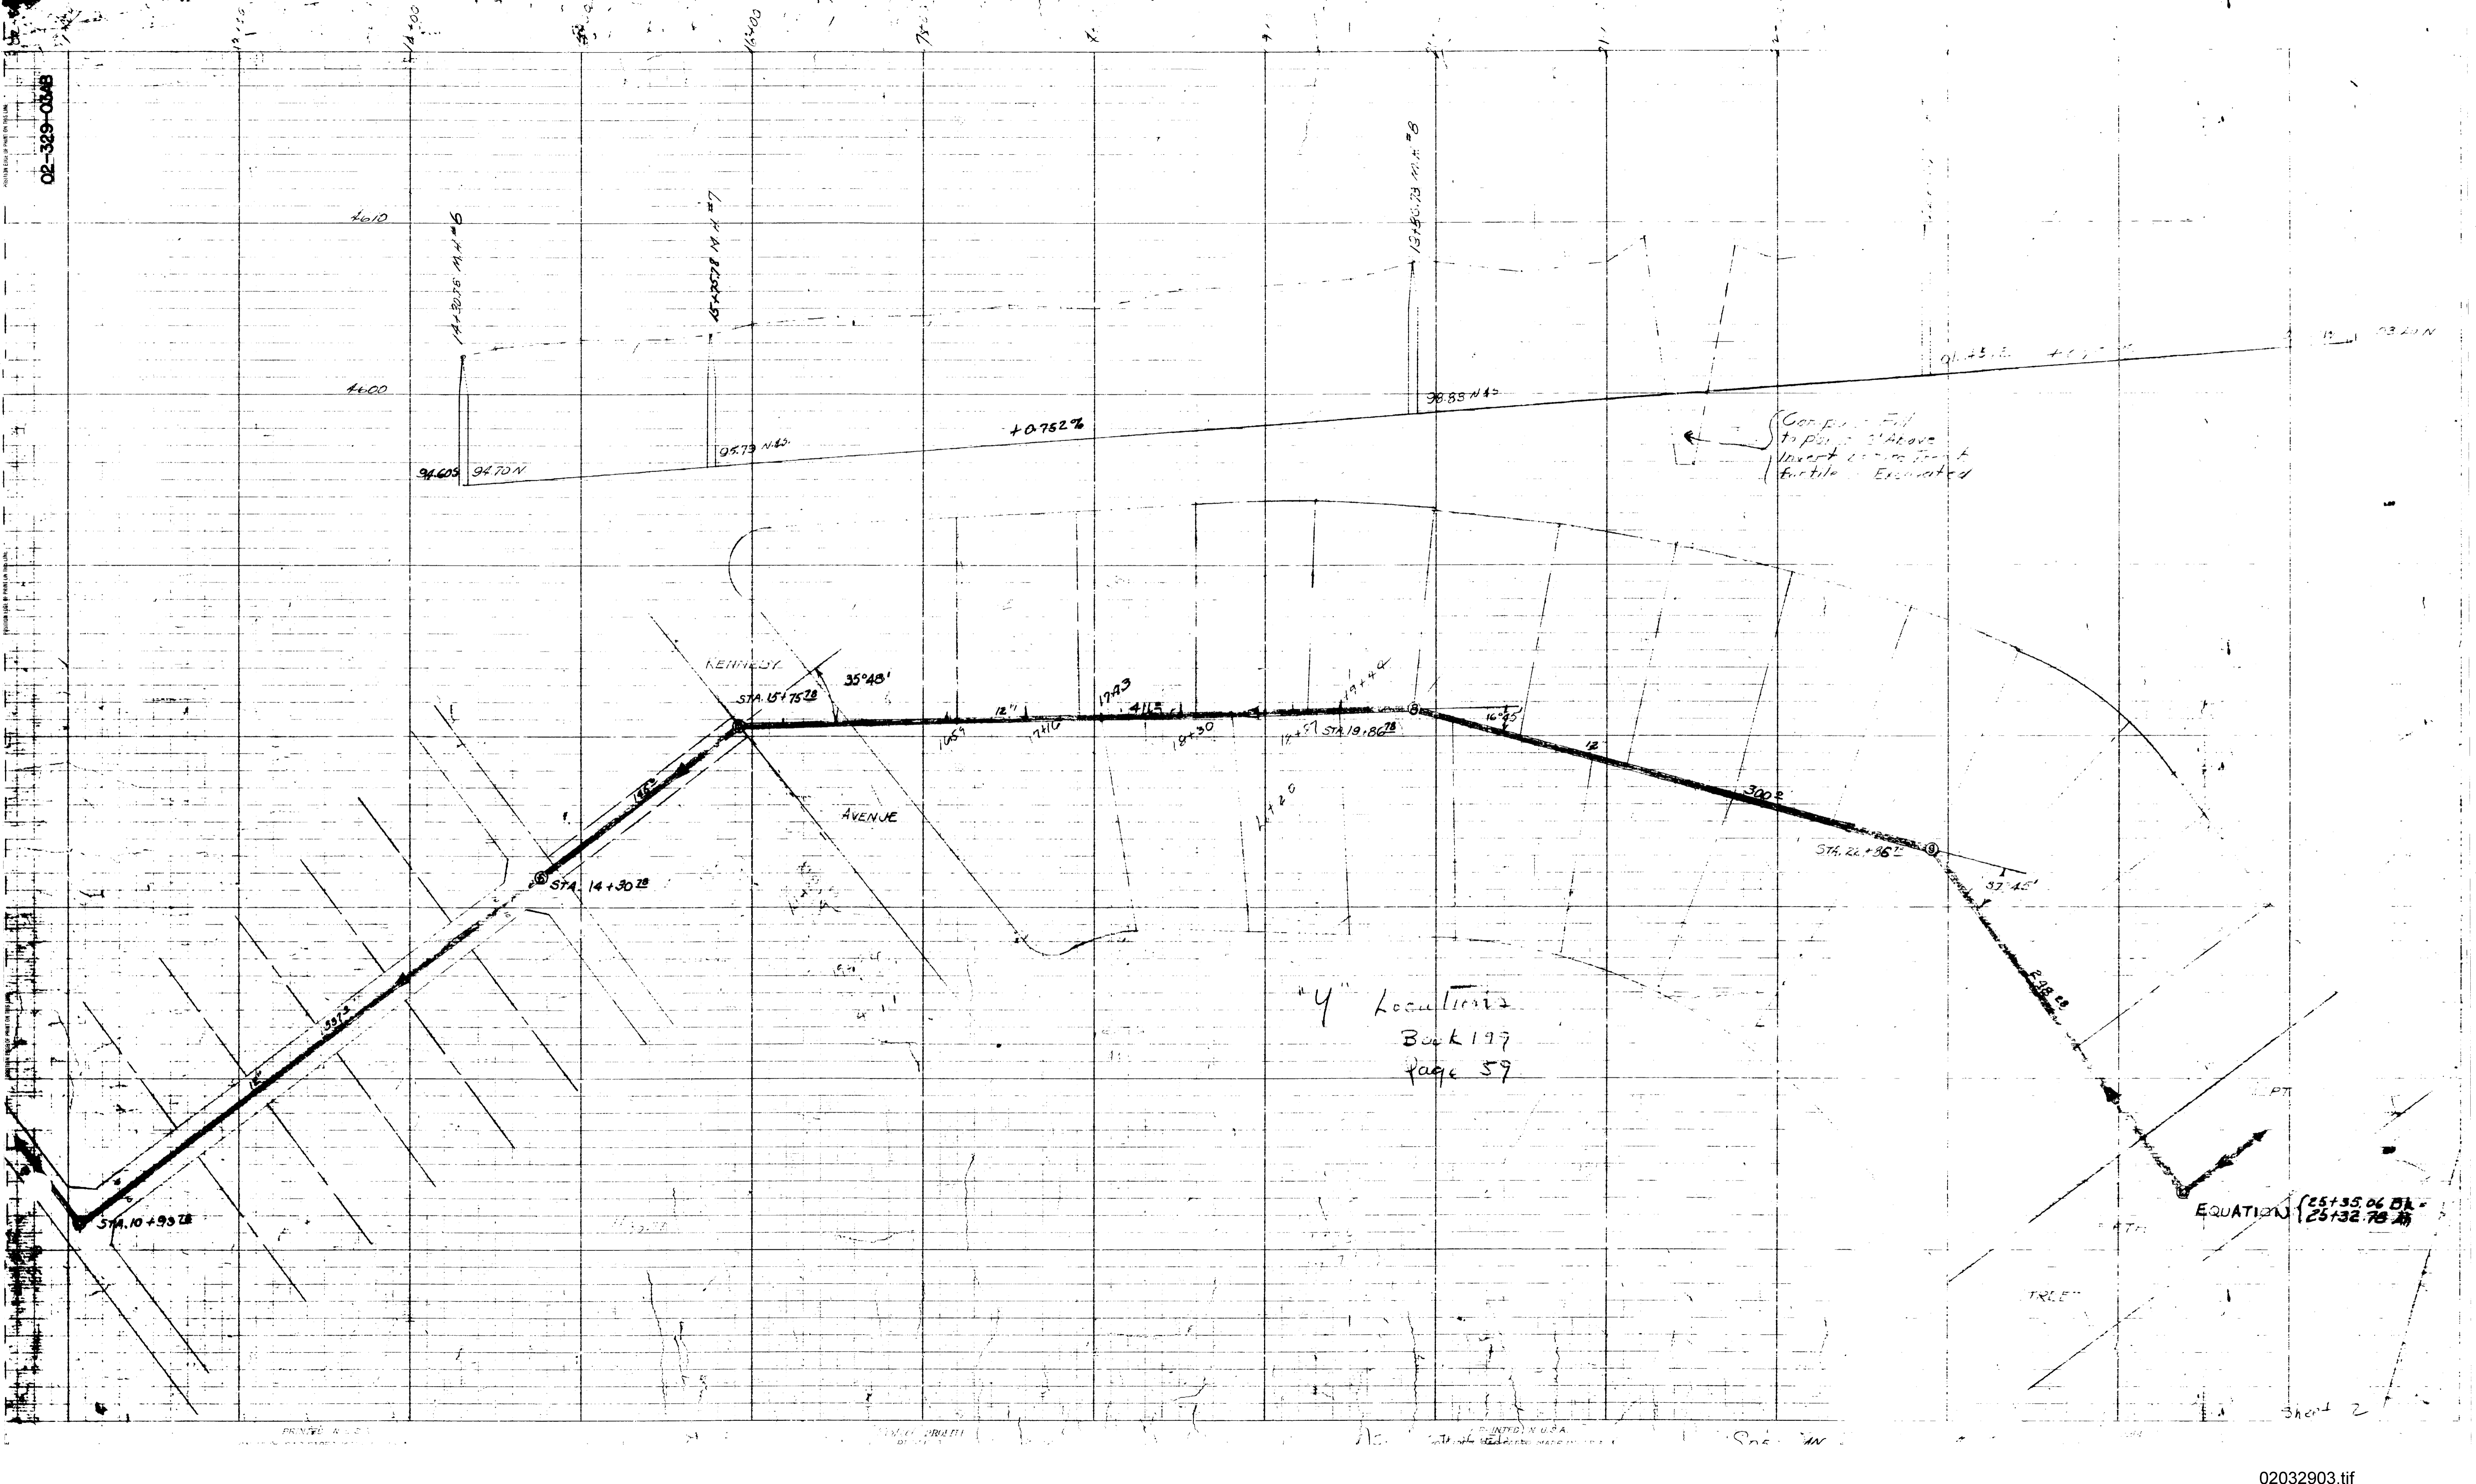

1400

1400

94.605 94.70N

95.73 N40

+0.752%

96.85 N40

91.43 E. +0.75%

91.43 E. +0.75%

KENNESSET AVENUE
35°48'
STA 15+75.28

STA 14+30.28

STA 10+99.28

1793



STA 19+86.28

STA 22+86.28

37°45'

EQUATION (25+35.06 DL - 25+32.78)

"4" Location Book 197 Page 59

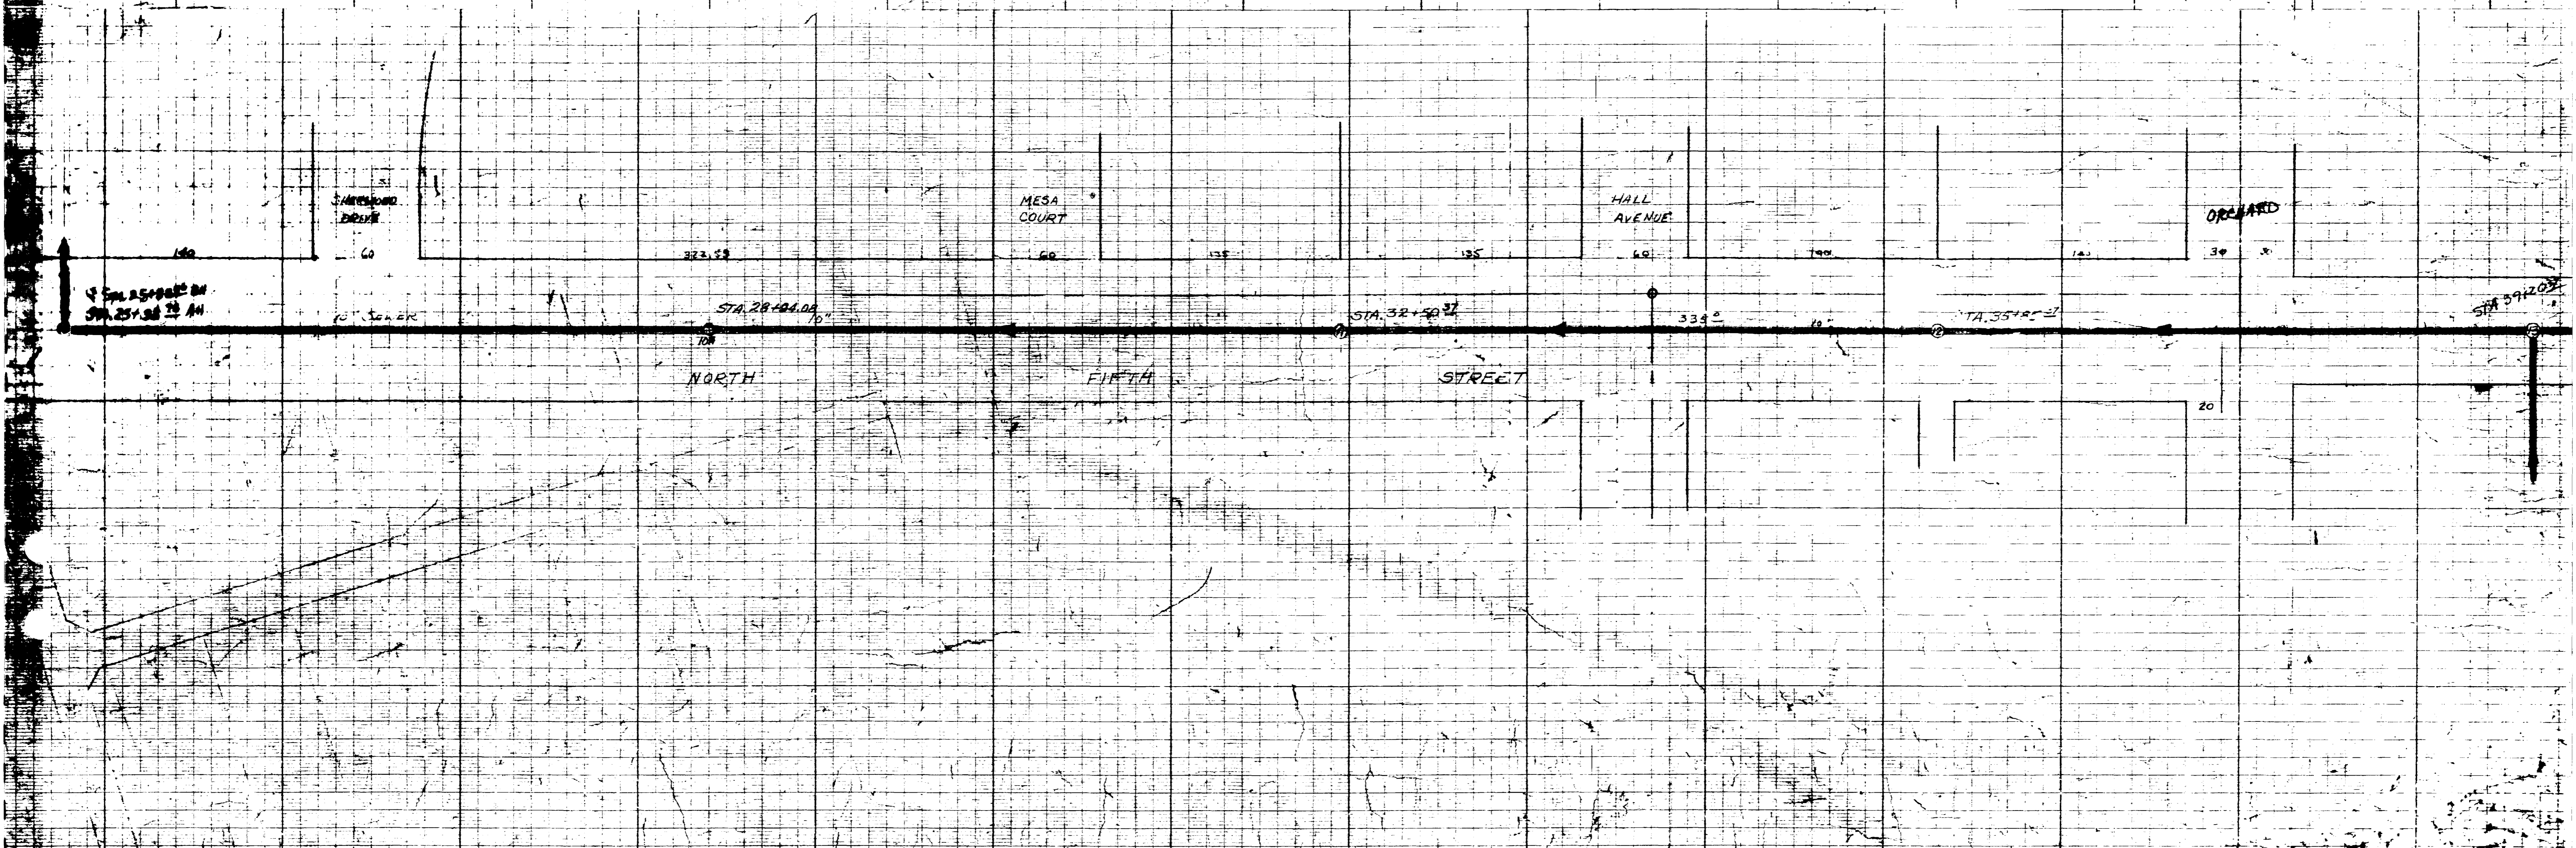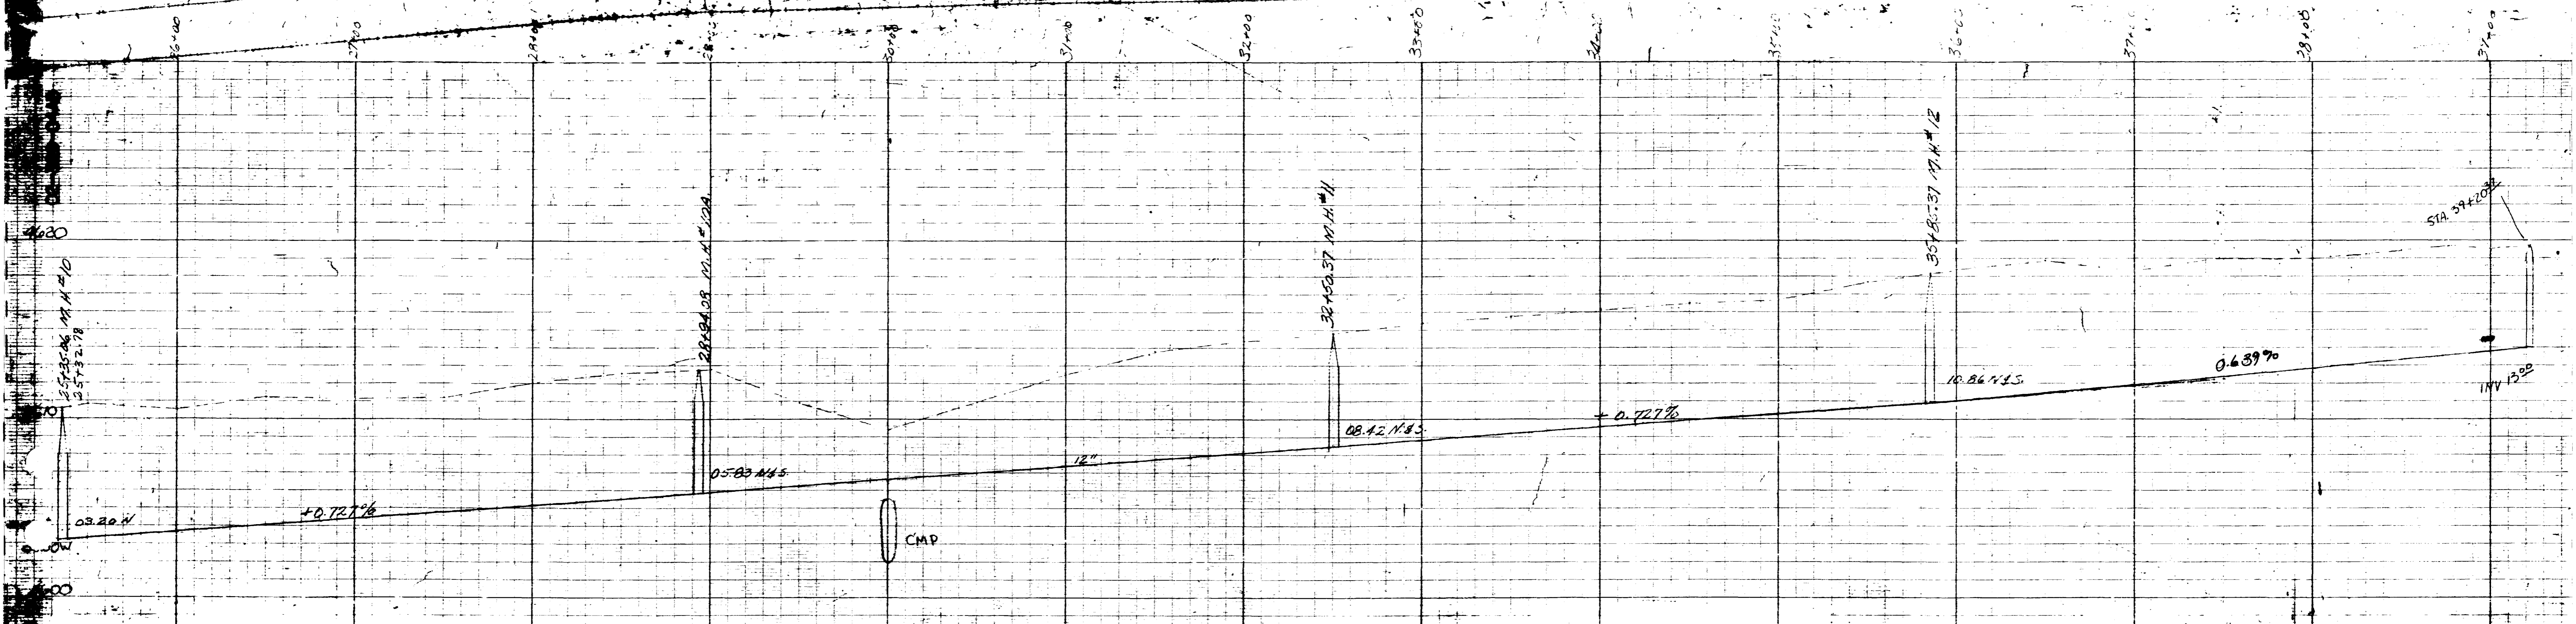




SPEC. PROFILE
 PLATE A
 EUGENE DIEZGEN CO.

PRINTED IN U.S.A.
 ON 100% RAG PAPER MADE IN U.S.A.


SPEC. PROFILE
 PLATE A
 EUGENE DIEZGEN CO.




SPEC. PROFILE
 PLATE A
 EUGENE DIEZGEN CO.

As Co.

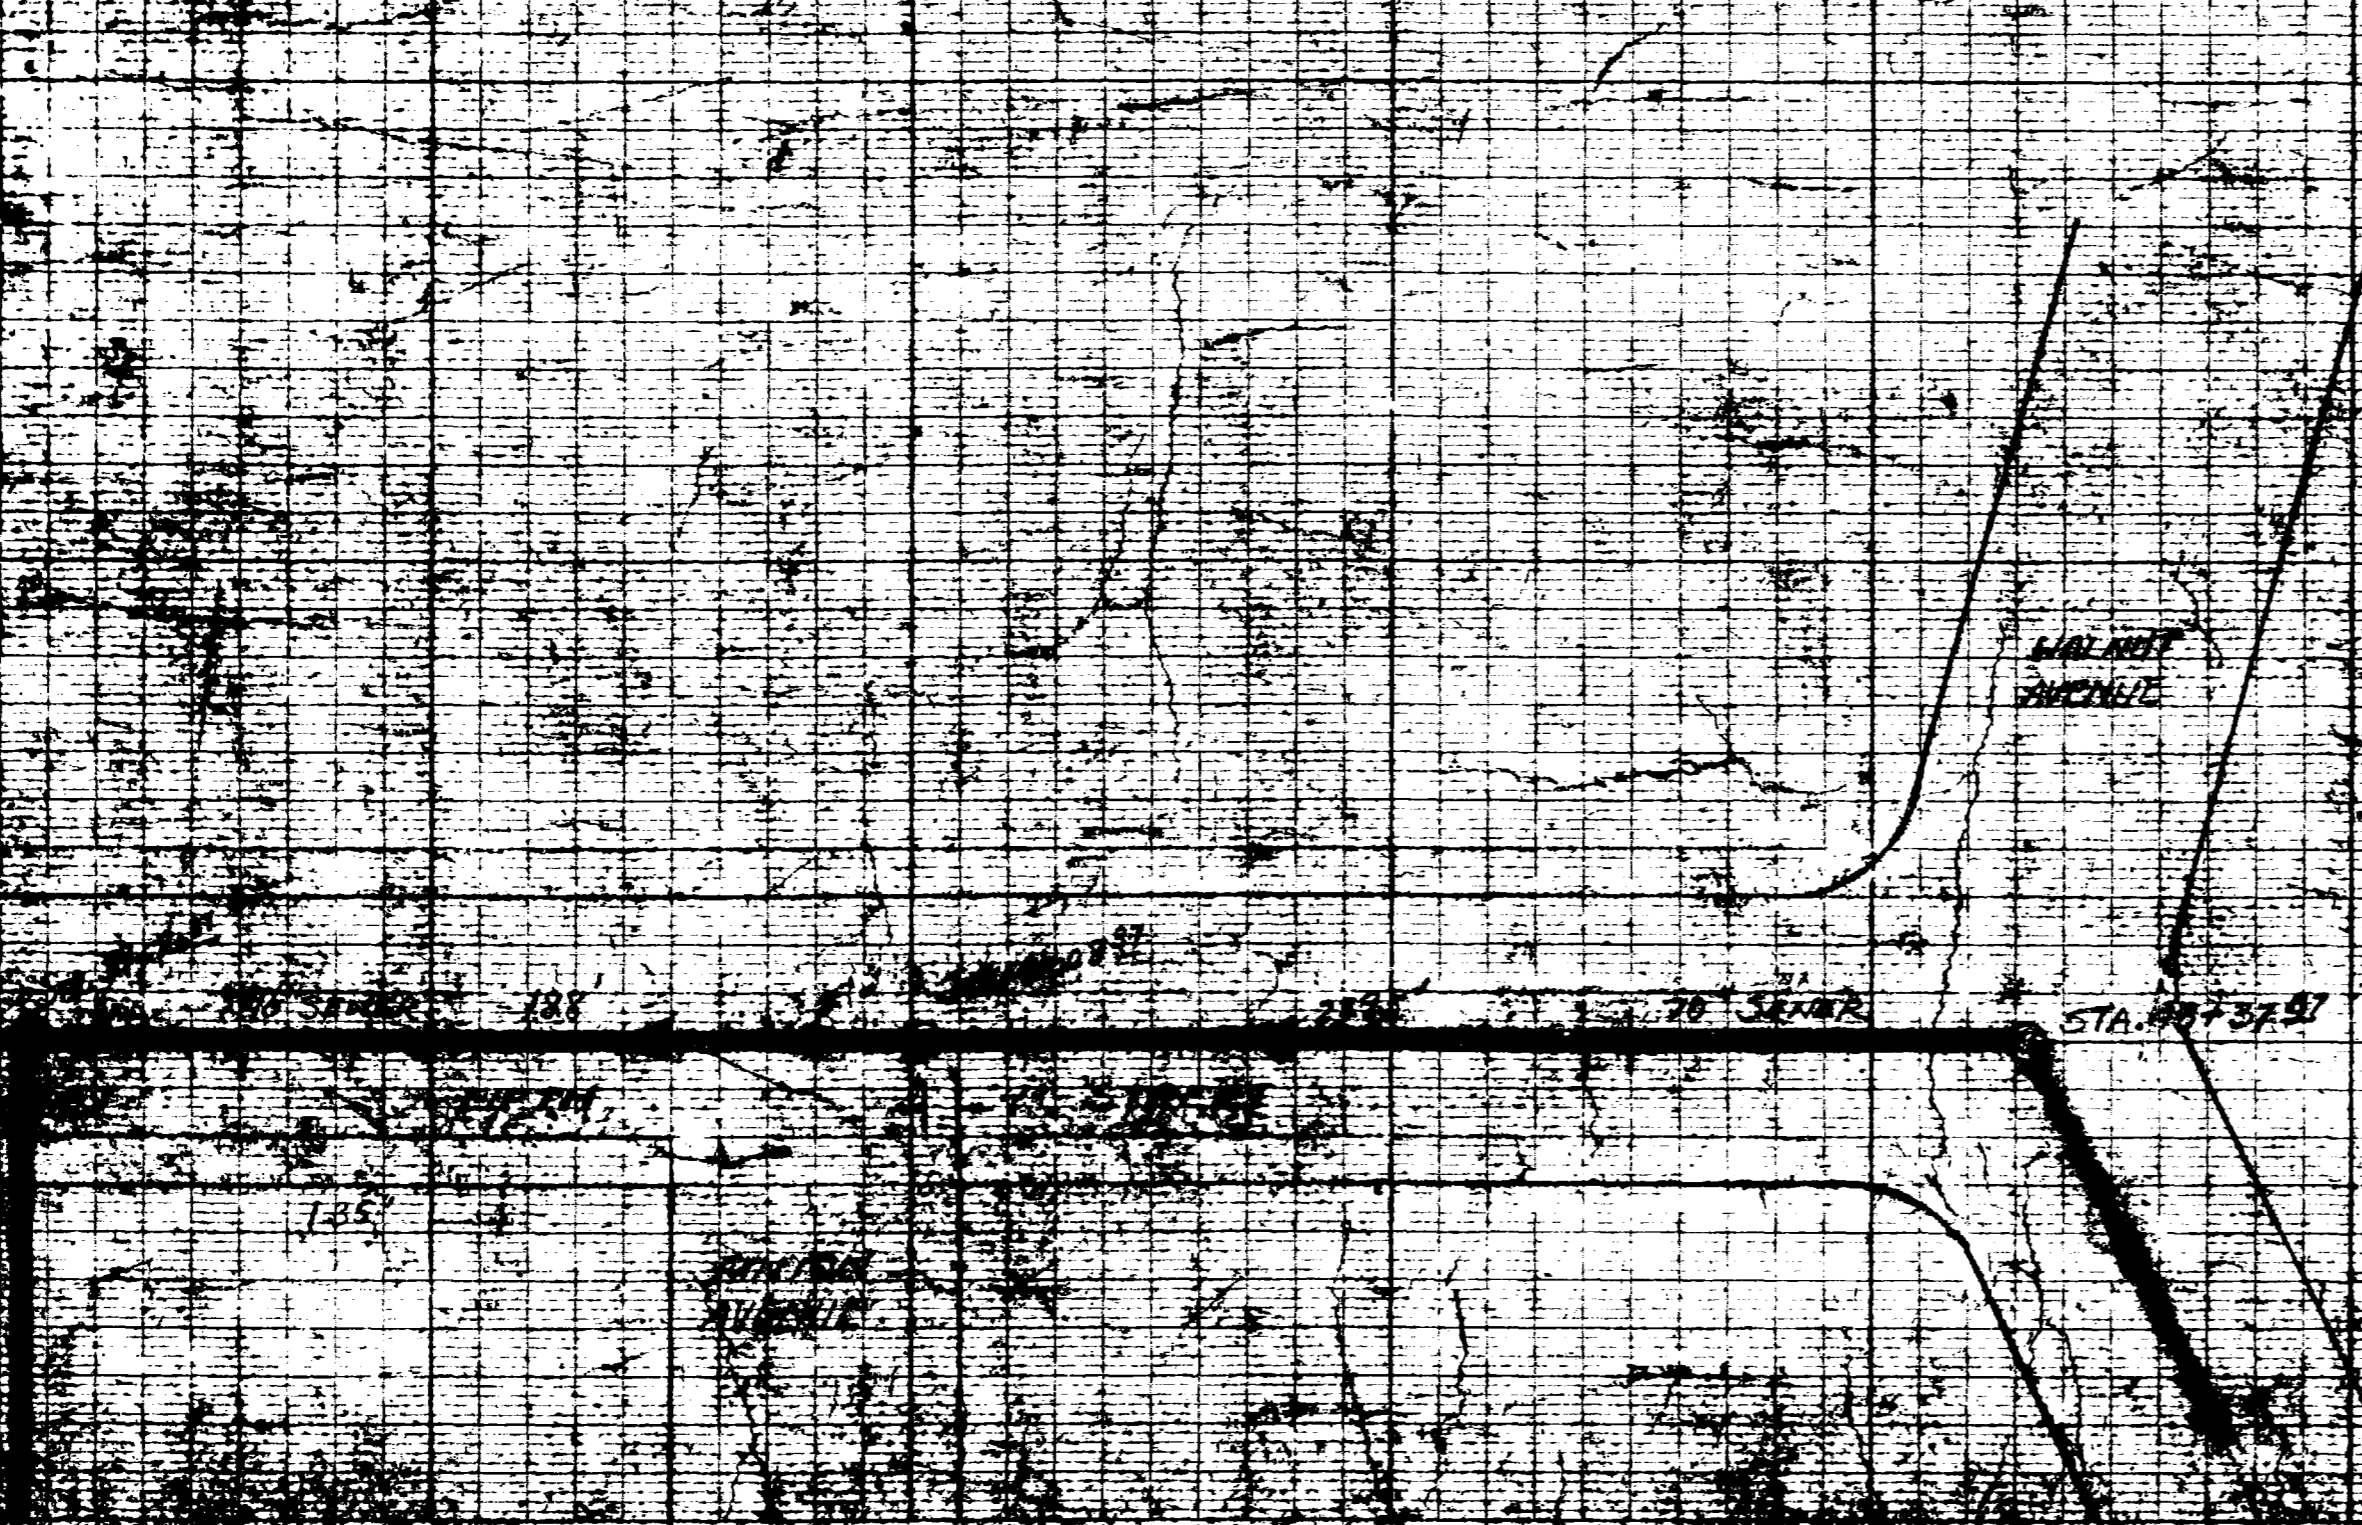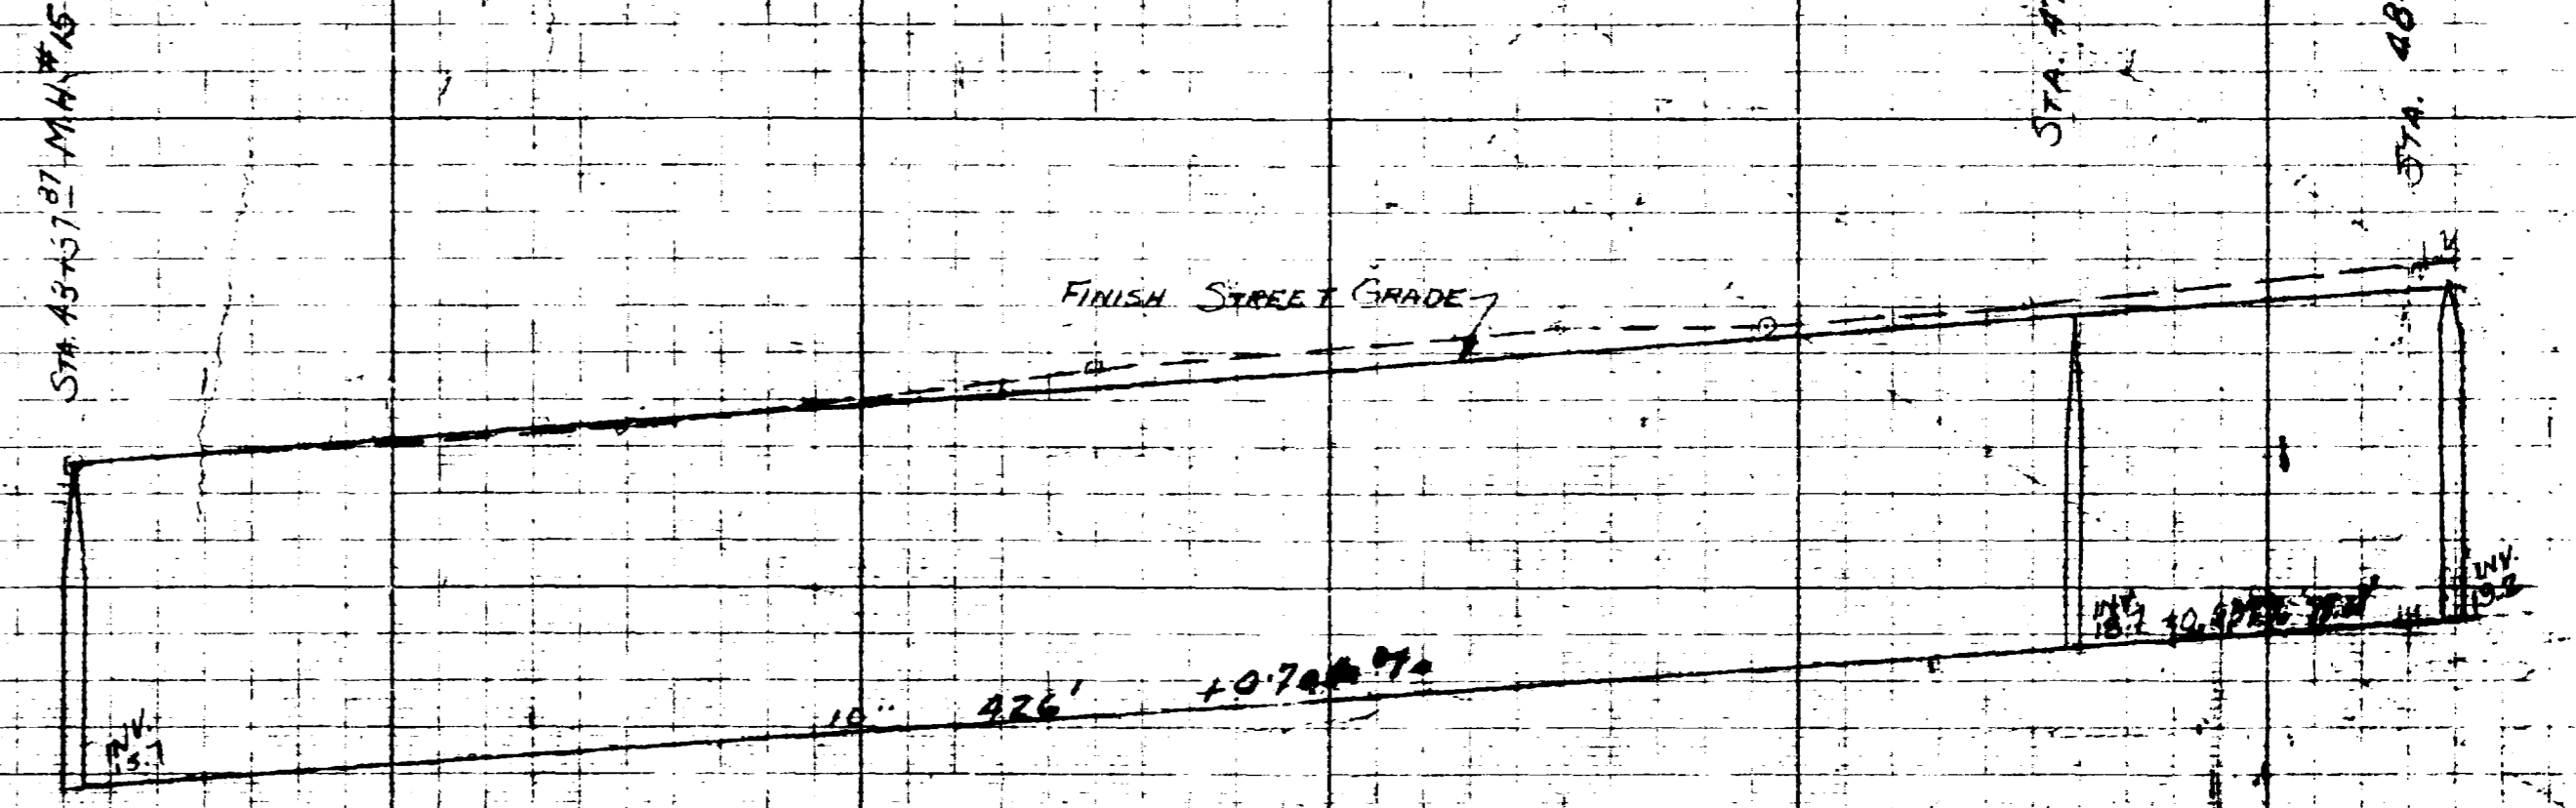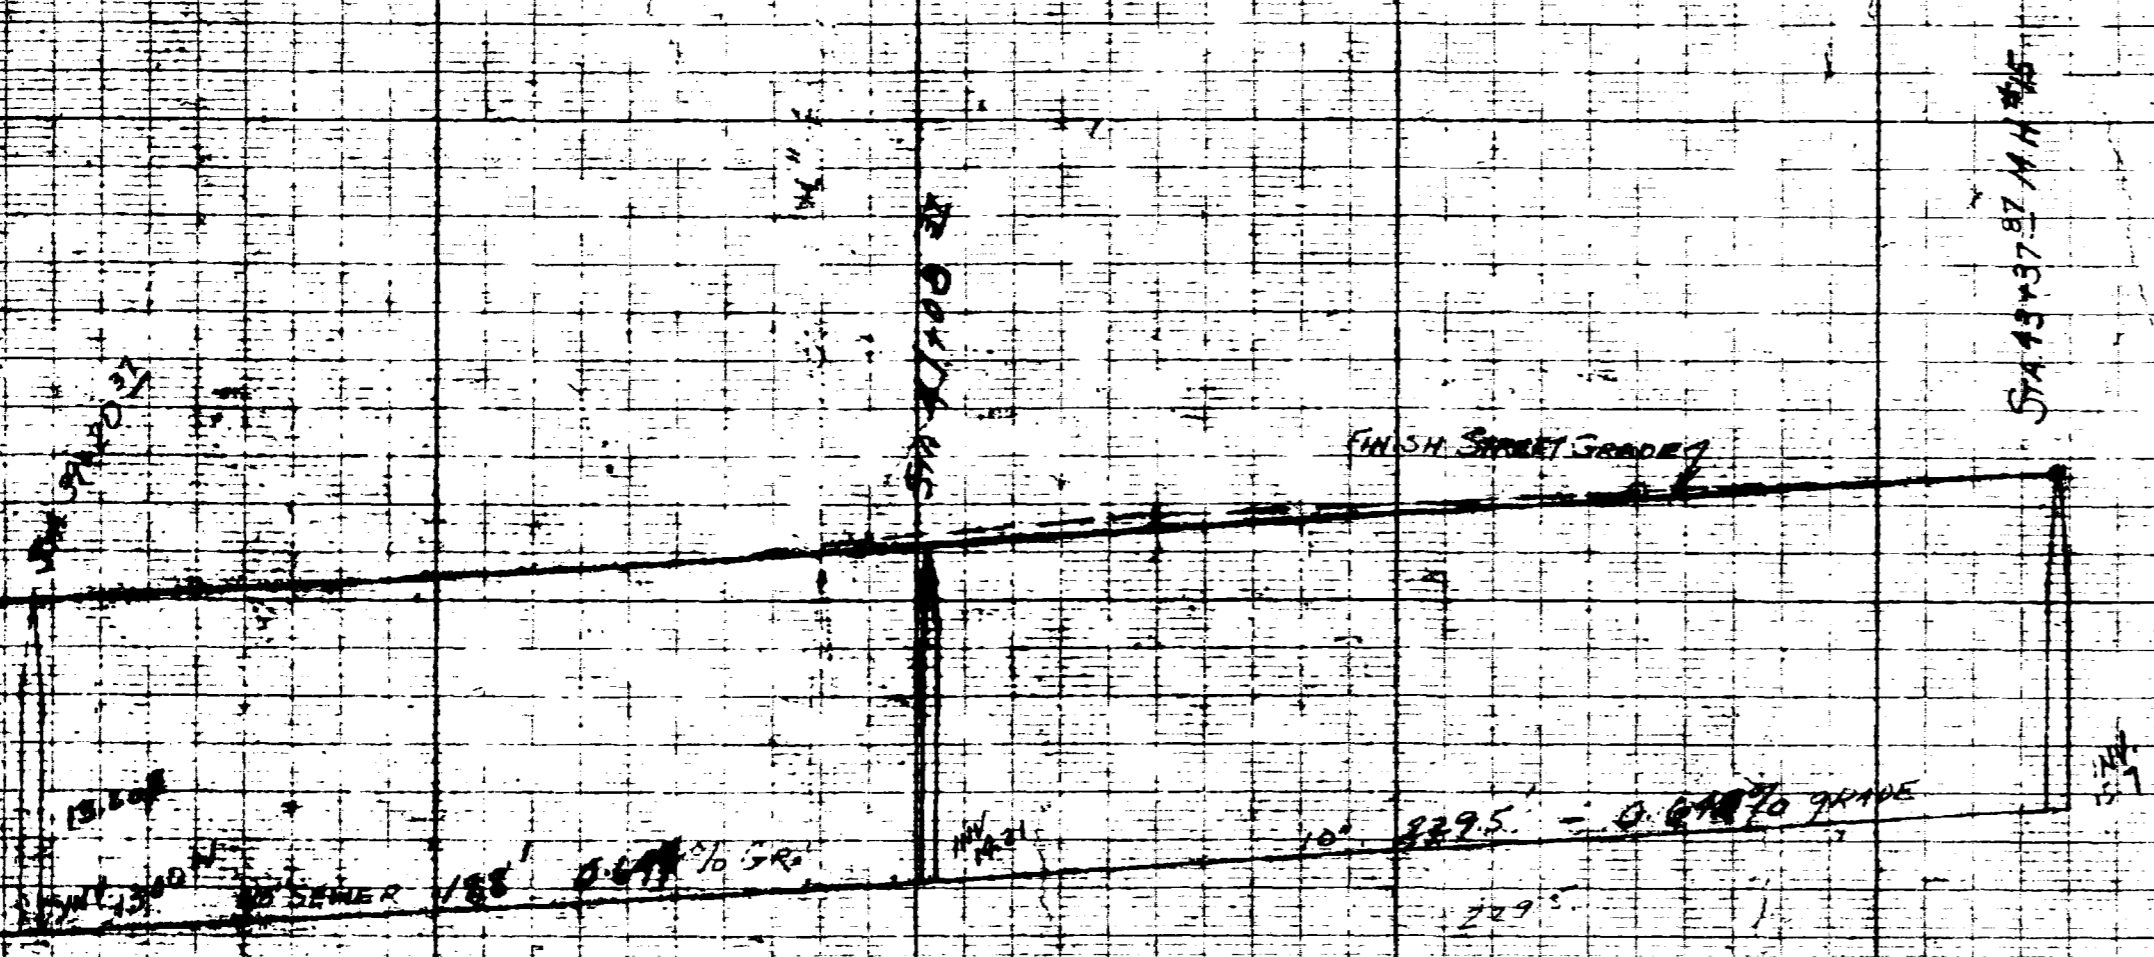

PRINTED IN U.S.A.
 SPEC. 500 - SEWER DISC 15

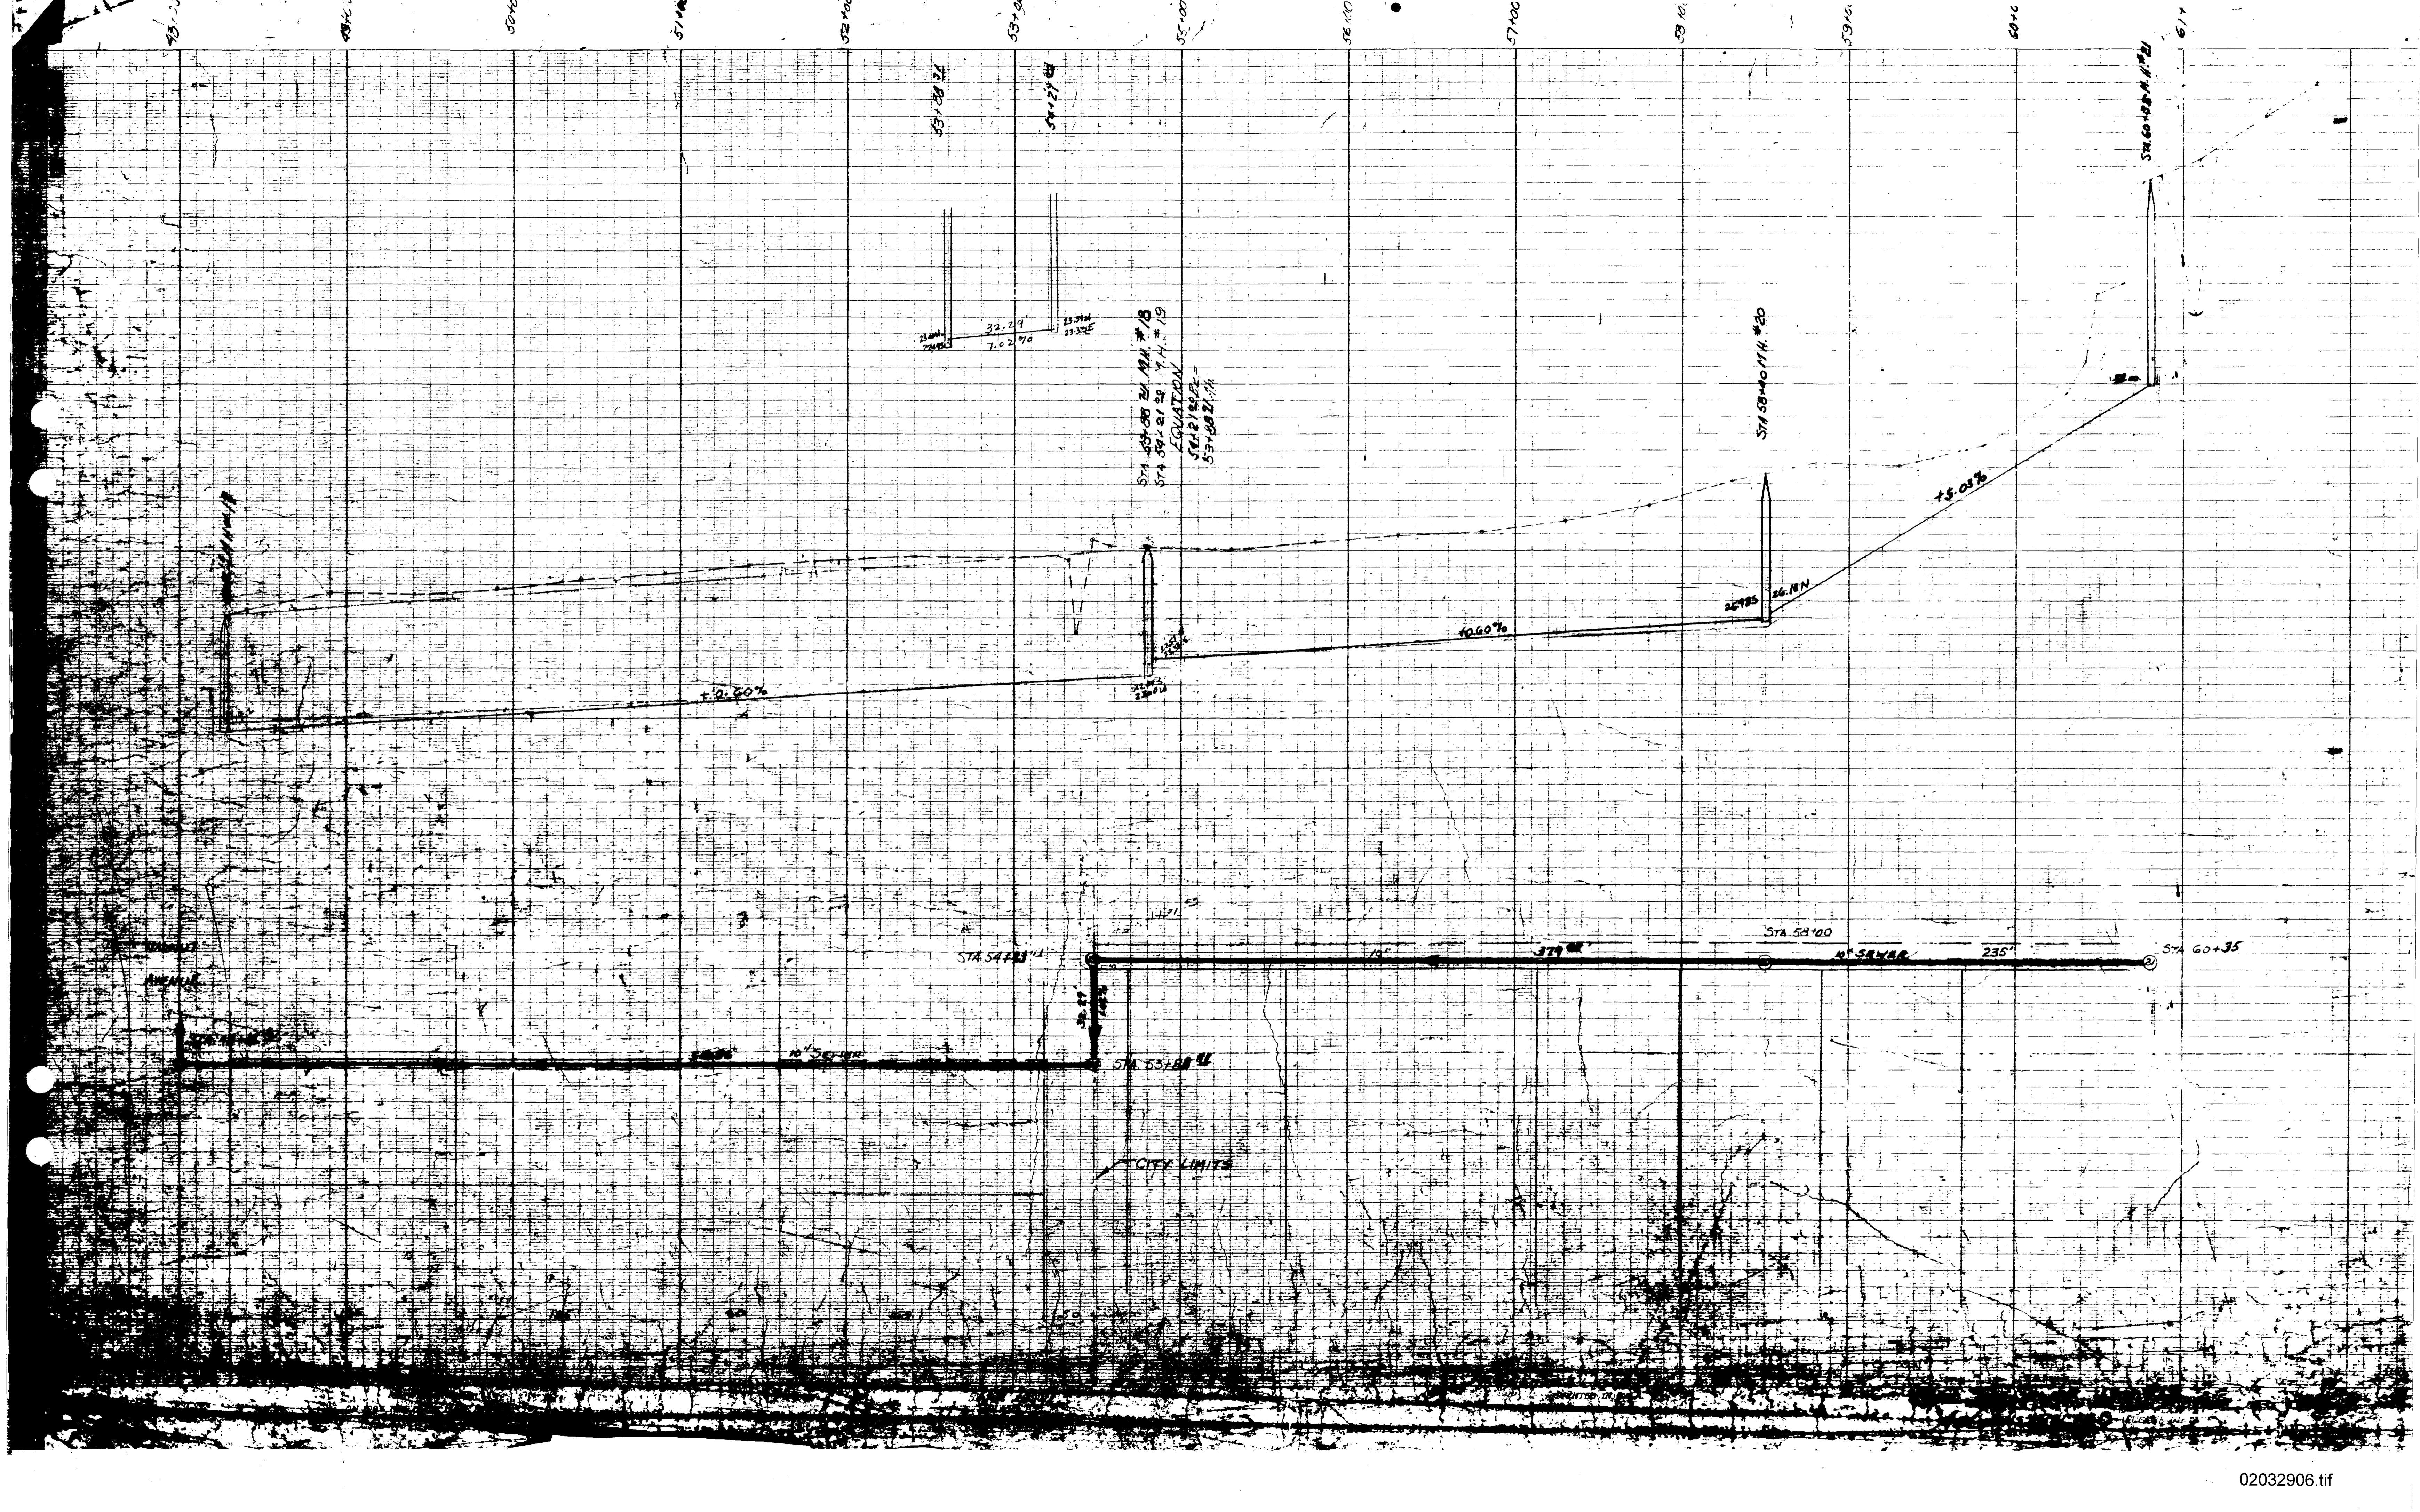

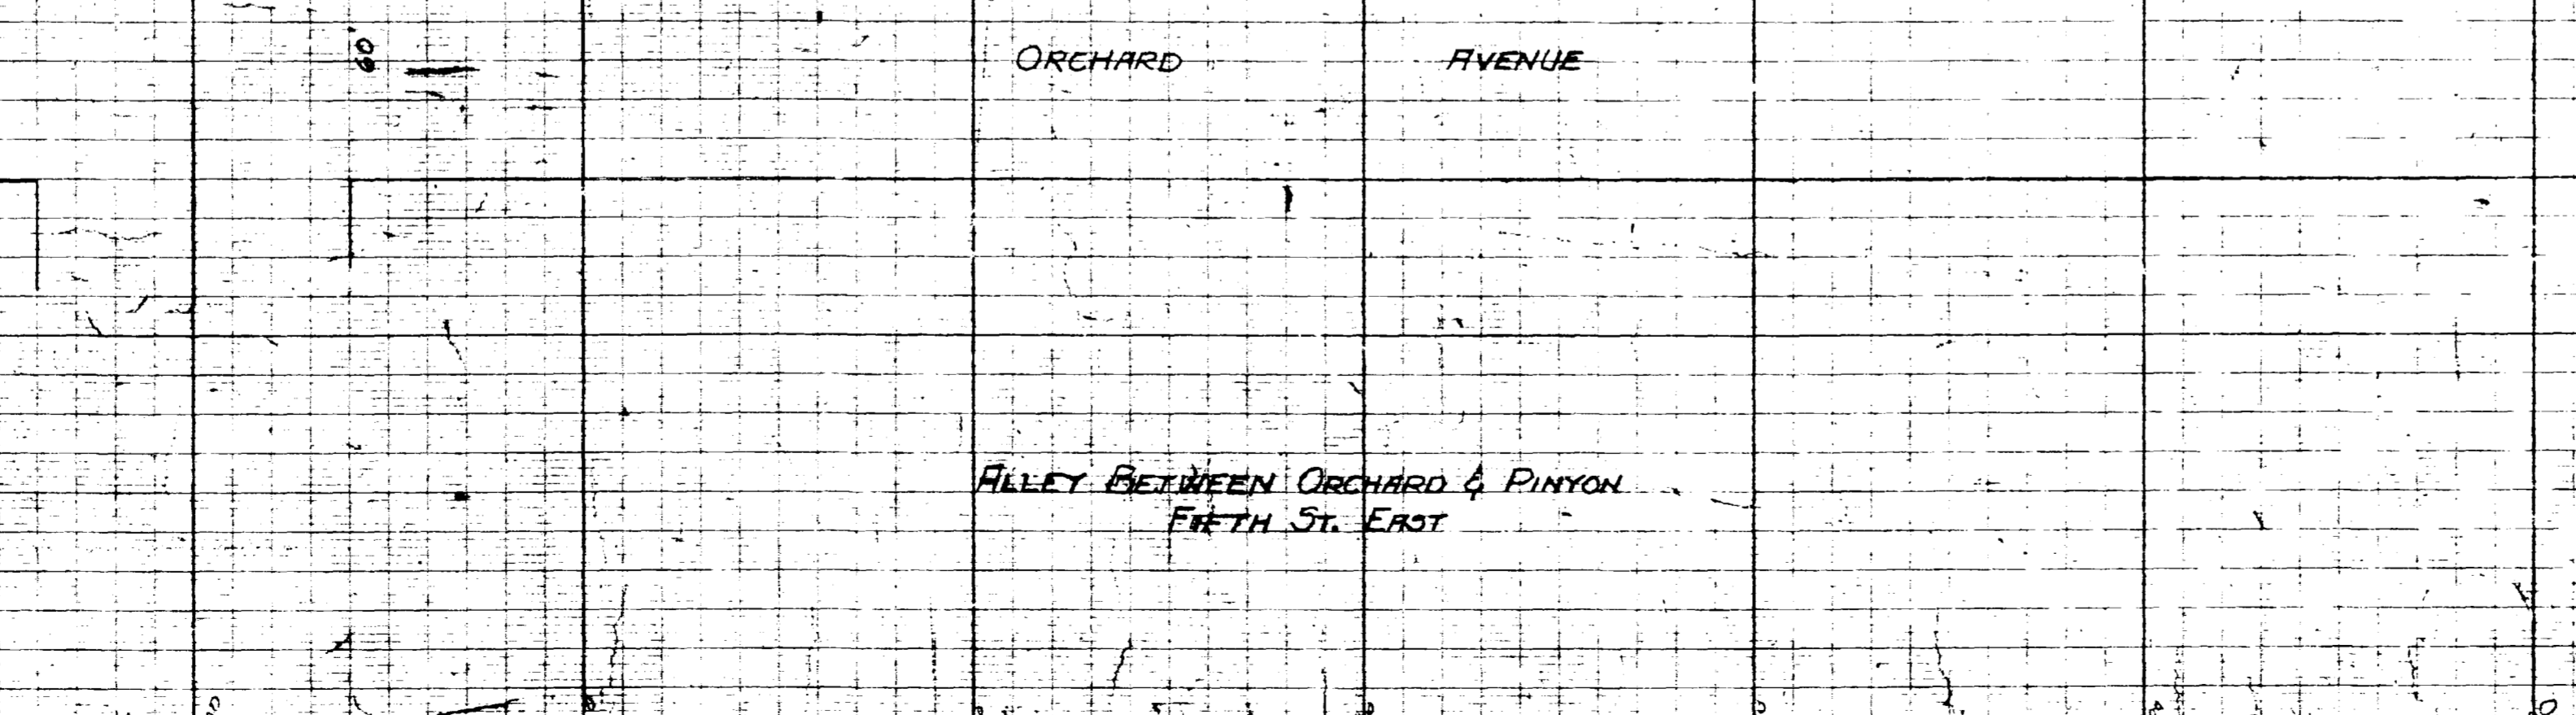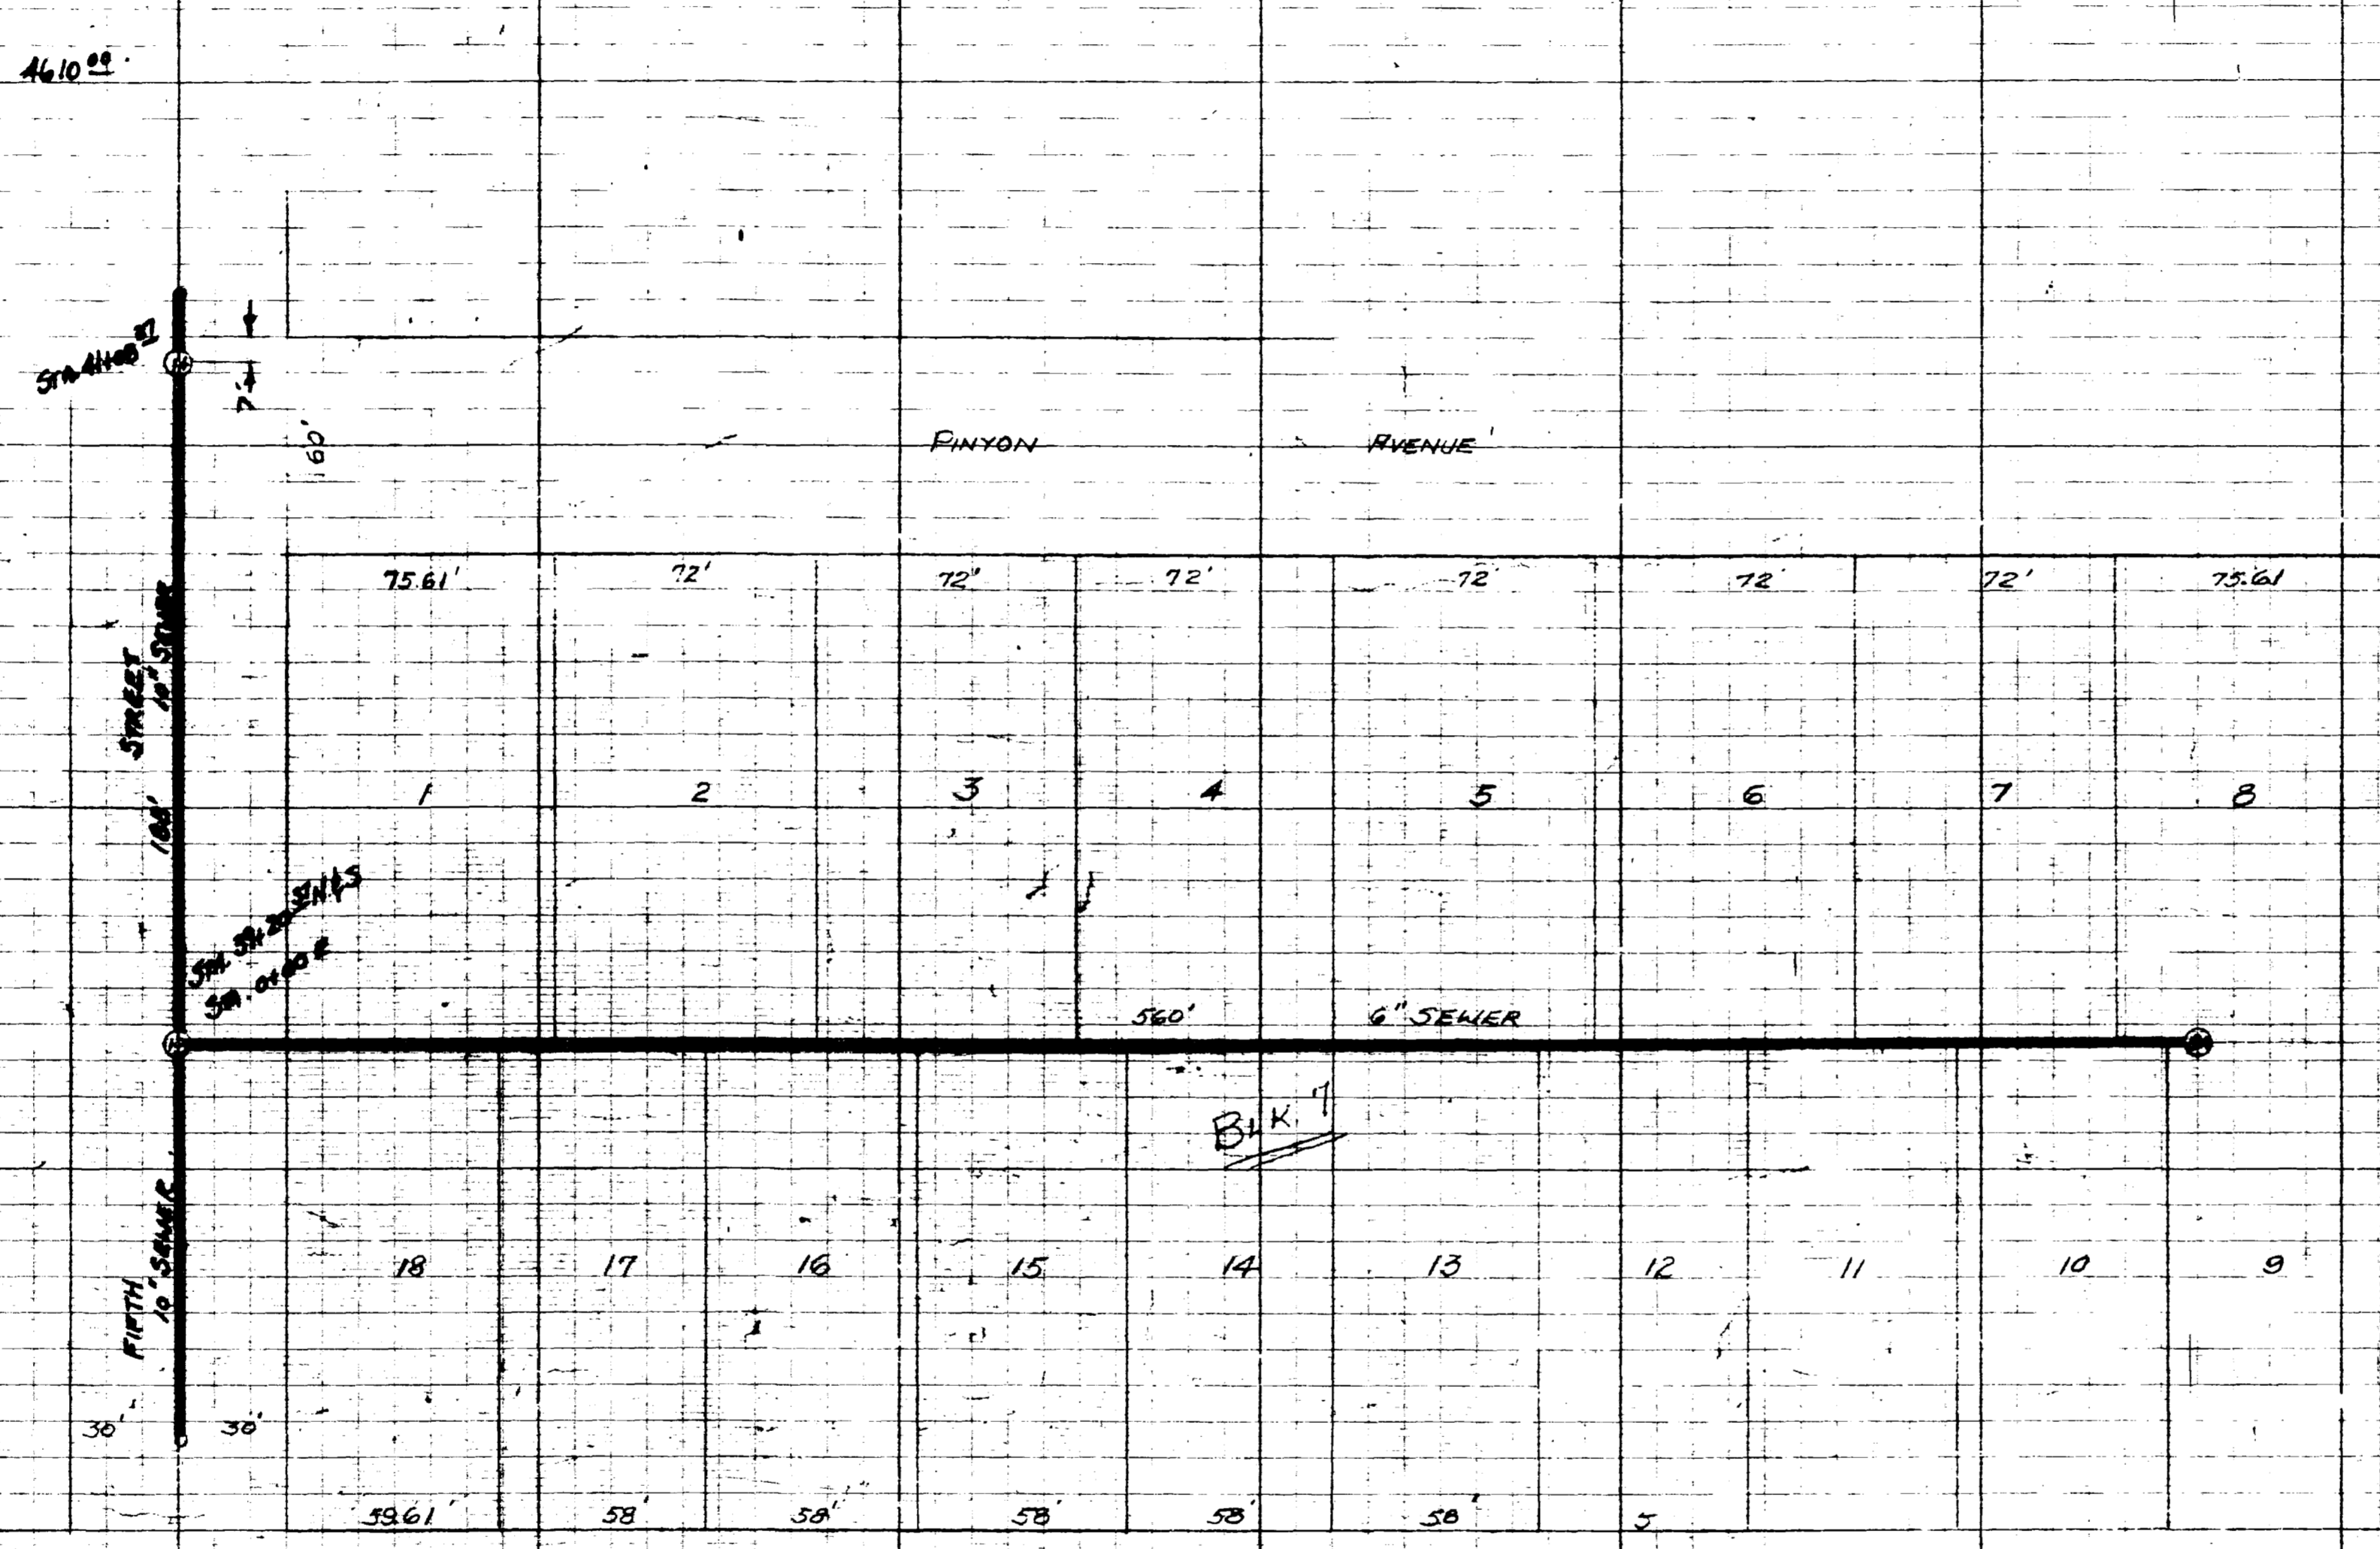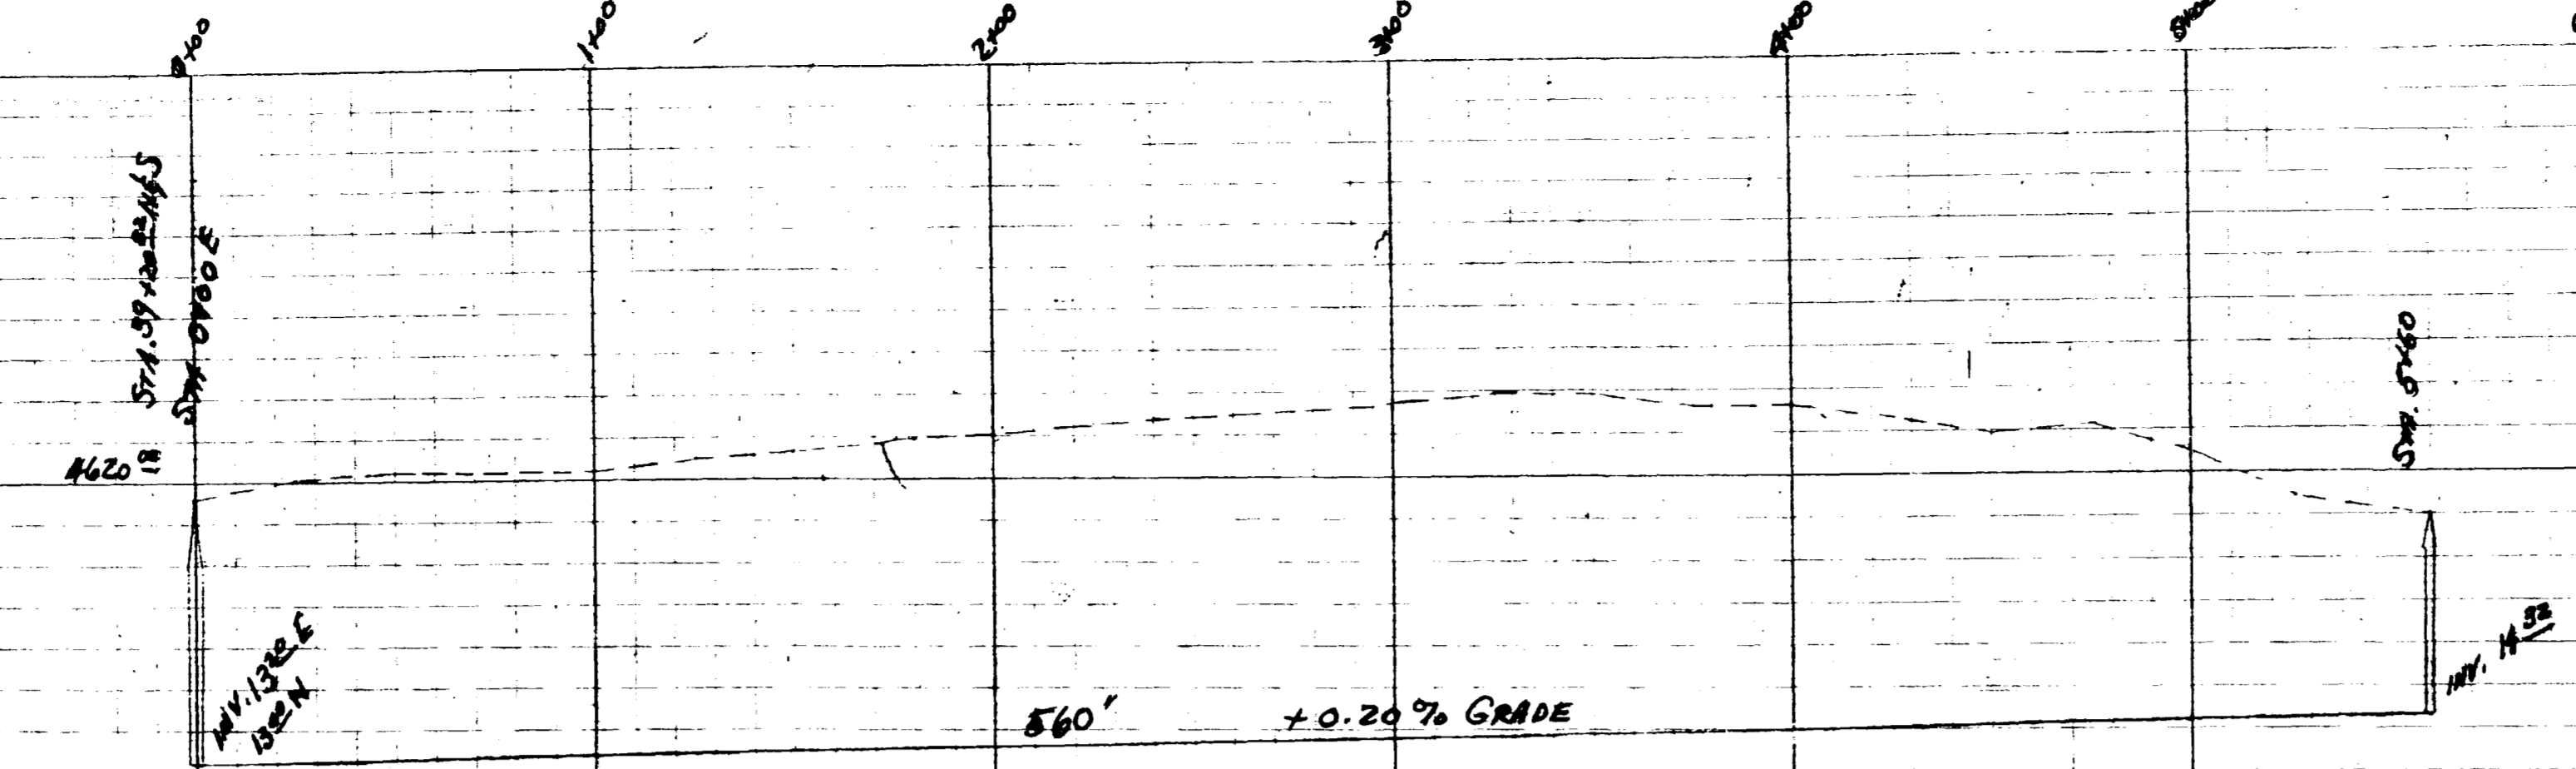

PRINTED IN U.S.A.
ON 100% RAG PAPER MADE IN U.S.A.

SEWER PROFILE
PLATE #
EUGENE DITZGEN CO.

PRINTED IN U.S.A.
ON 100% RAG PAPER MADE IN U.S.A.

SPECIAL SAN. SEWER LIST #13
EUGENE DITZGEN CO.
AS CONTRACTED

SHEET #1