



SANITARY SEWER DISTRICT 30 - 74

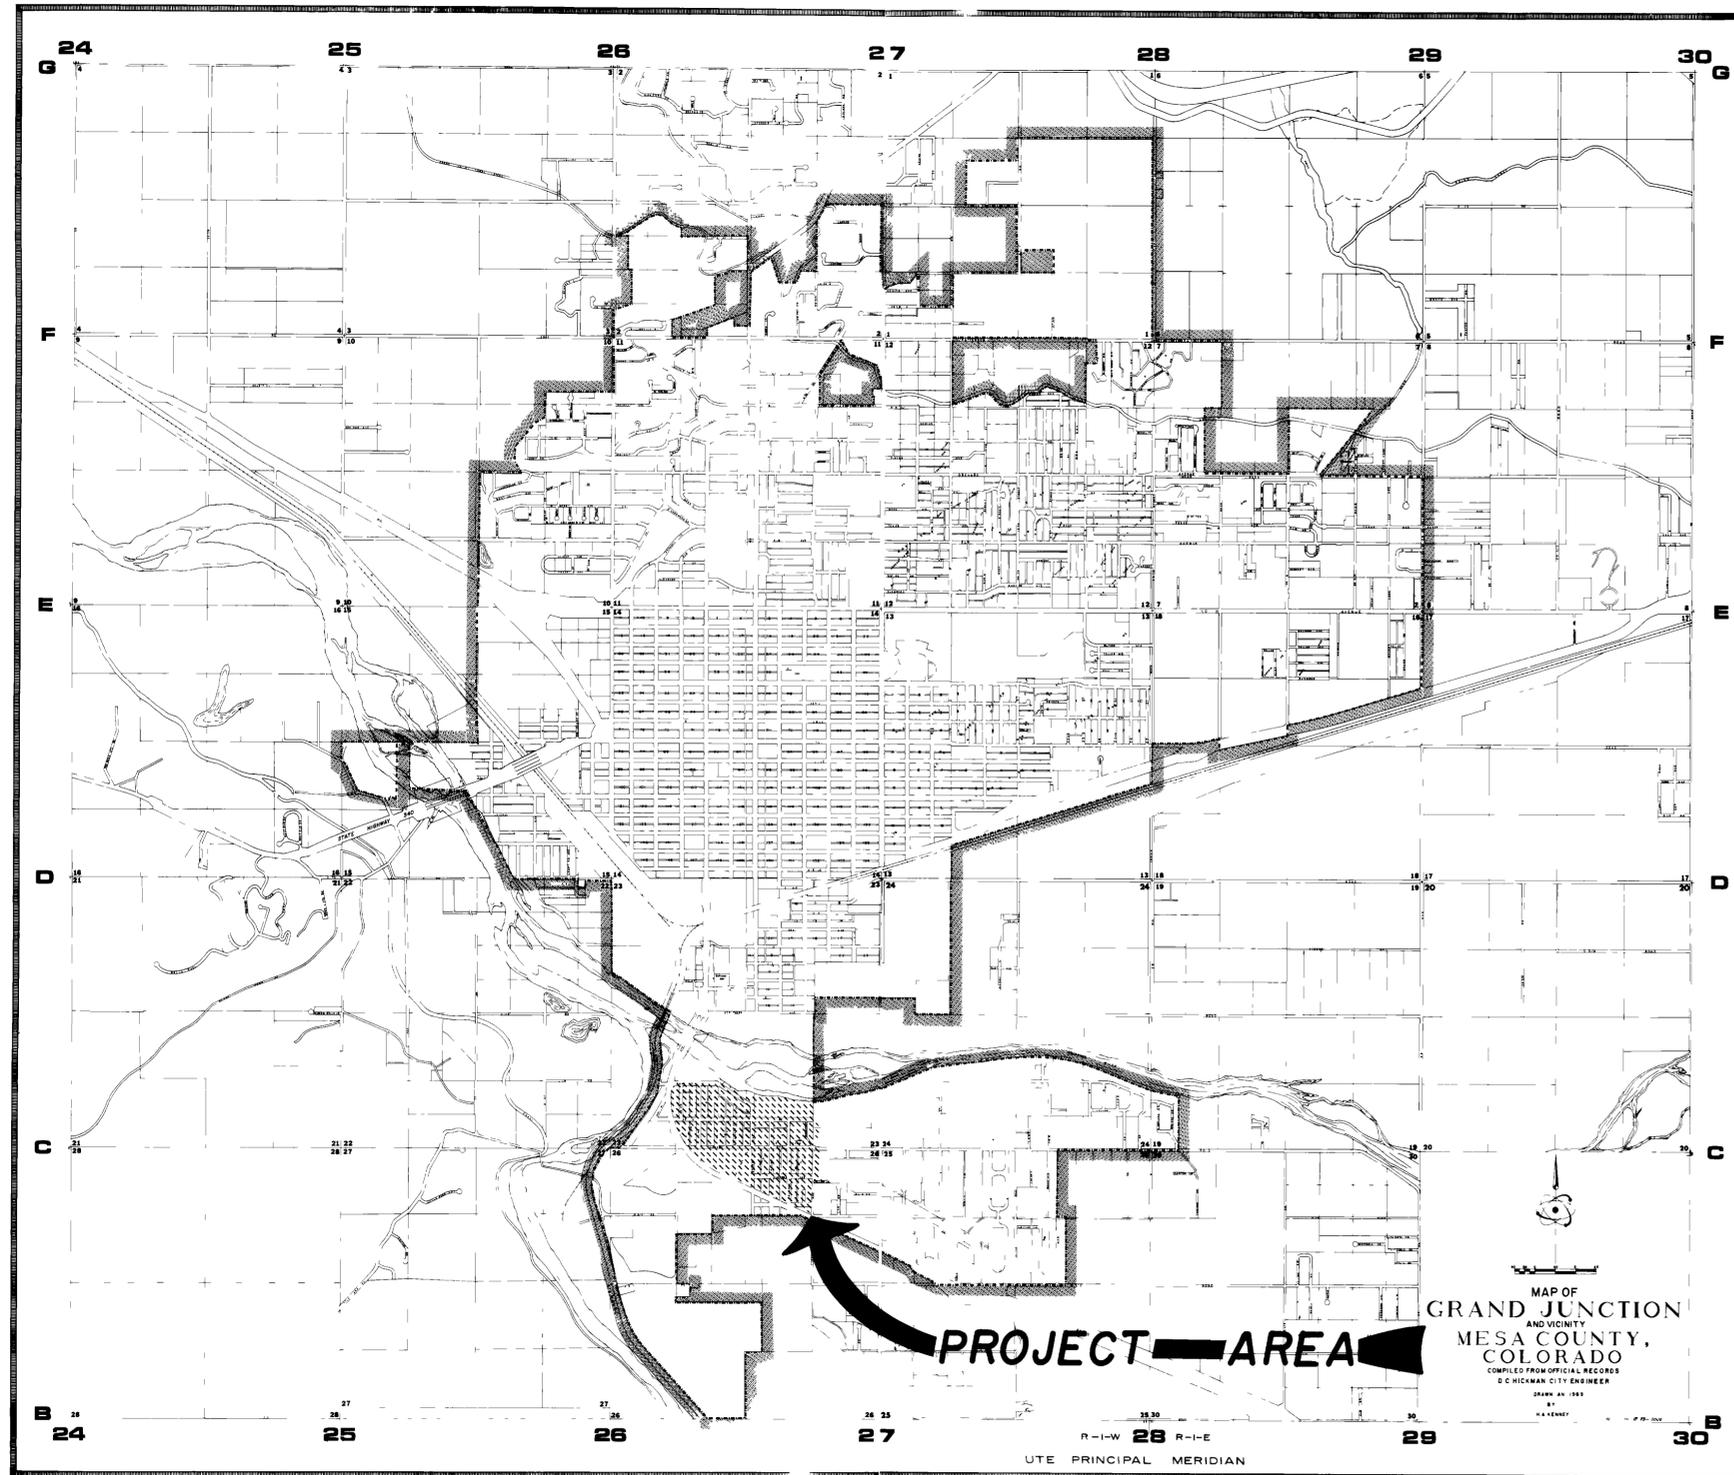

SURVEY & DESIGN BY
Doris Hickman
D.C. HICKMAN P.E. No. 456

APPROVED BY
Mustafa A. Bayram
DIRECTOR OF PUBLIC WORKS


TRUNK LINE

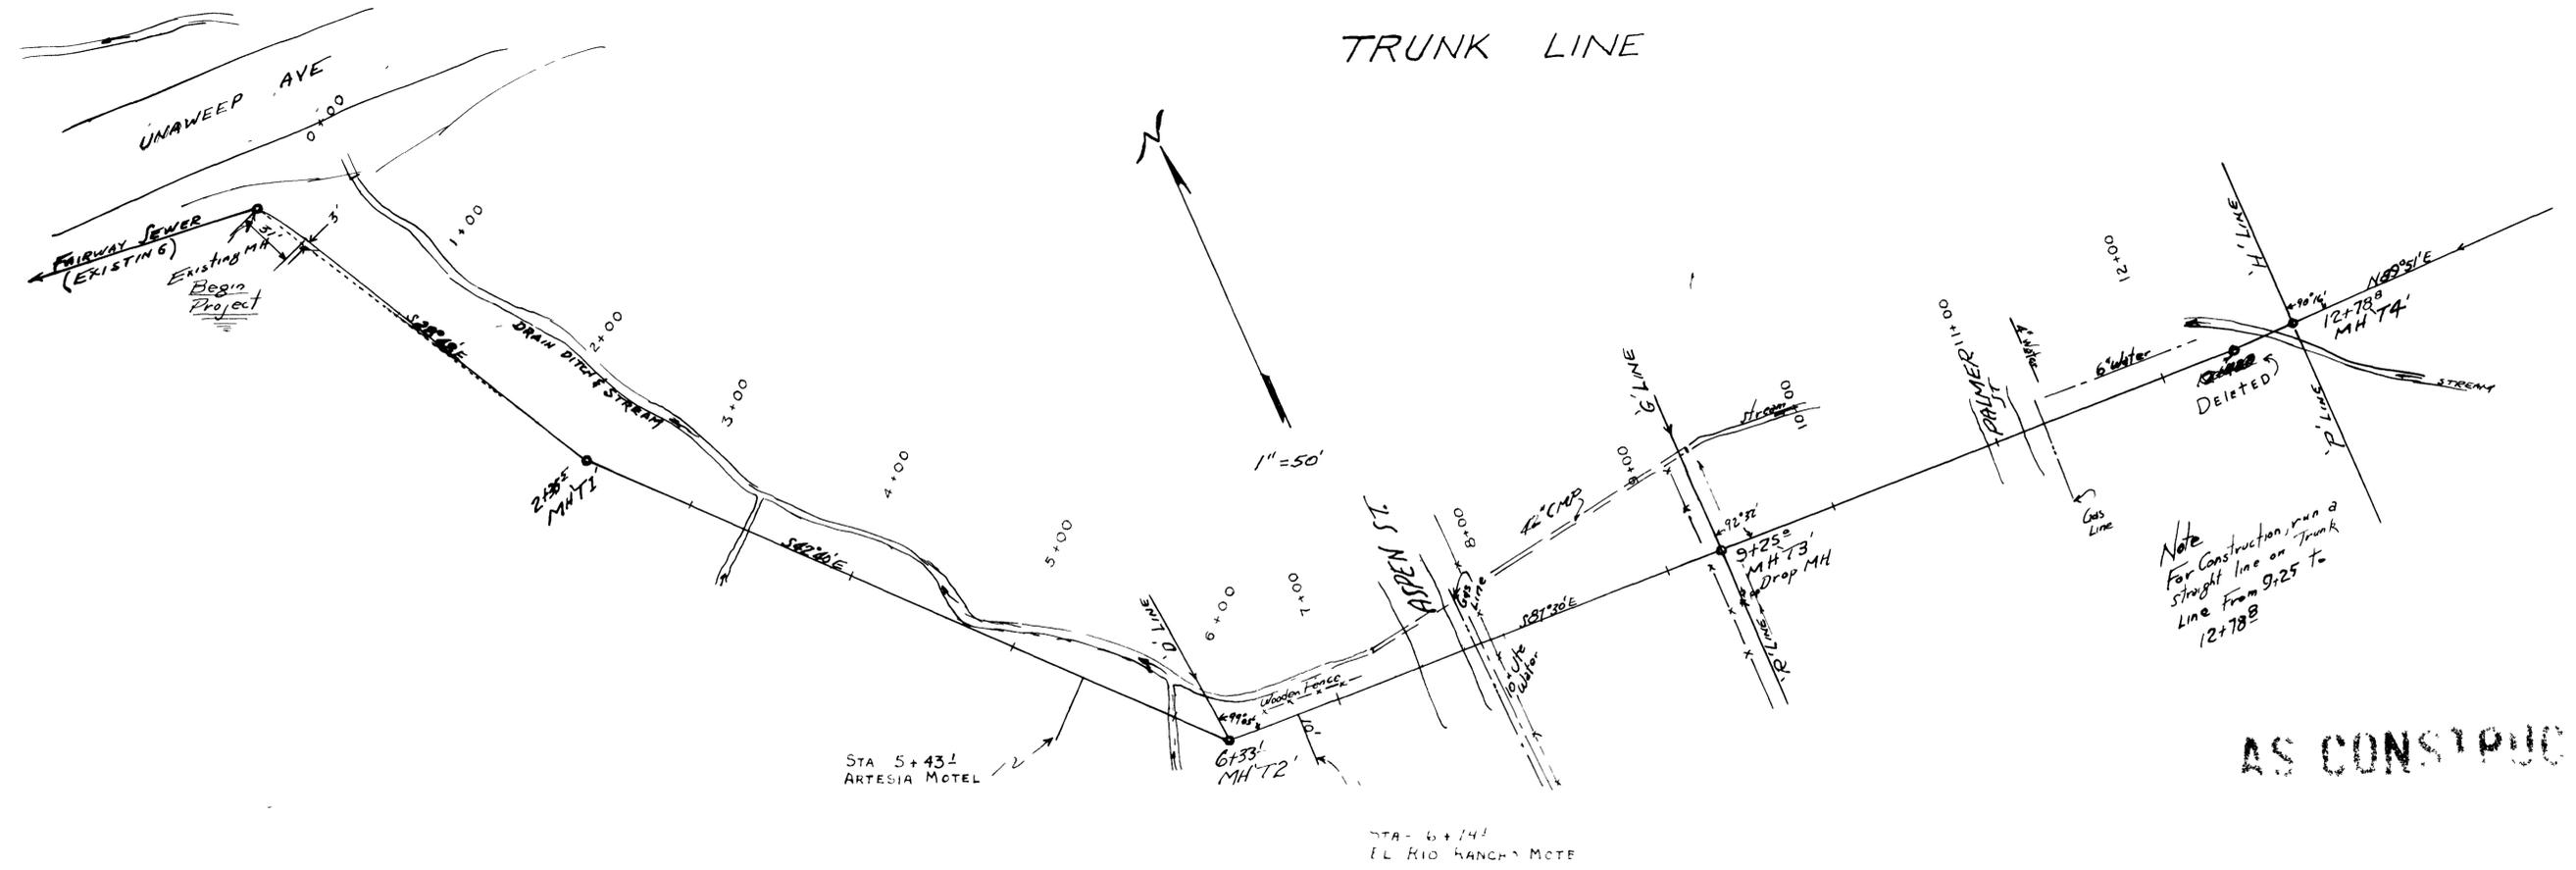

AS CONSTRUCTED


PLAN NOTE BOOK No. 307

PROFILE NOTE BOOK No. 307

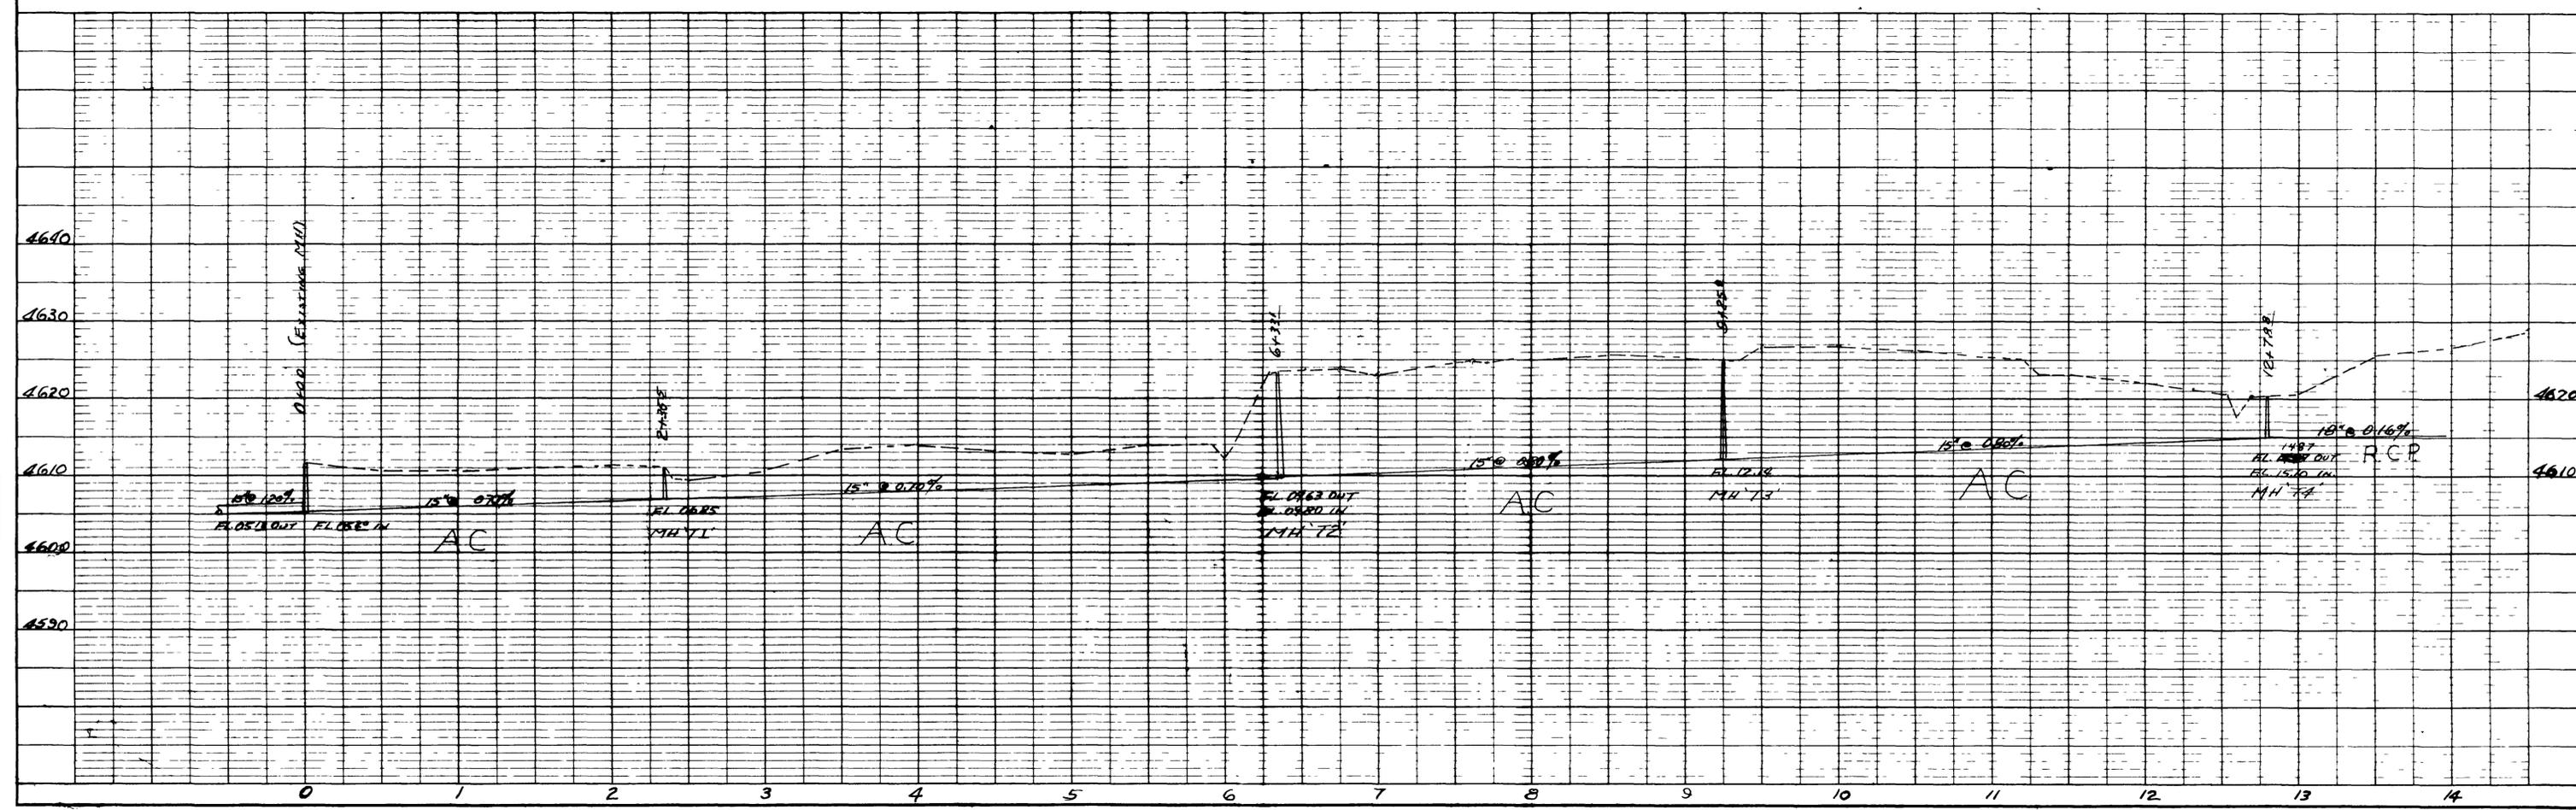


TRUNK LINE

DATE	
BY	
REVISION	
PLOTTED	
NOTE BOOK	
ALIGNED CHECKED	
NO. 307	

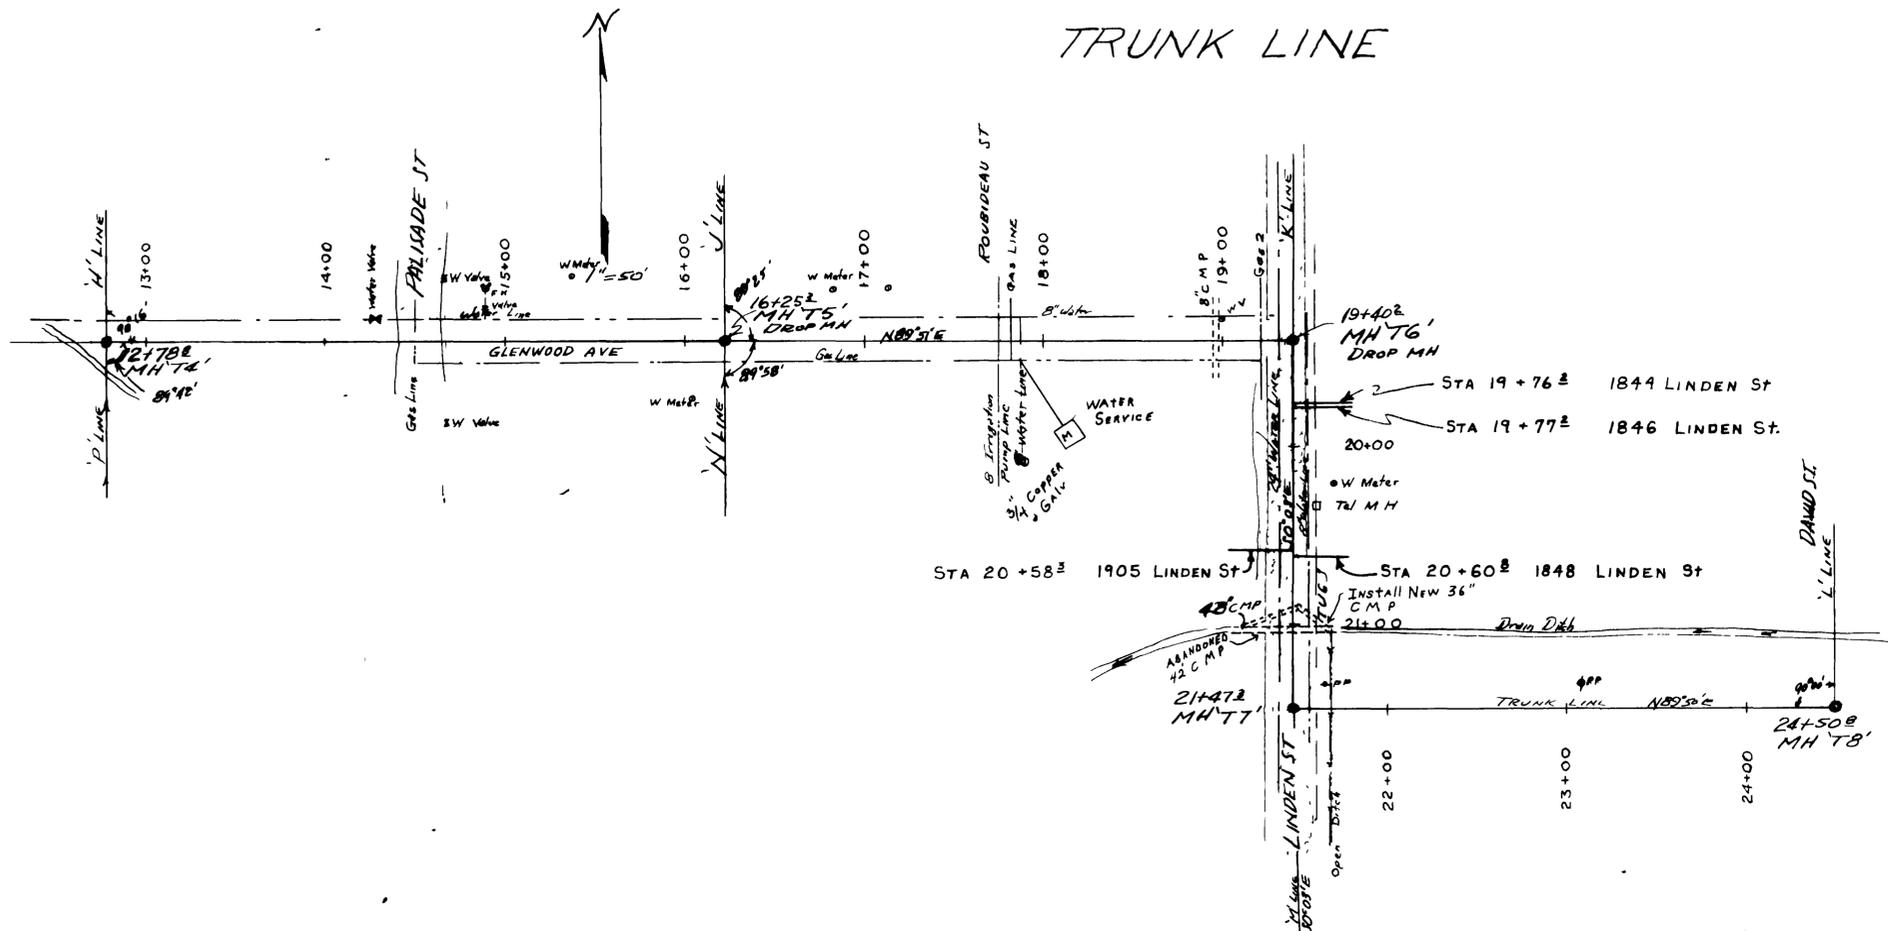


AS CONSTRUCTED

DATE	
BY	
REVISION	
PLOTTED	
NOTE BOOK	
ALIGNED CHECKED	
NO. 307	

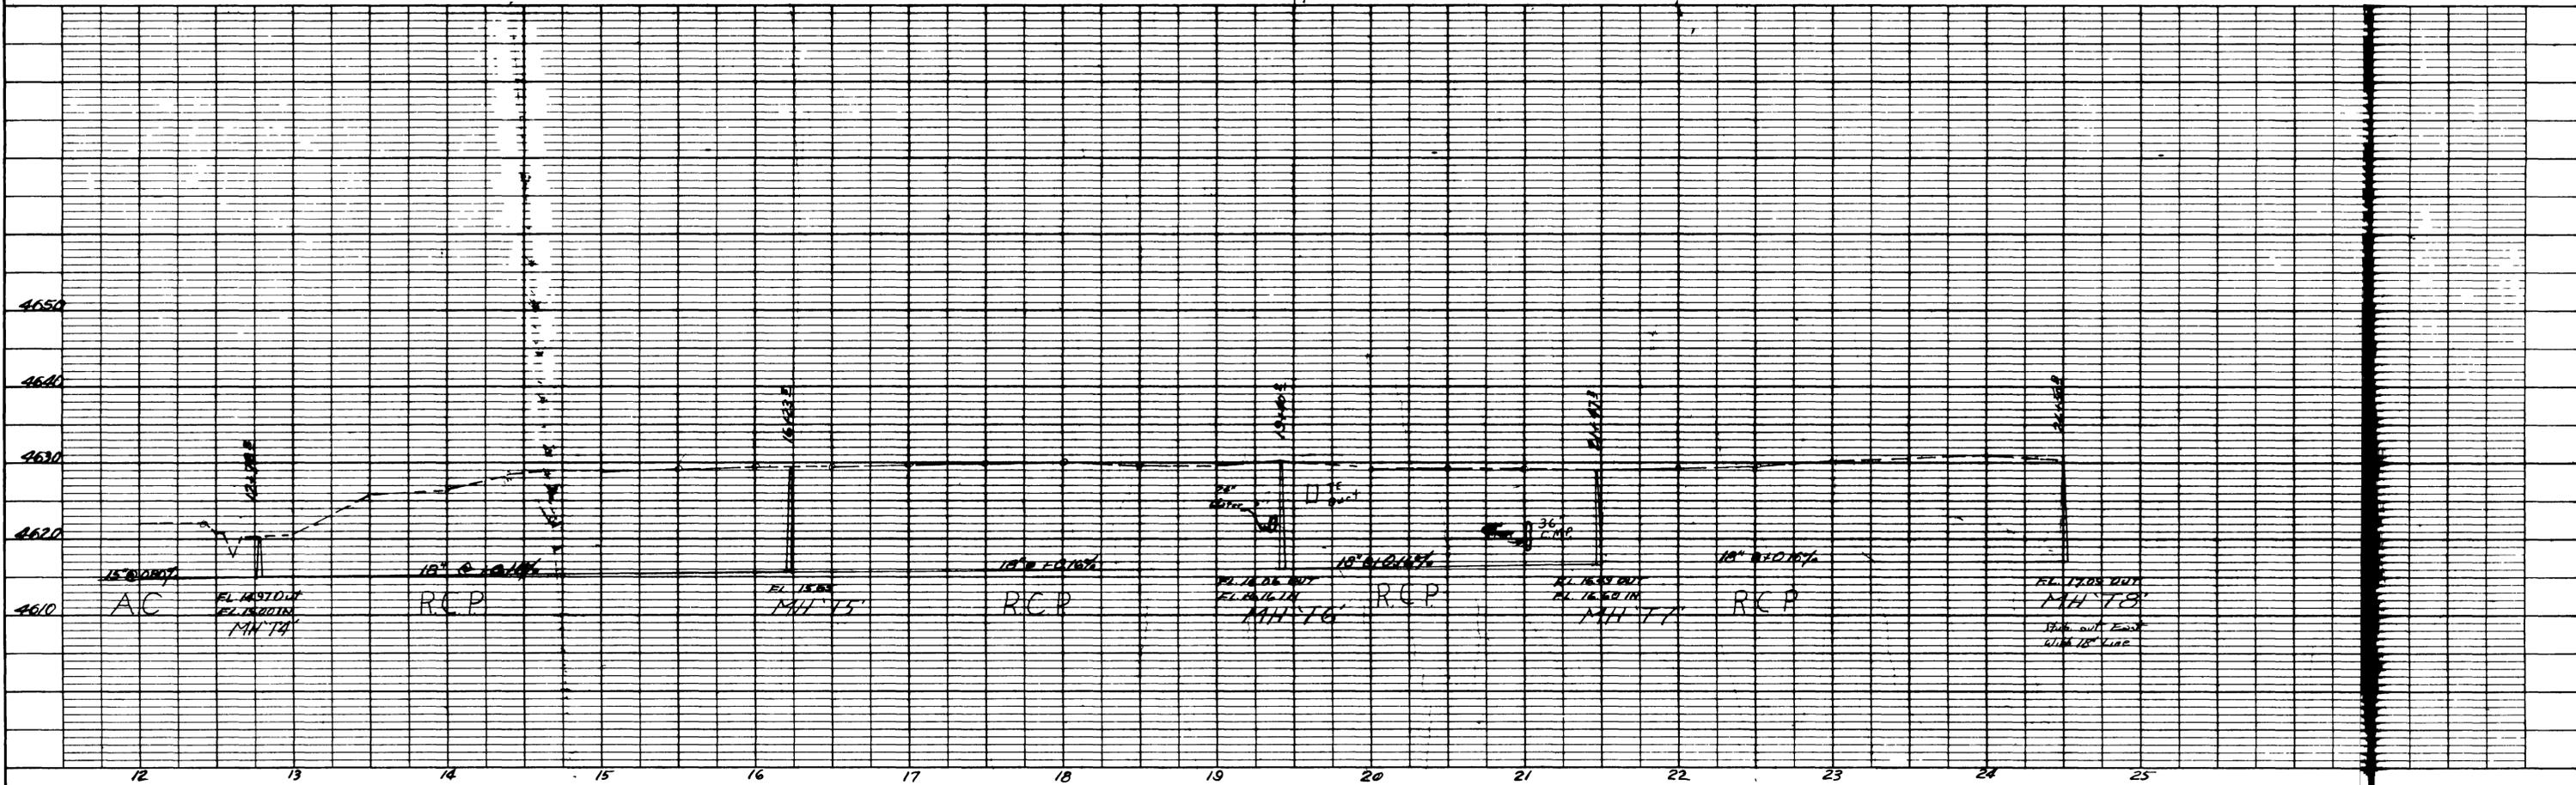

PROFILE	SURVEYED	DATE
NO. 207	PLOTTED	
	GRADES CHECKED	
	B. M. E. NOTED	
	STRUCTURE NOTATIONS CH. KD.	

PLAN	SURVEYED	DATE
NO. 207	PLOTTED	
	ALIGNMENT CHECKED	
	RT. OF WAY CHECKED	

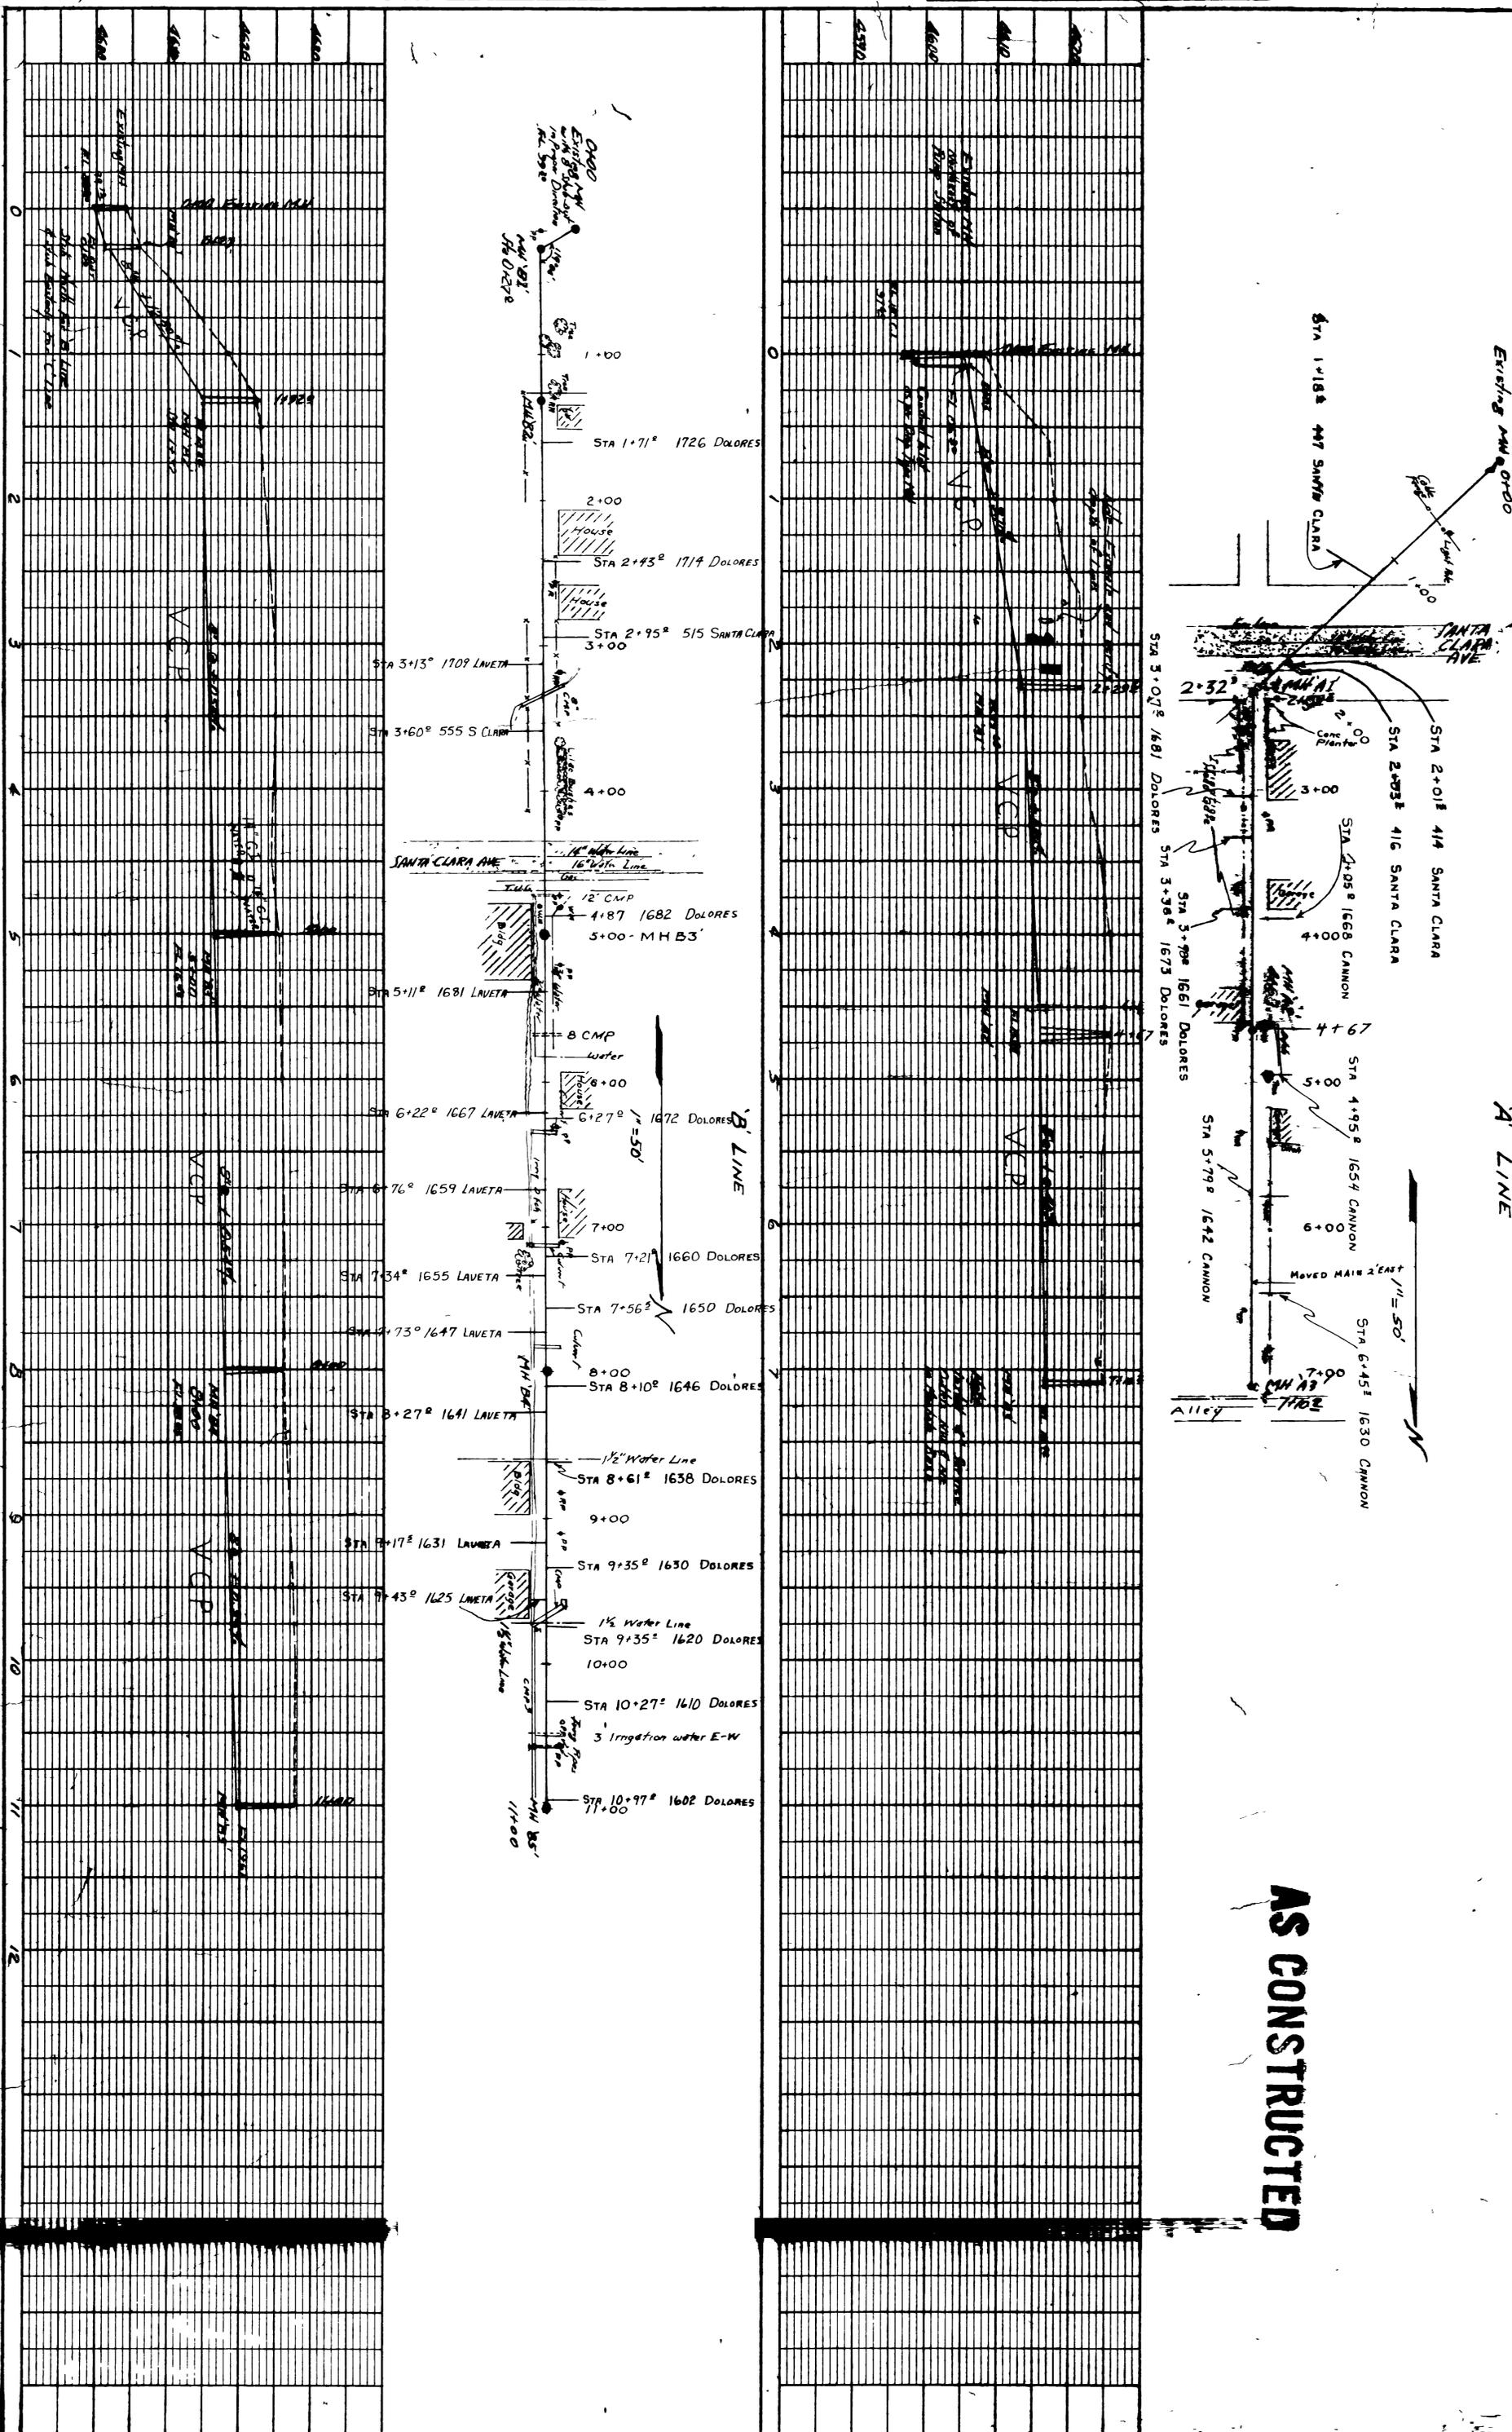


AS CONSTRUCTED

K.E. PLATE 2, RAINBOW
48708 ALABAMA ENGINEERING NUMBER 3700

PROFILE	SURVEYED	BY	DATE
NOTE BOOK	PLOTTED		
No. 327	GRADES CHECKED		
	AS NOTED		
	STRUCTURE NOTATIONS CHECKED		

PLAN	SURVEYED	BY	DATE
NOTE BOOK	PLOTTED		
No. 327	ALIGNMENT CHECKED		
	RT OF WAY CHECKED		

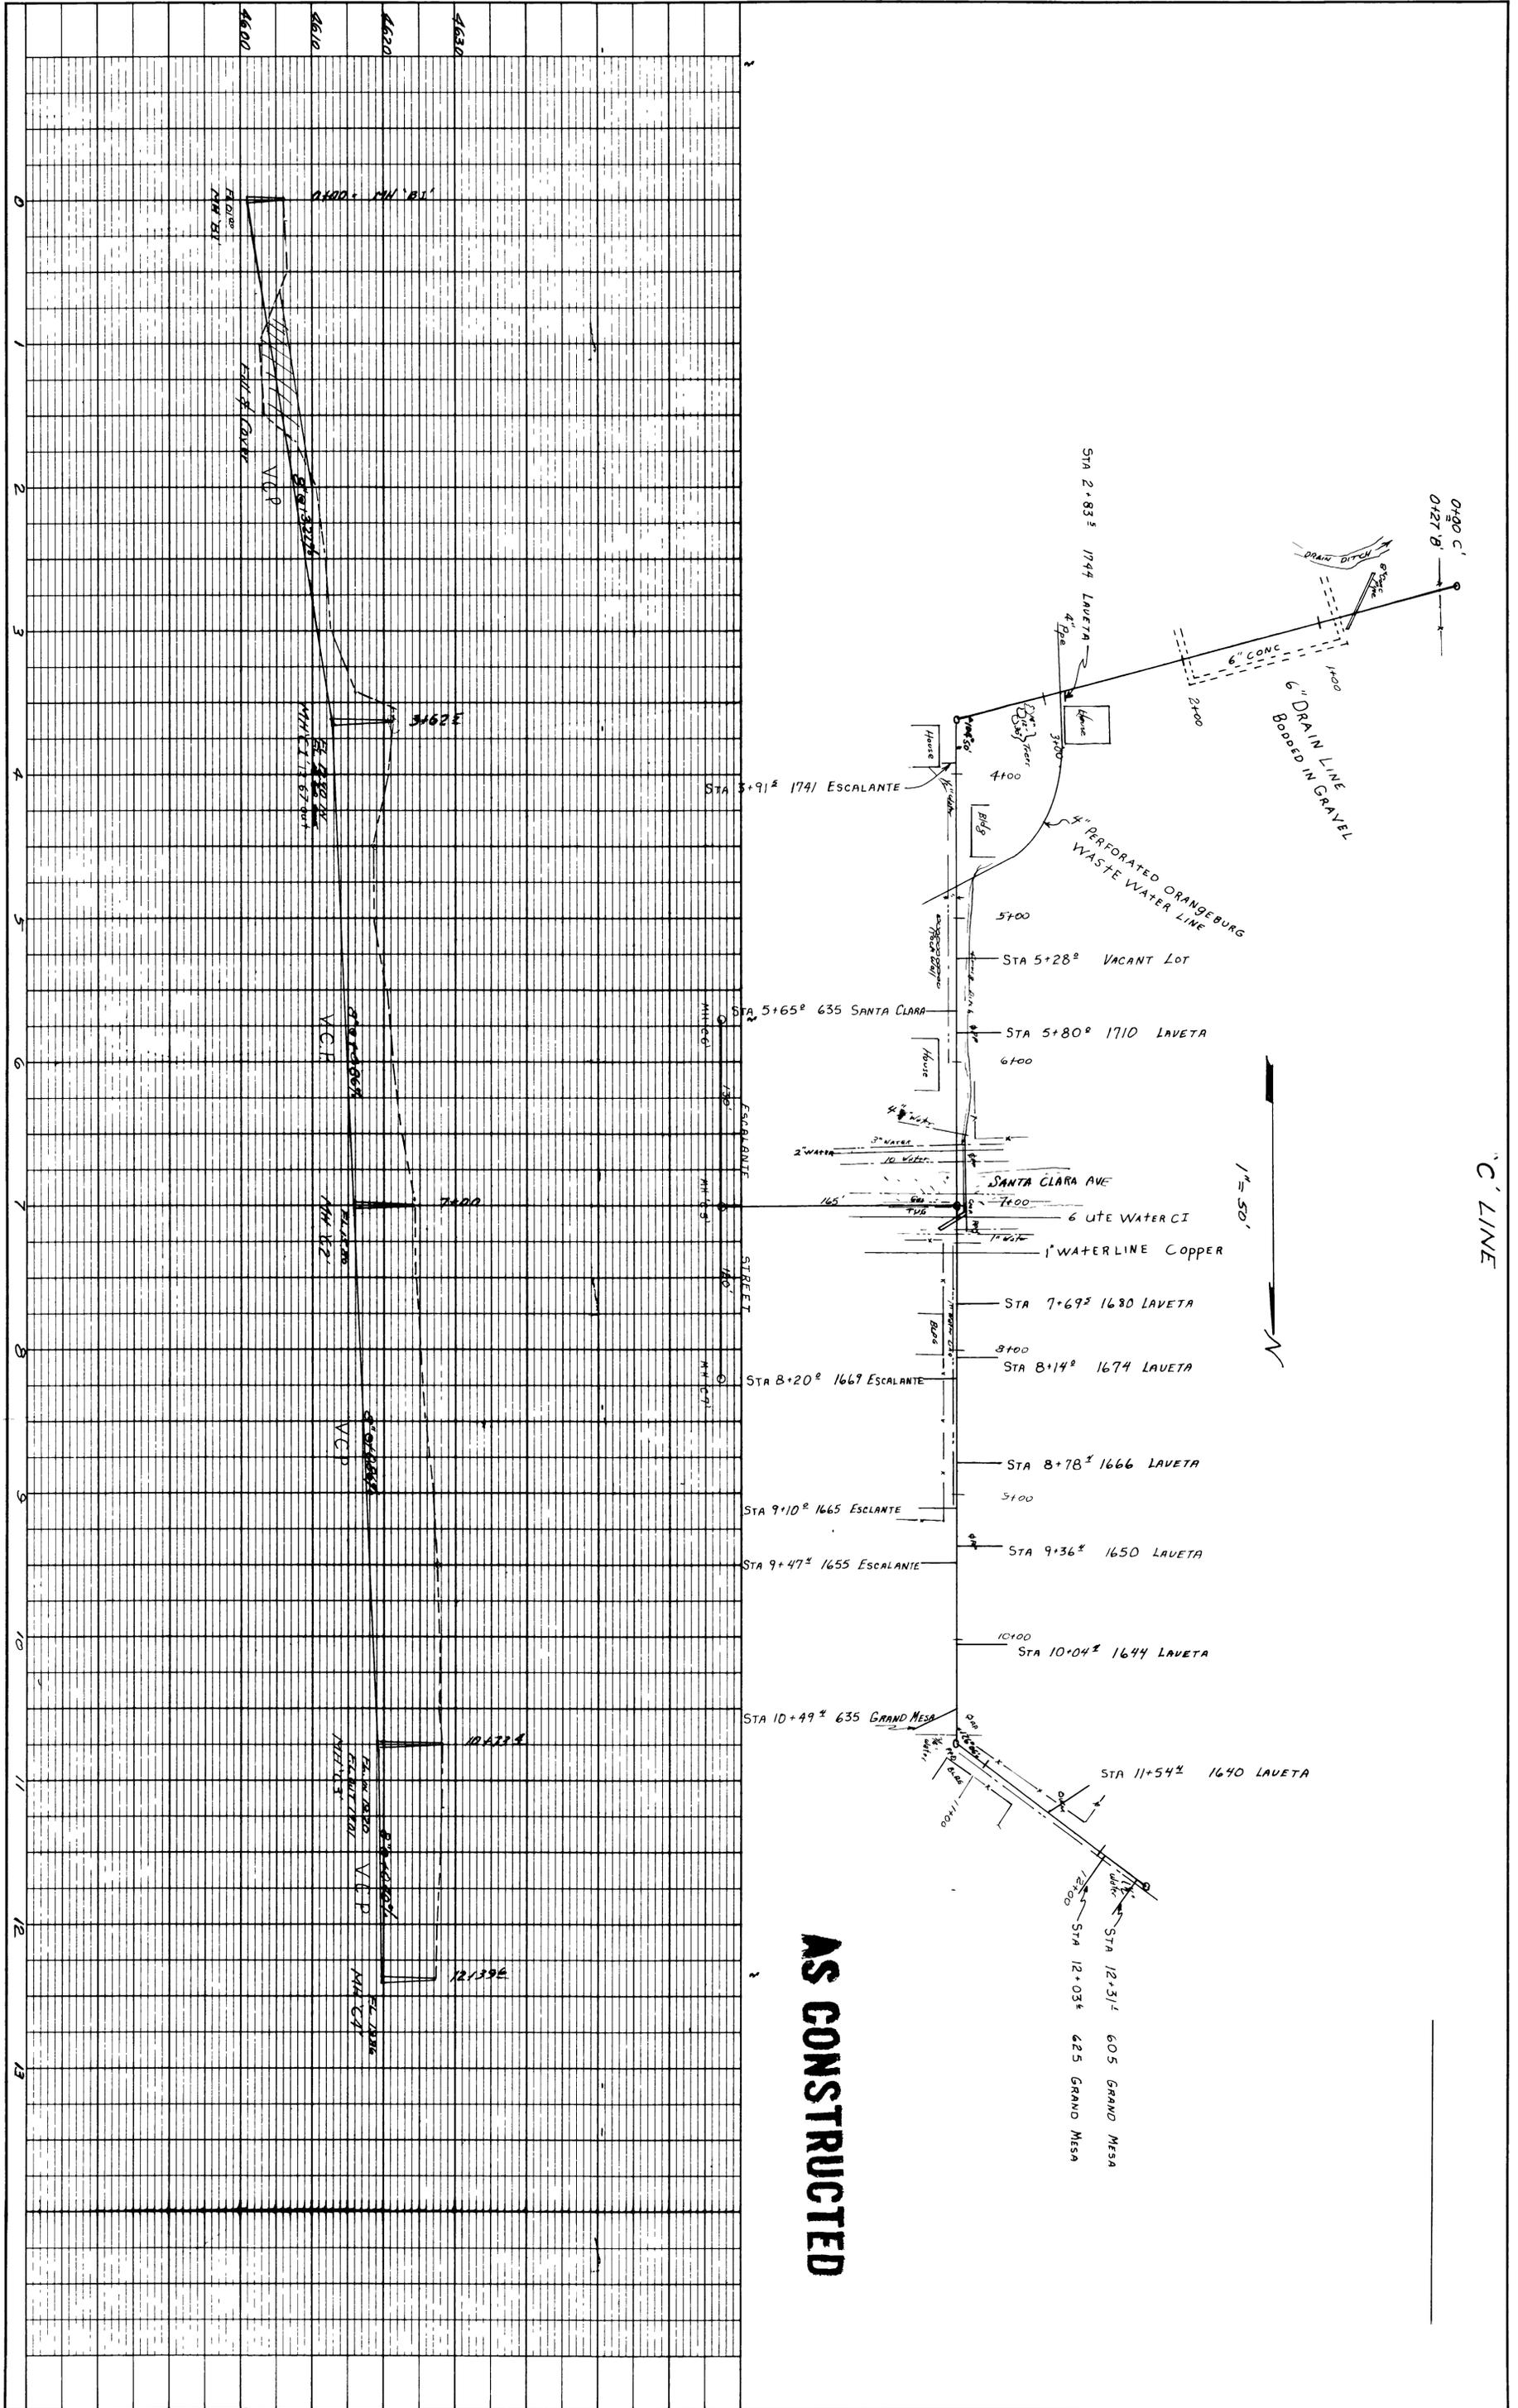

AS CONSTRUCTED

C' LINE

1" = 50'


HOE PLATE 1, PLAN PROFILE
487008 MADRID, N.M.

02010006.tif

SHEET NO. 5
02-451-02-100







DATE	
BY	
REVISION	
PLAN	
NOTE BOOK	
NO.	

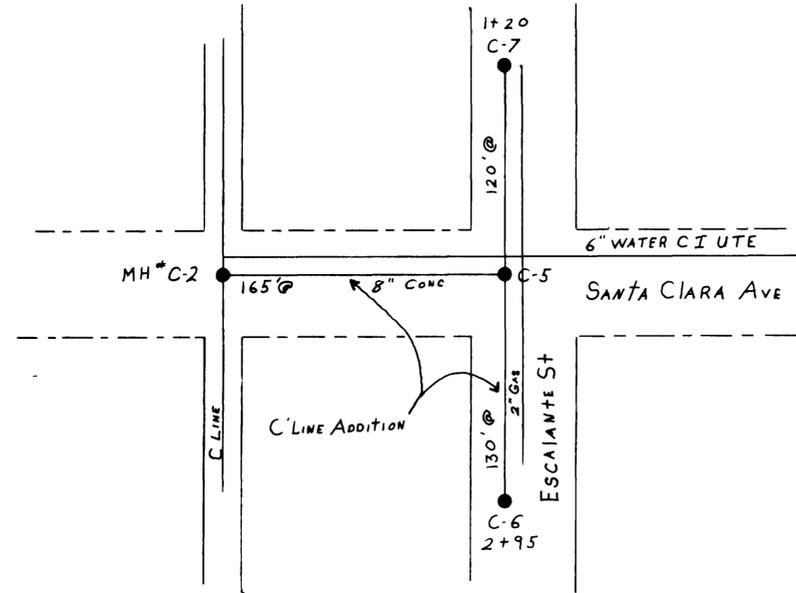


AS CONSTRUCTED

DATE	
BY	
REVISION	
PROFILE	
NOTE BOOK	
NO.	


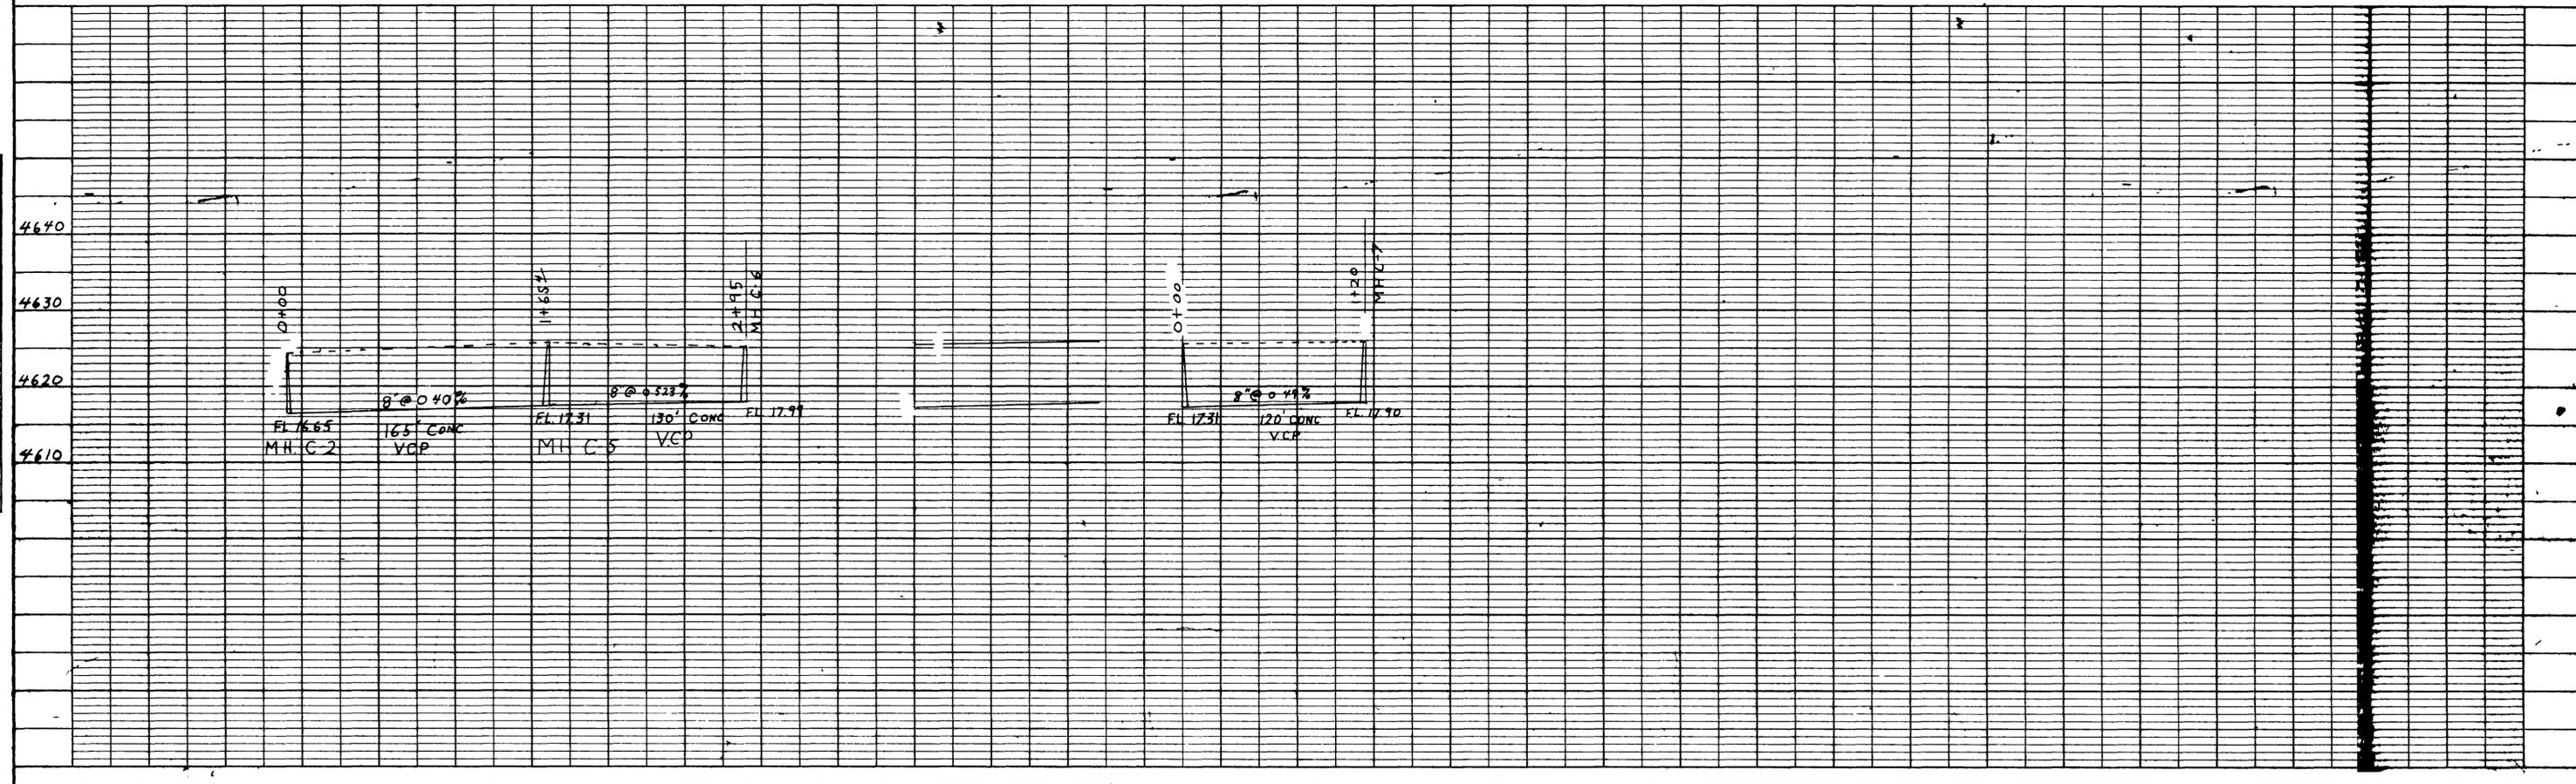


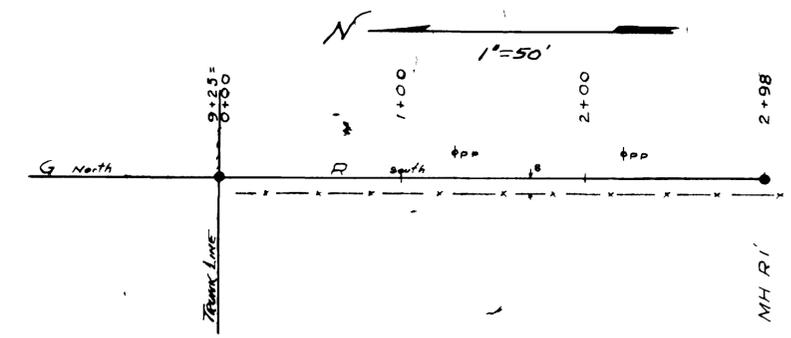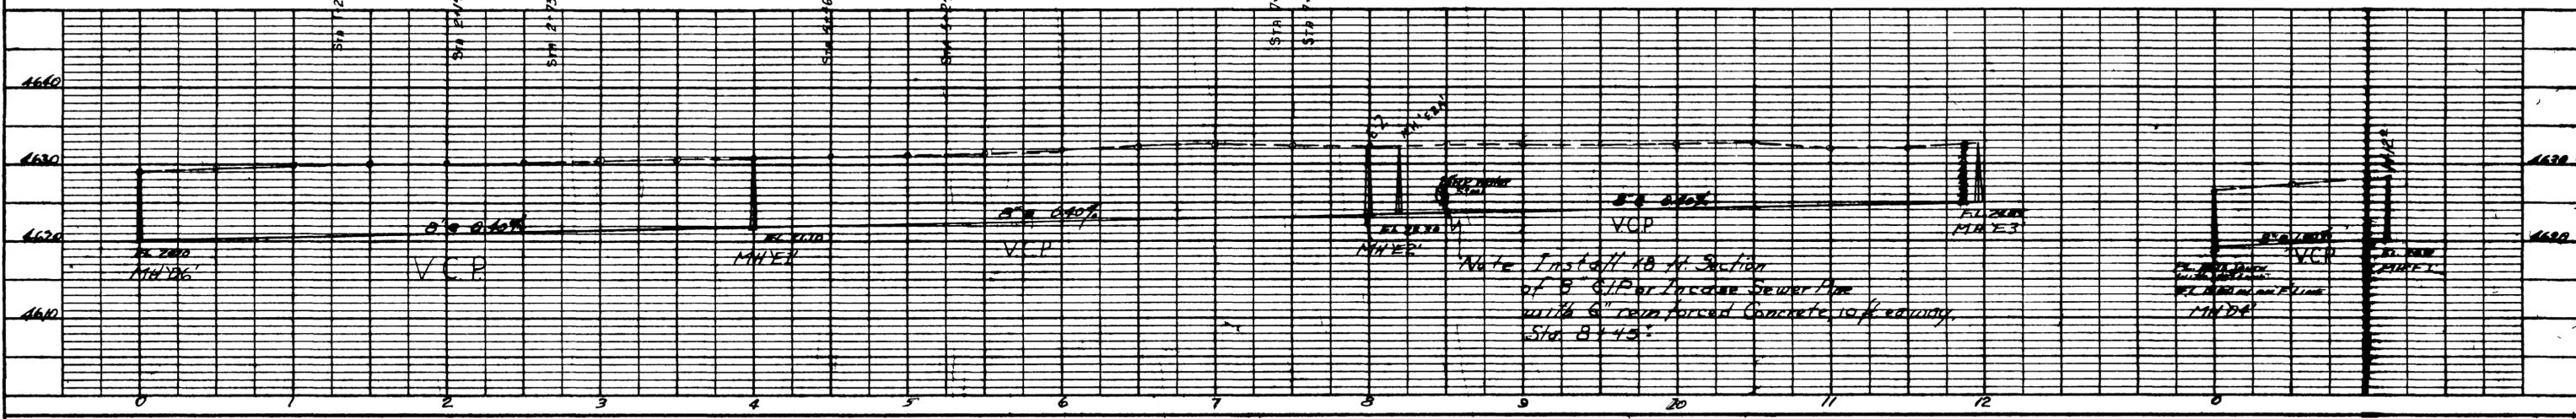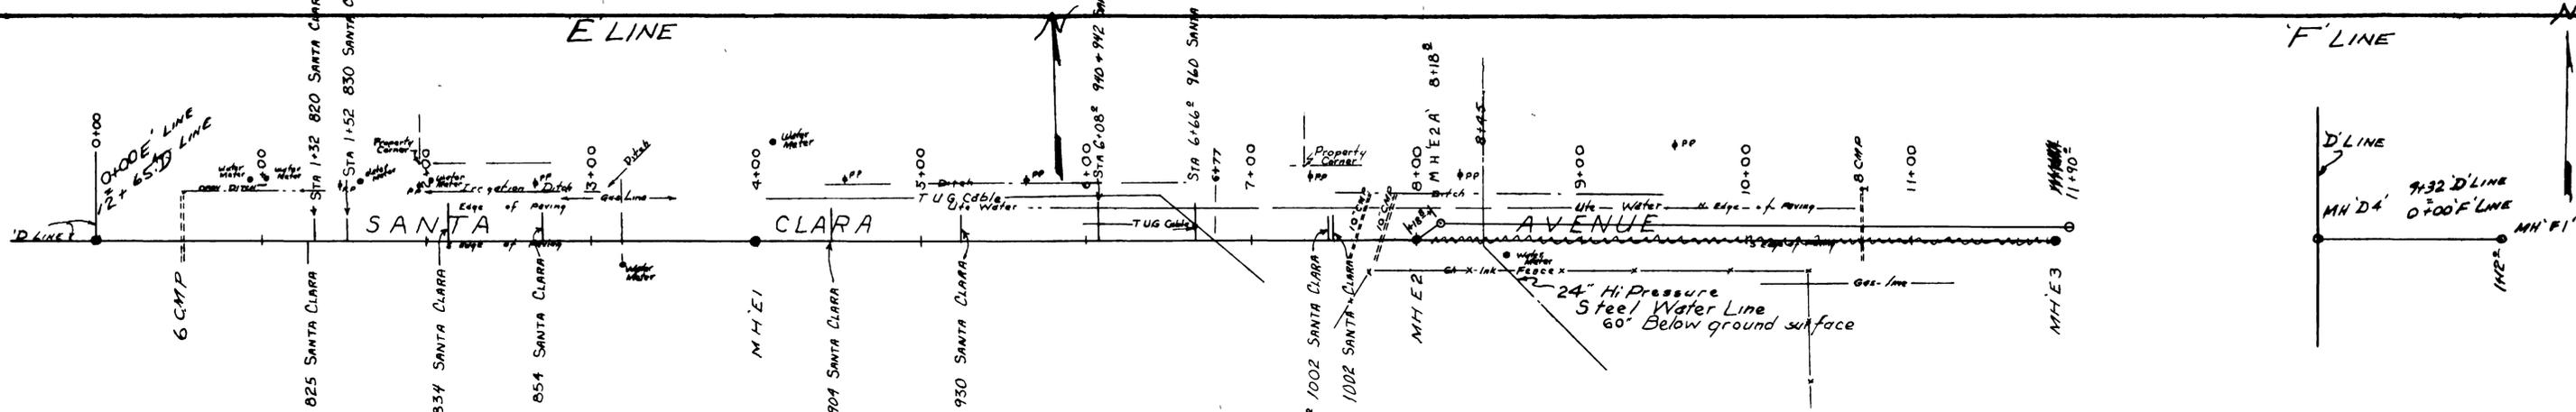



AS CONSTRUCTED

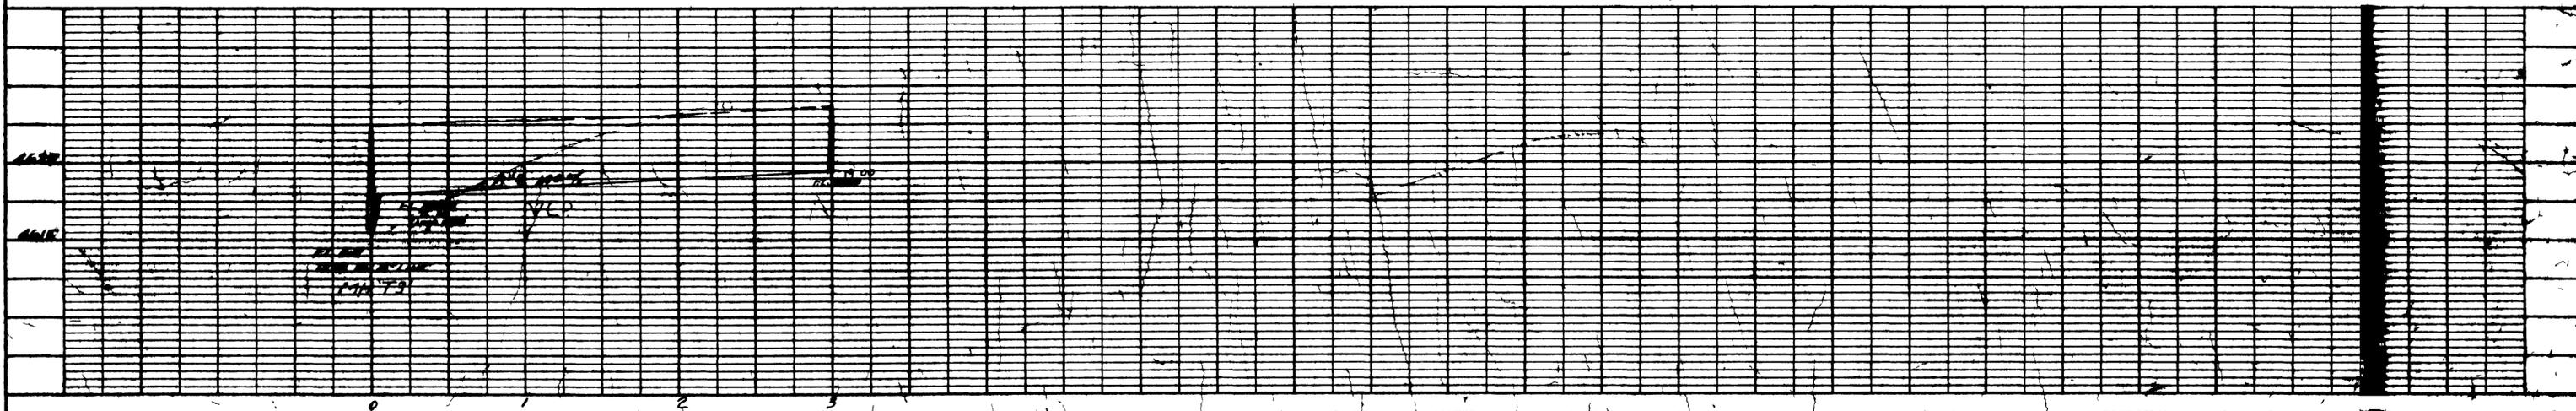

PLAN
NOTE BOOK
NO. 307
NO. 308

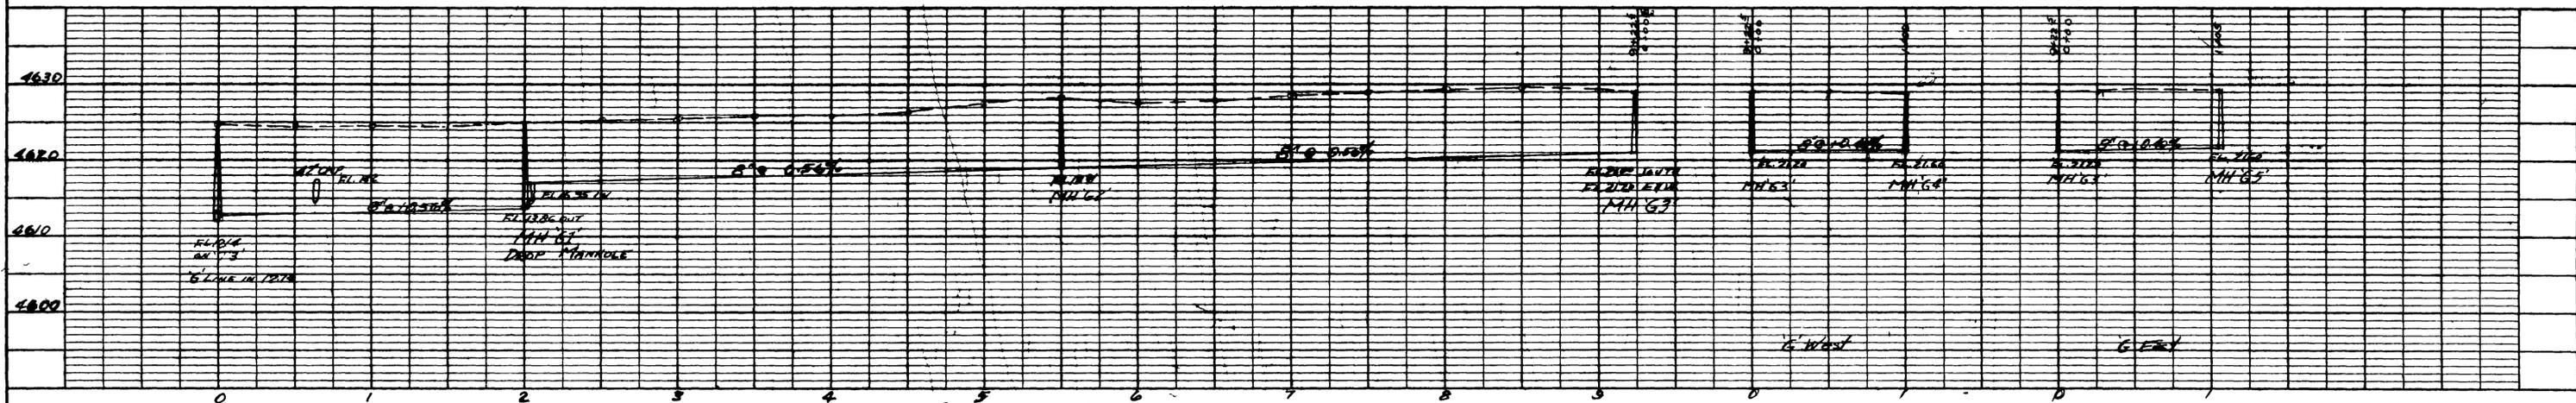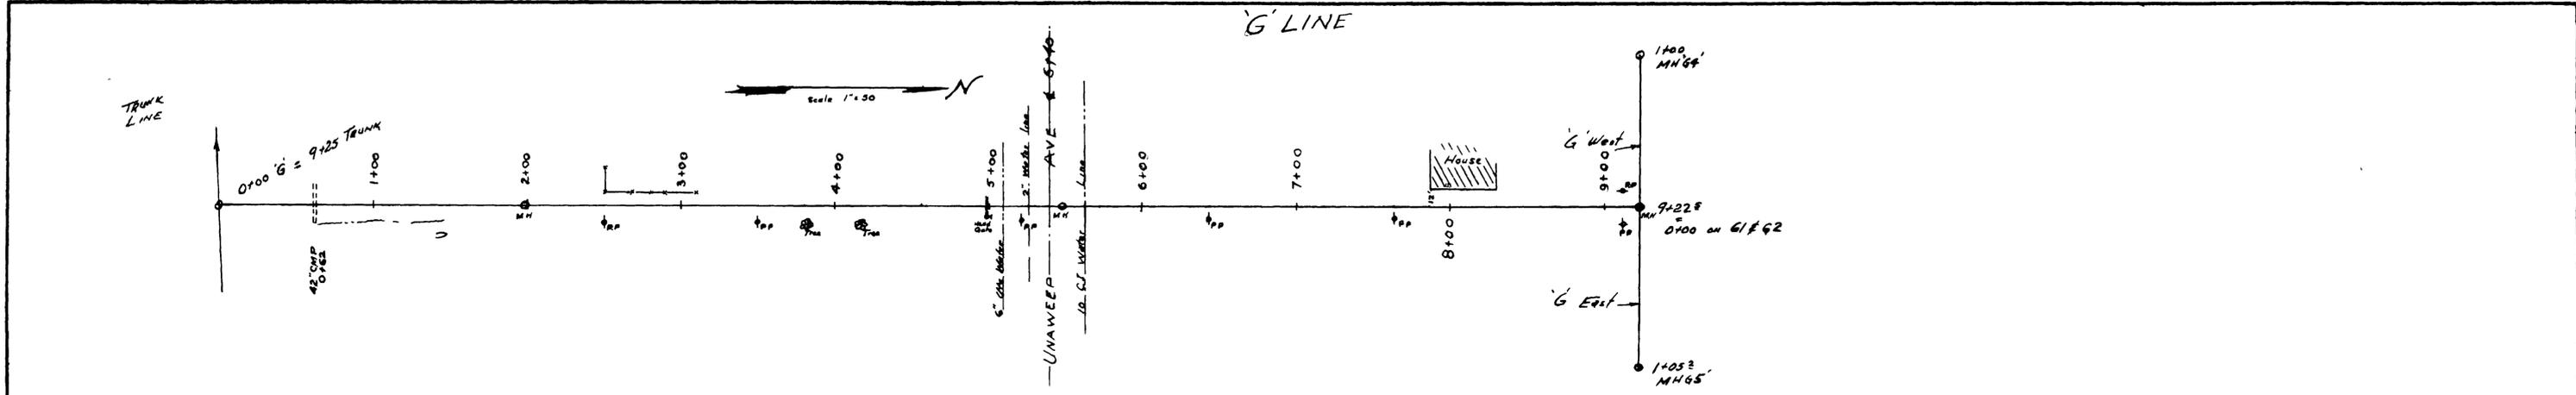


PROFILE
NOTE BOOK
NO. 307
NO. 308

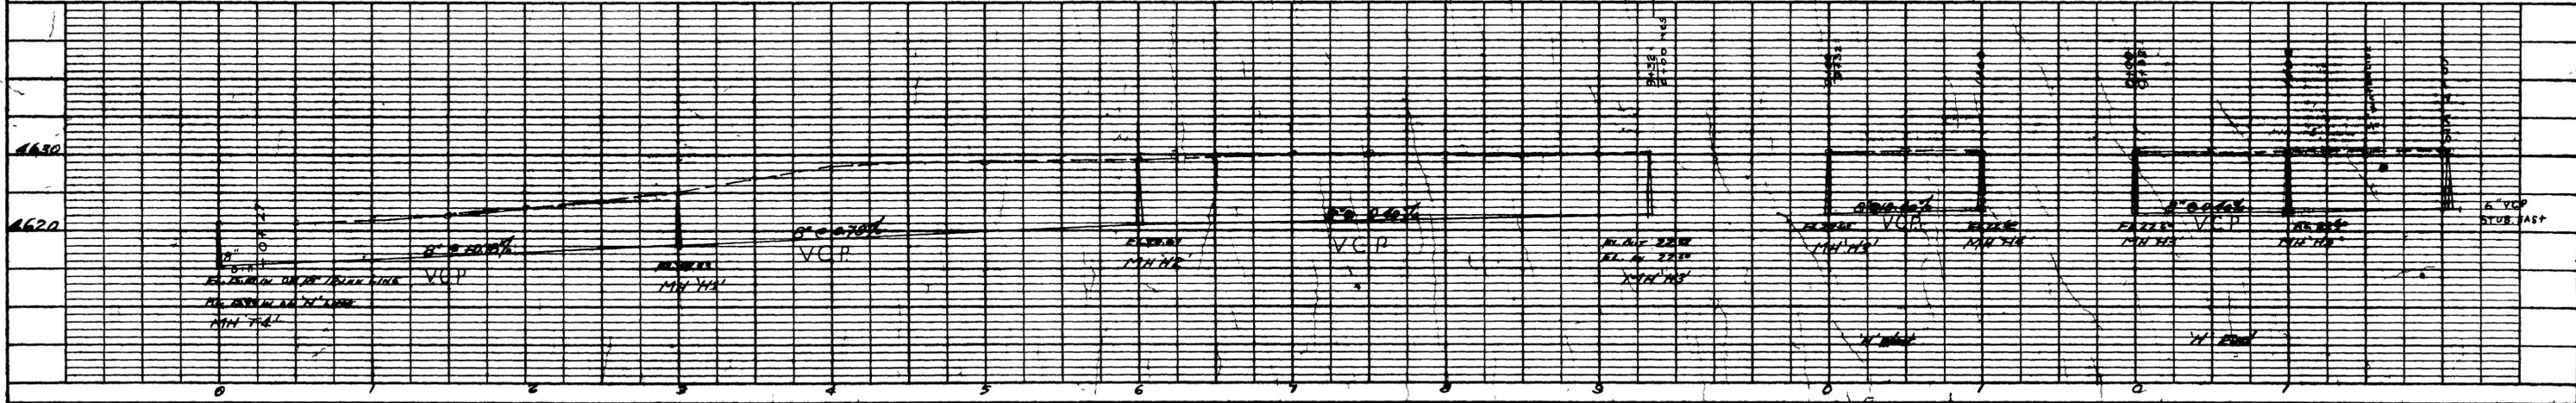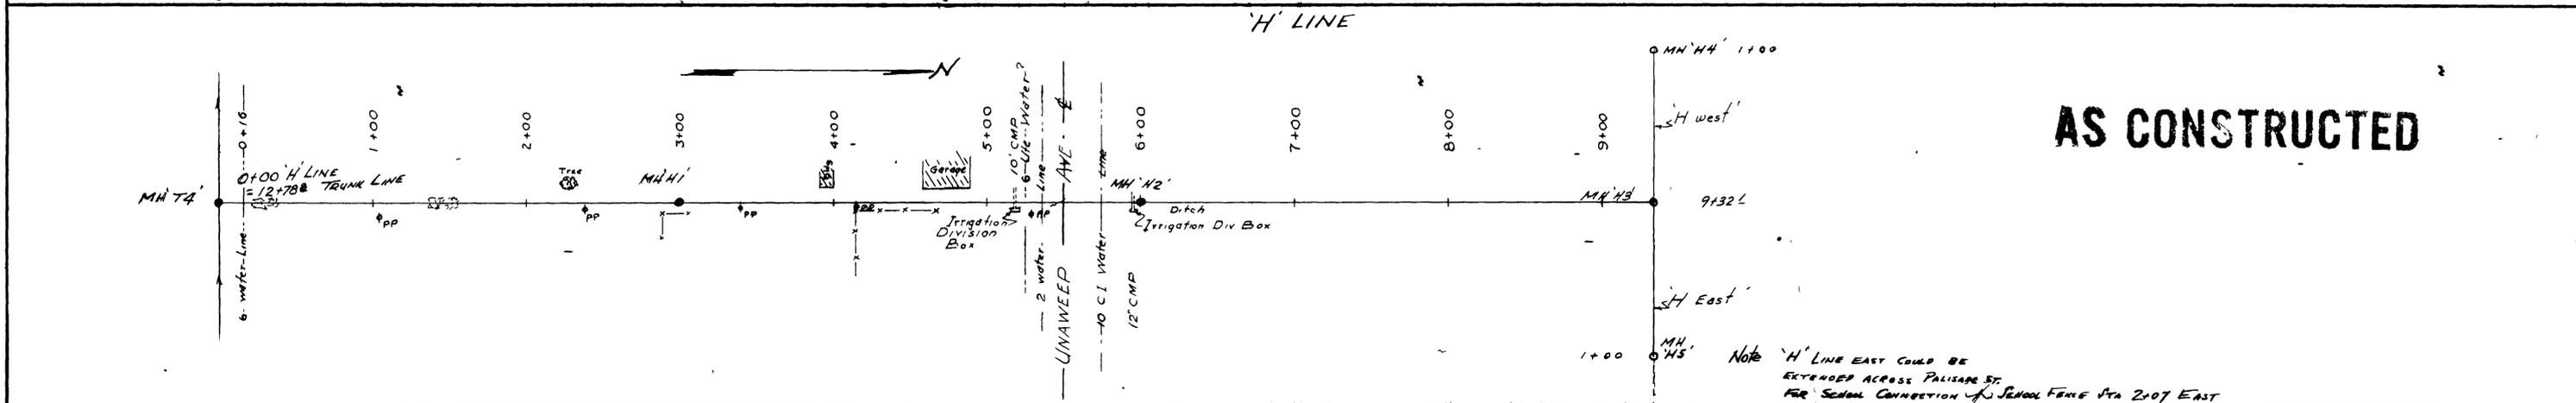


AS CONSTRUCTED

Note 0+00 ON "H" LINE DIP FOR WATER LINE CROSSING


J' LINE

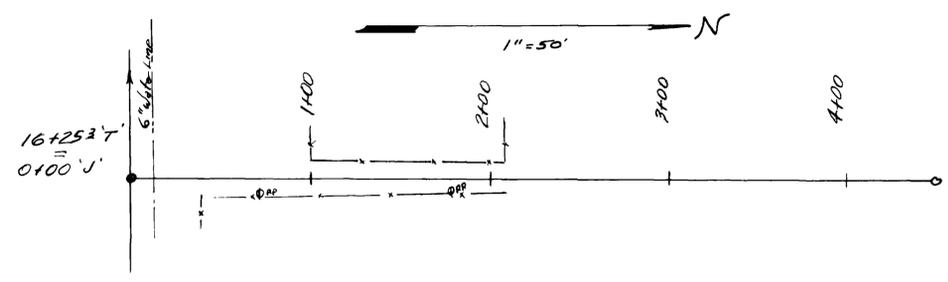

PLAN
NOTE BOOK
NO. 207
NO. 208

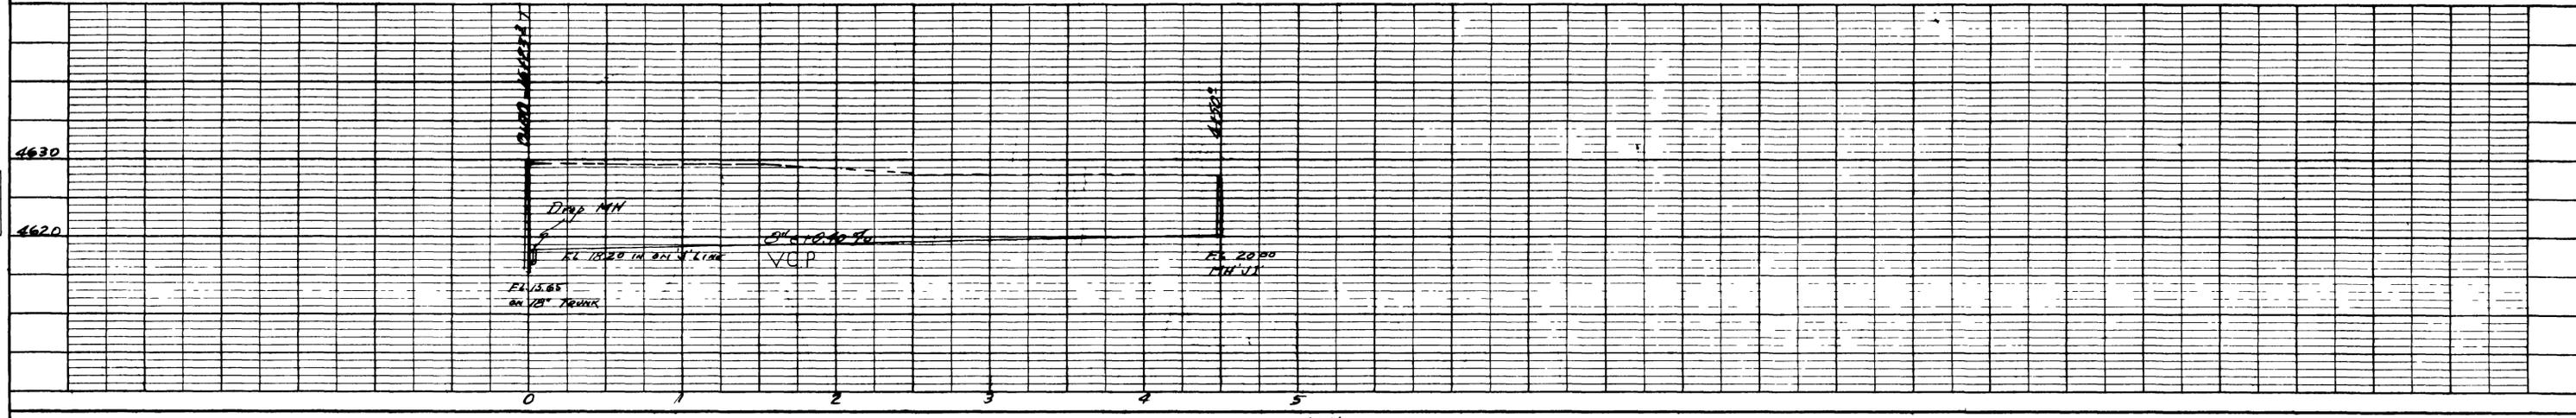


K' LINE

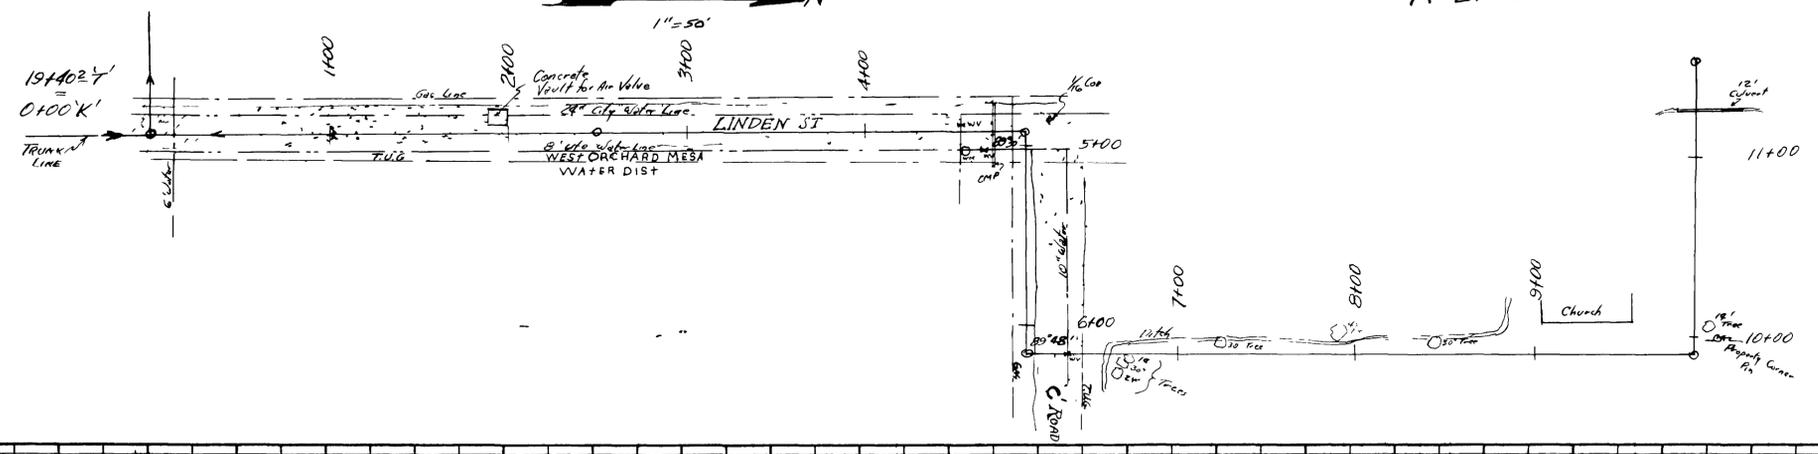



AS CONSTRUCTED

PROFILE
NOTE BOOK
NO. 207
NO. 208

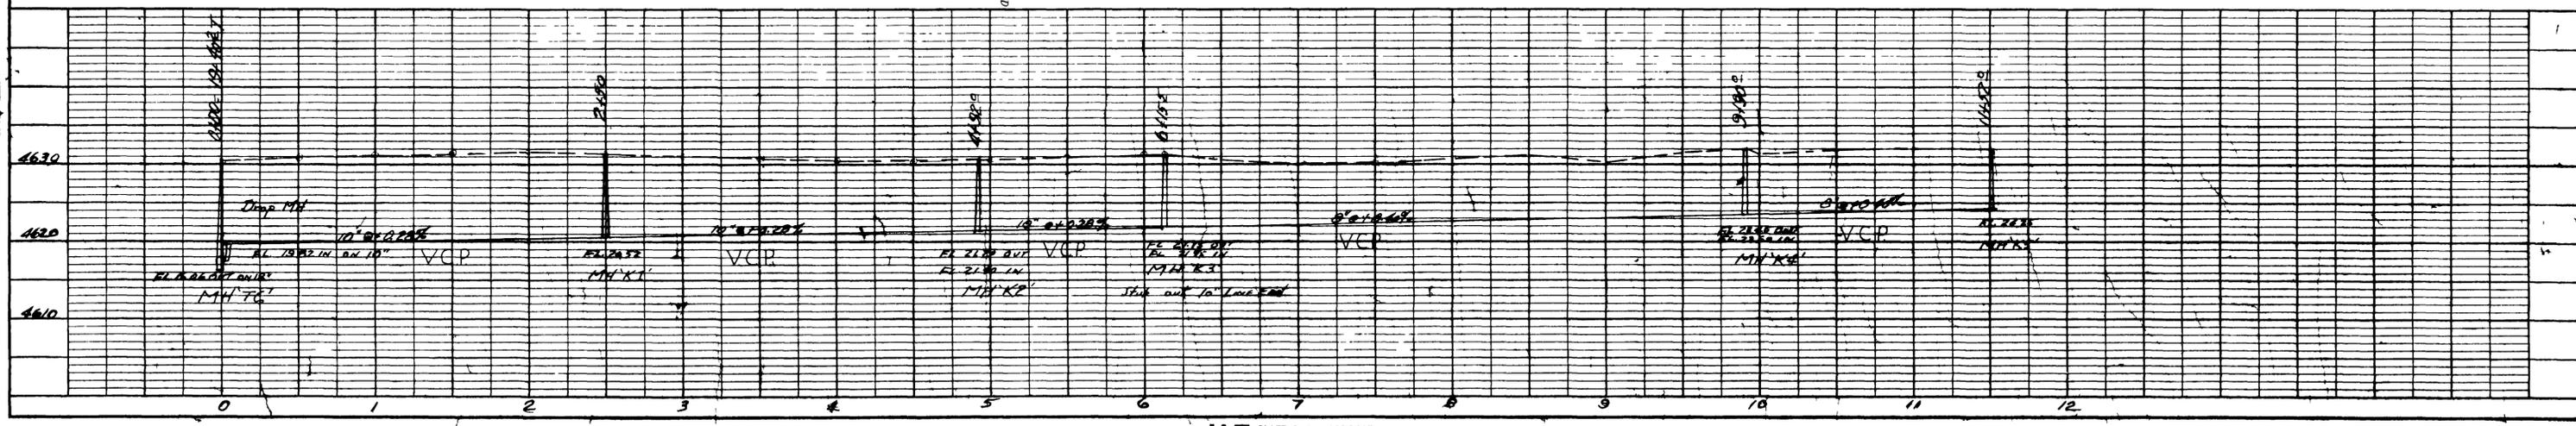


'L' LINE

'M' LINE

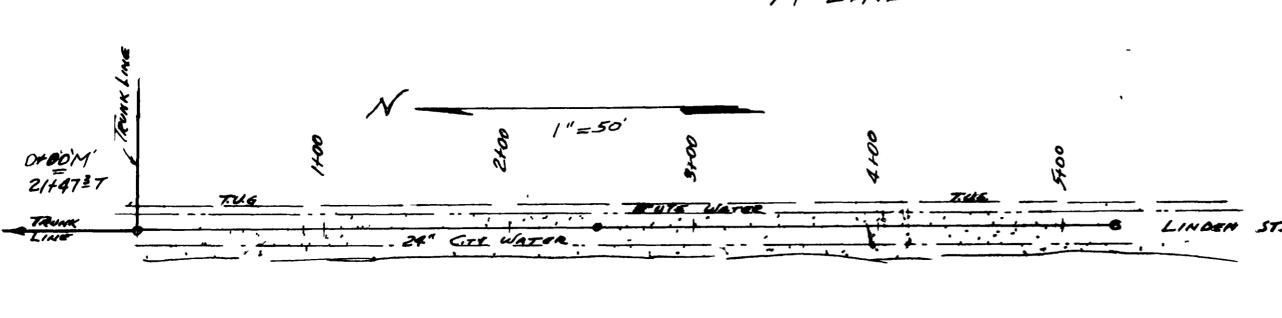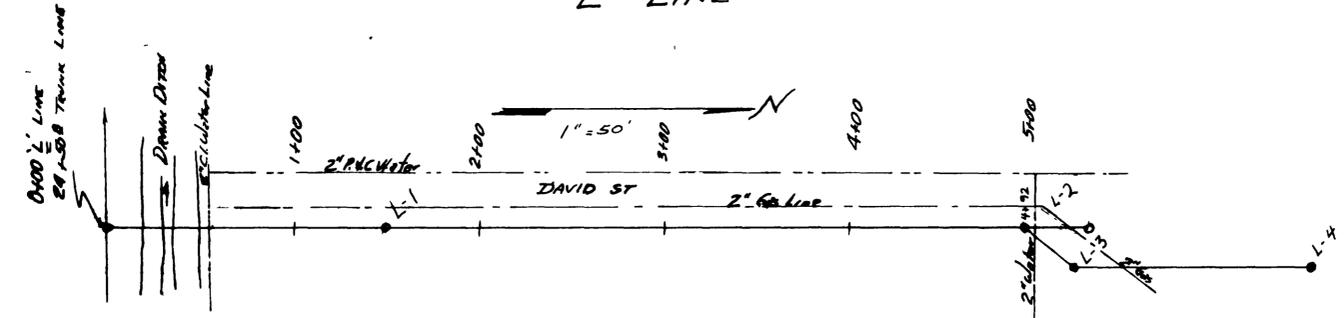

NOTE LOWERED
'M' LINE 1' GRADE
REMAINS SAME

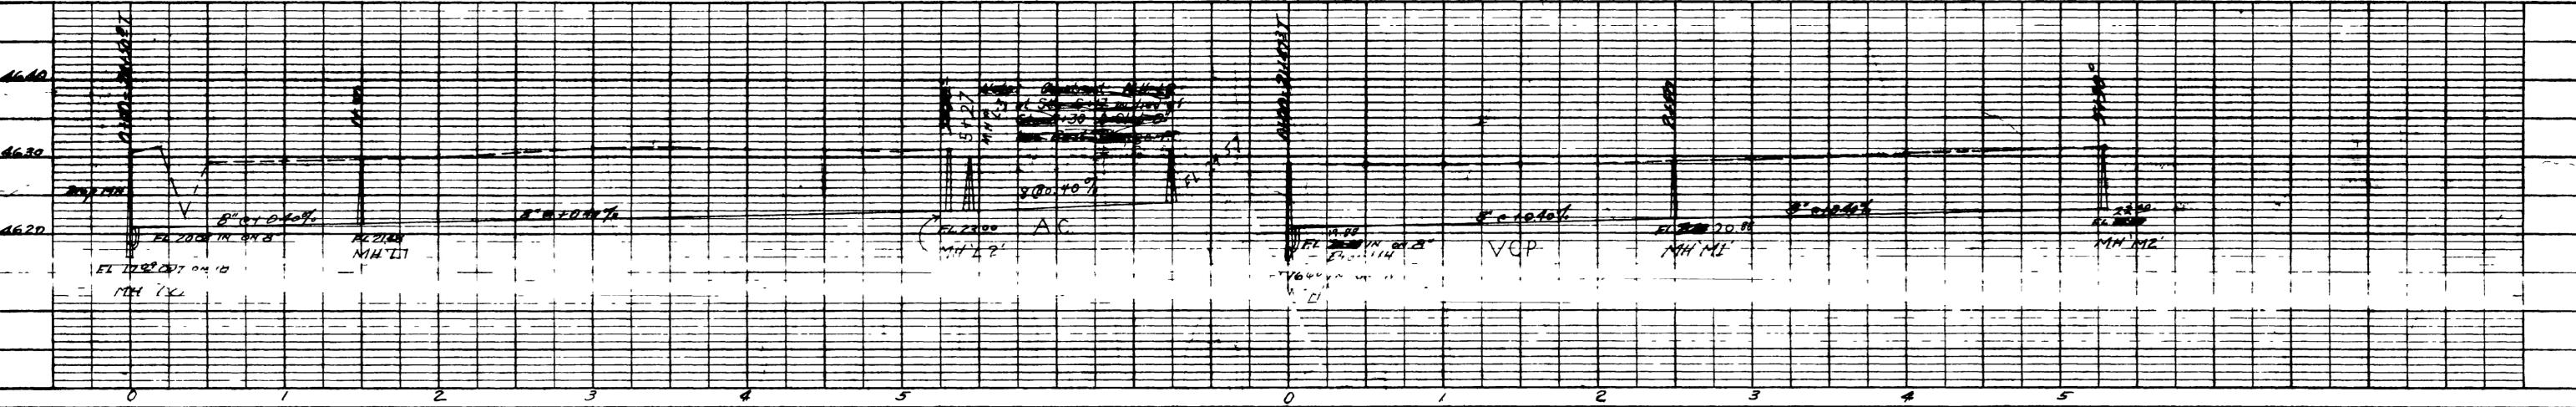

'N' LINE

'P' LINE

AS CONSTRUCTED

