


PLAN SCALE 1" 100'
PROFILE SCALE 1 = 10



SURVEYORS CERTIFICATE
I hereby certify that a field survey was conducted under my supervision on December 15 & 16 1976 of the sewer system shown hereon and that this plat is a true representation of said survey, to the best of my knowledge and belief

Luther T Musgrave
Luther T Musgrave L S 10386

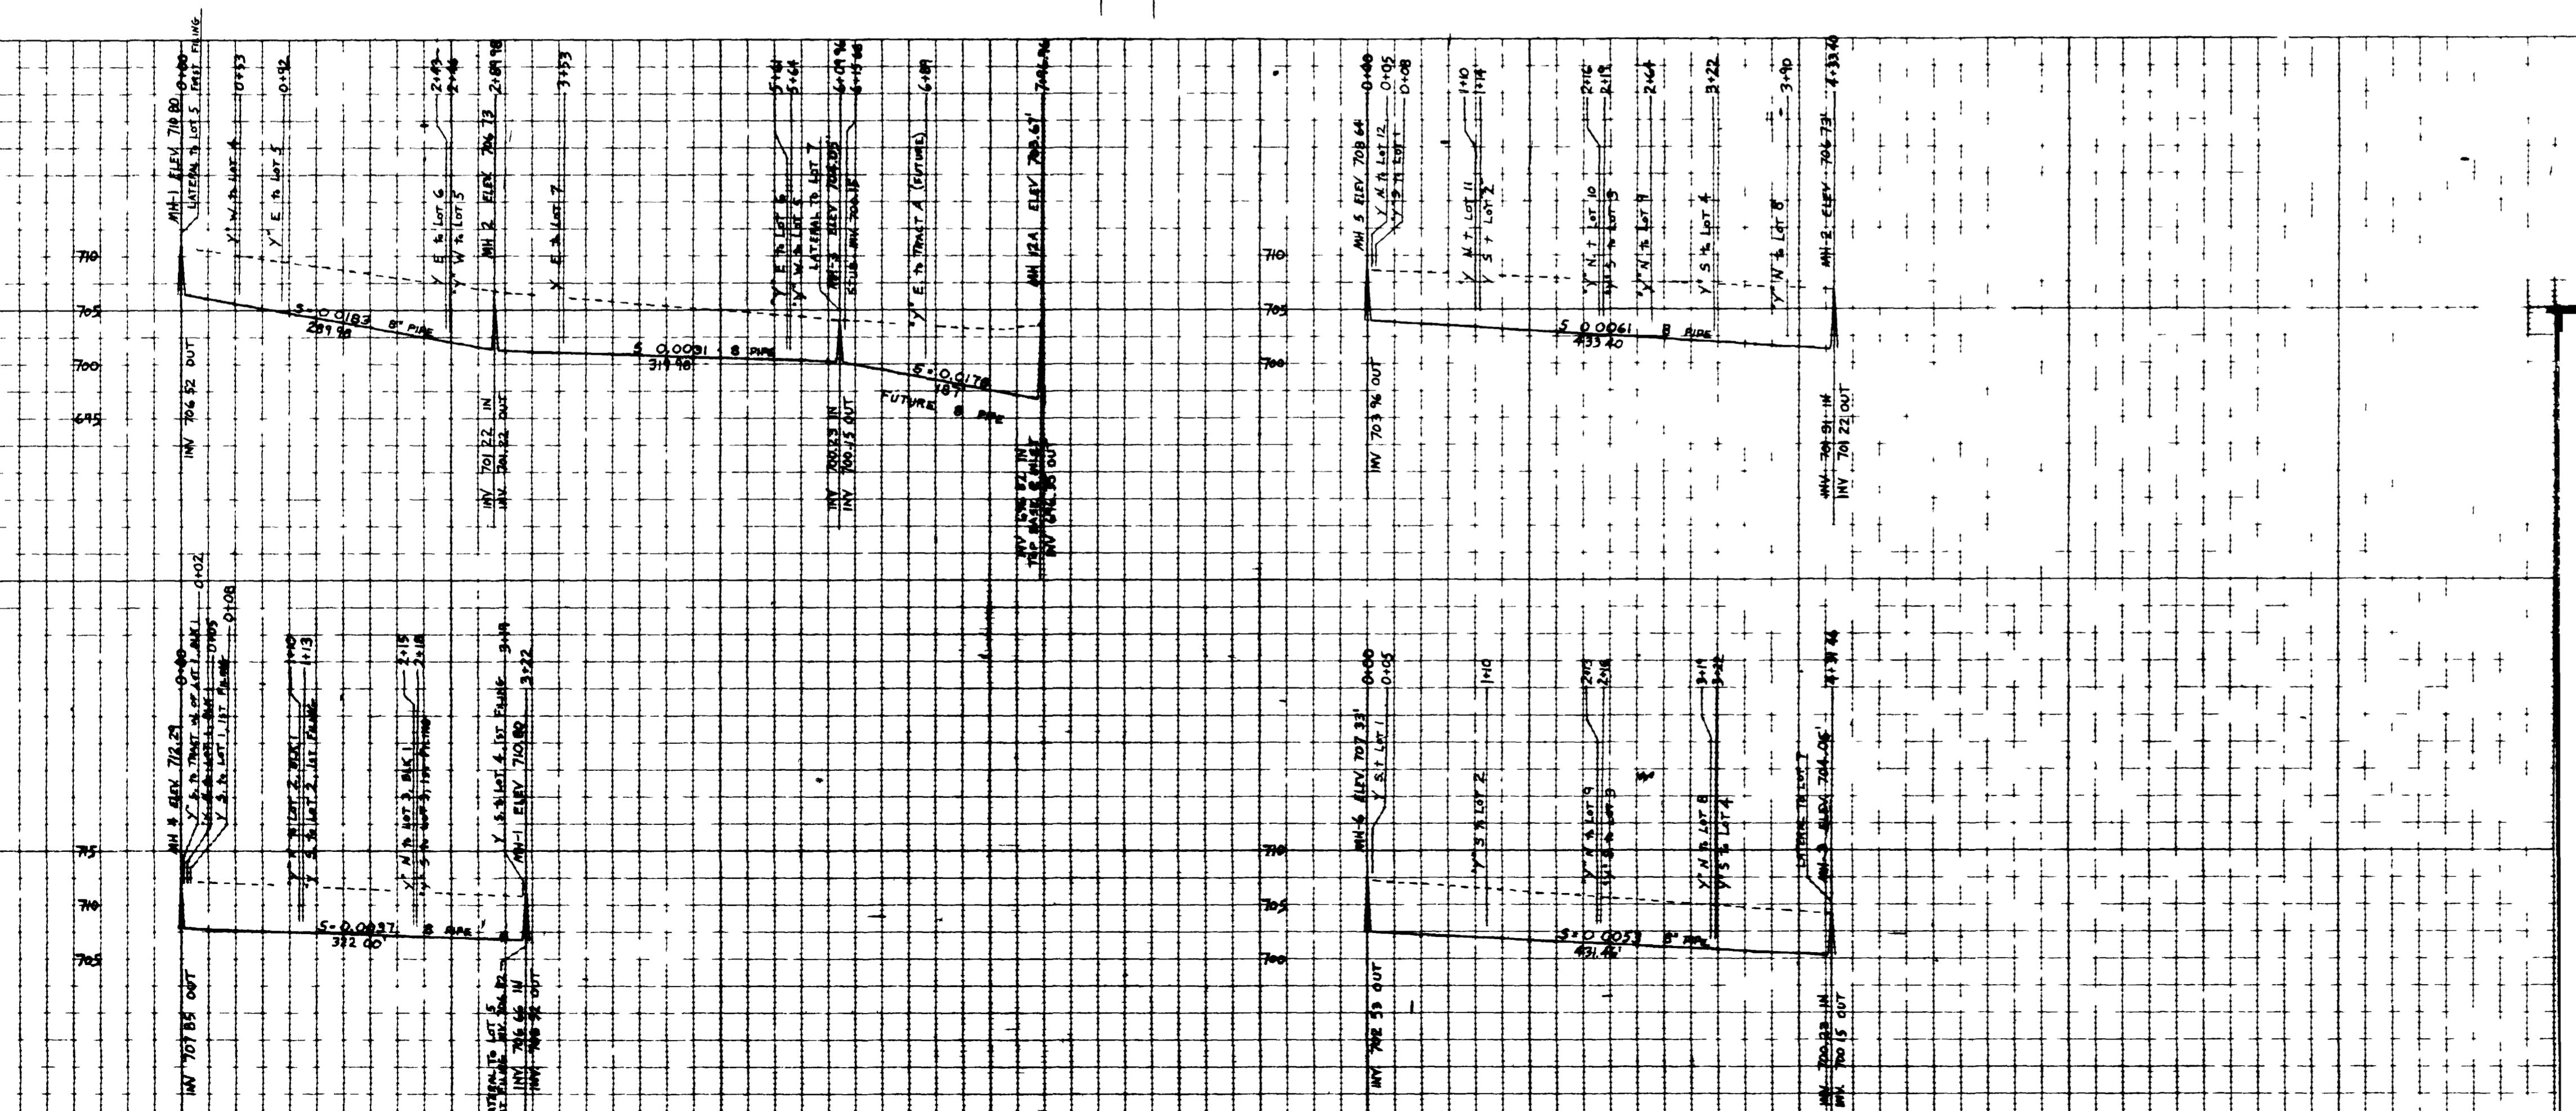

AS ~~UNIT~~
SANITARY SEWER
PLAN & PROFILE
BALDWIN ~~SUPERVISION~~
FIRST & SECOND FILING

FOR
(OWNERS & SUBSIDERS)
KENNETH C & FRANCES I BALDWIN
2947 B ROAD
GRAND JUNCTION, COLORADO 81501
PHONE 242-0411