
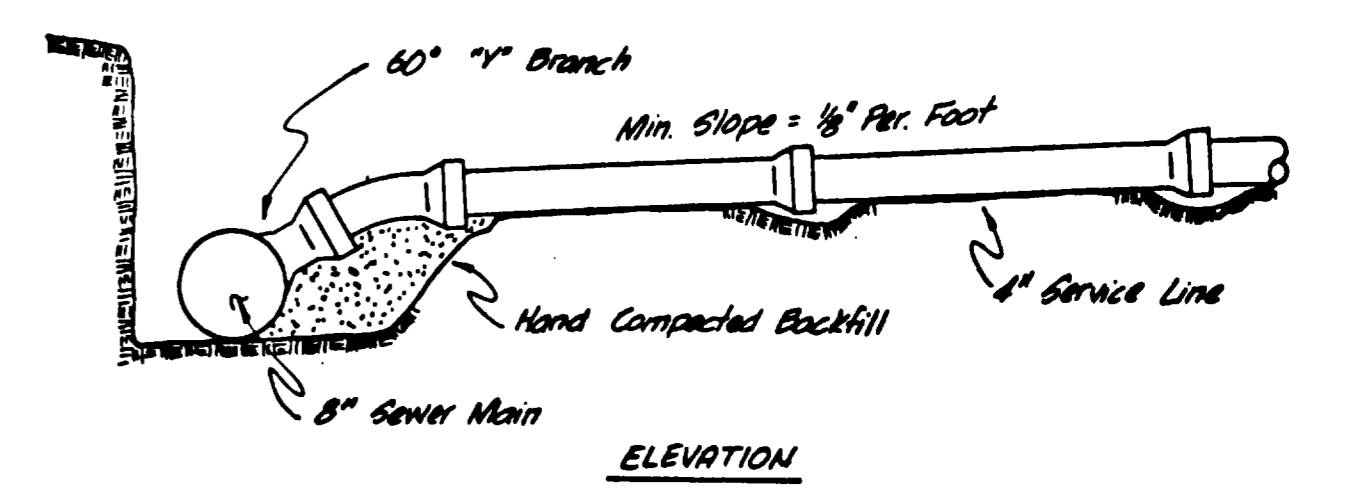
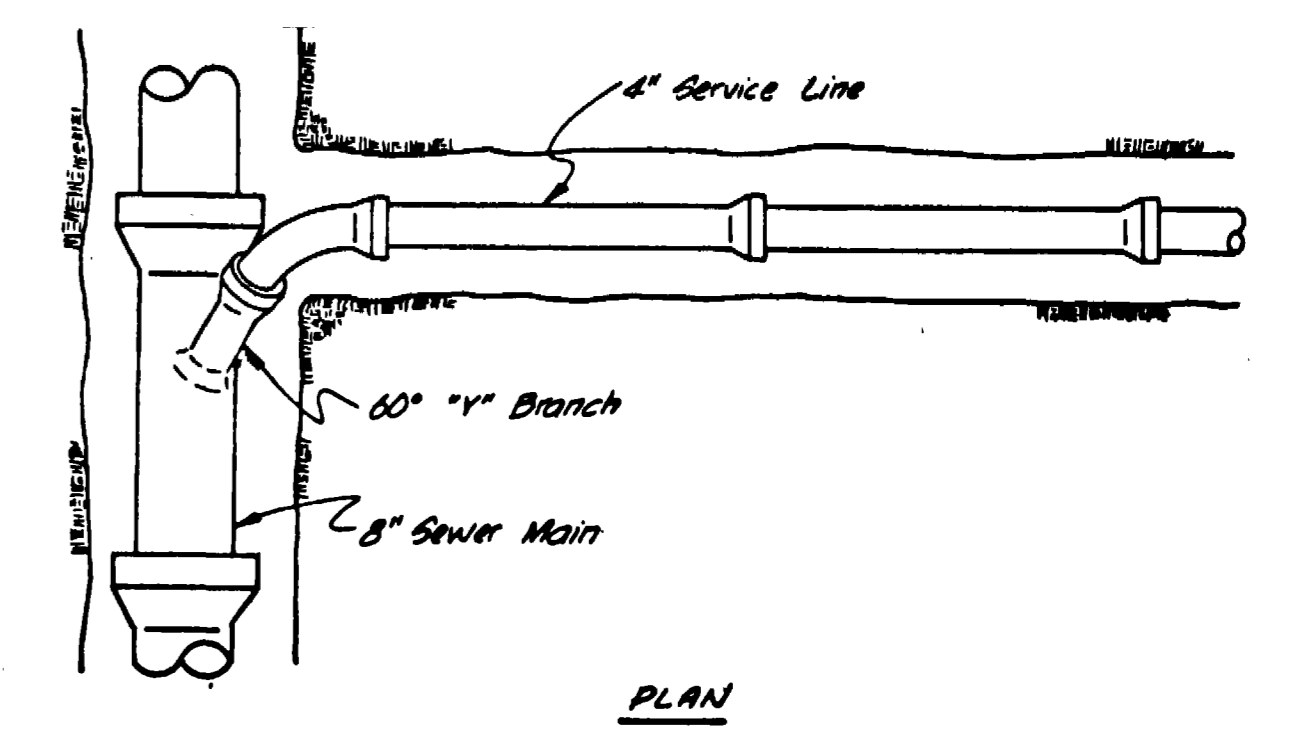


NOTE
STREET CONTRACTOR IS TO ADJUST LID AND RING TO FINISH GRADE AND PROVIDE CEMENT GROUT.

NOTE
TOP ECCENTRIC CONE TO BE SET LEVEL WITH TOP SUBGRADE

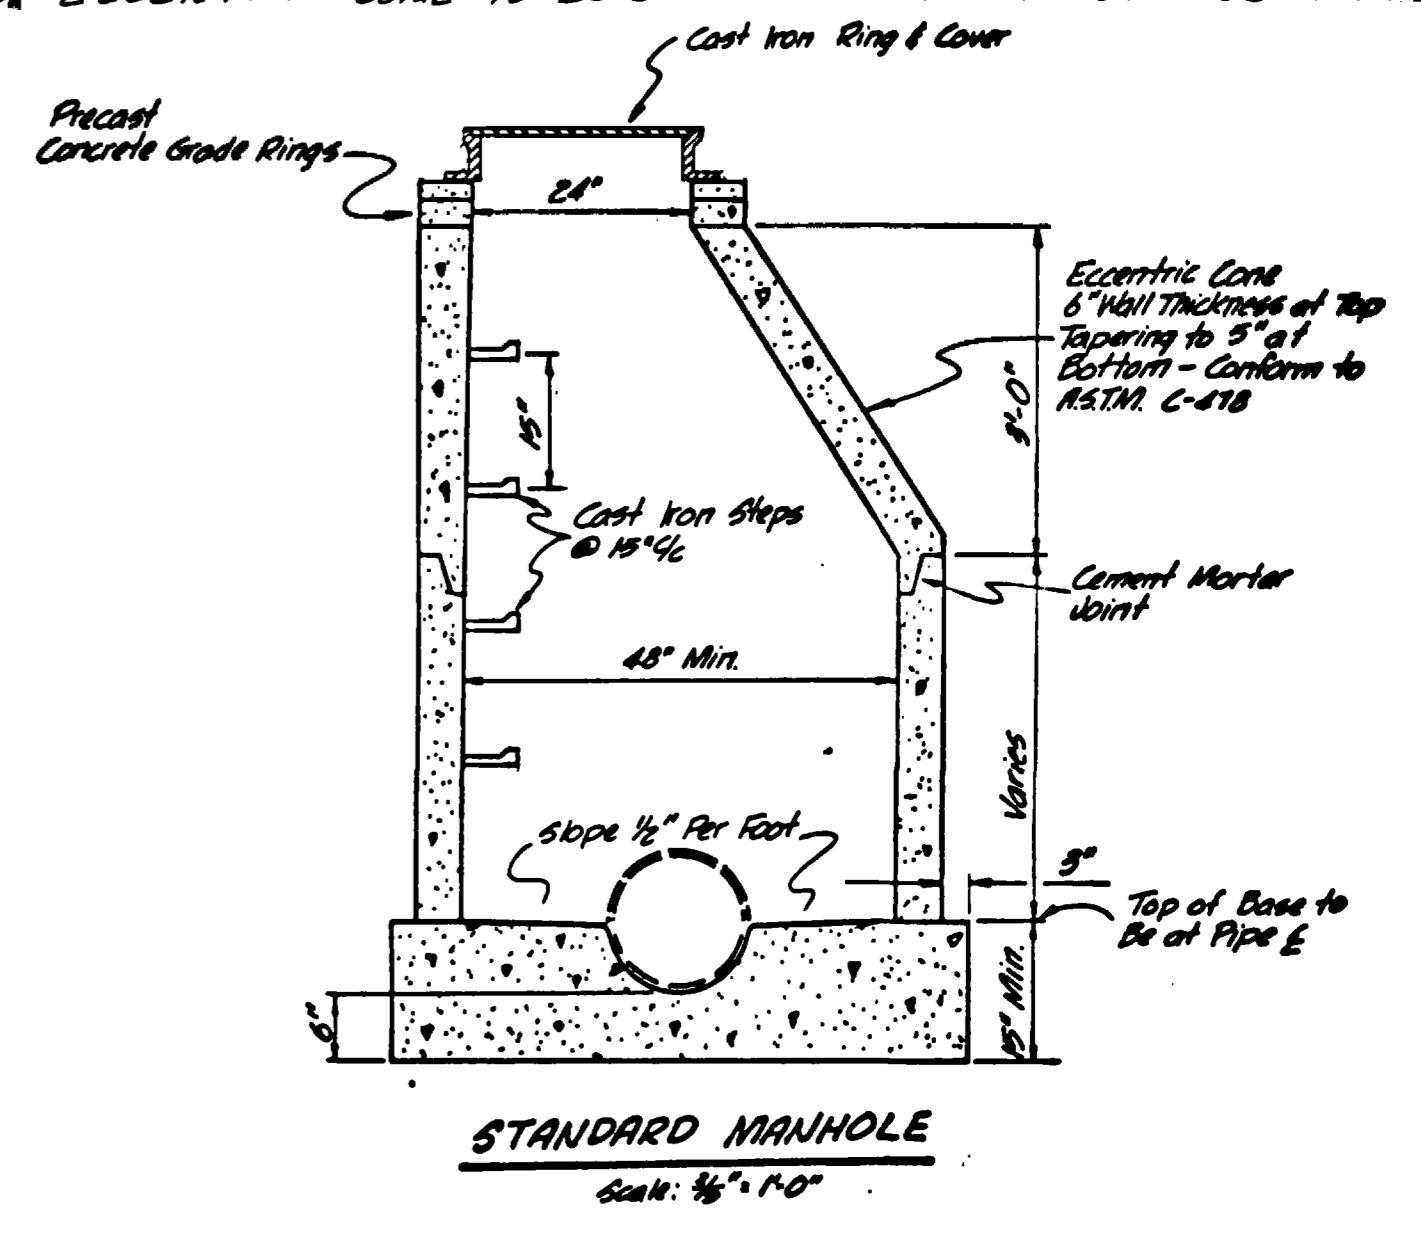




STANDARD SERVICE CONNECTION
No Scale

QUANTITIES
1416 LF 8" SANITARY SEWER
5 MANHOLES
25 - 4" SERVICE LINES

AS BUILT DRAWING

APPROVED: *Jack J. Selman* Date: 2/14/77
Central Grand Valley Sanitation District



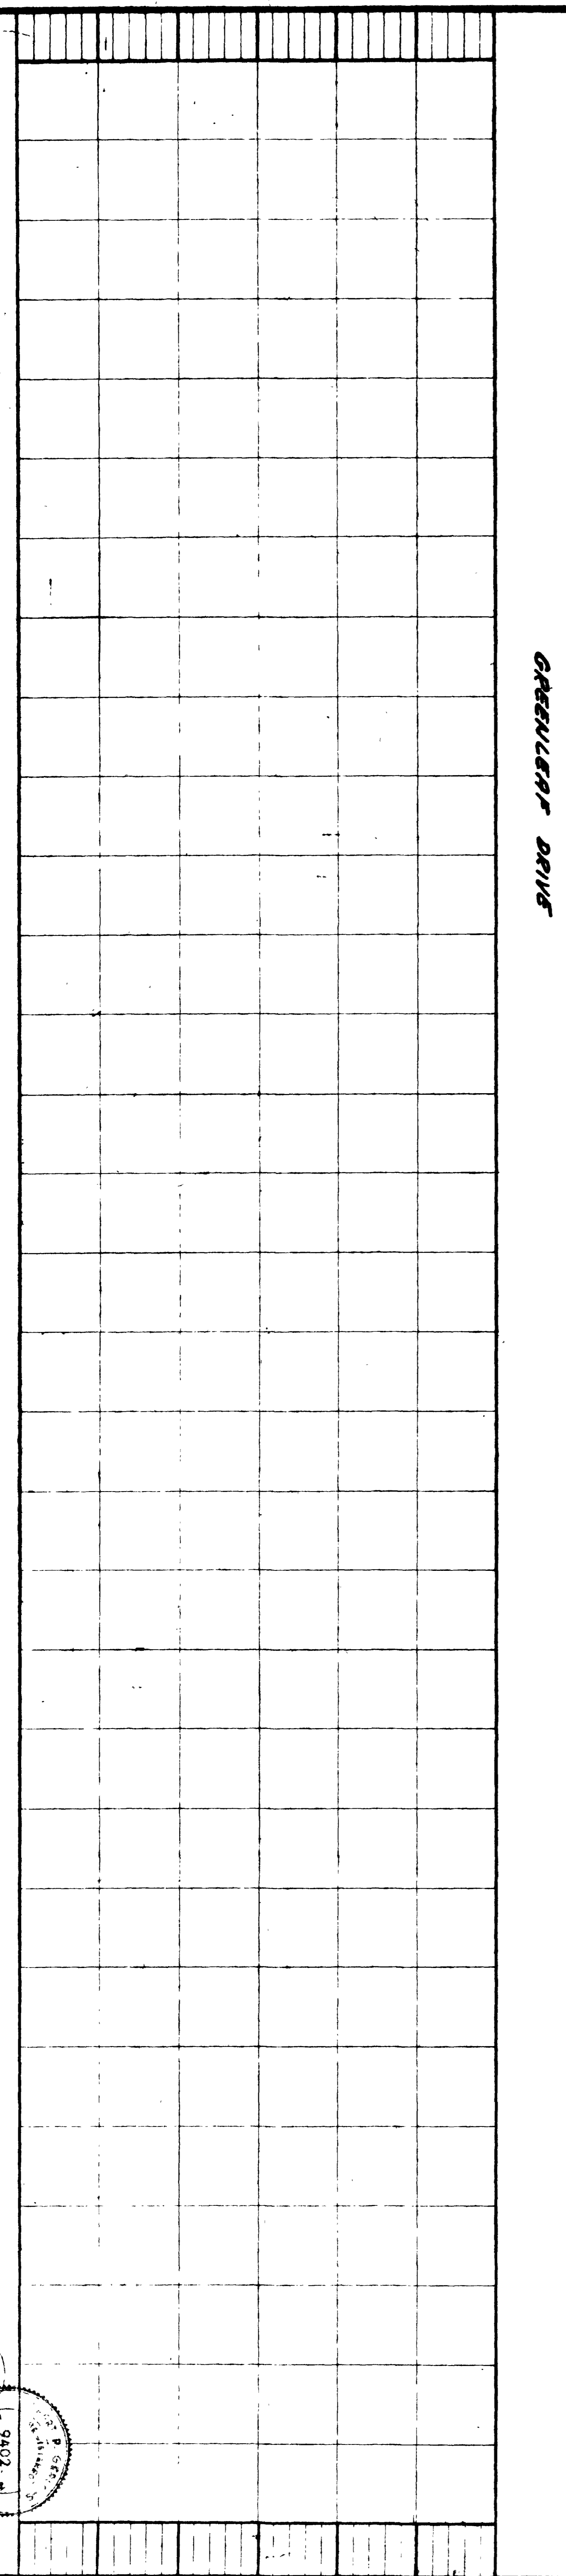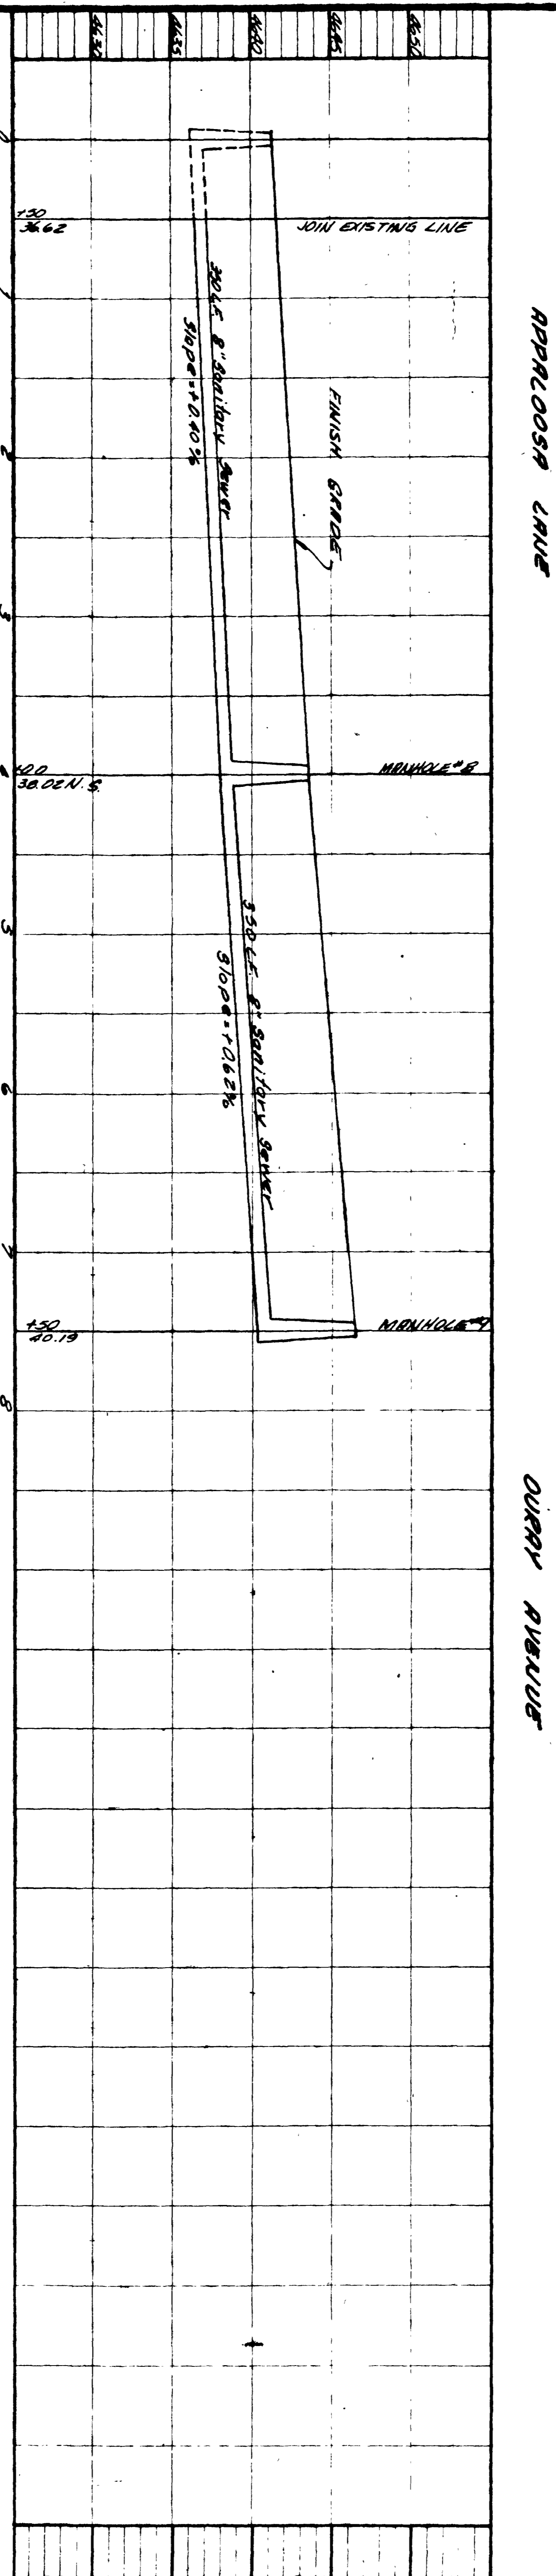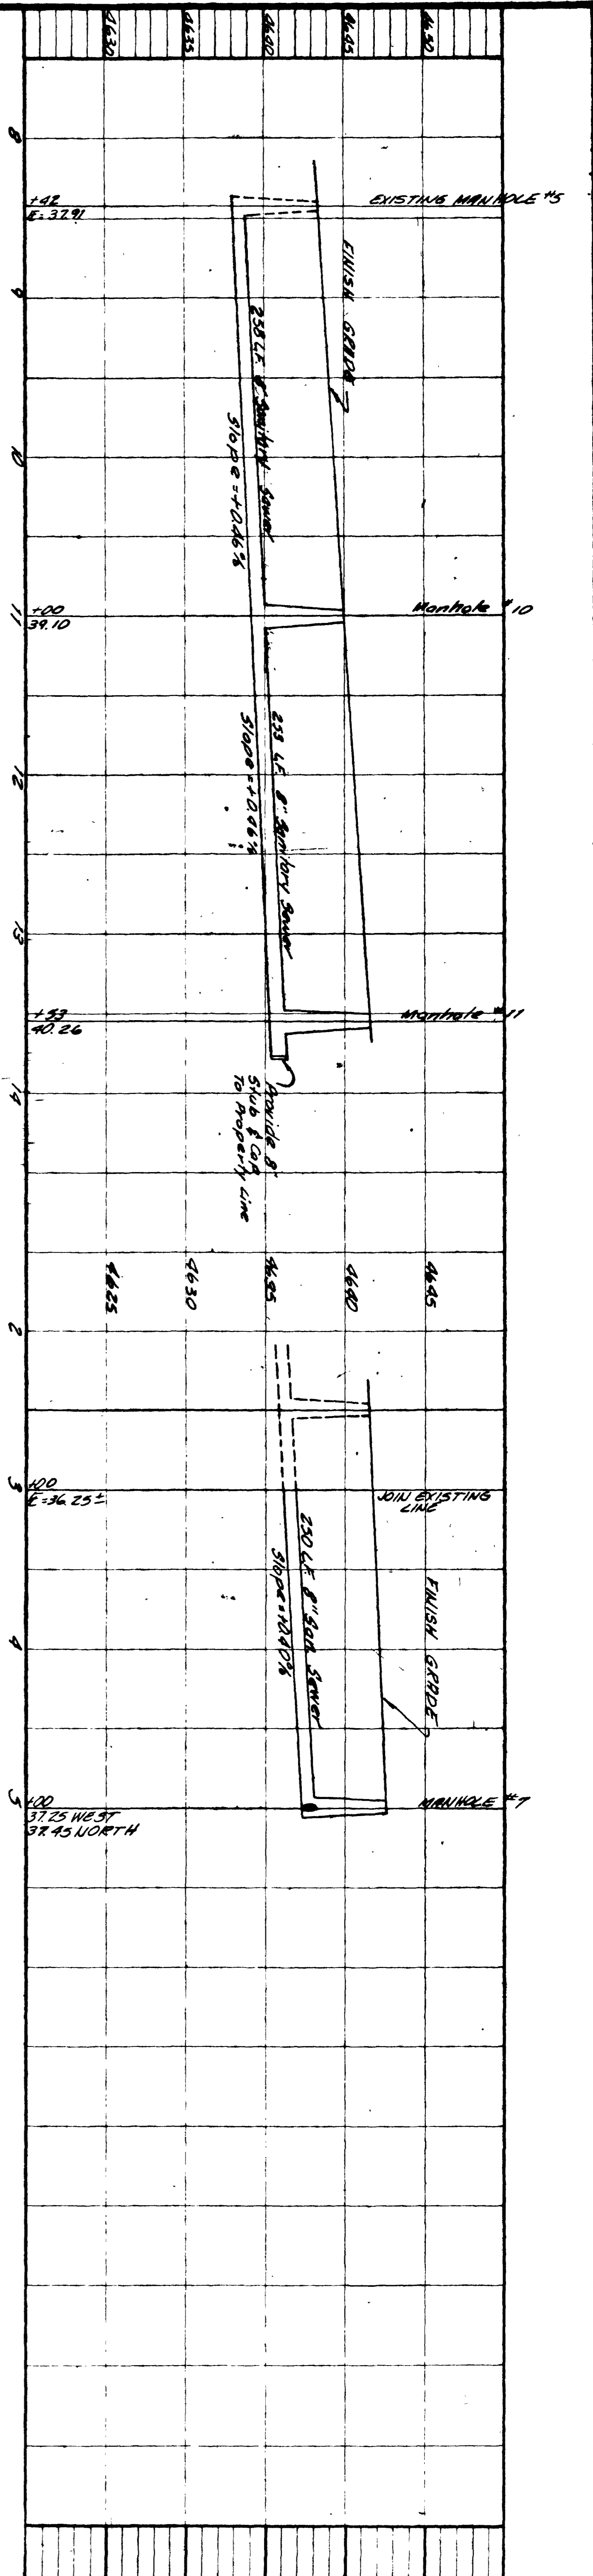

AS BUILT FOR RECORD

