

REVIEWED BY Kodyl DATE 7/30/15
 City Eng
 S I H y o p t m t
 M C ty P d l H lth
 C lo St t D pt f H lth Richard A. Bouman 8-11-75

SCALE Horiz 1" = 30'
 Vert 1" = 2'


AS BUILT PLAN 10 22 75

DESIGNED BY
E. A. Armstrong
 E. A. ARMSTRONG PE 137441

ARMSTRONG ENGINEERS
 CONSULTING ENGINEERS

SCALE	1" = 30'
DATE	
DESIGNED BY	E. A. ARMSTRONG
CHECKED BY	
DATE OF SURVEY	

SANITARY SEWER
 FOR DALE NICKERSON
 SHEET 1 of 1
 JOB NO. 75319

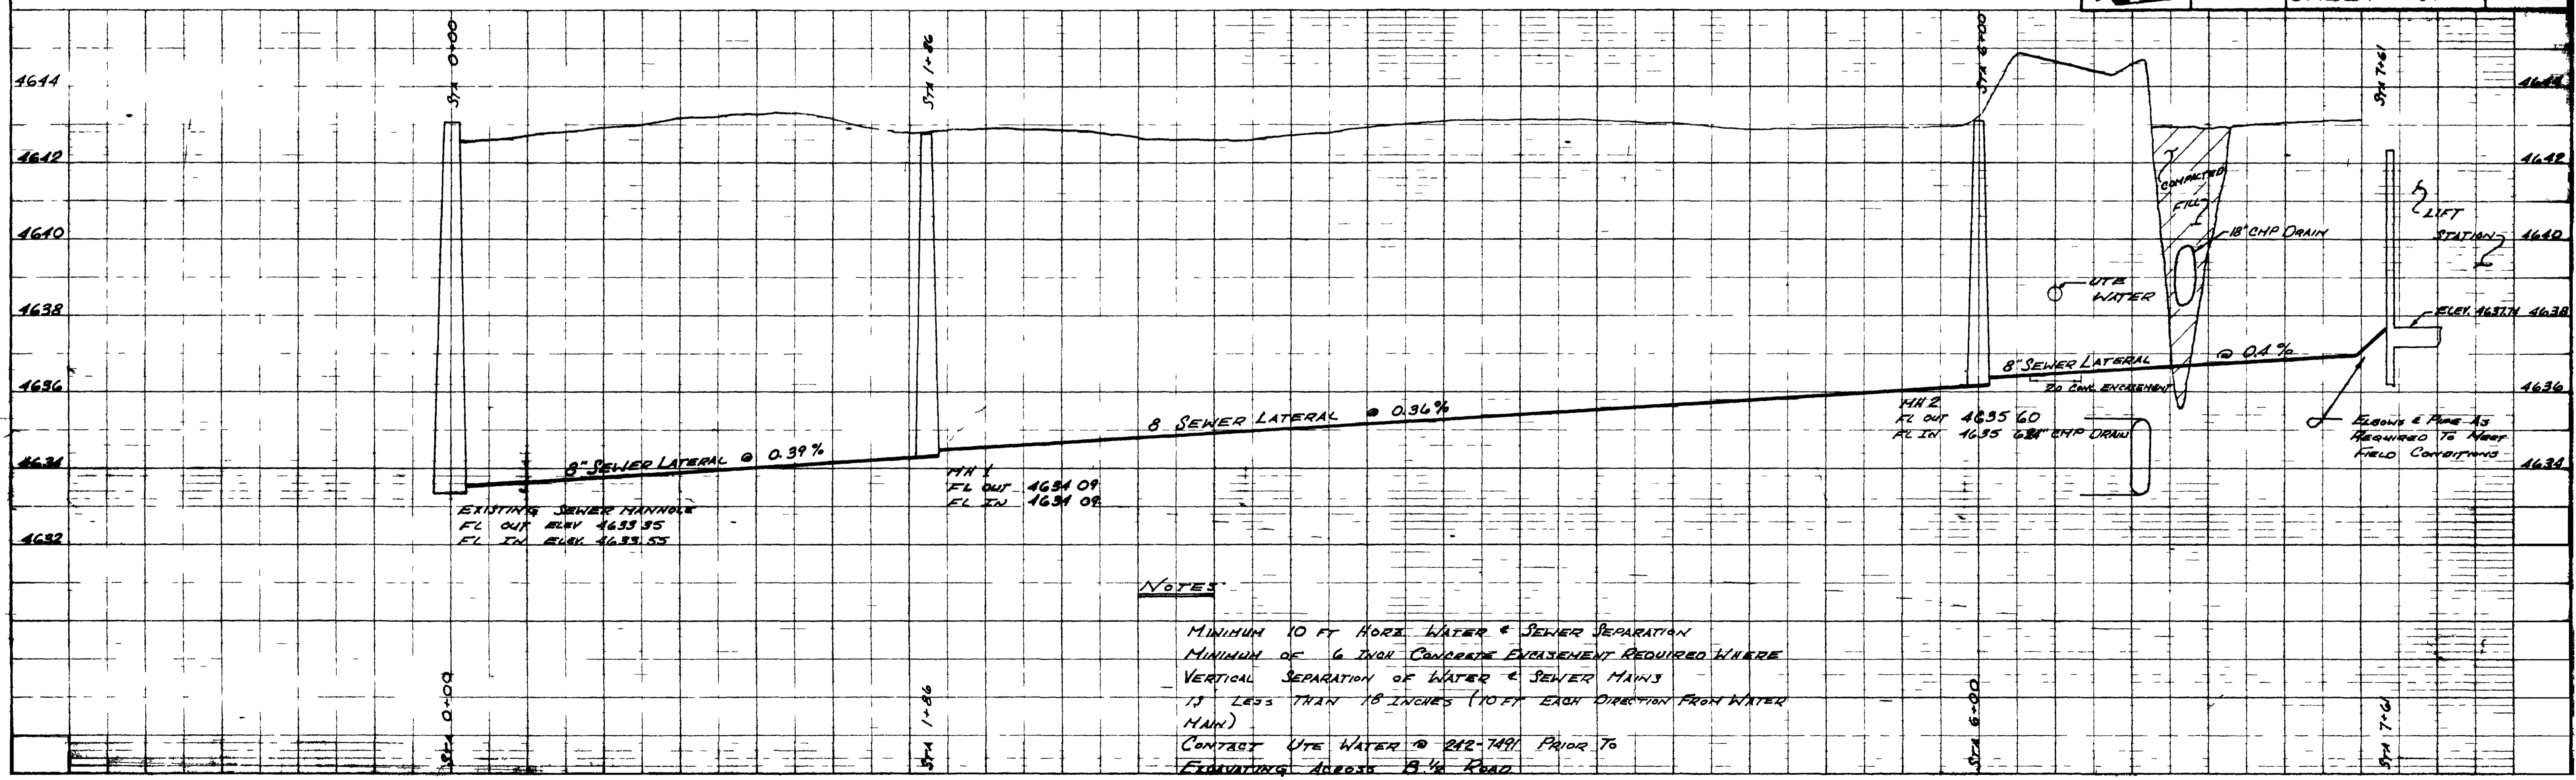

NOTES

MINIMUM 10 FT HORIZ WATER & SEWER SEPARATION
 MINIMUM OF 6 INCH CONCRETE ENGAGEMENT REQUIRED WHERE
 VERTICAL SEPARATION OF WATER & SEWER MAINS
 IS LESS THAN 18 INCHES (10 FT EACH DIRECTION FROM WATER
 MAIN)

CONTACT UTE WATER @ 282-7491 PRIOR TO
 EXCAVATING ACROSS B 1/2 ROAD