


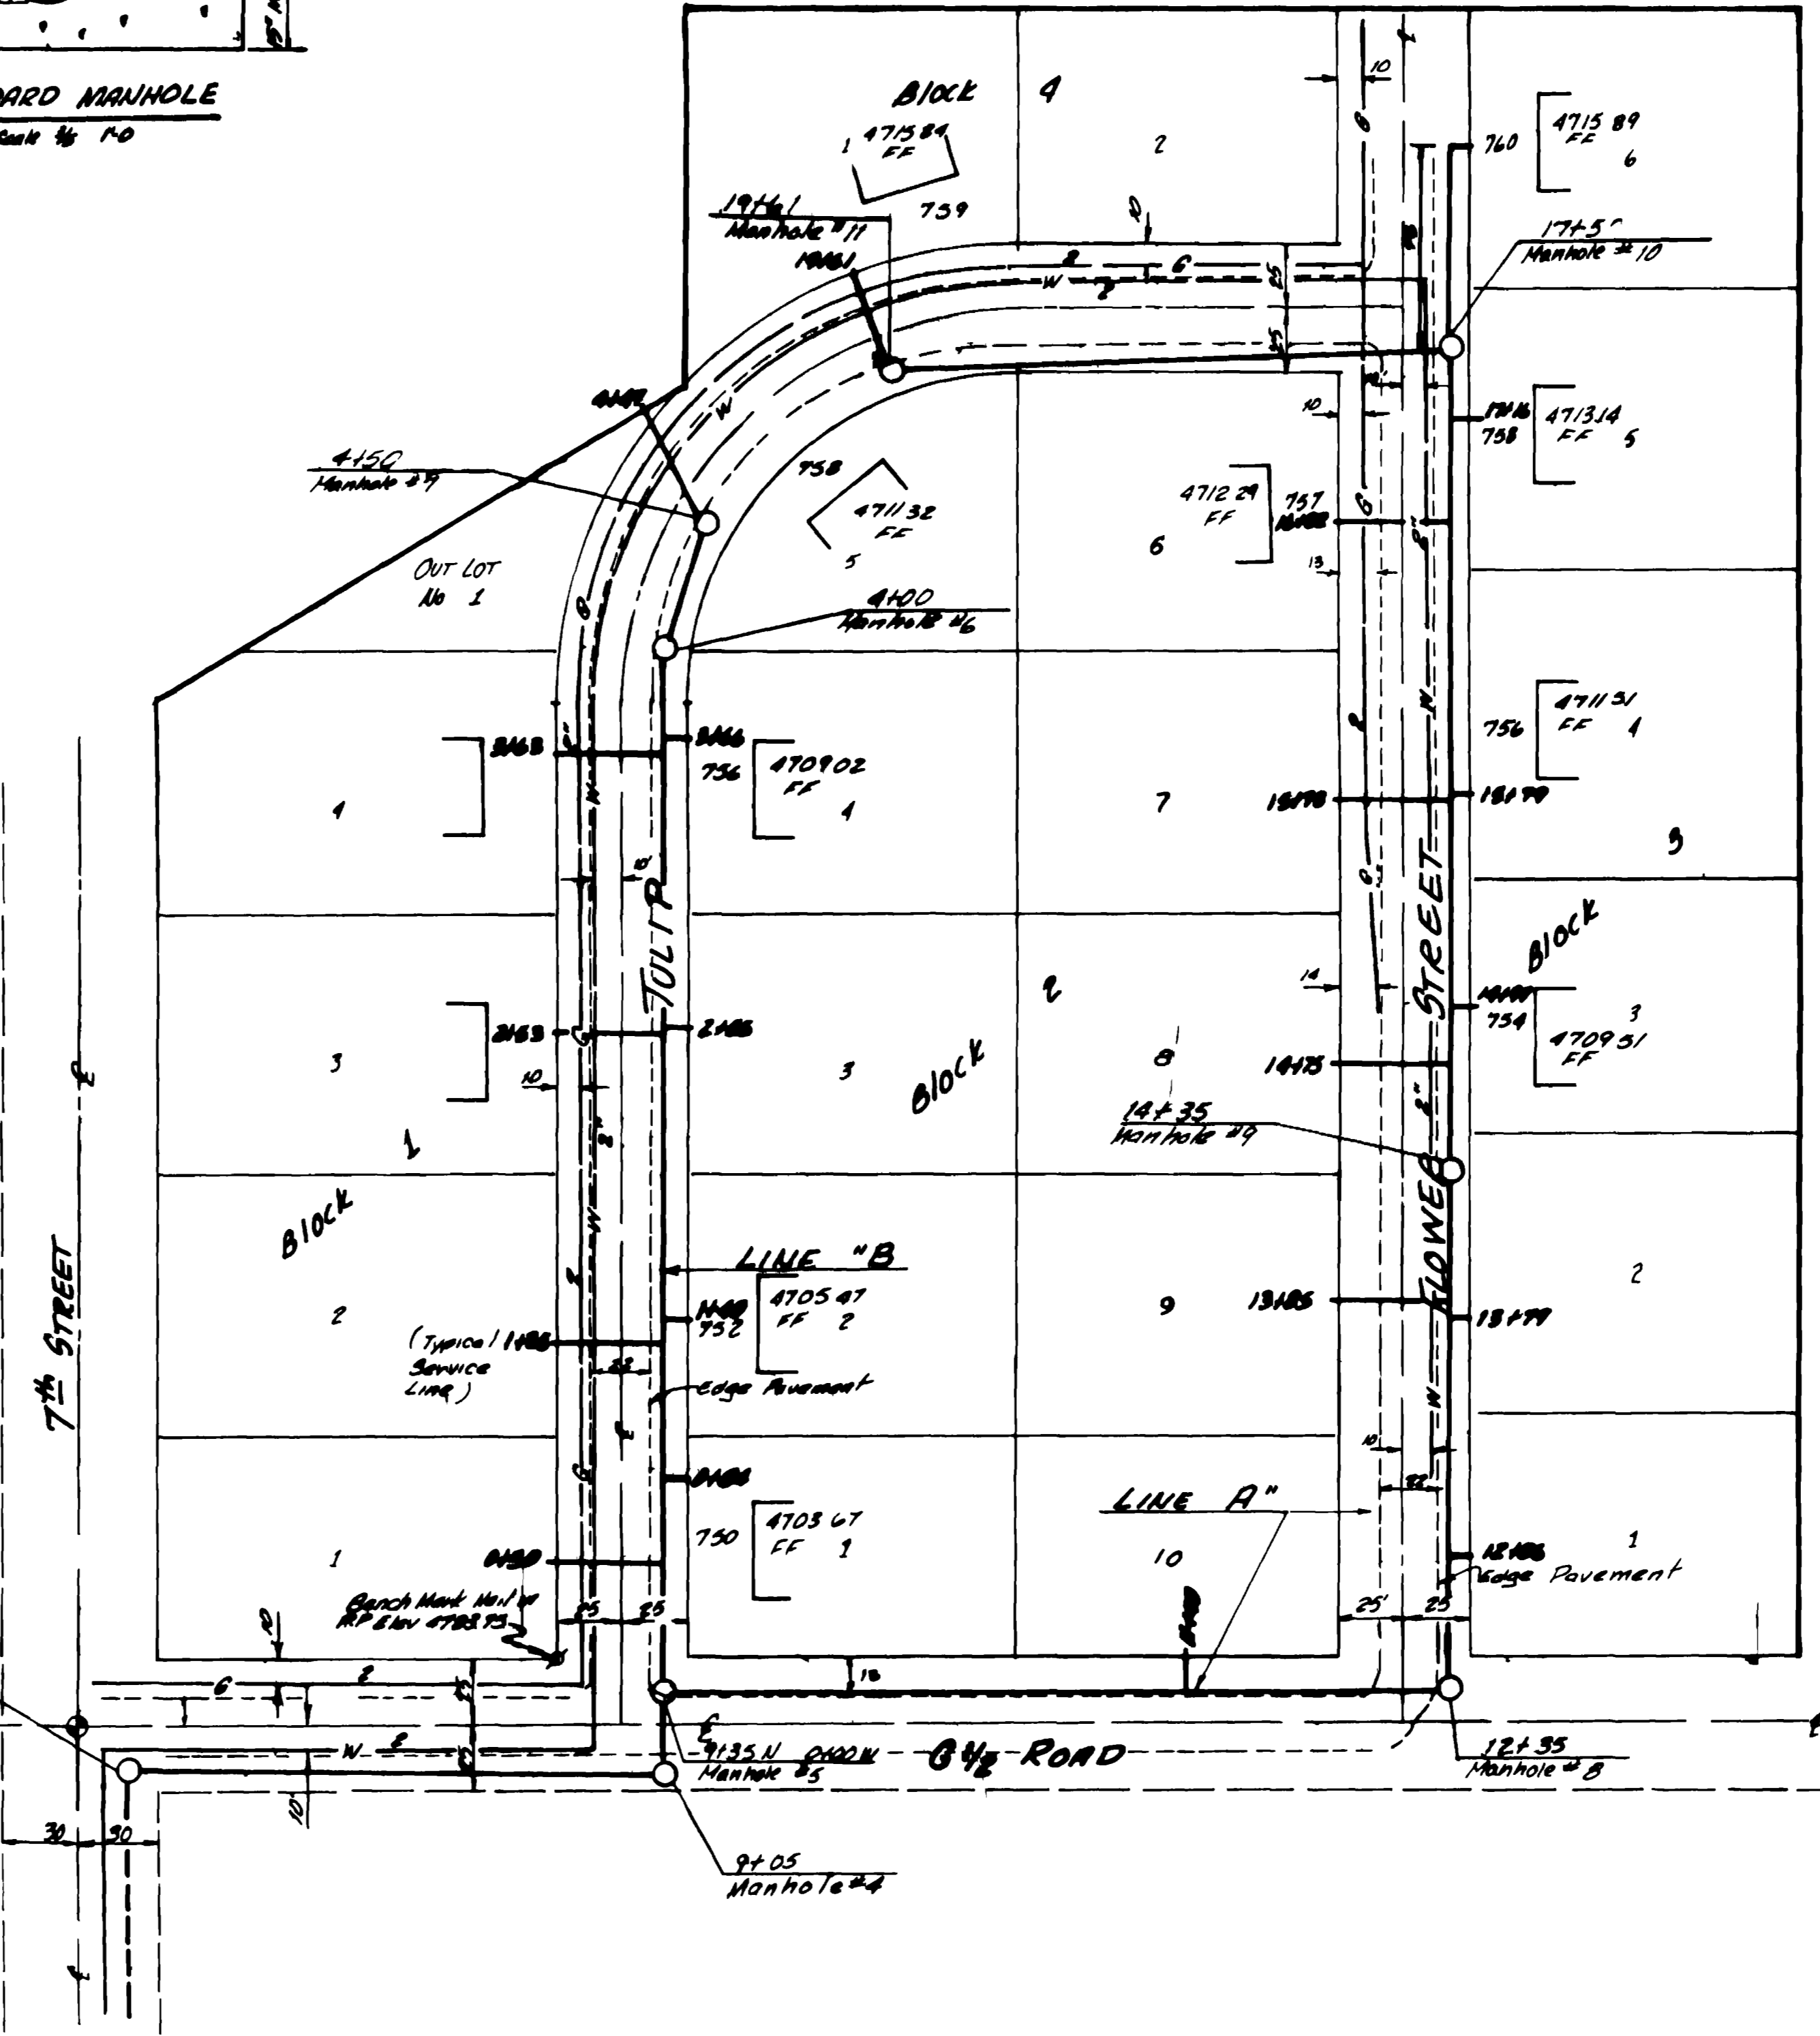
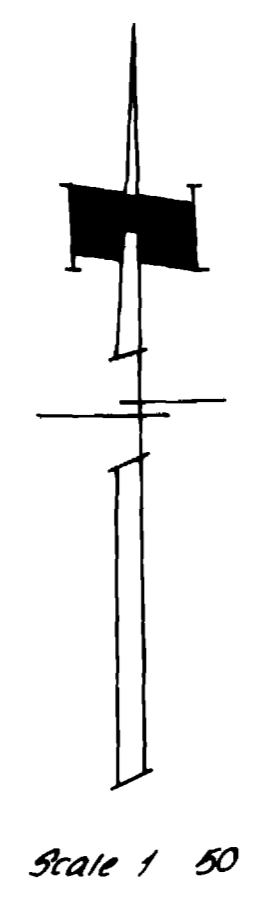


STANDARD SERVICE CONNECTION
1/8" SCALE

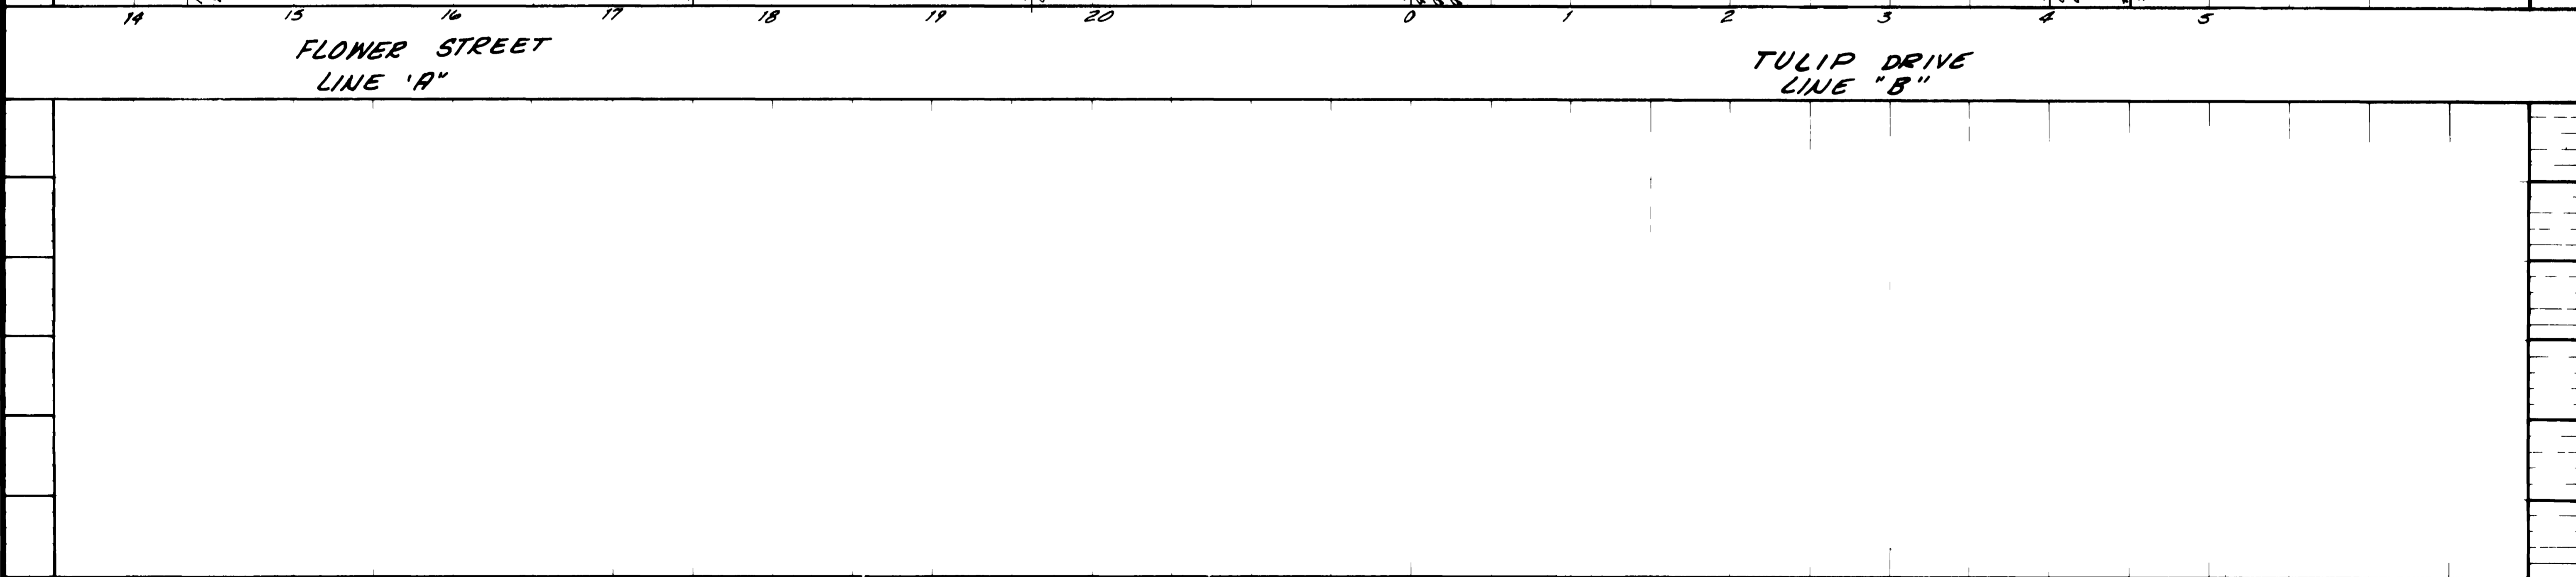

Note: A Service Line is to be provided for each lot within TERRA DEL VISTA SUB on lots that have NO House Service Line to be 5 feet downstream from center of lot. On lots that have houses the occupant will be furnished a wood stake so that he can provide the location of his own service.

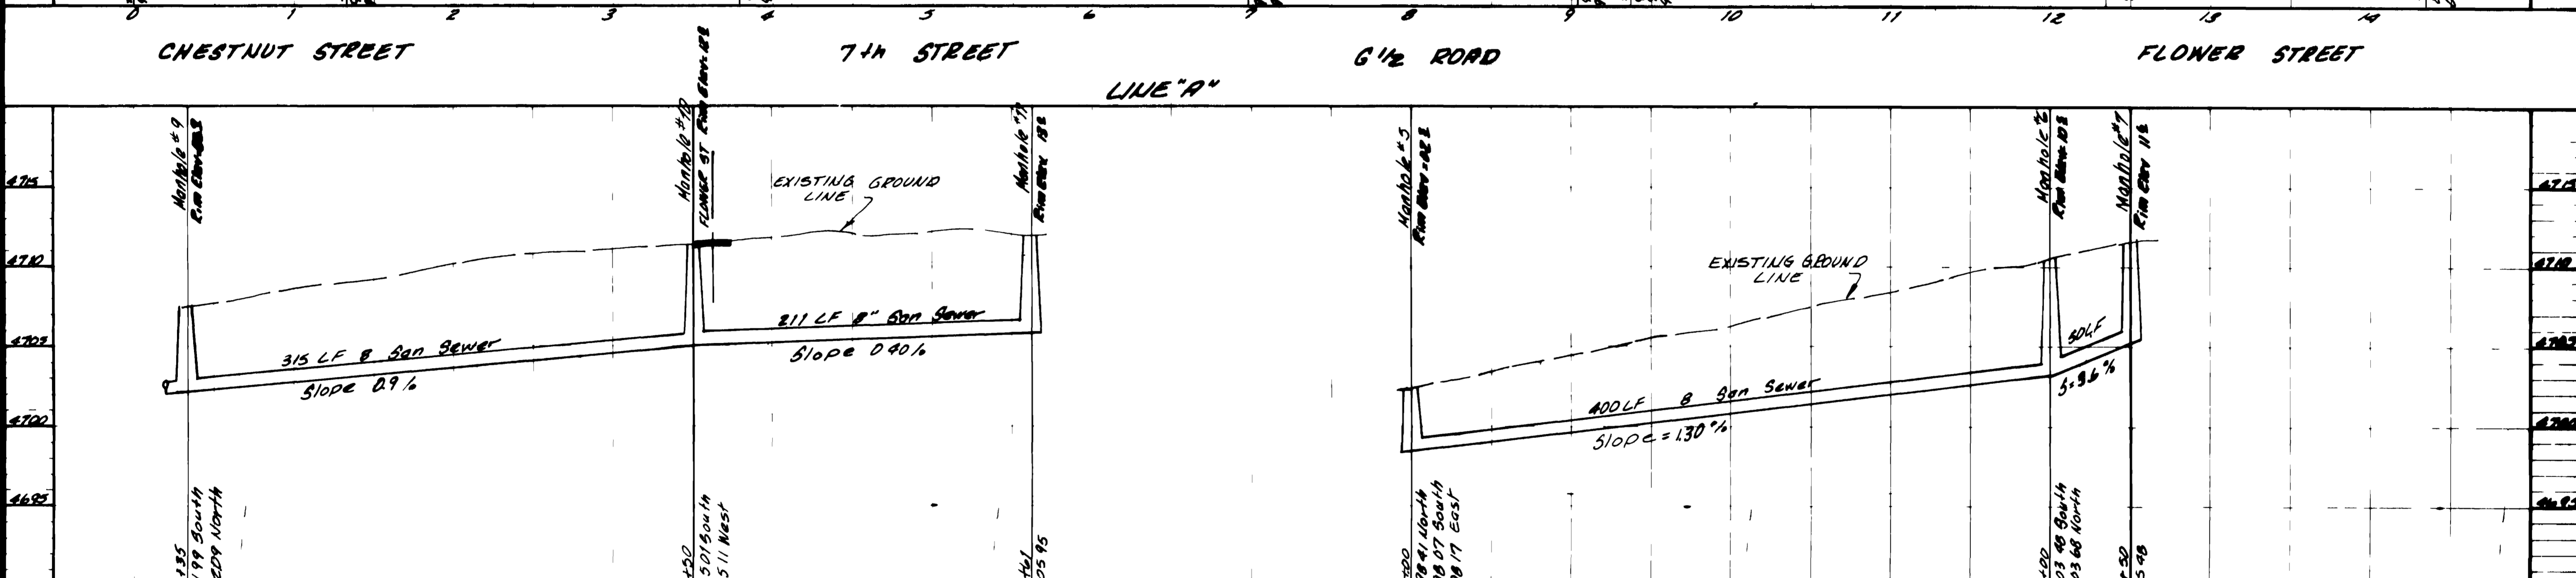

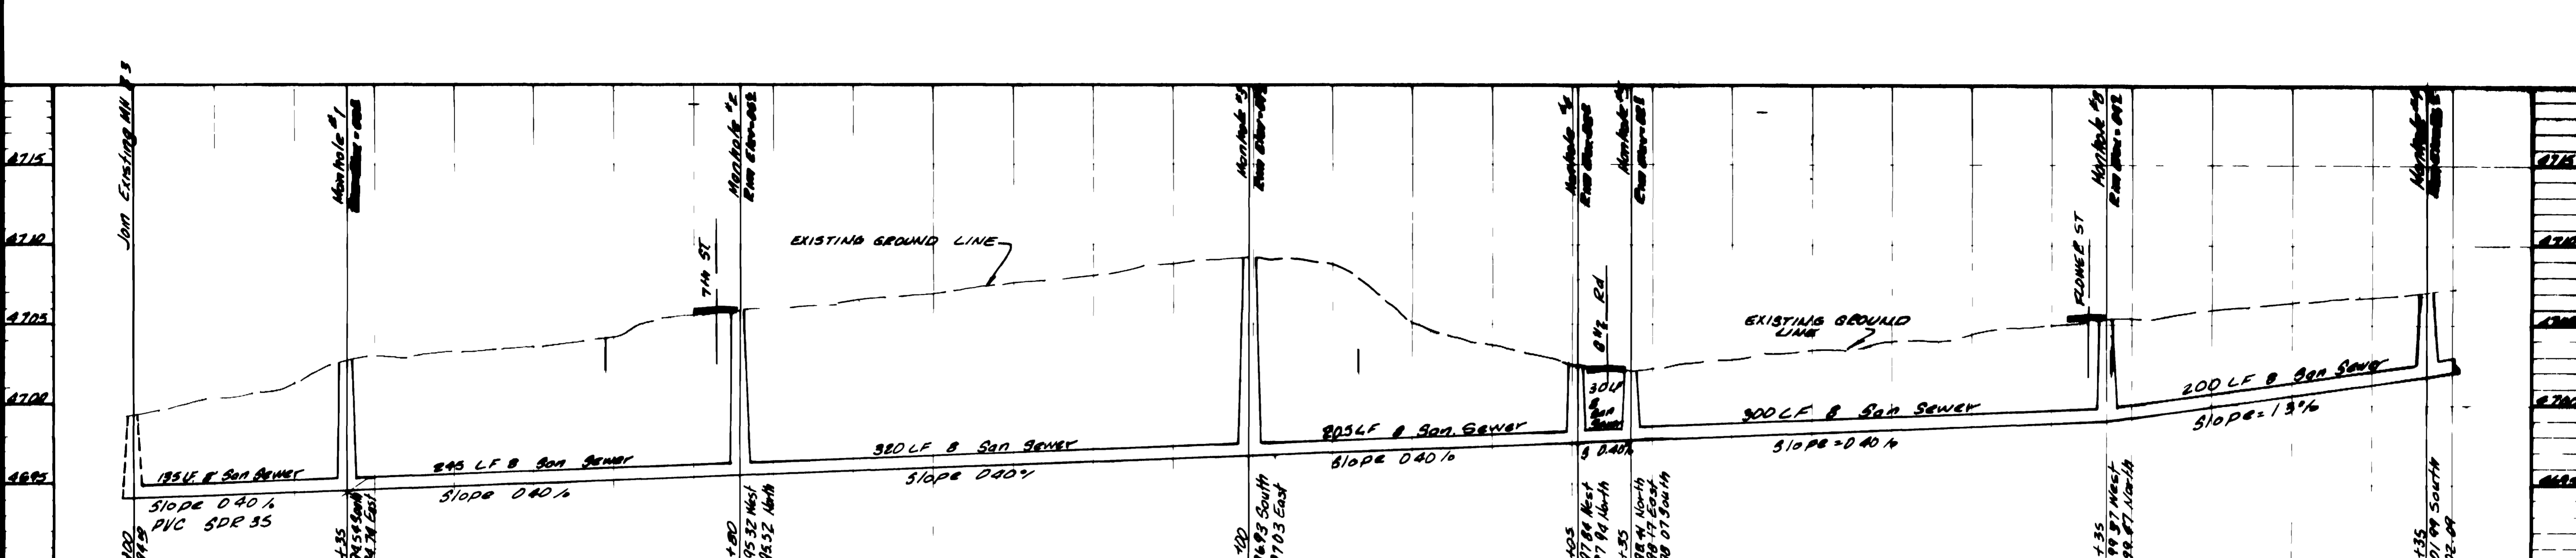

ROBERT P. GERLOFS
Engineering Consultants
DATE DEC 1976
SCALE 1" = 50' HORIZ.
SAUNARY SEWER
PLAN AS BUILT
TERRA DEL VISTA
MESA COUNTY, COLORADO
SHEET
2