




Note 1 — Indicates Sanitary Sewer Service Taps
 Note 2 — All Sanitary Sewer Service Taps Extend 10 Feet Past The Property Line

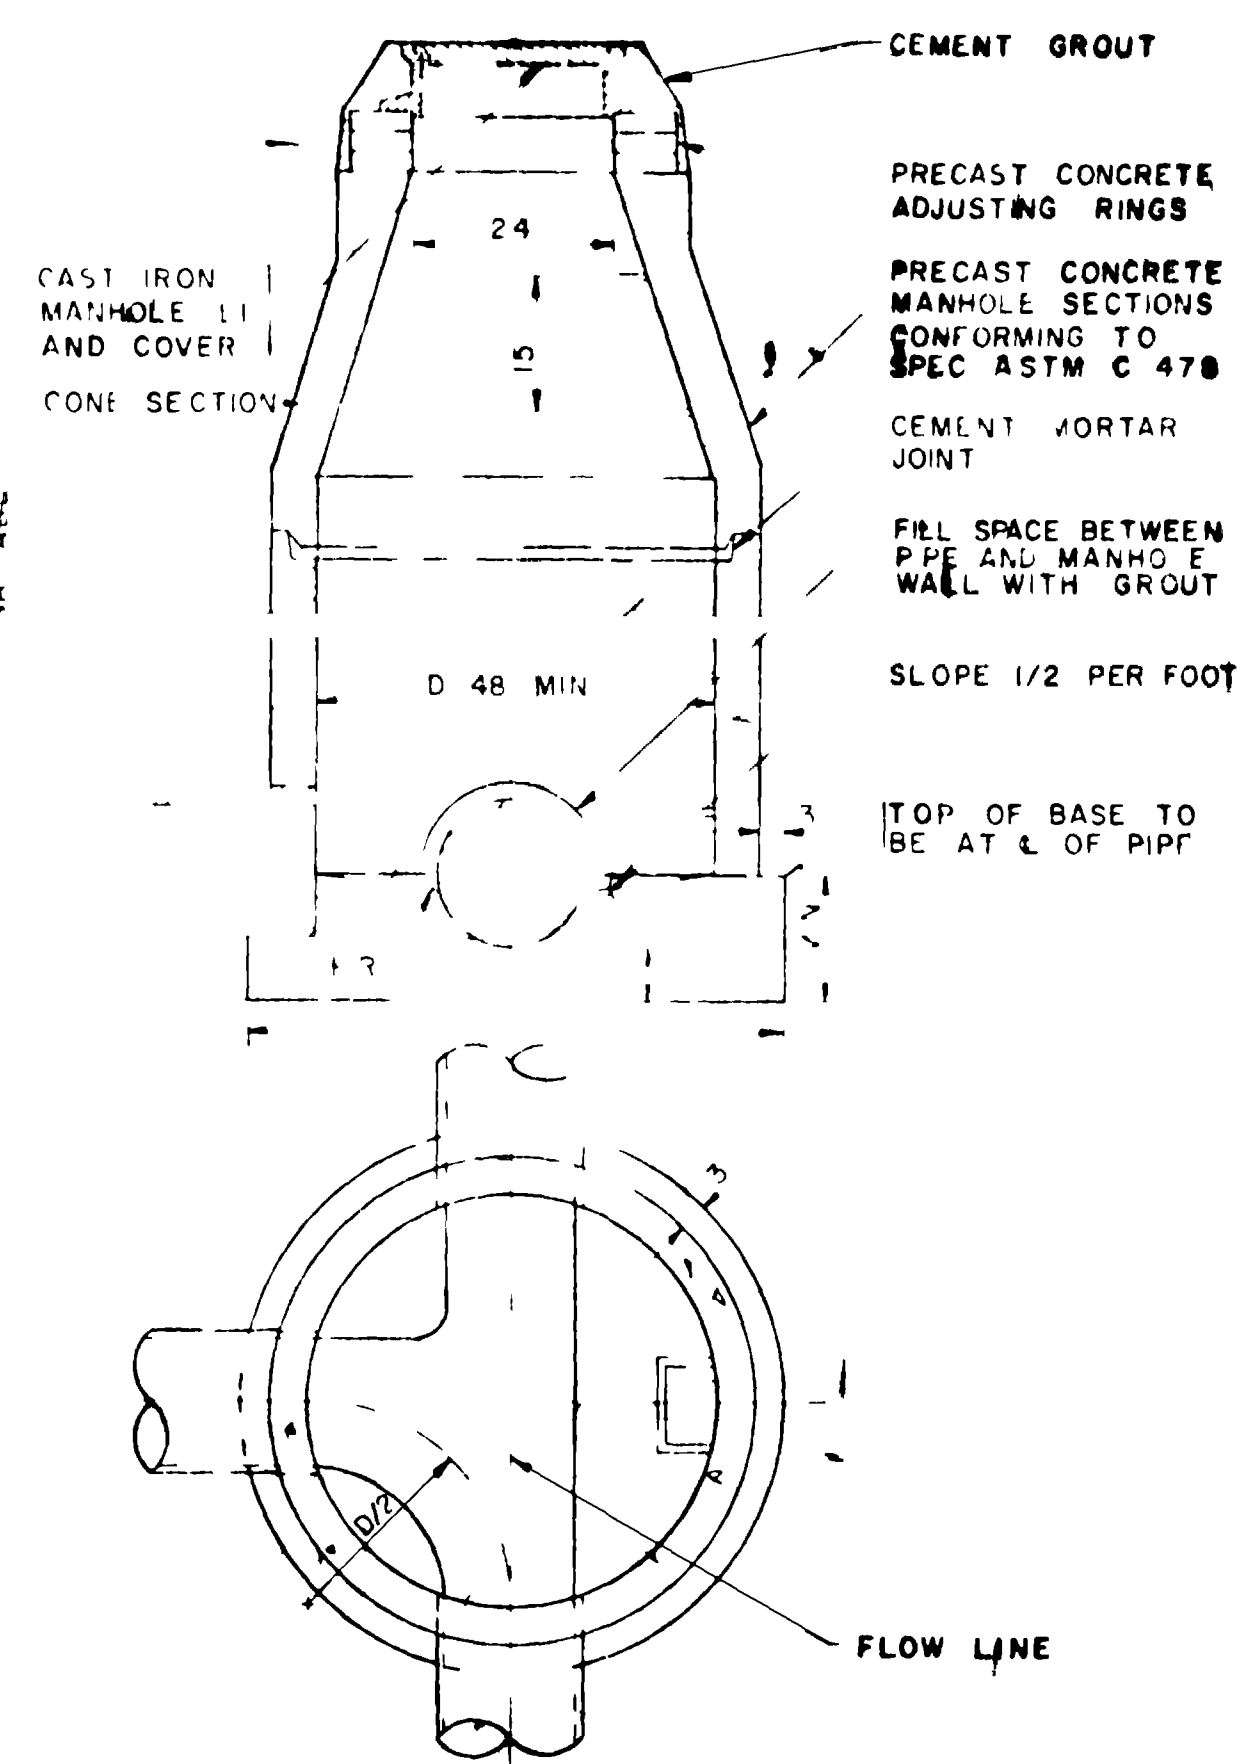

STANDARD MANHOLE
201

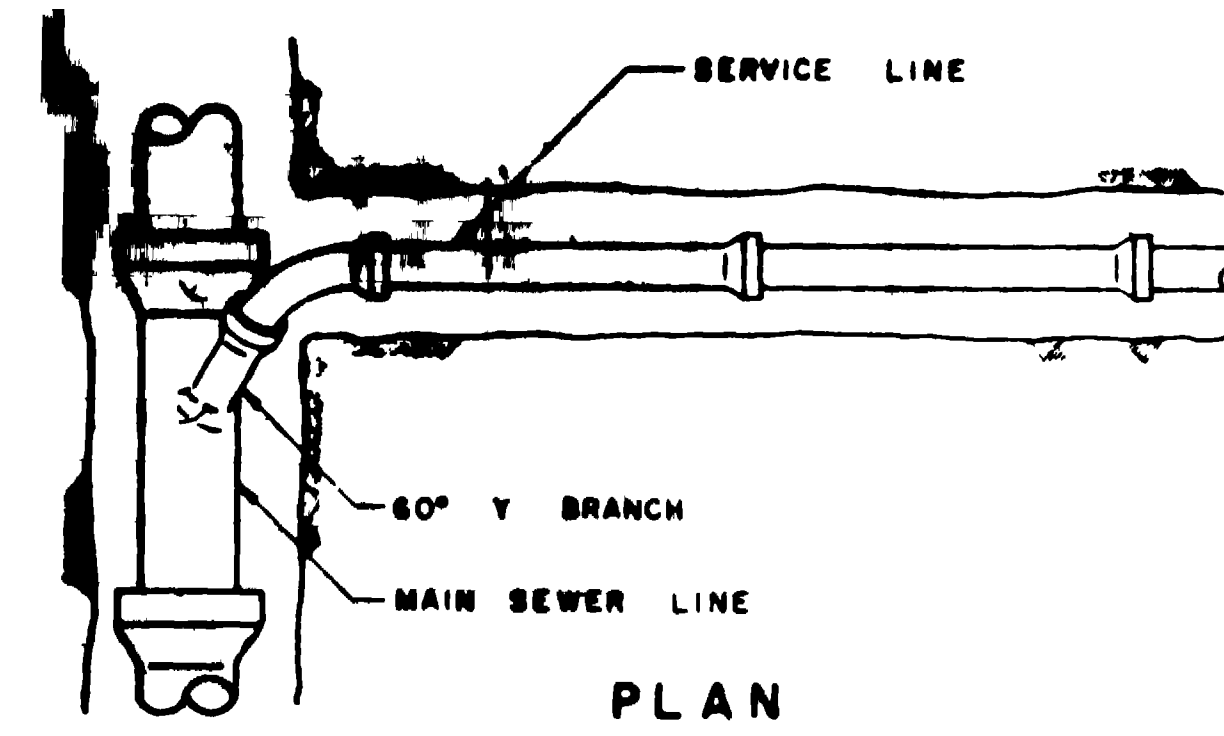

PLAN

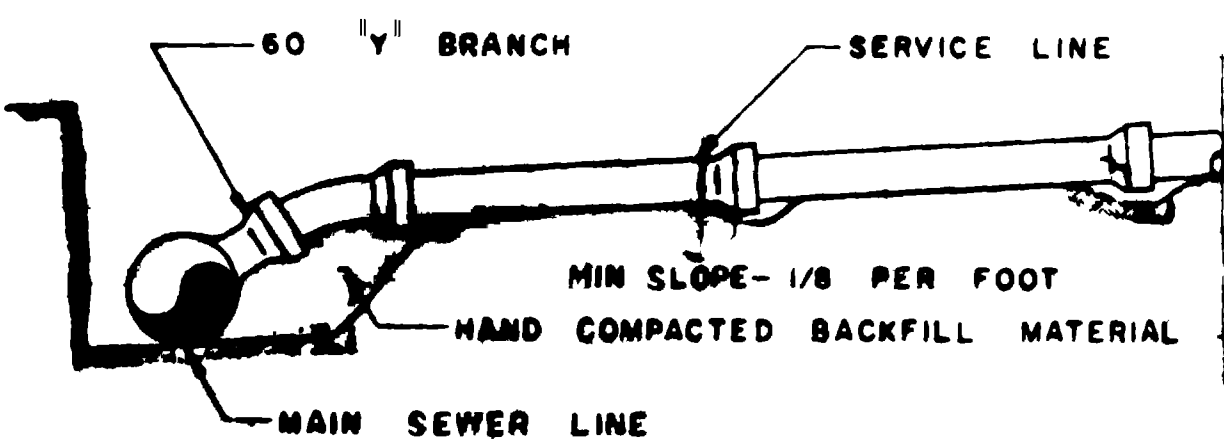

CONSTRUCTION EYE CONNECTION
STANDARDS

APPROVAL BY CITY OF GRAND JUNCTION
 Name _____ Date _____
 Grand Junction City Engineer

1 PLS 1/11/76 EJS As Built

March, 1976
1"=50

GL Shaw
PJ Siegmund
RL Atkins





NELSON HALEY PATTERSON & QUIRK
ENGINEERS CONSULTANTS


"C" ROAD LIMITED SUBDIVISION
MESA COUNTY COLORADO

SANITARY SEWER PLAN
& MISCELLANEOUS DETAILS


2
1

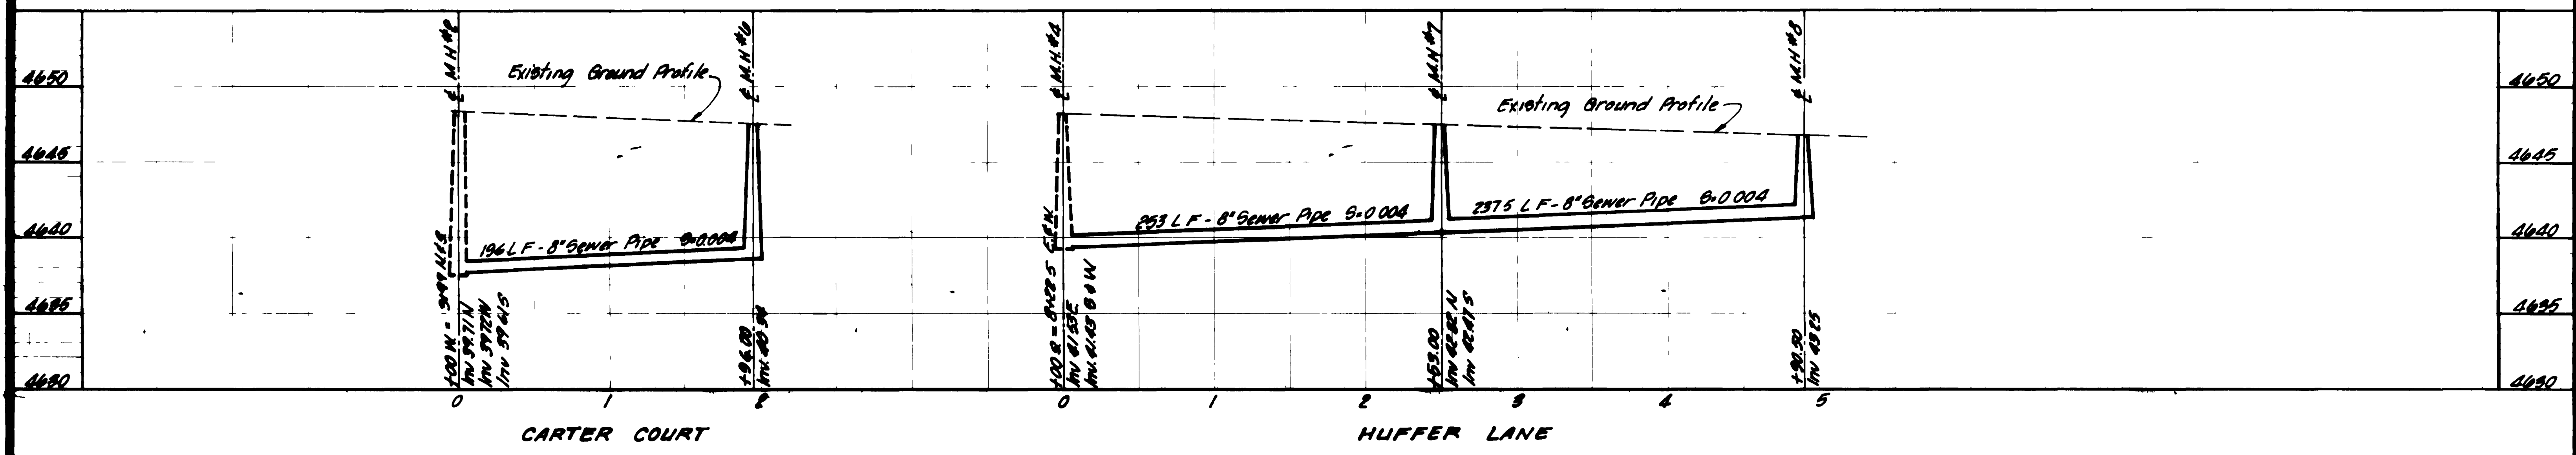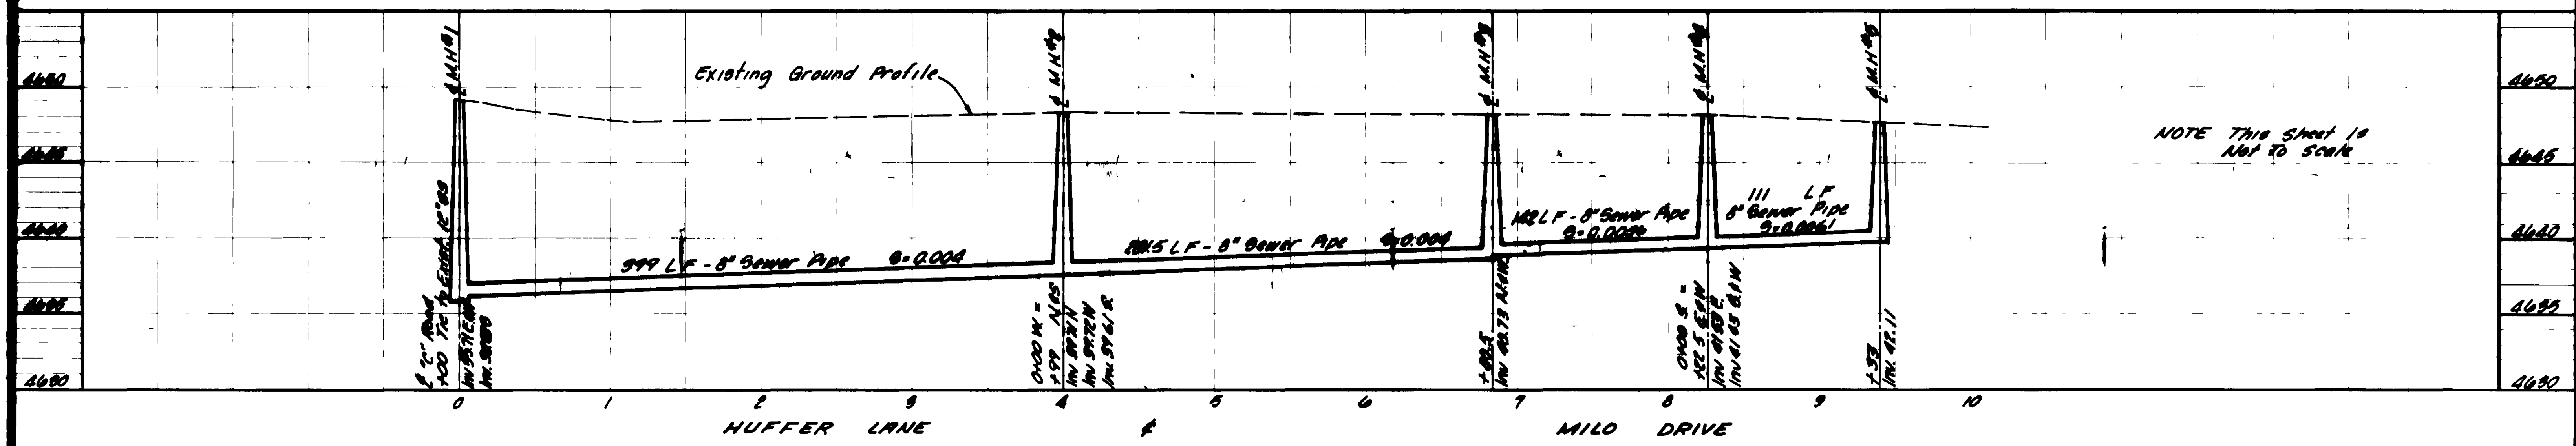


40 2 11 T

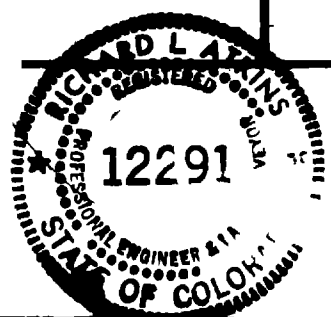


1 1/2" ROAD		DATE	DRAFTSMAN	DEPT HEAD	NELSON - HALEY - PATTERSON AND QUIRK		10" ROAD LIMITED SUBDIVISION		SANITARY SEWER PROFILES		SHEET
E.S. "H" ROUTE		March, 1978	R.L. Atkins		ENGINEERING CONSULTANTS		MESA COUNTY, COLORADO		2		2
NO	BY	DATE	APPROVED	REVISIONS	CONSULTANTS		COLORADO		SHEETS		

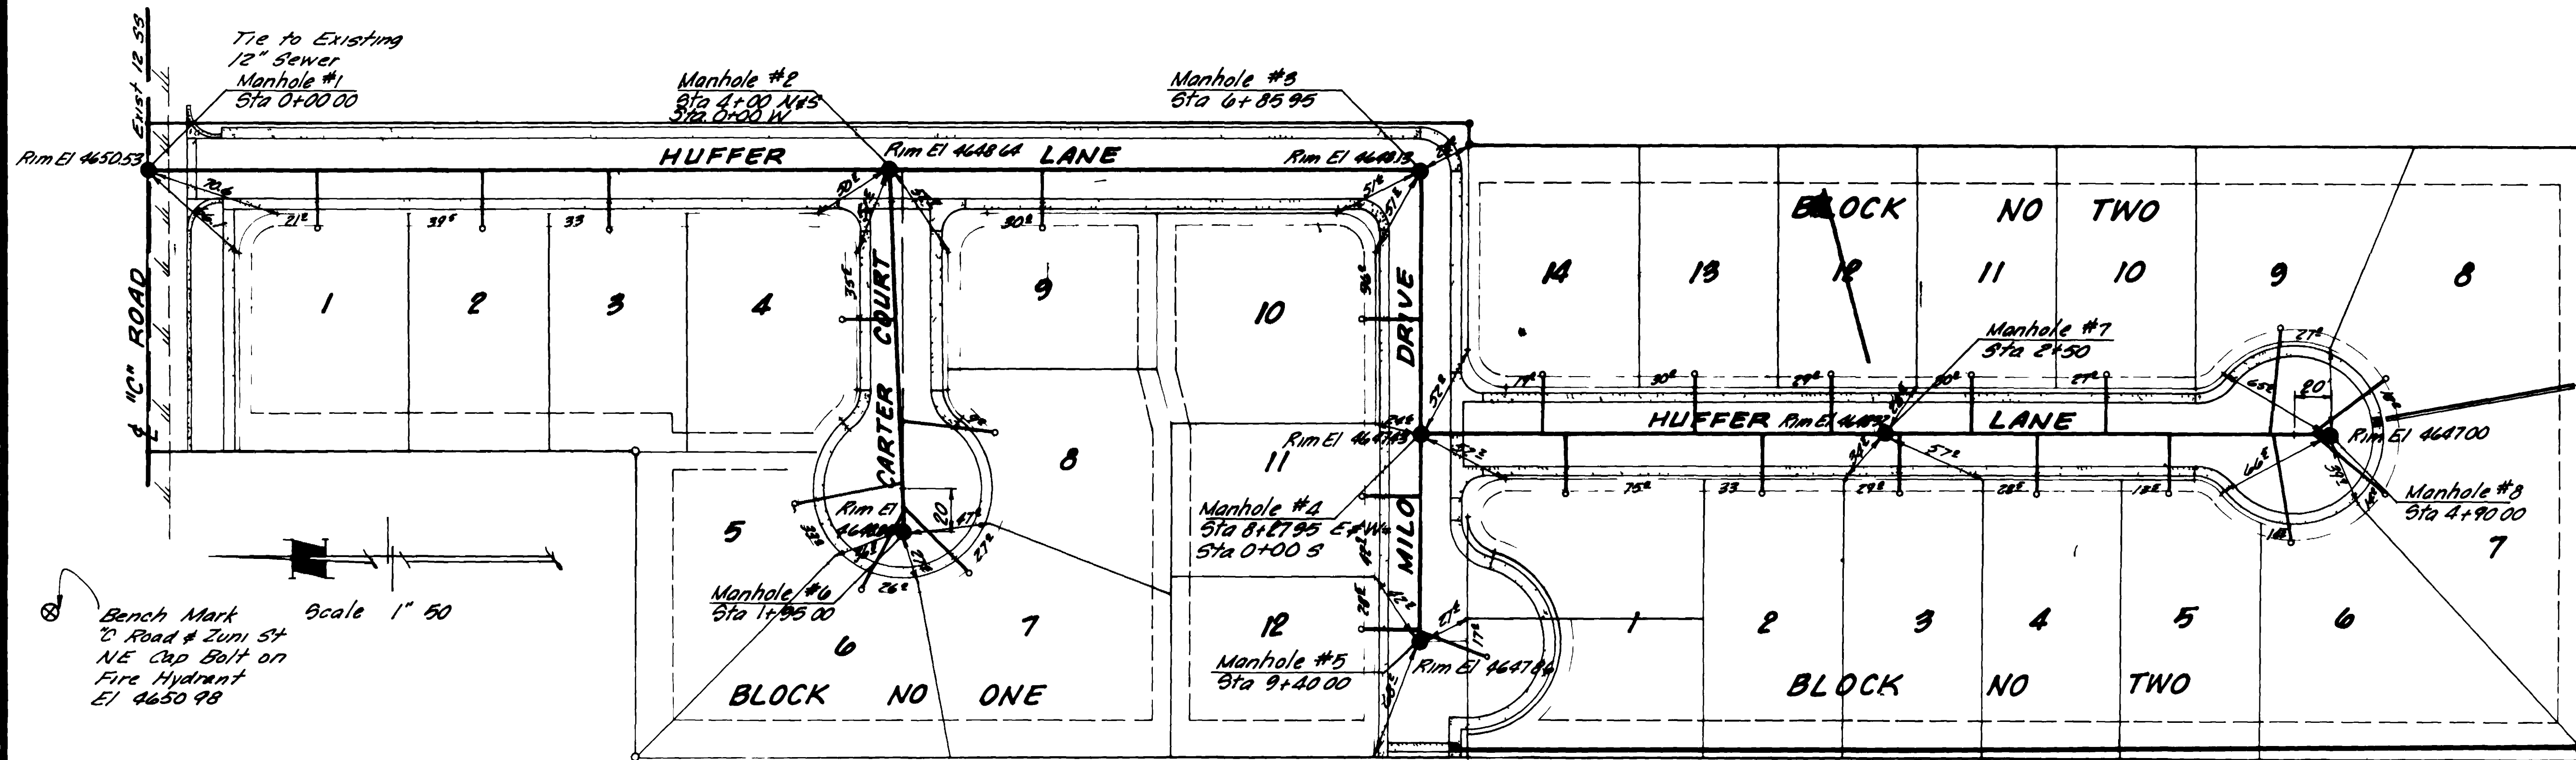


Note 1 — Indicates Sanitary Sewer Service Taps
 Note 2 — All Sanitary Sewer Service Taps Extend 10 Feet Past The Property Line

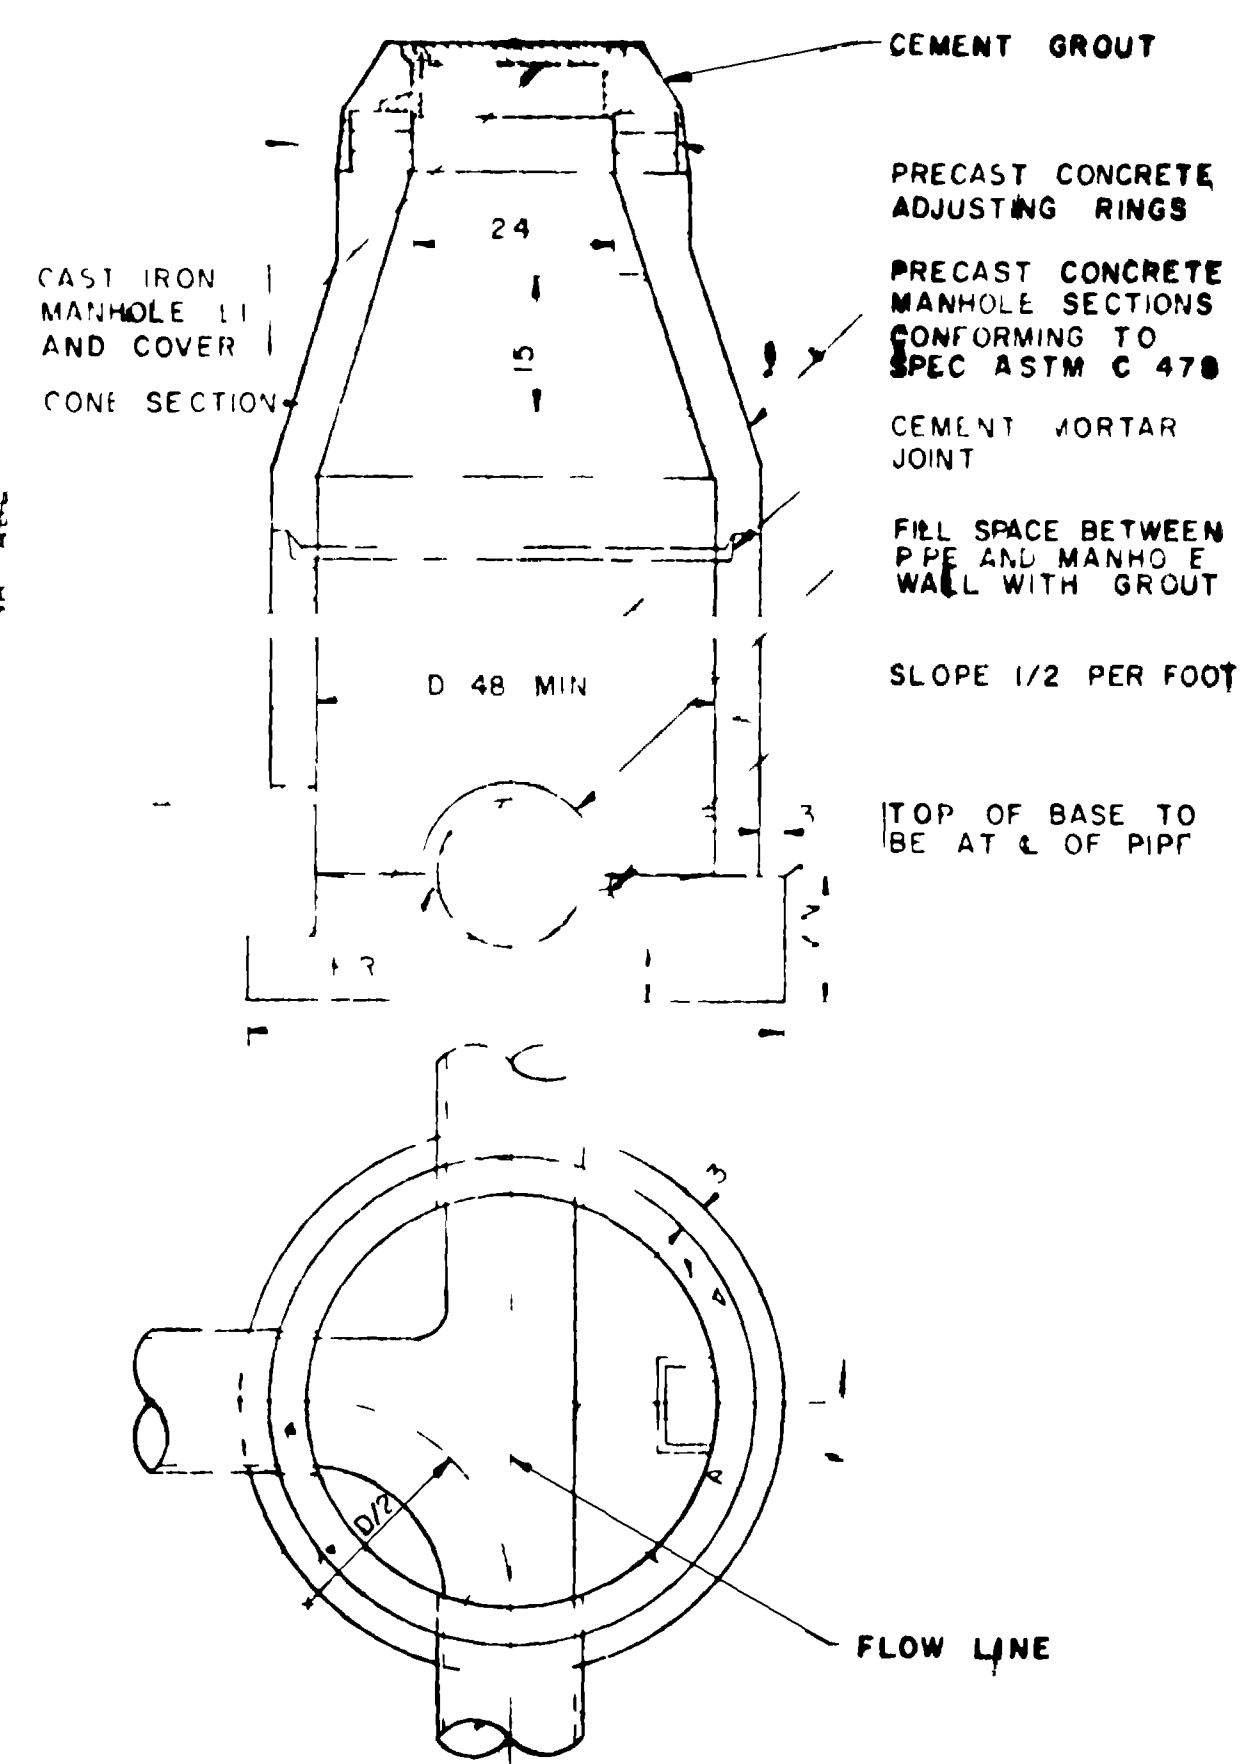

STANDARD MANHOLE
201

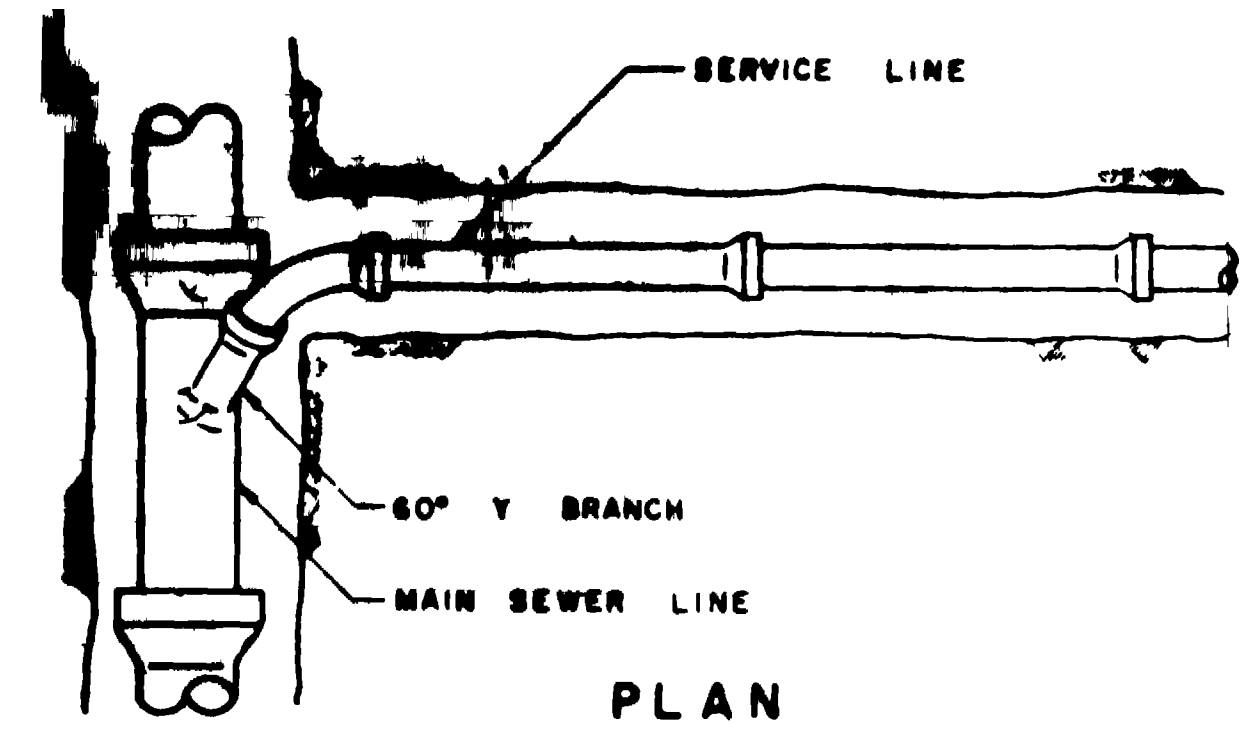


PLAN


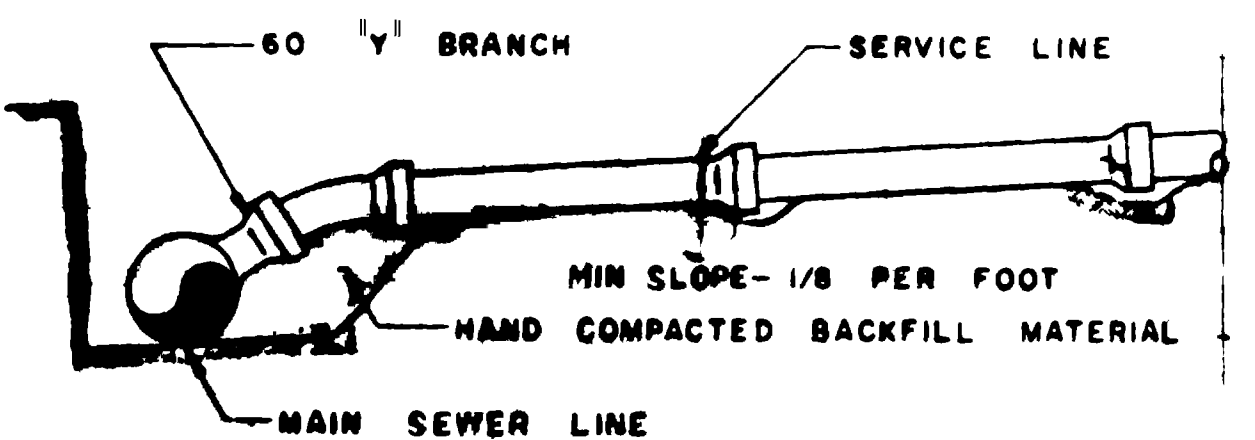


CONSTRUCTION EYE CONNECTION
STANDARDS

APPROVAL BY CITY OF GRAND JUNCTION
 Name _____ Date _____
 Grand Junction City Engineer

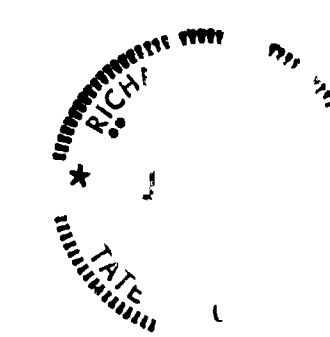


1	PJS	1/1/76	EJS	As Built	March, 1976	1"=50	GL Shaw PJ Siegmund RL Atkins		NELSON HALEY PATTERSON & QUIRK EER CONSULTANTS	"O" ROAD LIMITED SUBDIVISION MESA COUNTY COLORADO	SANITARY SEWER PLAN & MISCELLANEOUS DETAILS	2	1
---	-----	--------	-----	----------	-------------	-------	-------------------------------------	--	---	--	--	---	---

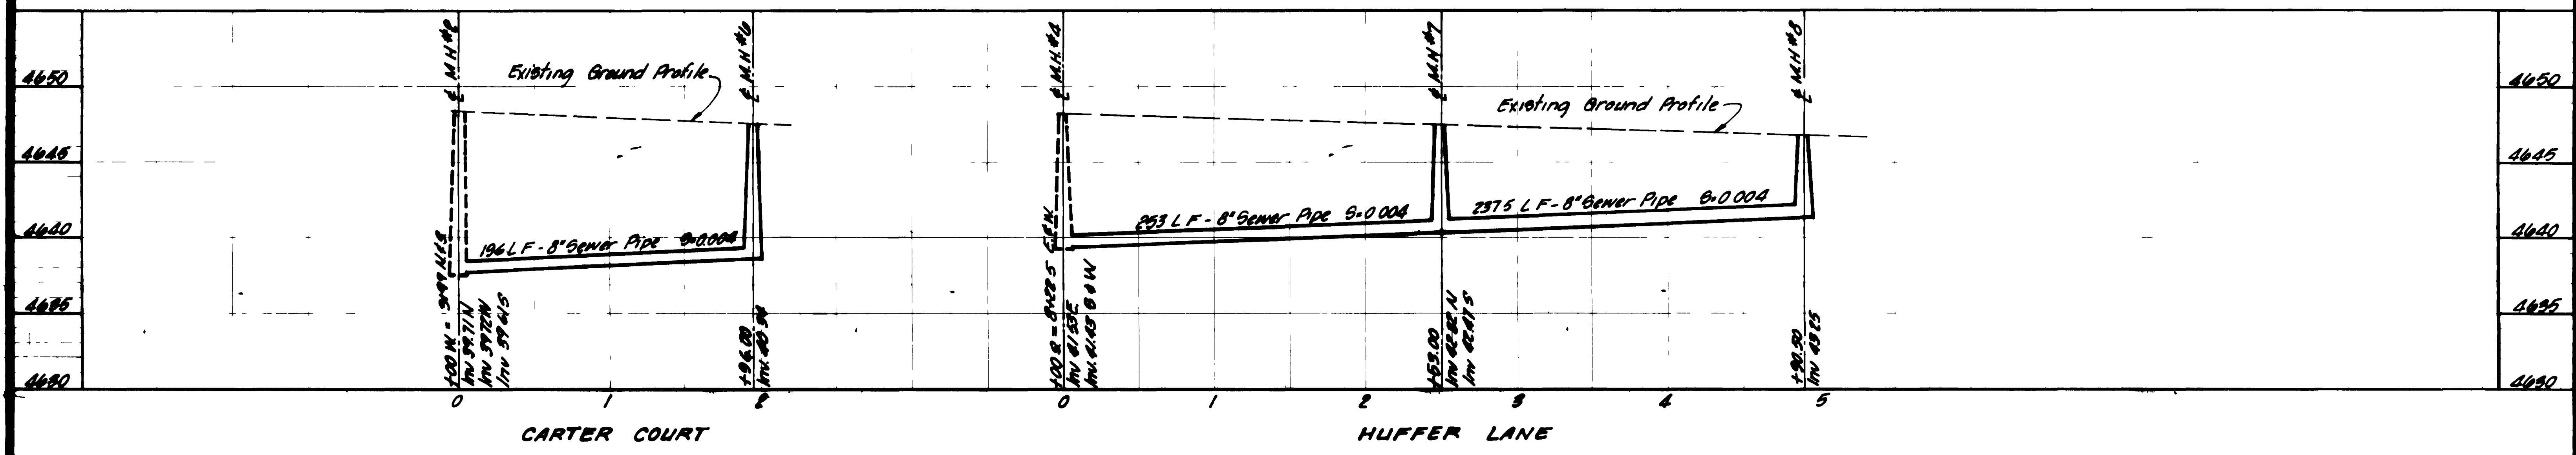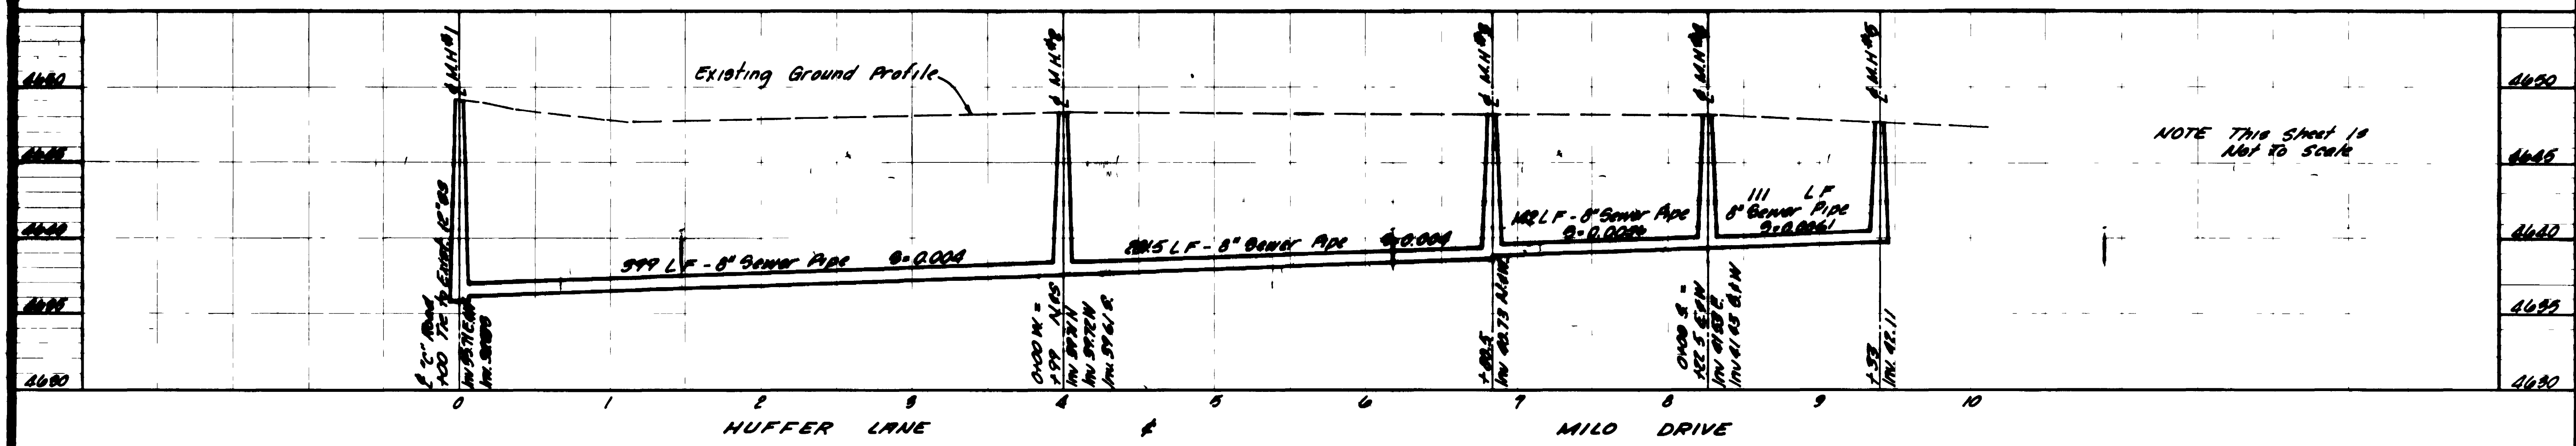

NOTE This Sheet is Not to Scale

40 2 11 T

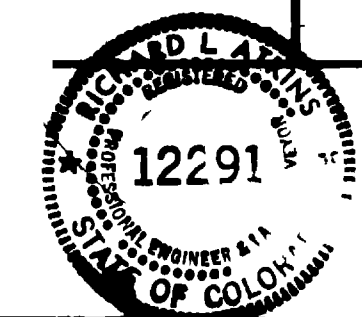

1 1/2" 11/16" E.L.S. "As BUILT"		DATE: March, 1978	DRAFTSMAN: R.L. Shaw	DEPT. HEAD:		NELSON - HALEY - PATTERSON AND QUIRK ENGINEERING CONSULTANTS COLORADO	1/2" ROAD LIMITED SUBDIVISION MESA COUNTY, COLORADO	SANITARY SEWER PROFILES	2 SHEETS
NO.	BY	DATE	APPROVED	REVISIONS					