


**QUANTITIES**

8" SANITARY SEWER 594 L.F.

STANDARD MAN HOLES 3

SERVICE CONNECTIONS 8

ALL CONSTRUCTION TO BE DONE IN ACCORDANCE WITH CITY OF GRAND JUNCTION STANDARDS.

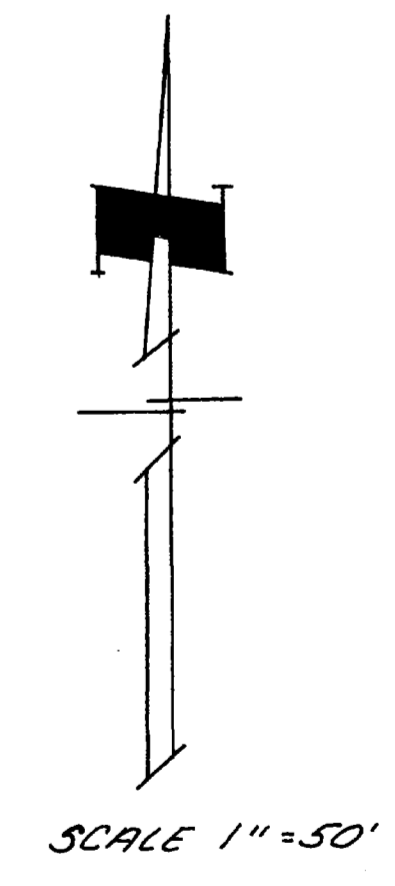

AS BUILT DRAWING



APPROVED BY: \_\_\_\_\_ DATE: \_\_\_\_\_

CITY ENGINEER UTILITIES

PARAGON ENGINEERING, INC. Engineering Consultants  
 PO BOX 2872 GRAND JUNCTION COLORADO 81501 PHONE 243-8966  
 DATE July 1978 SCALE AS SHOWN  
 SANITARY SEWER PLAN, PROFILE AND DETAILS  
 F ROAD SEWER EXTENSION MESA COUNTY, COLO.  
 SHEET 1 OF 1