





QUANTITIES
 10" SANITARY SEWER 168 L.F.
 8" SANITARY SEWER 2649 L.F.
 STANDARD MANHOLES = 13
 4" SERVICE CONNECTIONS = 62

A final inspection determined that infiltration does not exceed 200 gallons per inch diameter per mile of length per day.

NOTES:
 1. ALL CONSTRUCTION TO BE DONE IN ACCORDANCE WITH THE CENTRAL GRANDE VALLEY SANITATION DISTRICT SPECIFICATIONS.
 2. TOP OF ECCENTRIC CONE TO BE SET @ TOP OF SUBGRADE (STREET CONTRACTOR TO SET RIMS TO FINISHED GRADE OF STREETS)
 3. SERVICE LINE ARE INTENDED TO BE LOCATED 5' DOWN STREAM FROM CENTER OF LOTS OR AS SHOWN ON PLANS AND EXTEND 10' BEYOND PROPERTY LINE.

APPROVED _____ DATE _____
 CENTRAL GRAND VALLEY SANITATION DISTRICT

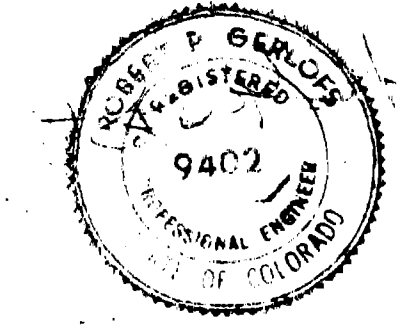

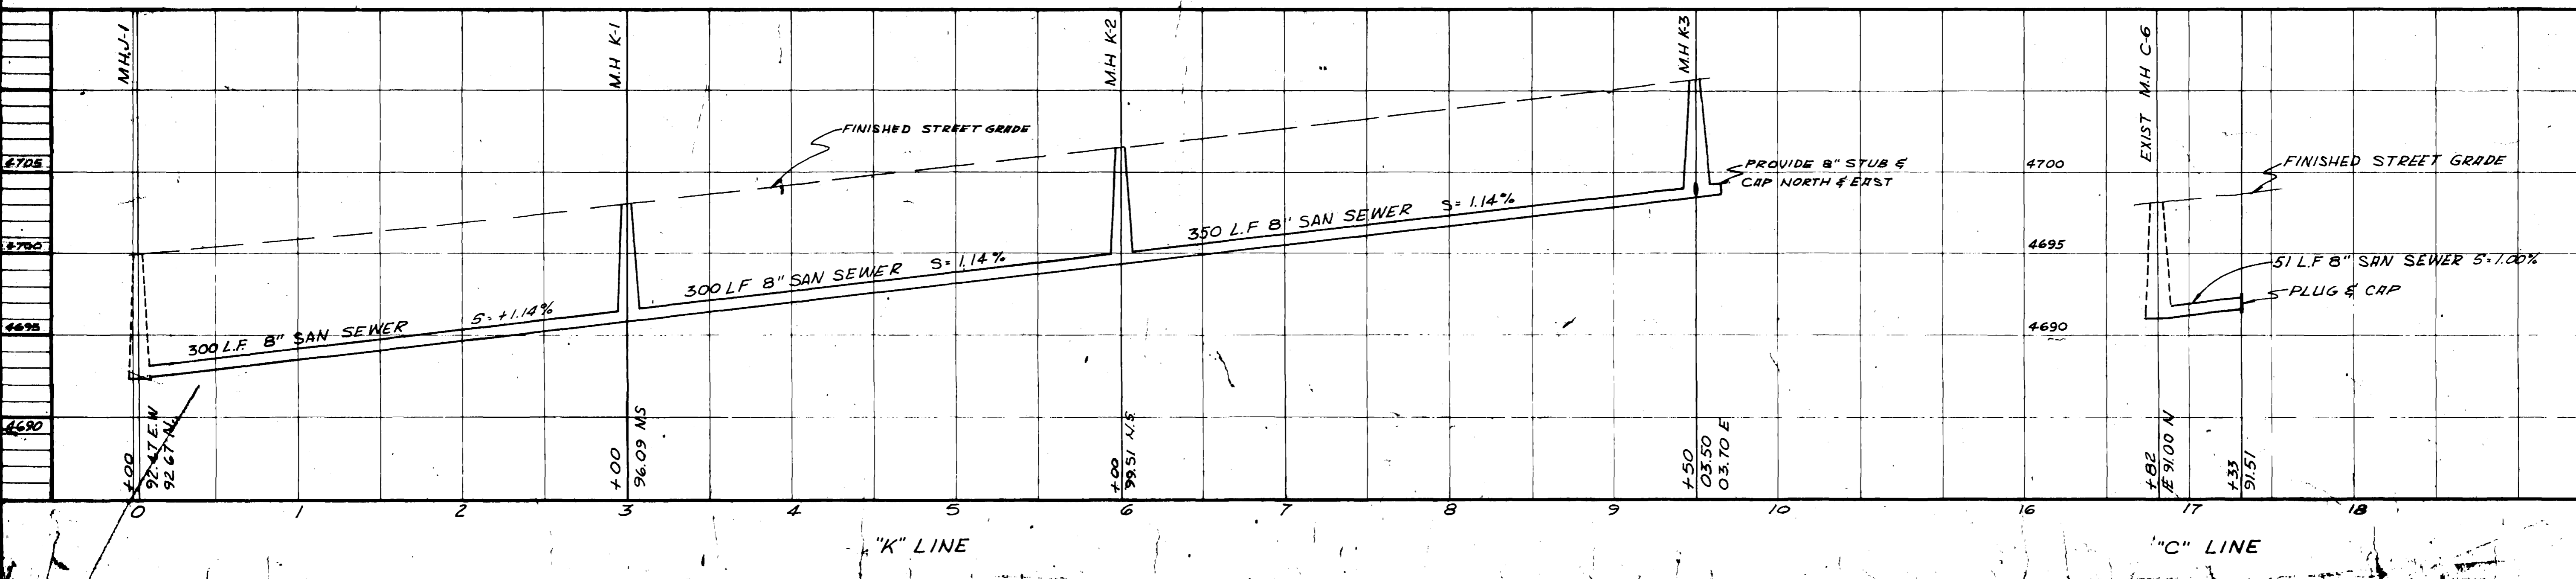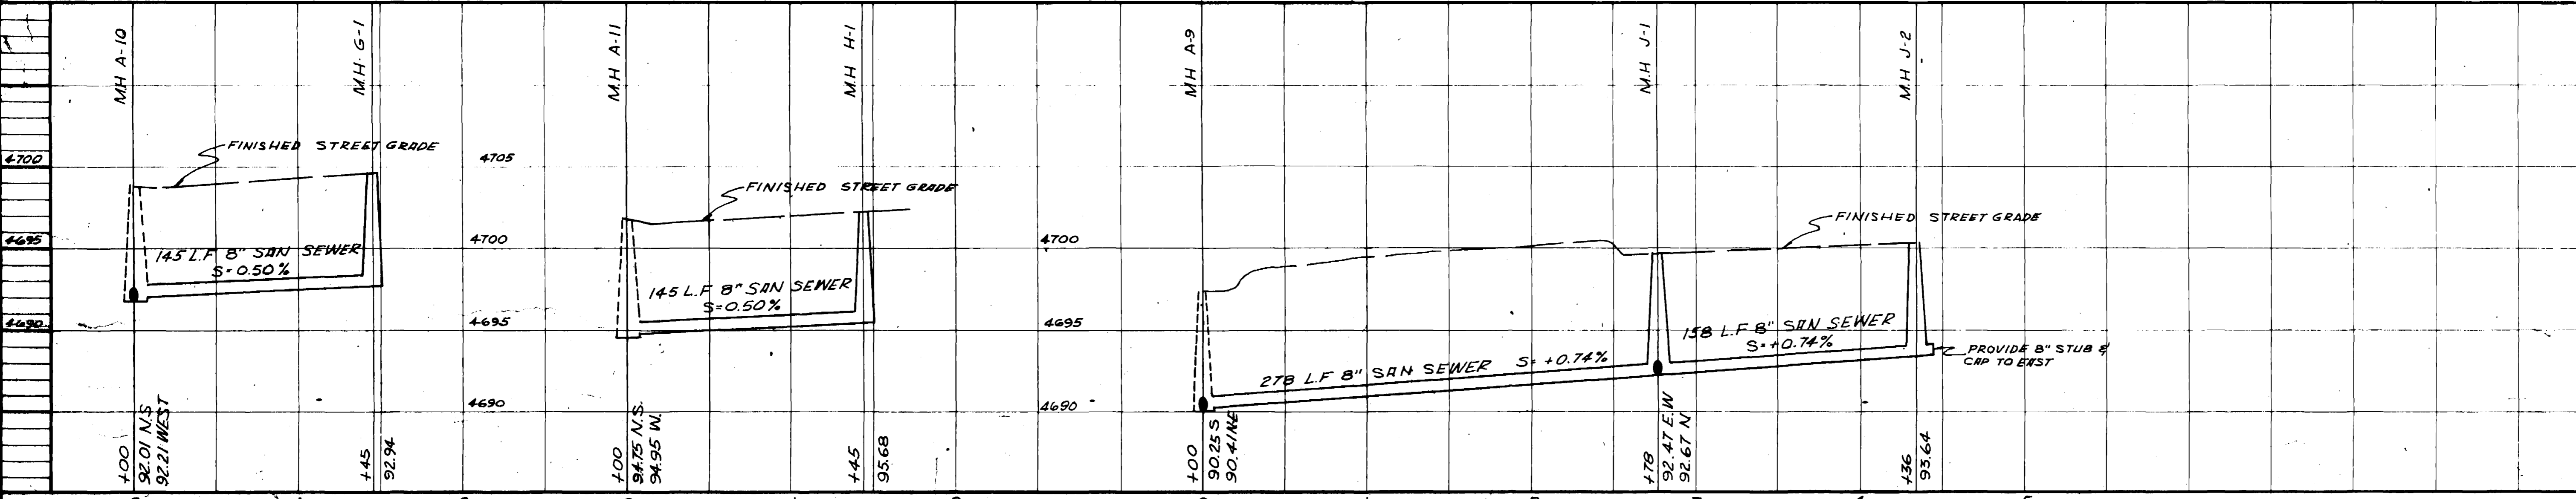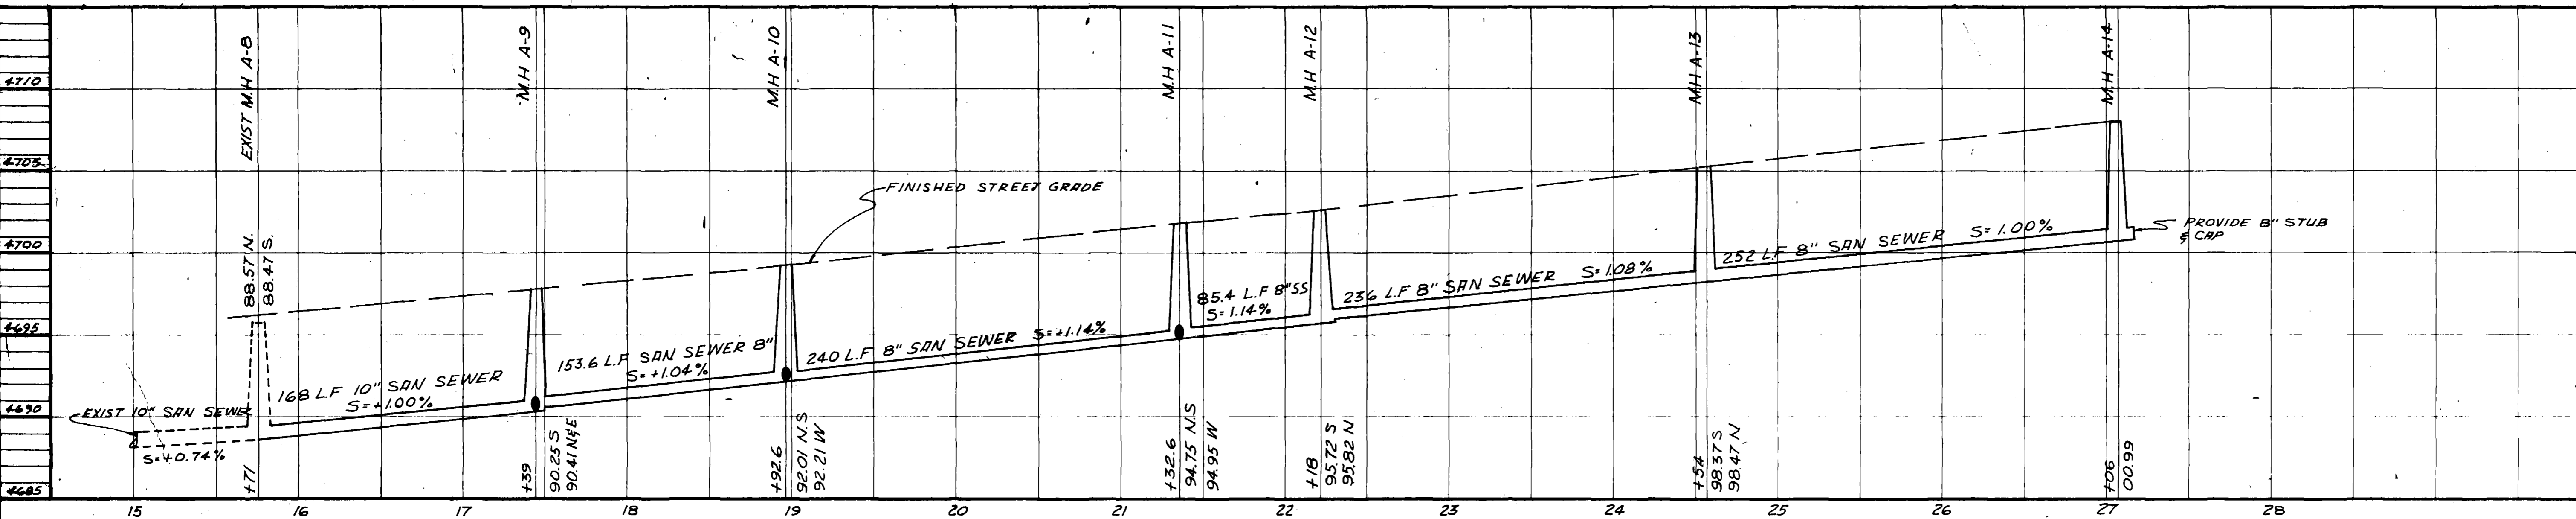

AS BUILT DRAWINGS

OX-BOW SUBDIVISION FILING NO. FOUR
 MESA COUNTY, COLORADO
 SANITARY SEWER PROFILE
 DATE FEBRUARY, 78
 SCALE 1"=5' VERT
 1"=50' HORIZ
 PARAGON ENGINEERING, INC.
 Engineering Consultants
 P.O. BOX 2872 • GRAND JUNCTION, COLORADO 81501