



A final inspection determined that infiltration does not exceed 200 gallons per inch diameter per mile of length per day.

AS BUILT DRAWINGS

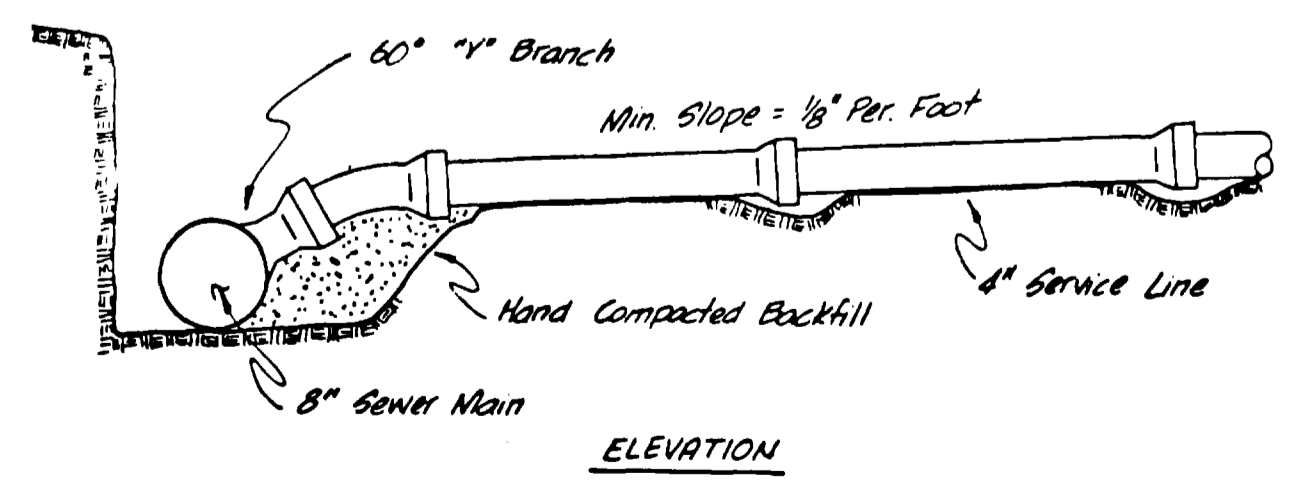

STANDARD SERVICE CONNECTION
No Scale

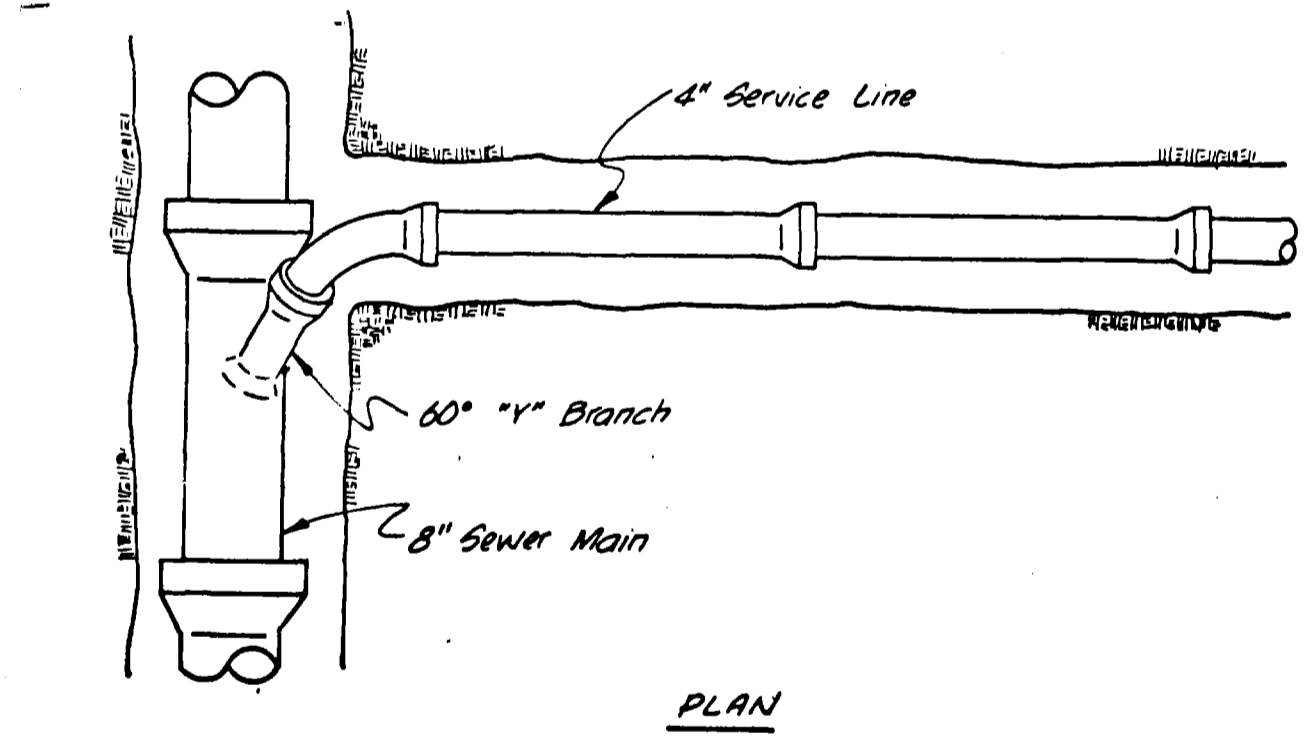